




MP 2.374
PROJECT BEGINS
STA 11.50

CABLE GUARD REQUIRED
LT-STA 13+85 TO 13+88 32 L.F.
" 14+82 TO 15+50 68 L.F.
RT - 13+38 TO 13+70 32 L.F.
" 14+54 TO 15+60 106 L.F.
238 L.F. TOTAL
\$ 100.00 MONEY

22-A
VI Docket
1920-0
JAMES McLAUGHLIN

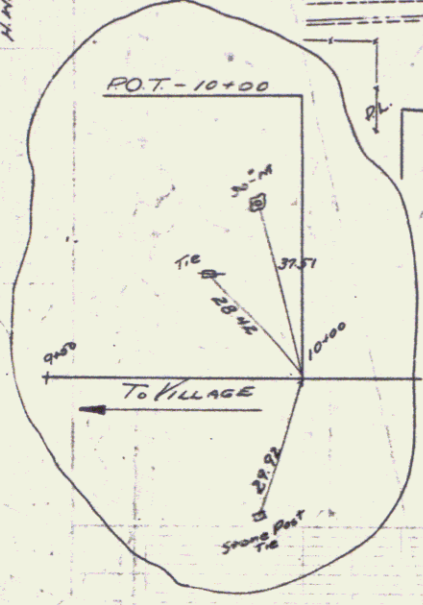

- INDEX OF SHEETS**
- 1 Plan & Profile
 - 2 518-20 25'00' Use 80' Span modified for 45' Snow and 3' Sidewalk. Details 204-4-1
 - 3 Details 204-4-1
 - 4 Details 204-4-2 Sidewalk Details
 - 5 5.8" 7A Balustrade Rail
 - 6 5.8" 11 Barricades, Lights, etc.
 - 7 5.8" 20 Typical Details, details 5-101, 5-103, 5-105, 5-111, 5-112
 - 8 5.8" 21 Typical Details, details 5-113, 5-115, 5-119
 - 9 Series 5-114, 20, Standard Structures C. R. M. Header
 - 10 Series 5-114, 30, Standard Structures Cable Rail; Anchors Grouted Cobble Gutter
 - 11 Series 5-114, 31 Standard Structures C.G. #3

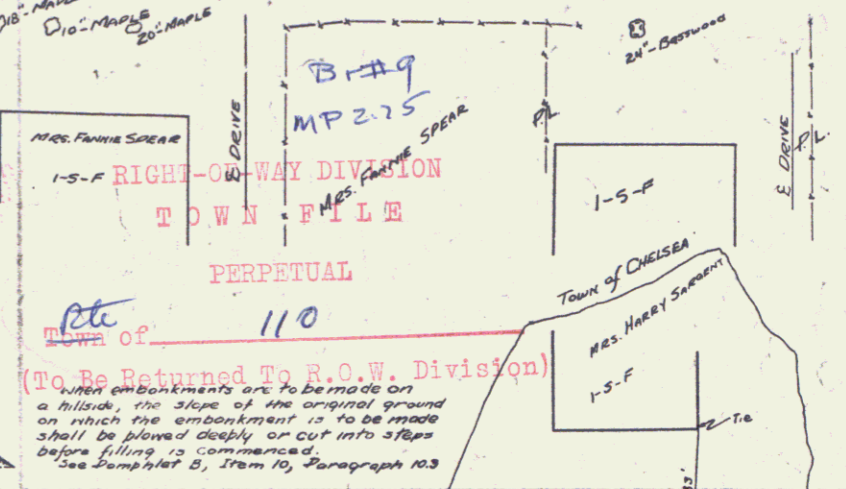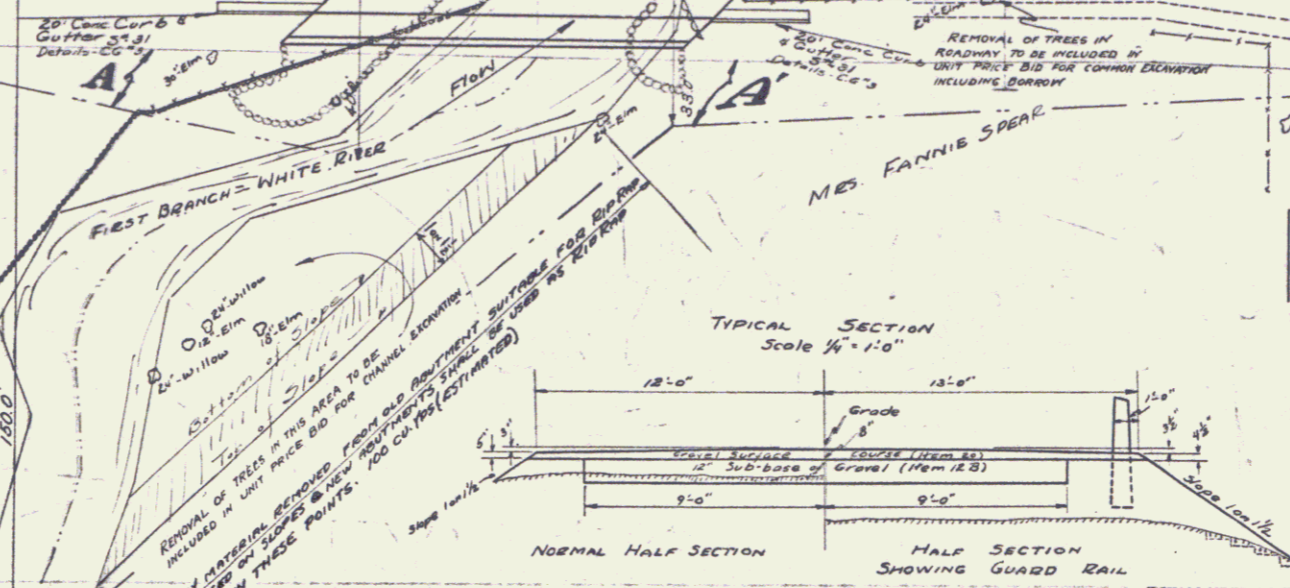


PROJECT BEGINS STA 11.50
EL. 201.60

STA 12+00/2-18
100' V.C.
EL. 200.00

BRIDGE BEGINS STA 12+85
SEE ELEV. 199.30 AT END

BRIDGE ENDS STA 16+50
SEE ELEV. 198.75 AT END

PROJECT ENDS STA 17+50

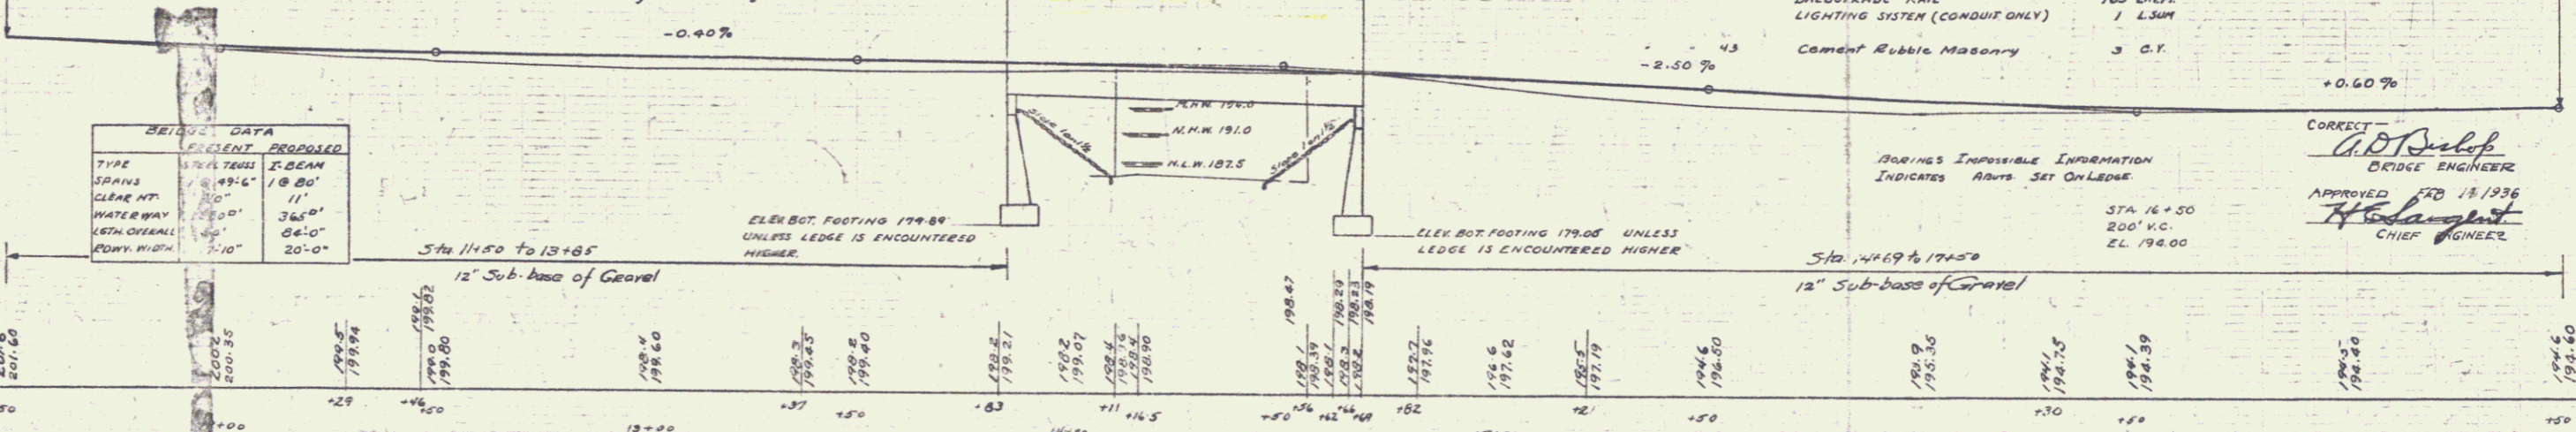

PARCEL INSTRUMENT	DATE	GRANTOR	GRANTEE	RECORDED CHSELSEA	REMARKS
A	6-7-36	HATTIE STOUGHTON	ST. OF VT.	BOOK 20 PAGE 639	5-26-36
A	7-7-36	FANNIE E. SPEAR	ST. OF VT.	BOOK 20 PAGE 635	4-8-36

1740 NORTON BE.
TOWN OF CHELSEA, VT.
Project No. A.W.A. VI, DOCKET 1920-0
Norton Bridge
SHEET 7 OF 18 SHEETS