


(To Be Returned To R.O.W. Division)
 Town of U+110
 PERPETUAL
 HIGH-OF-WAY DIVISION
 MP 3.32
 B-#11



DAY COLLINS
 CELESTINE
 TRACED

DAY COLLINS
 PROFILE

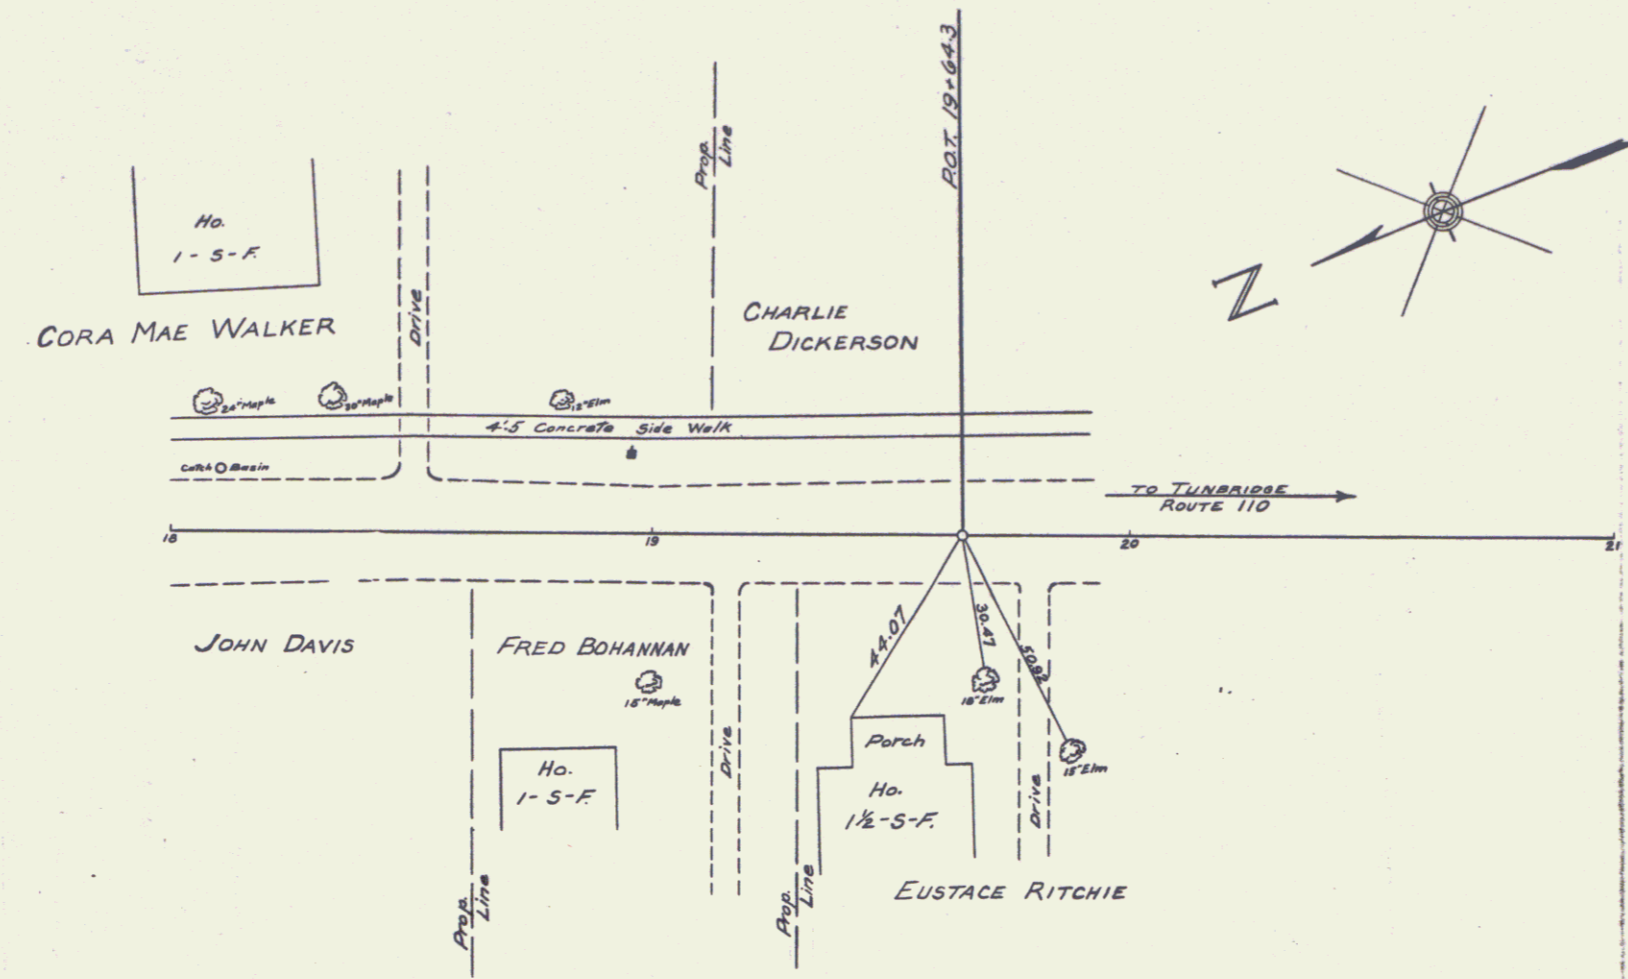