

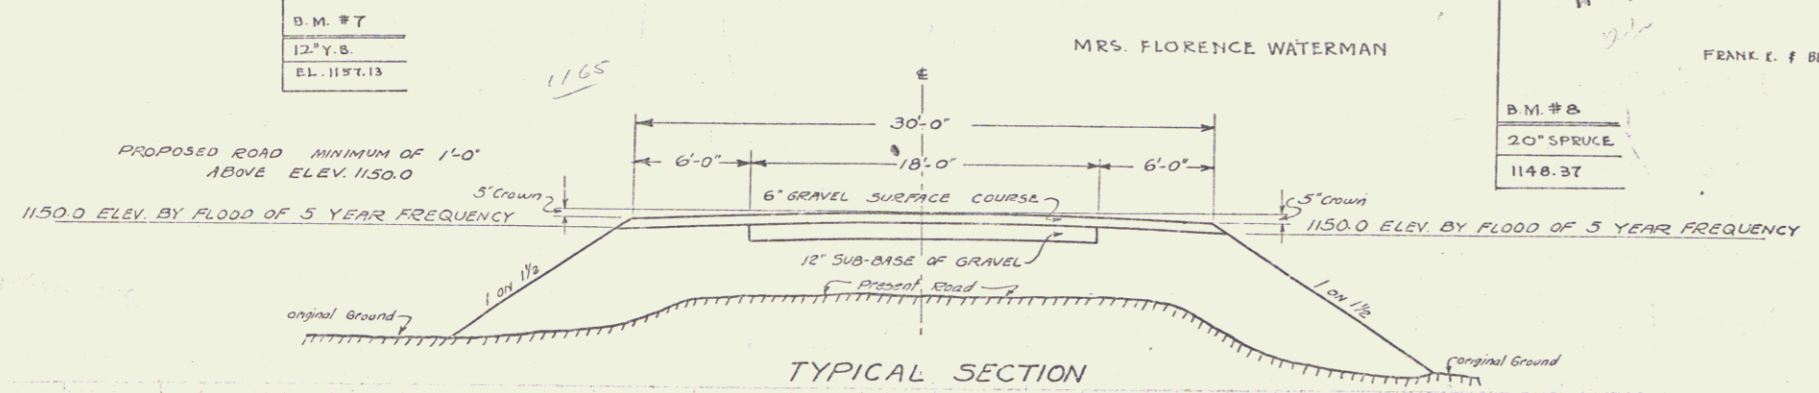


BARRE-BERTIN

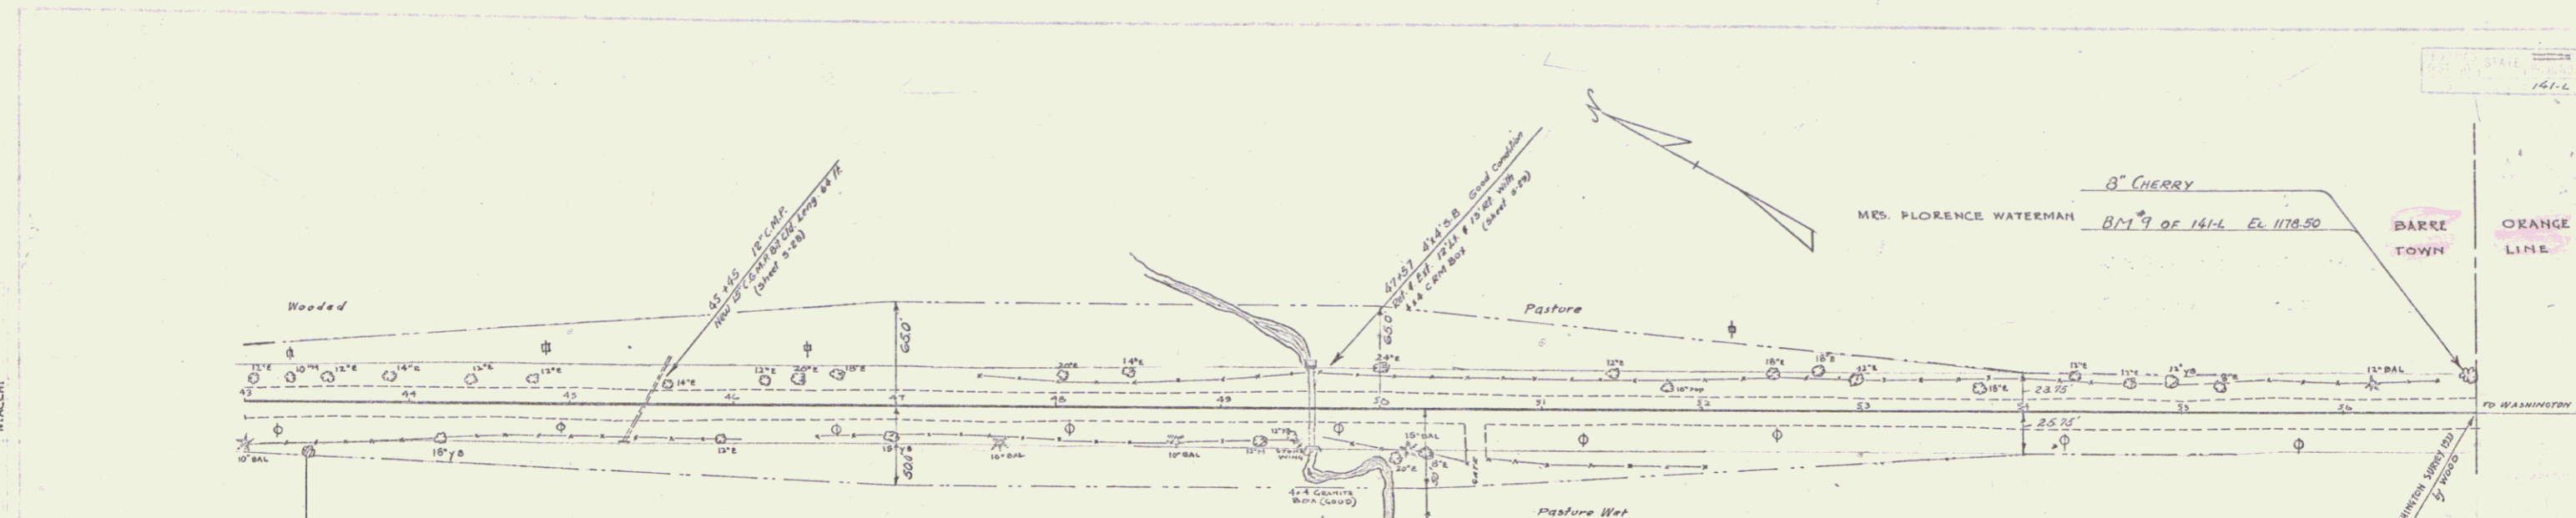

NOTE: MAR. 4, 1944
 MRS. BEIT SAYS THIS SECTION
 WAS BUILT UP TO SPILLWAY ELEV. 1167.00

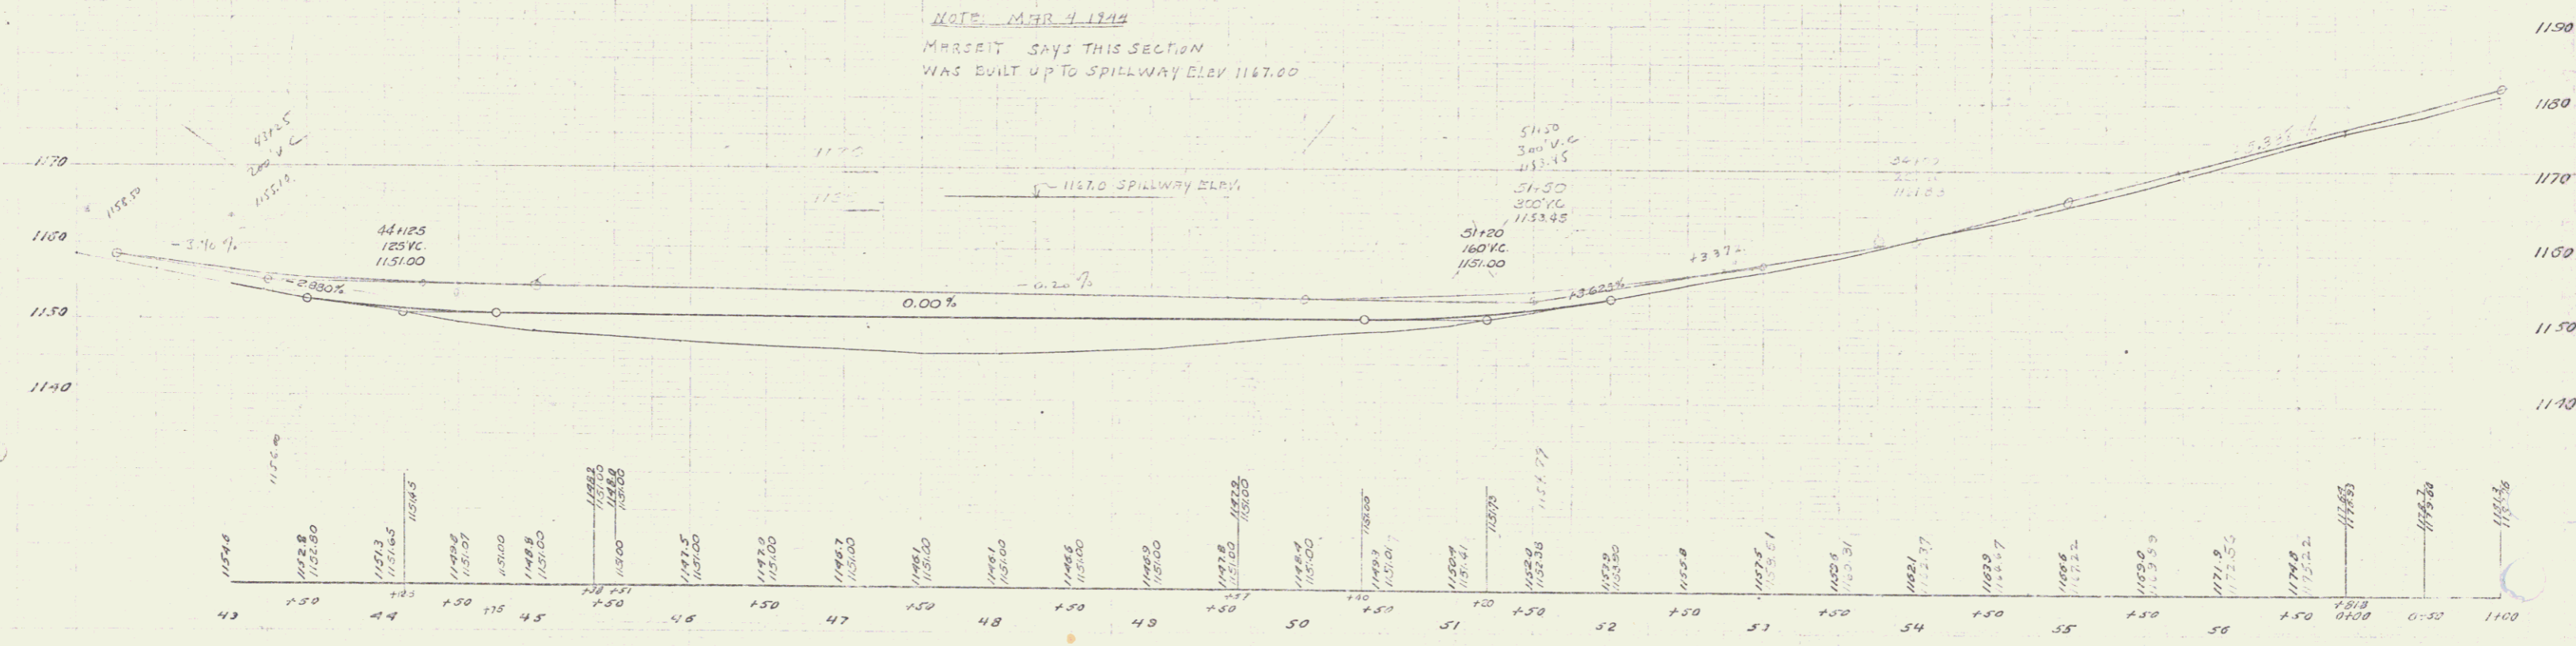

East Barre 141-L
 Sheet 5 of 11