
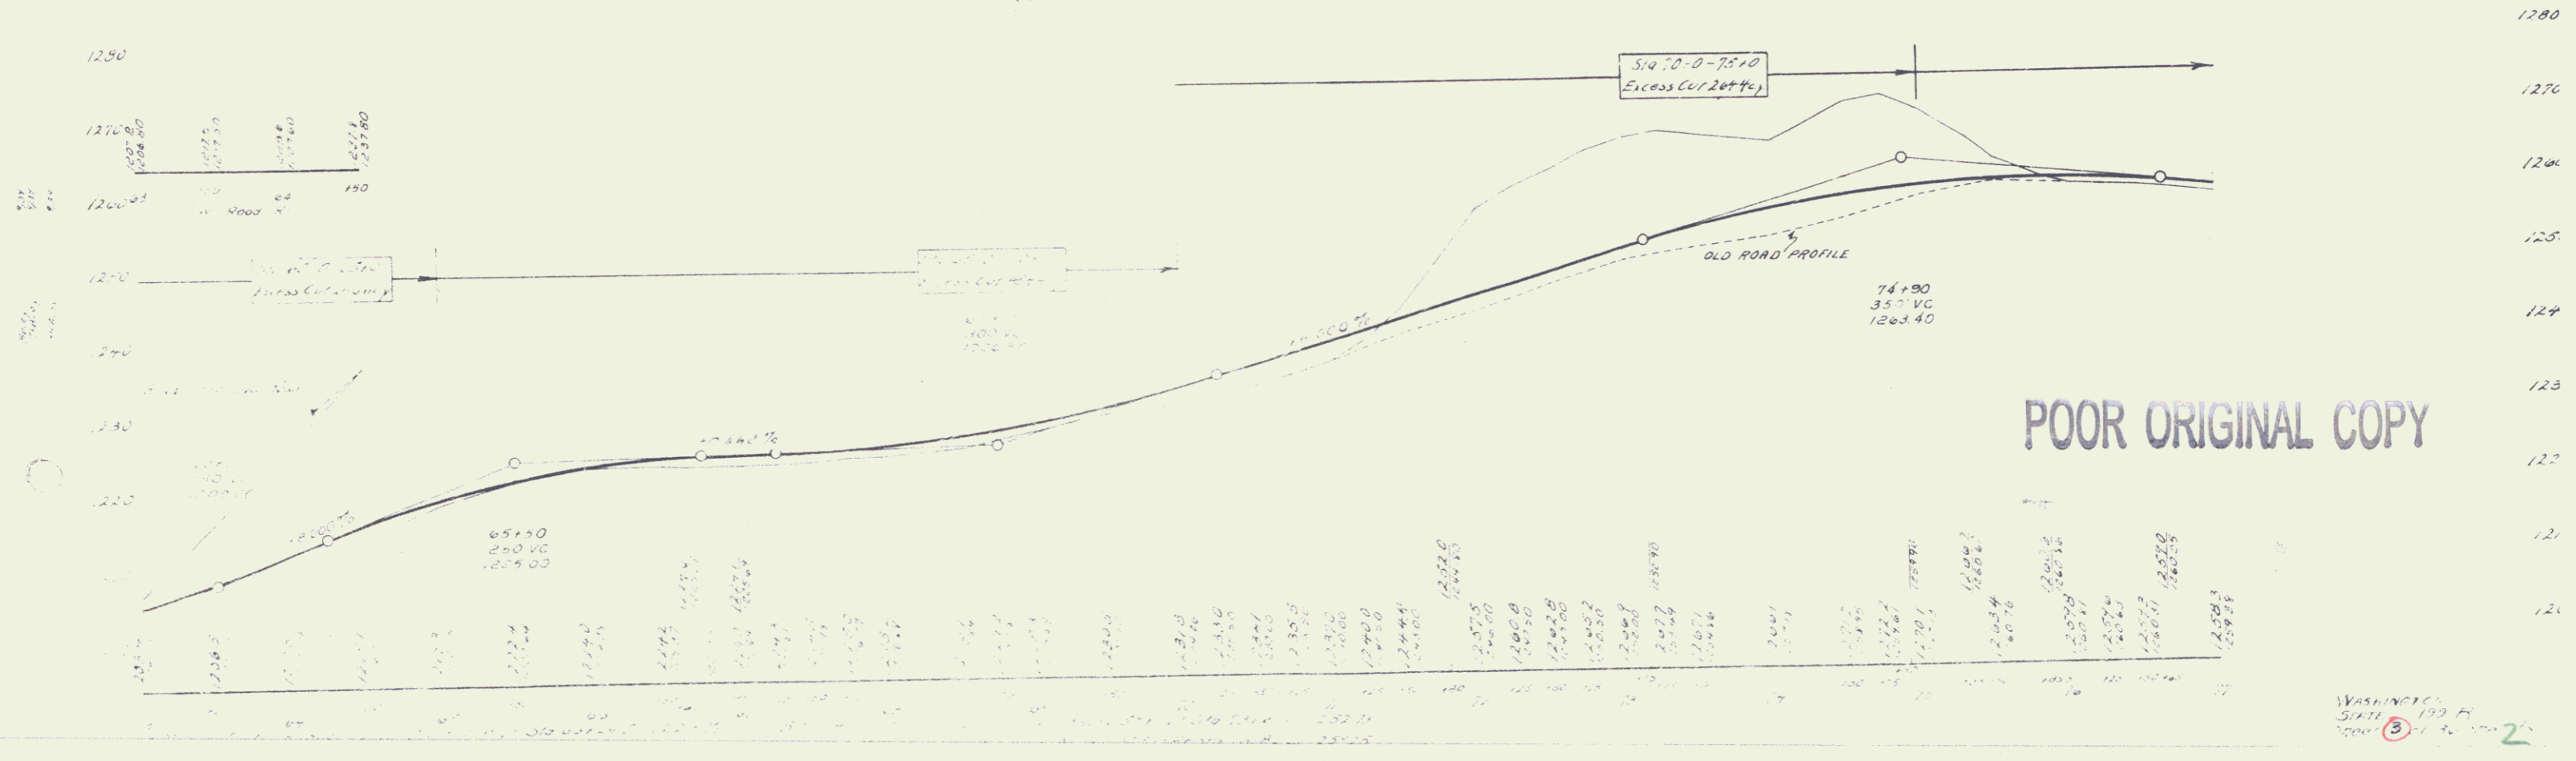


PARCEL	INSTRUMENT	DATE	GRANTOR	GRANTEE	RECORDED	REMARKS
A-B	Q.C.D.	4-17-40	VICTOR & LOURD DURANLEAU	ST. OF VT	27	146
A	Q.C.D.	11-27-39	ARNE E. MILLER (29.73M)	ST. OF VT	27	146
A	W.D.	11-27-39	TOWN OF WASHINGTON	ST. OF VT	27	162

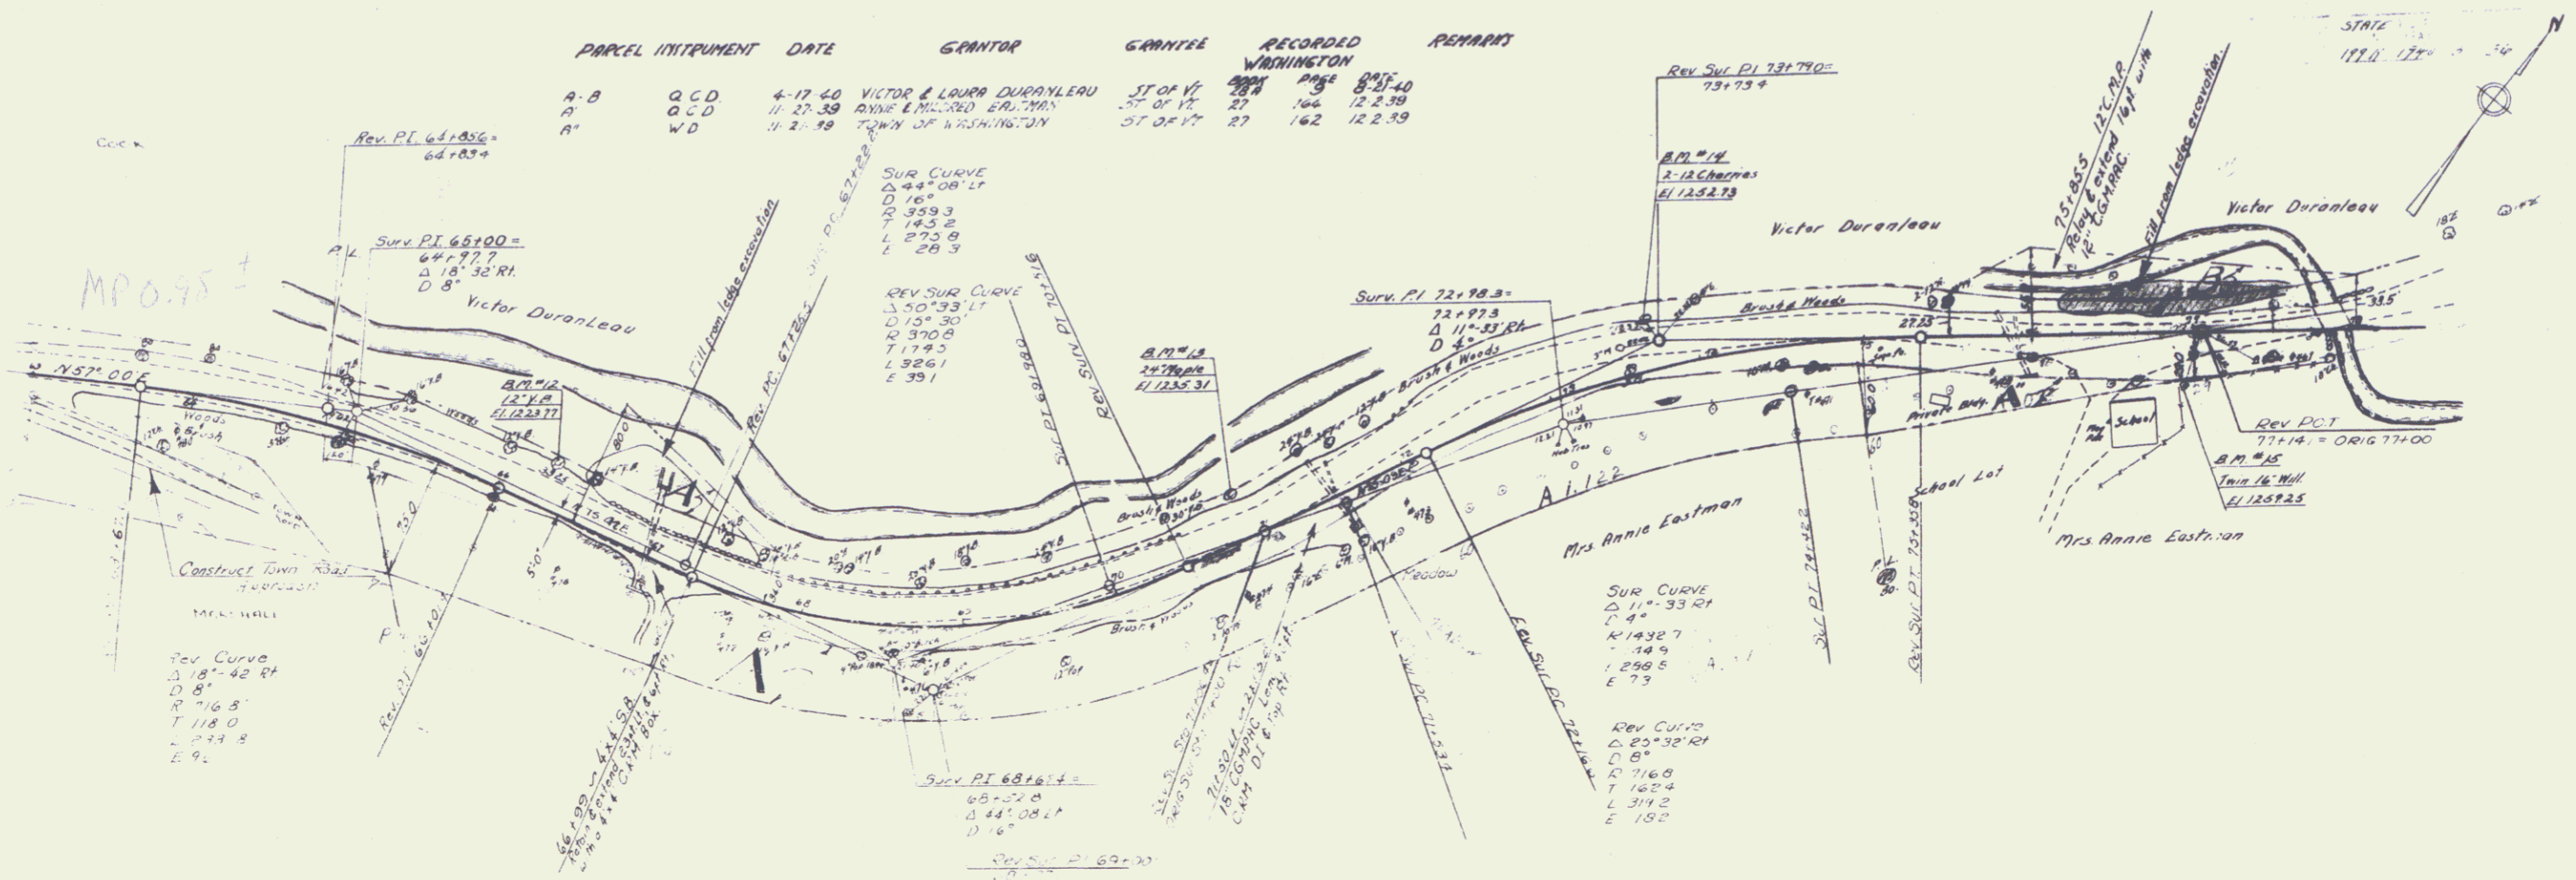

WASHINGTON
 STATE
 1939
 5