
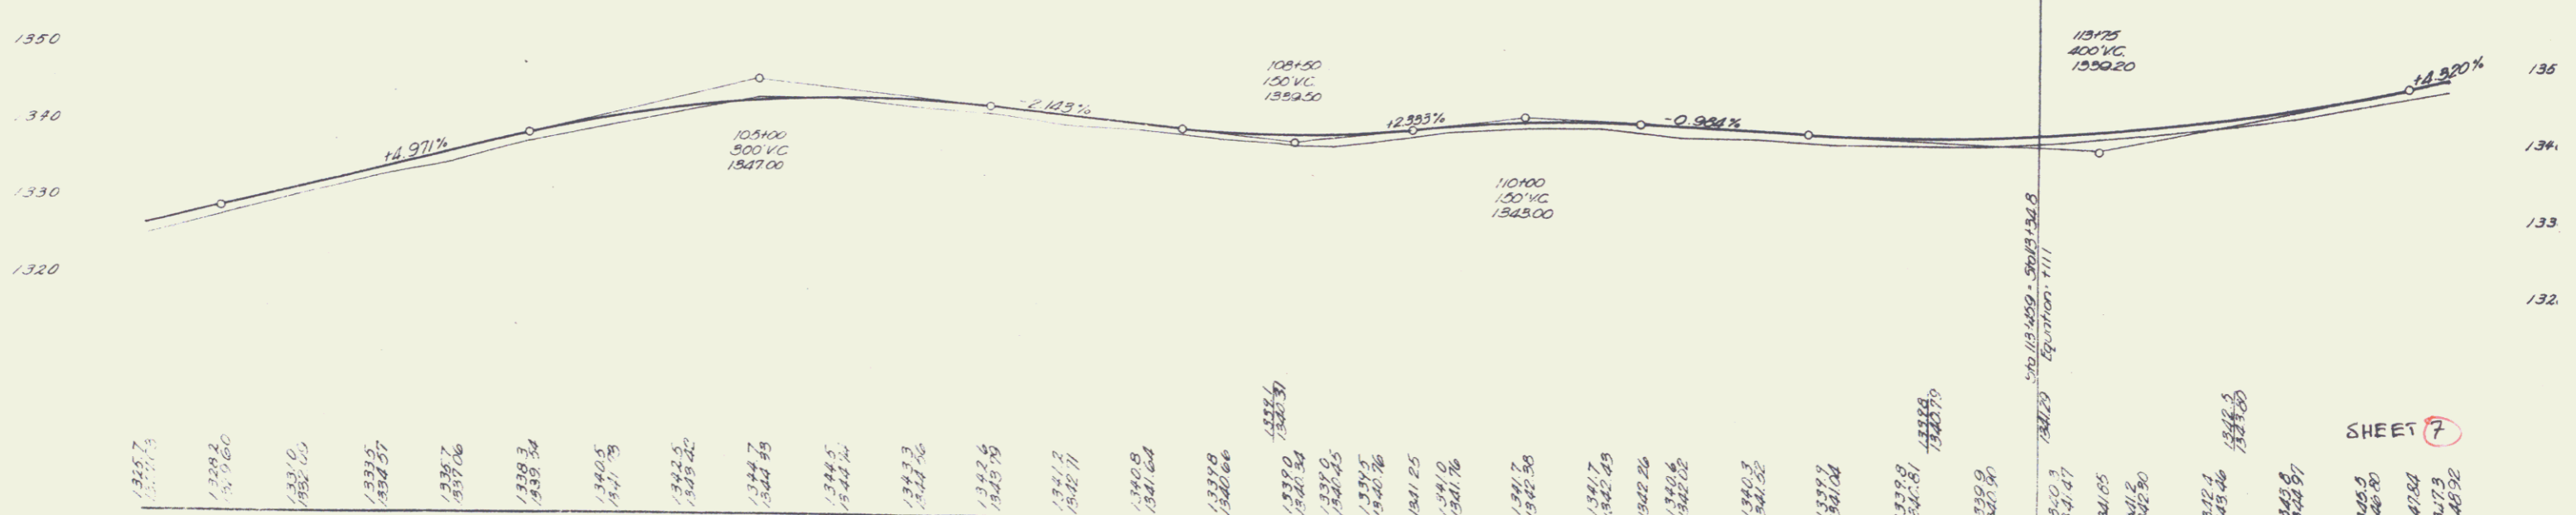


PARCEL	INSTRUMENT	DATE	GRANTOR	GRANTEE	RECORDED WASHINGTON BOOK	PAGE	DATE	REMARKS
A	W.D.G.	11-19-41	ALLEN & VERNA MACHELL	ST OF VT	27	252	11-26-41	
A'S	W.D.G.	9-30-41	E.D. PALMER	ST OF VT	27	258	11-7-41	

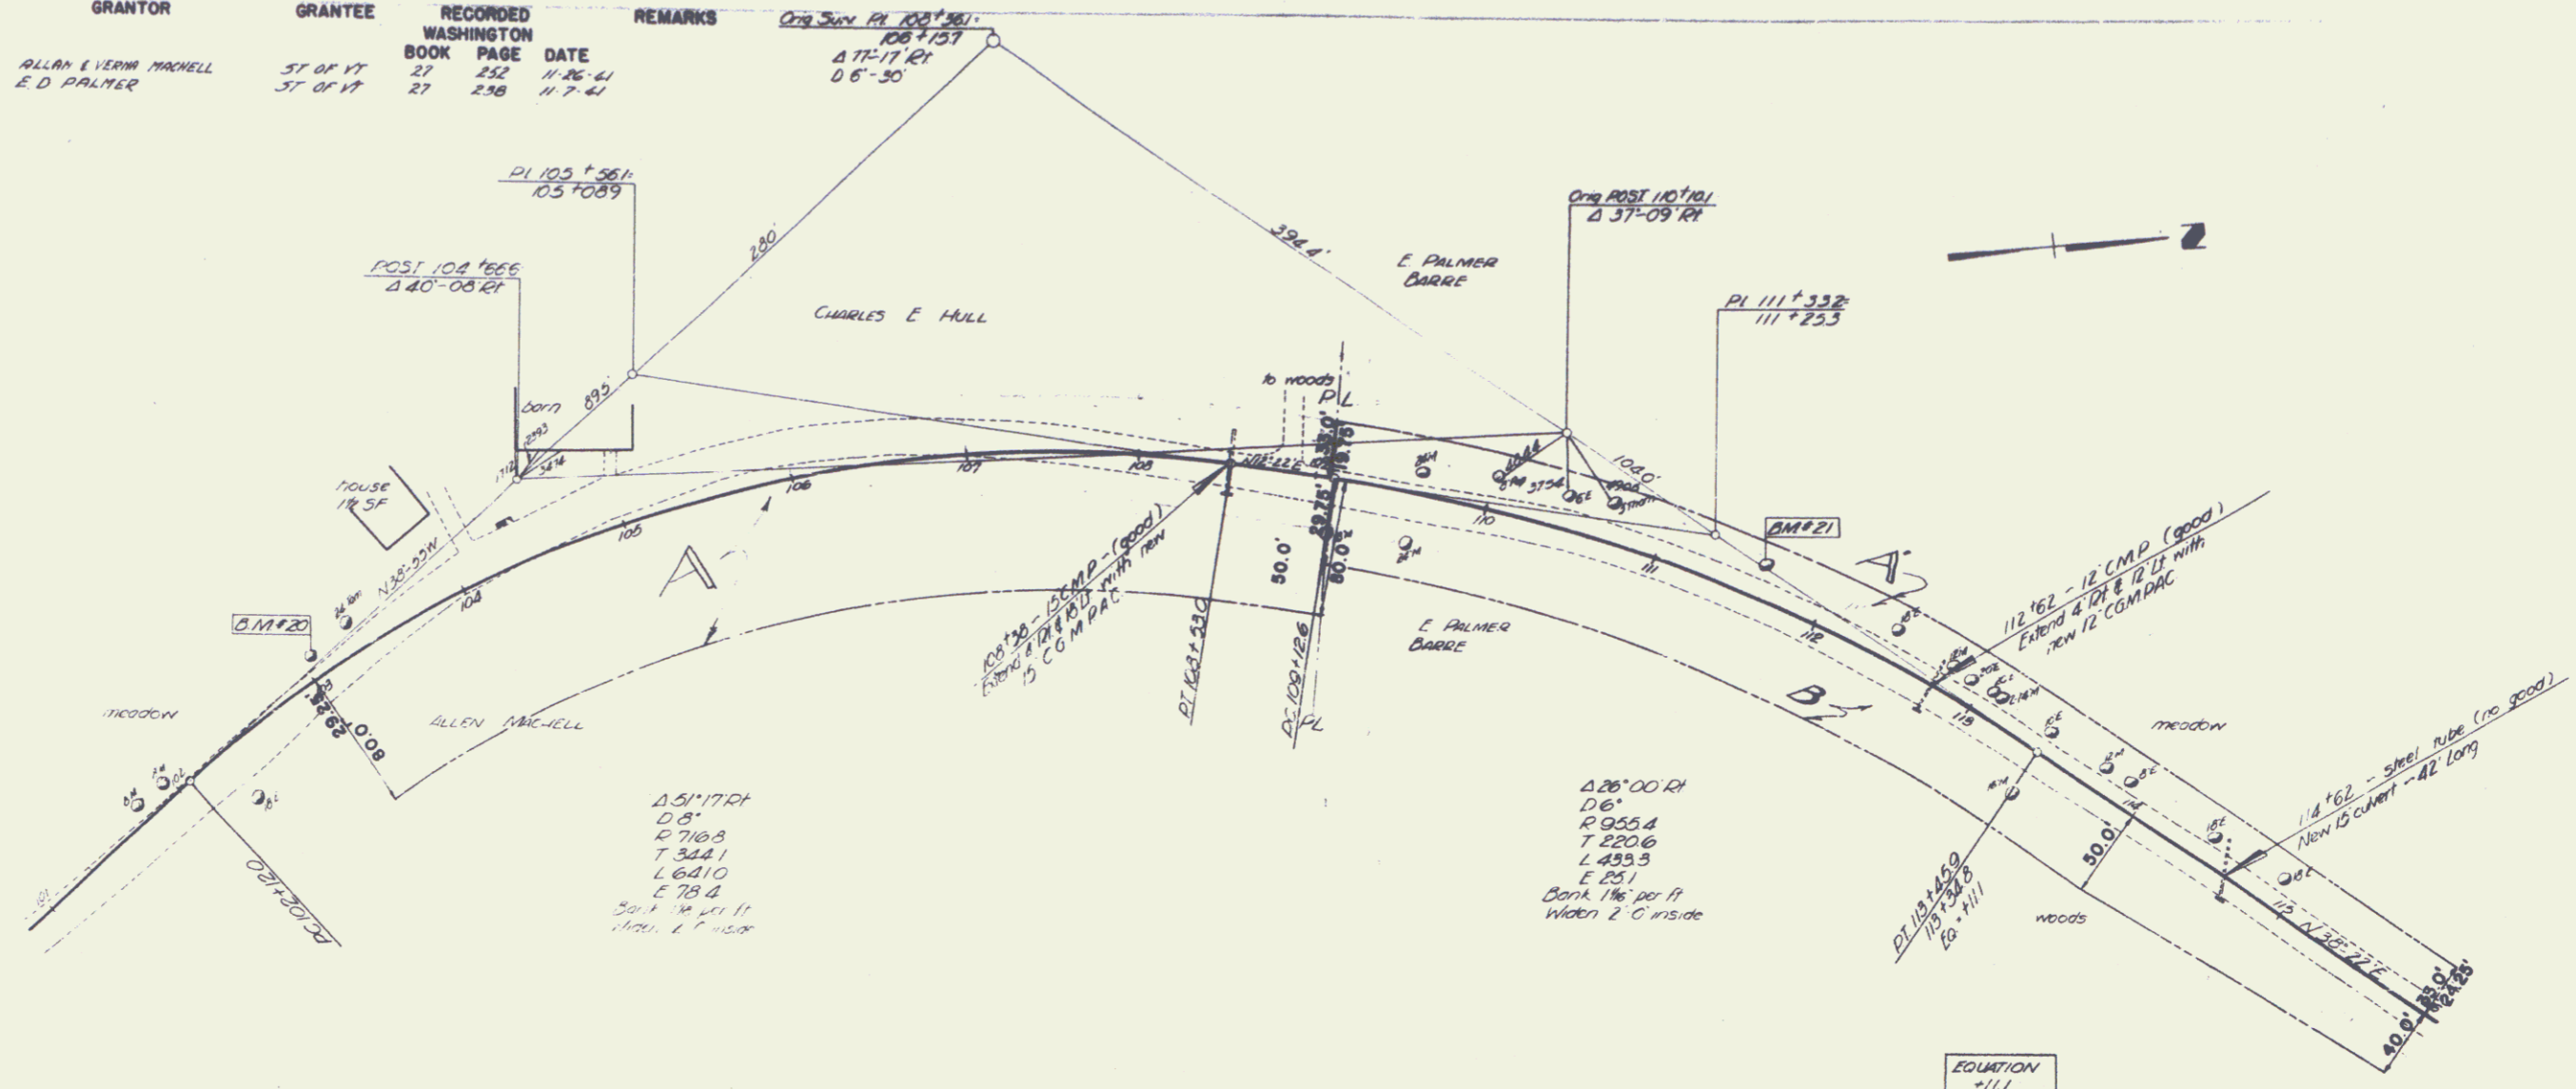

BM 100 1/2" x 1/2" GRANITE 5 ft left of Sta 105+10. Elev 1352.07  
 BM 200 1/2" x 1/2" IRON 15 ft left of Sta 111+30. Elev 1350.91

SHEET 7

6