



PARCEL	INSTRUMENT	DATE	GRANTOR	GRANTEE	RECORDED	REMARKS
A	W.D.O.E.	8-21-61	J.O. & W.G. RICHARDSON	ST OF VT	27 246	WASHINGTON BOOK PAGE DATE 11-2-61

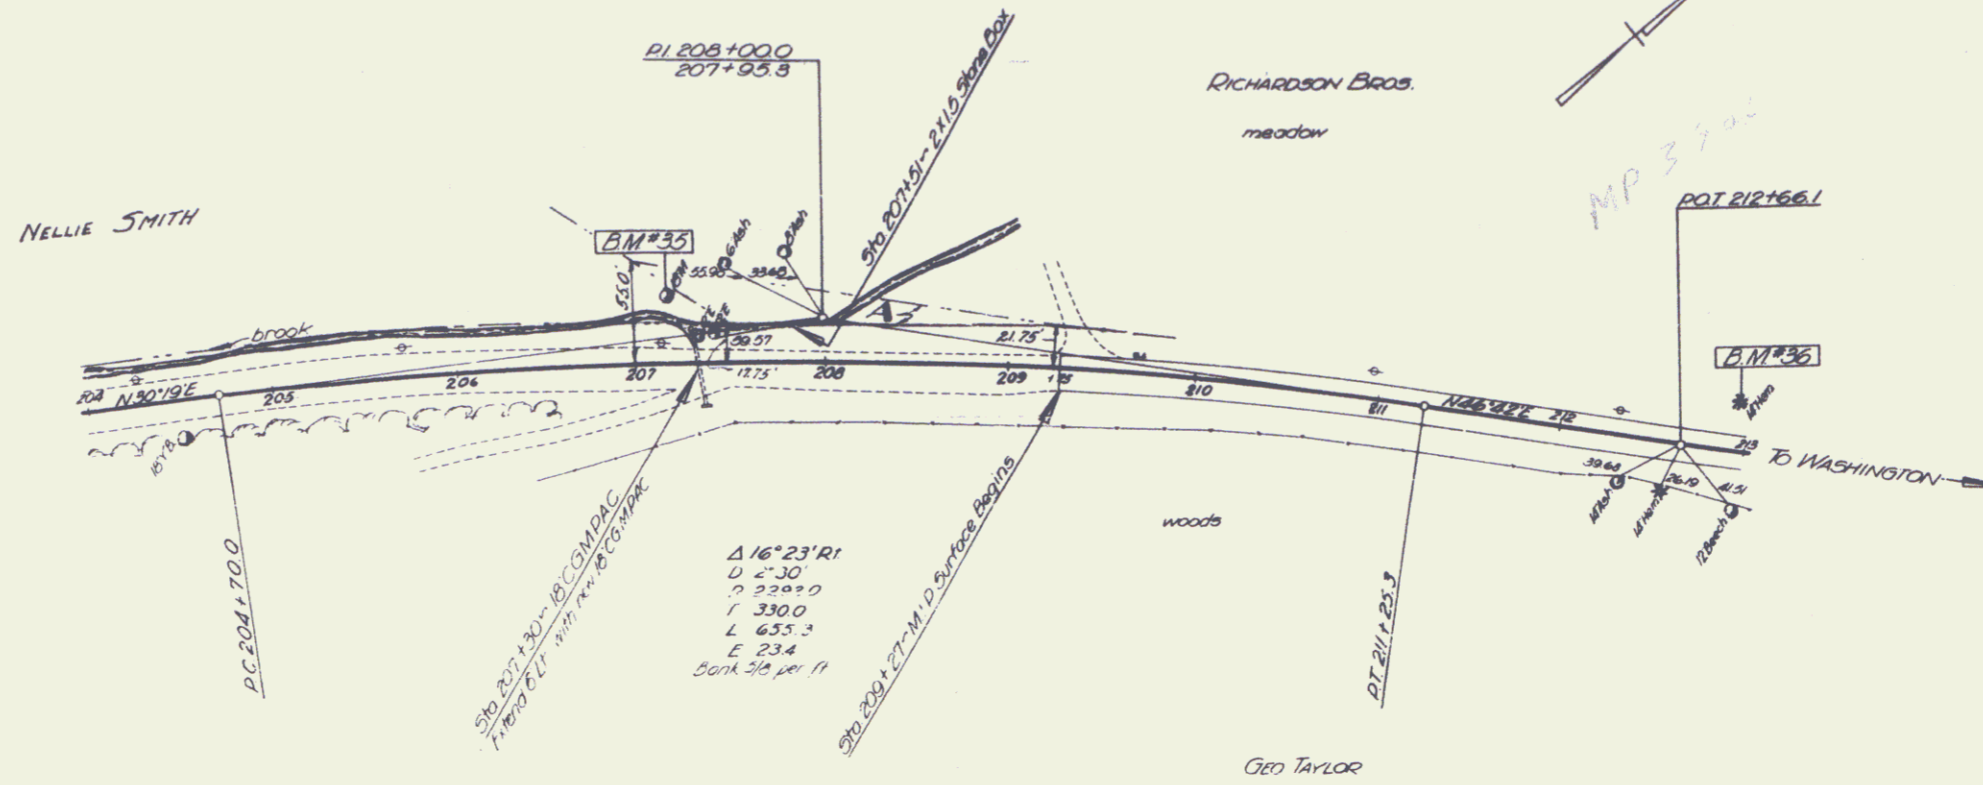

$\Delta 16^{\circ} 23' 21''$   
 $D = 330.0$   
 $T = 229.0$   
 $L = 635.3$   
 $E = 23.4$   
 Bank 30' per ft

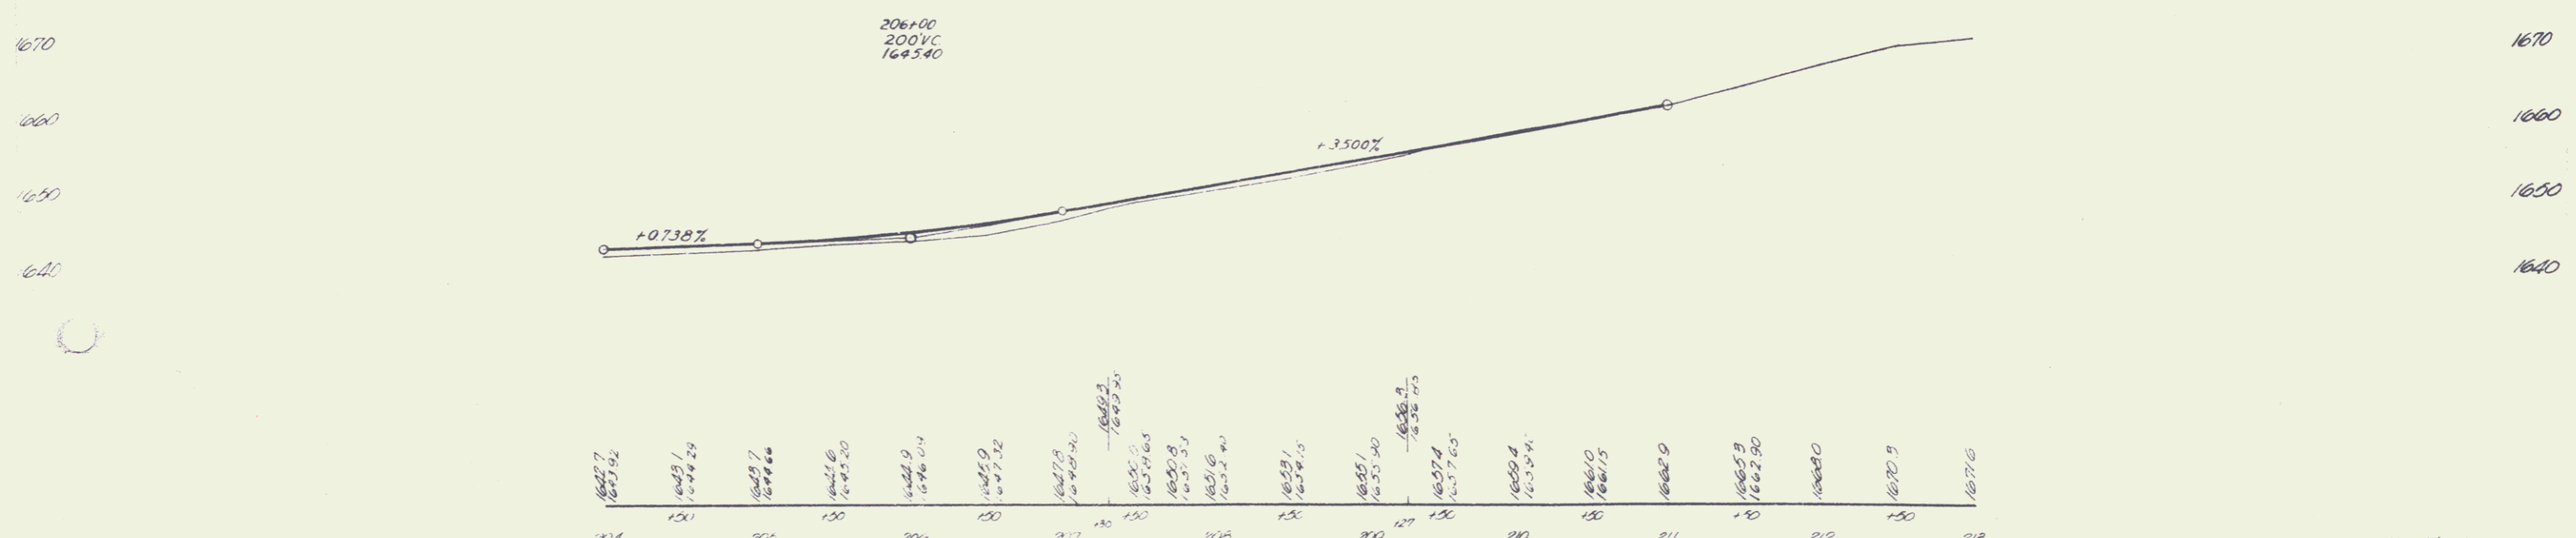

206+00  
 200VC  
 169540

BM#35 - S 10 1/2 Maple St. 11.5 to 207+14. Elev. 1636.95  
 BM#36 - S 10 1/2 Hemlock St. 11.5 to 212+22. Elev. 1666.28