
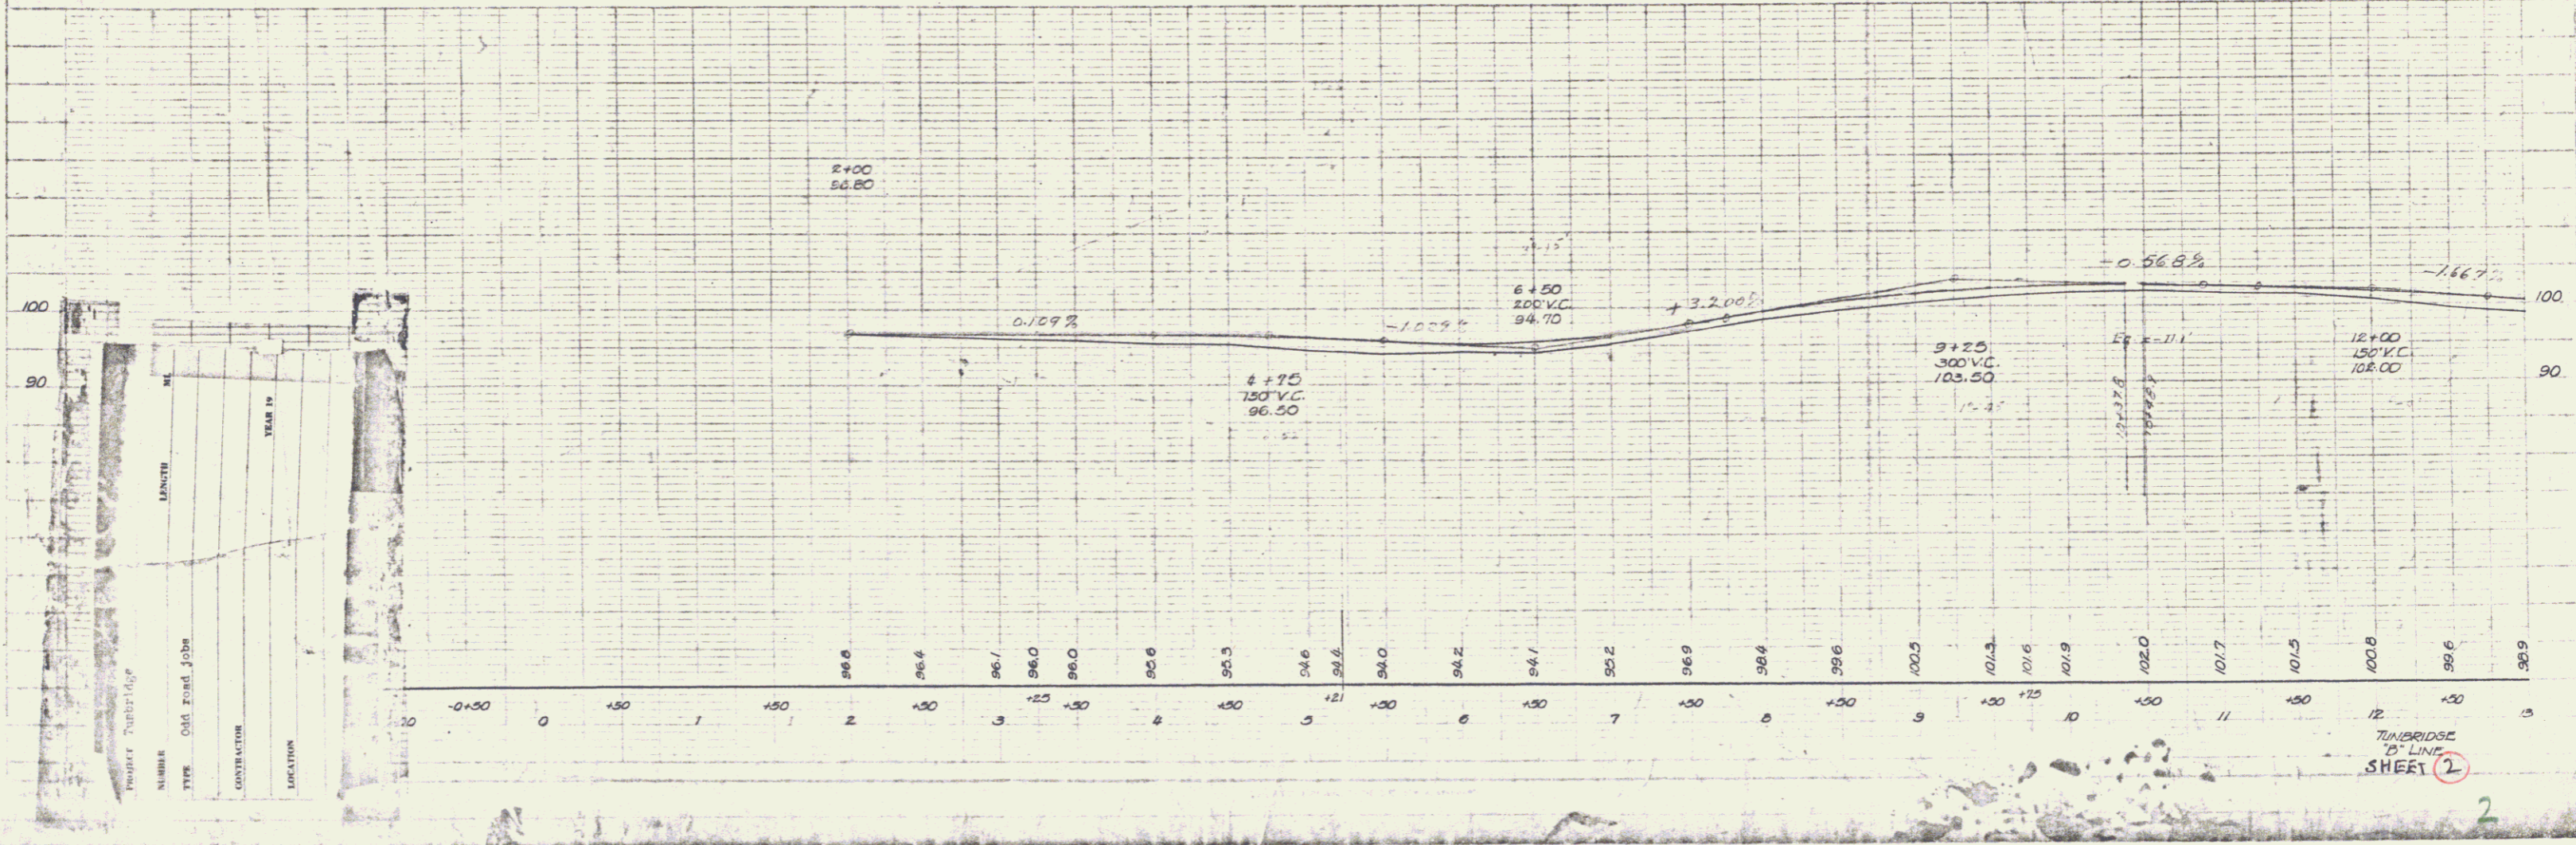


PLAN  
 DATE  
 NORTH ARROW  
 SCALE

DATE  
 SCALE

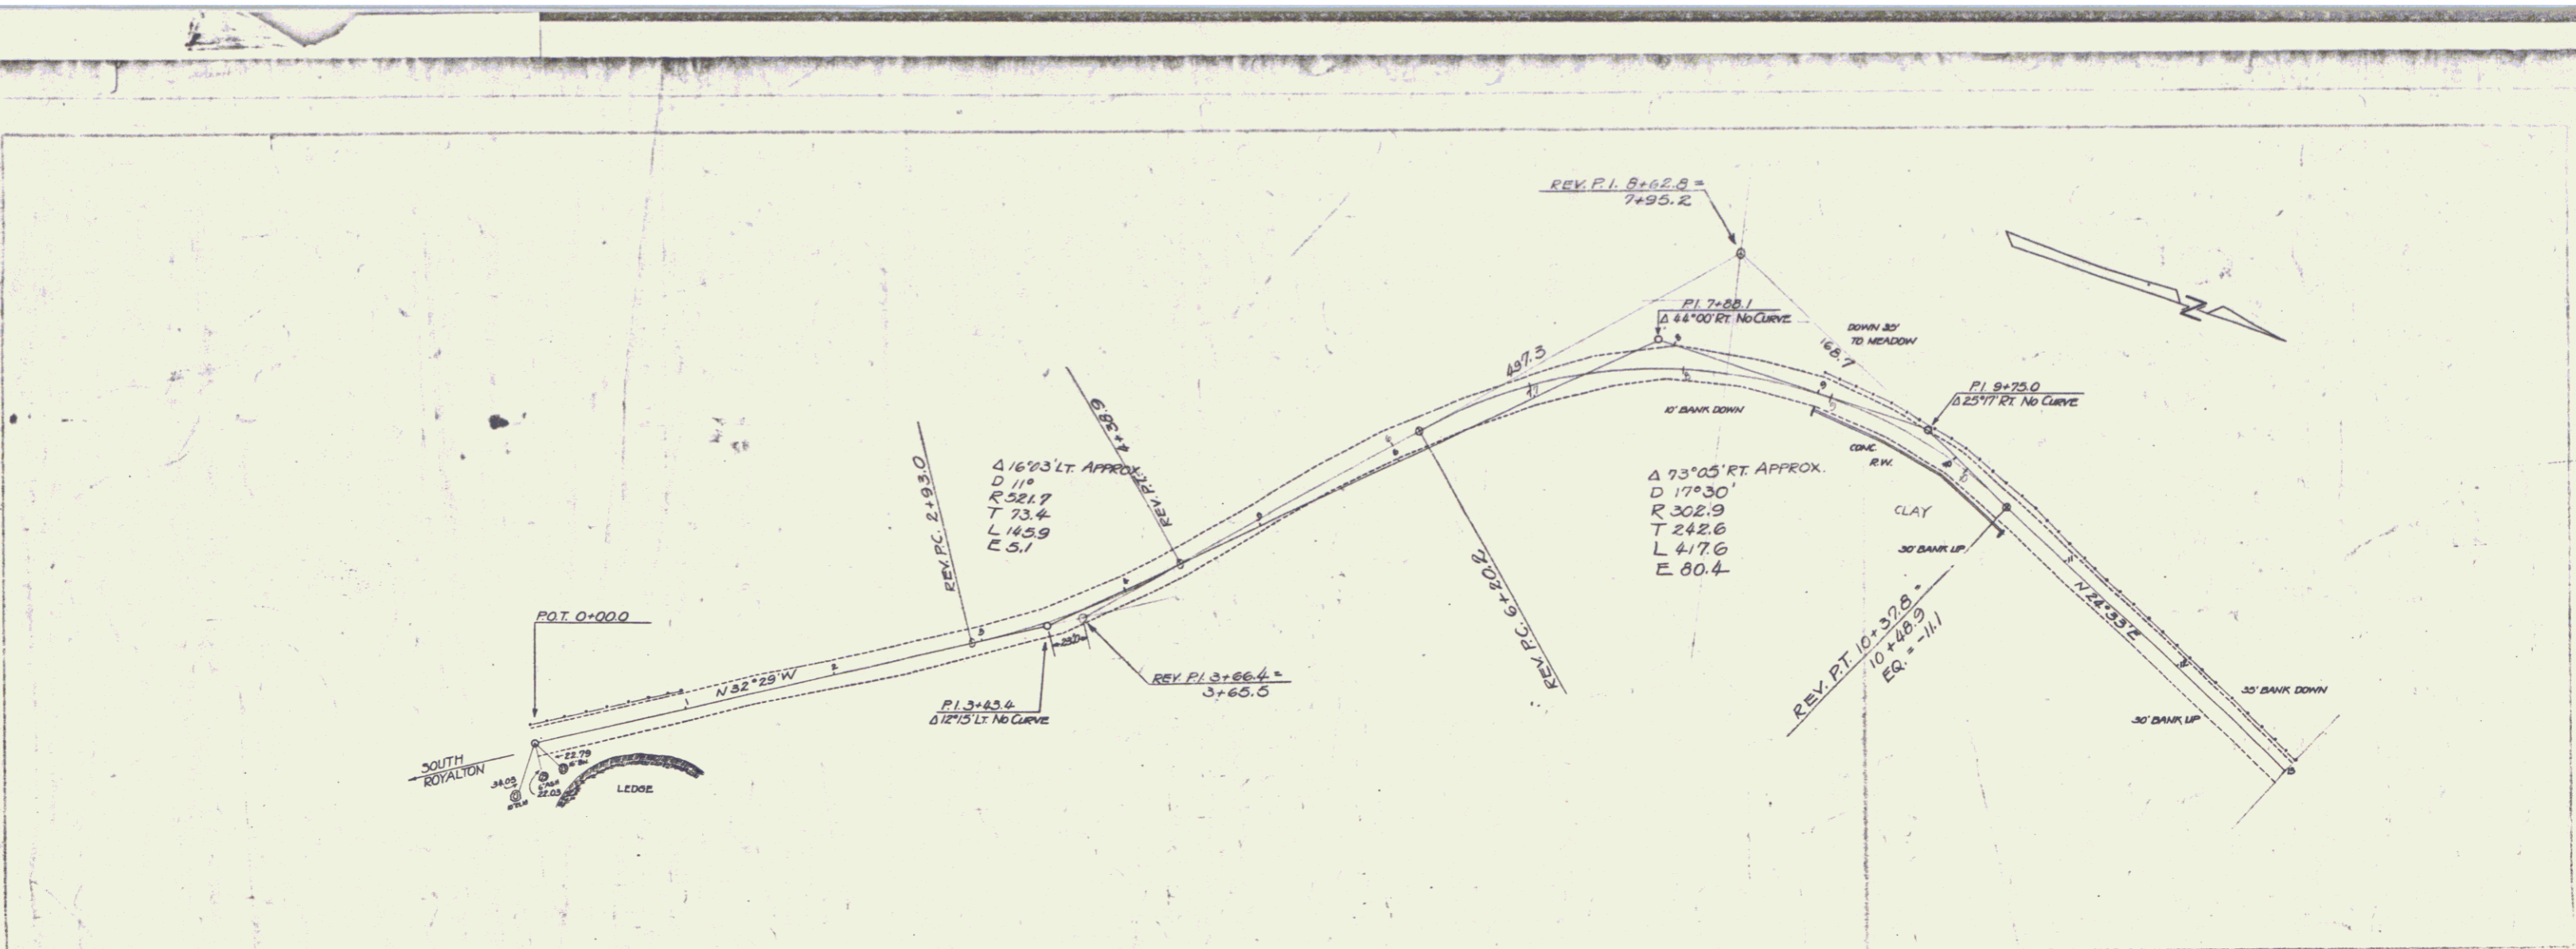

NUMBER	DATE	BY	REVISION

TIMBRIDGE  
 'D' LINE  
 SHEET 2

2