



PLAN
 SOUTH ROYALTON
 NORTH BAY
 1/2" = 100'

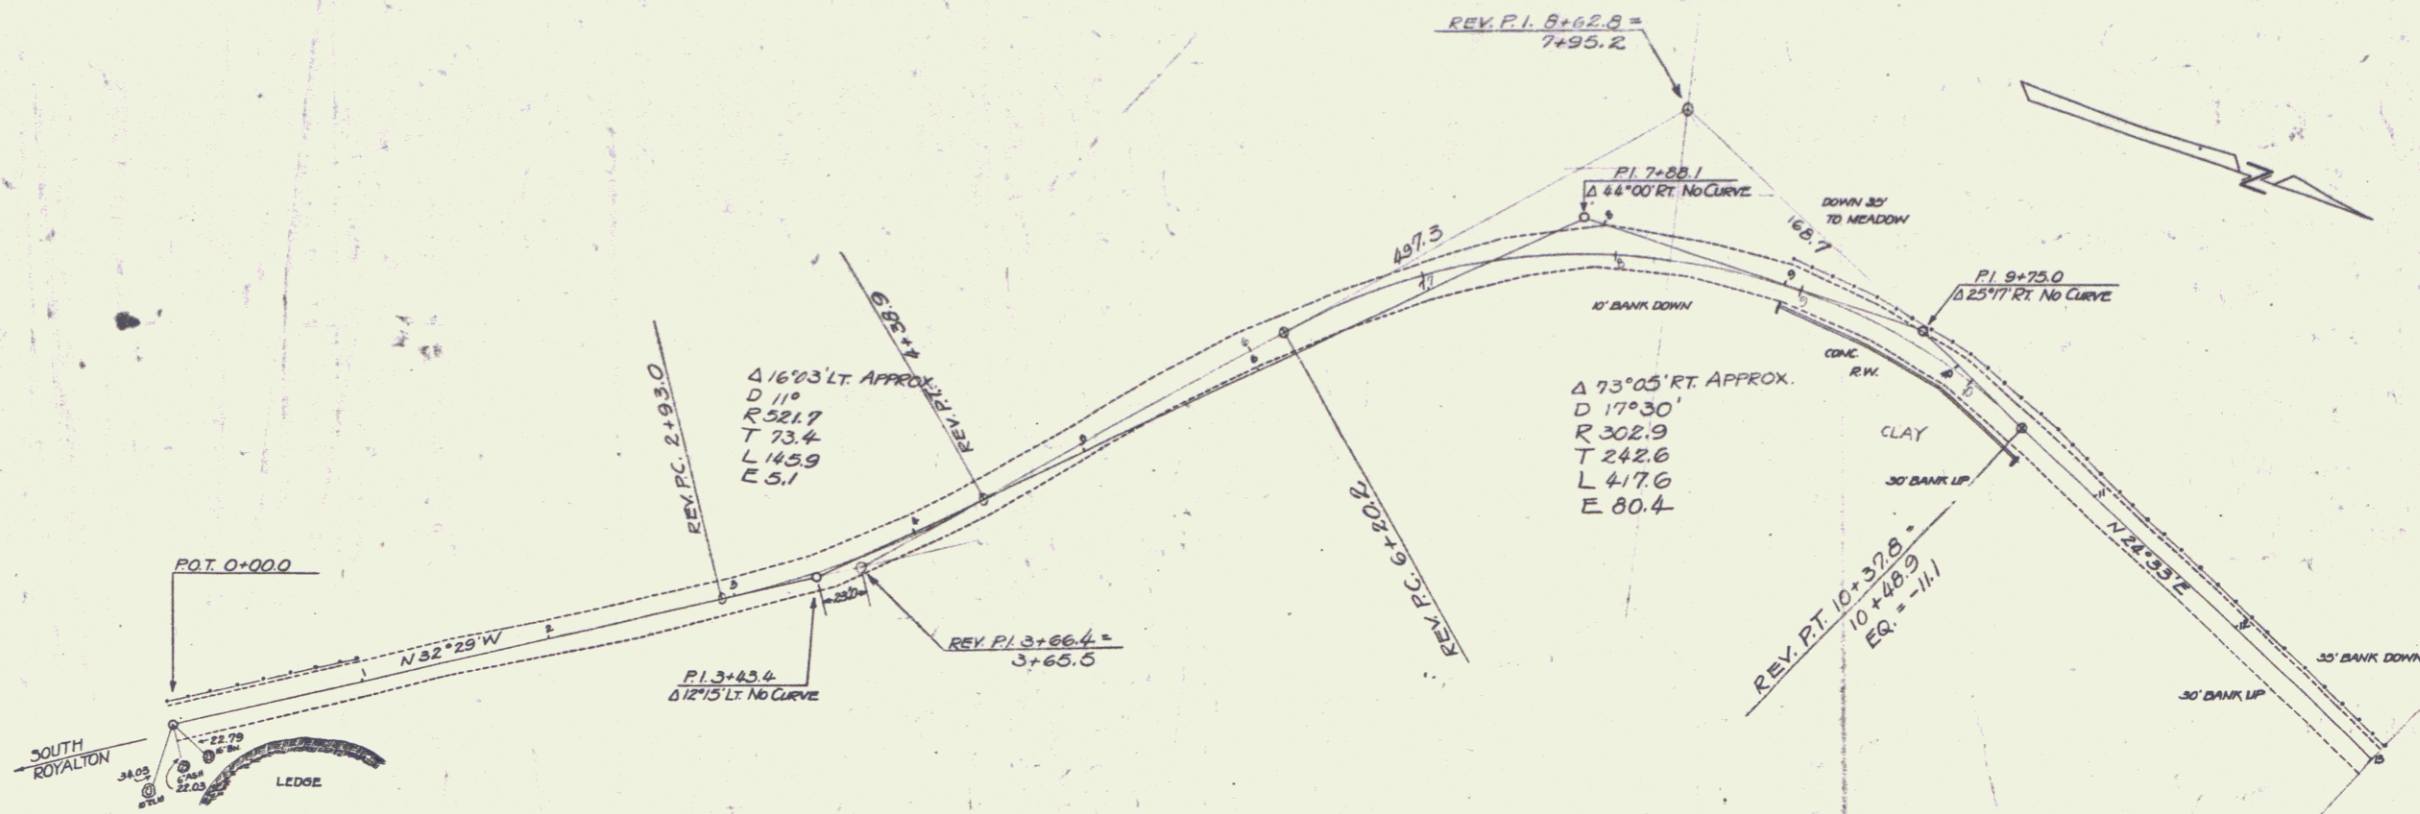

DATE
 1/20/50

PROJECT	NUMBER	DATE
PROJ. NO.	DATE	DATE
CONTRACTOR	TYPE	LOCATION
CONTRACTOR	TYPE	LOCATION
CONTRACTOR	TYPE	LOCATION

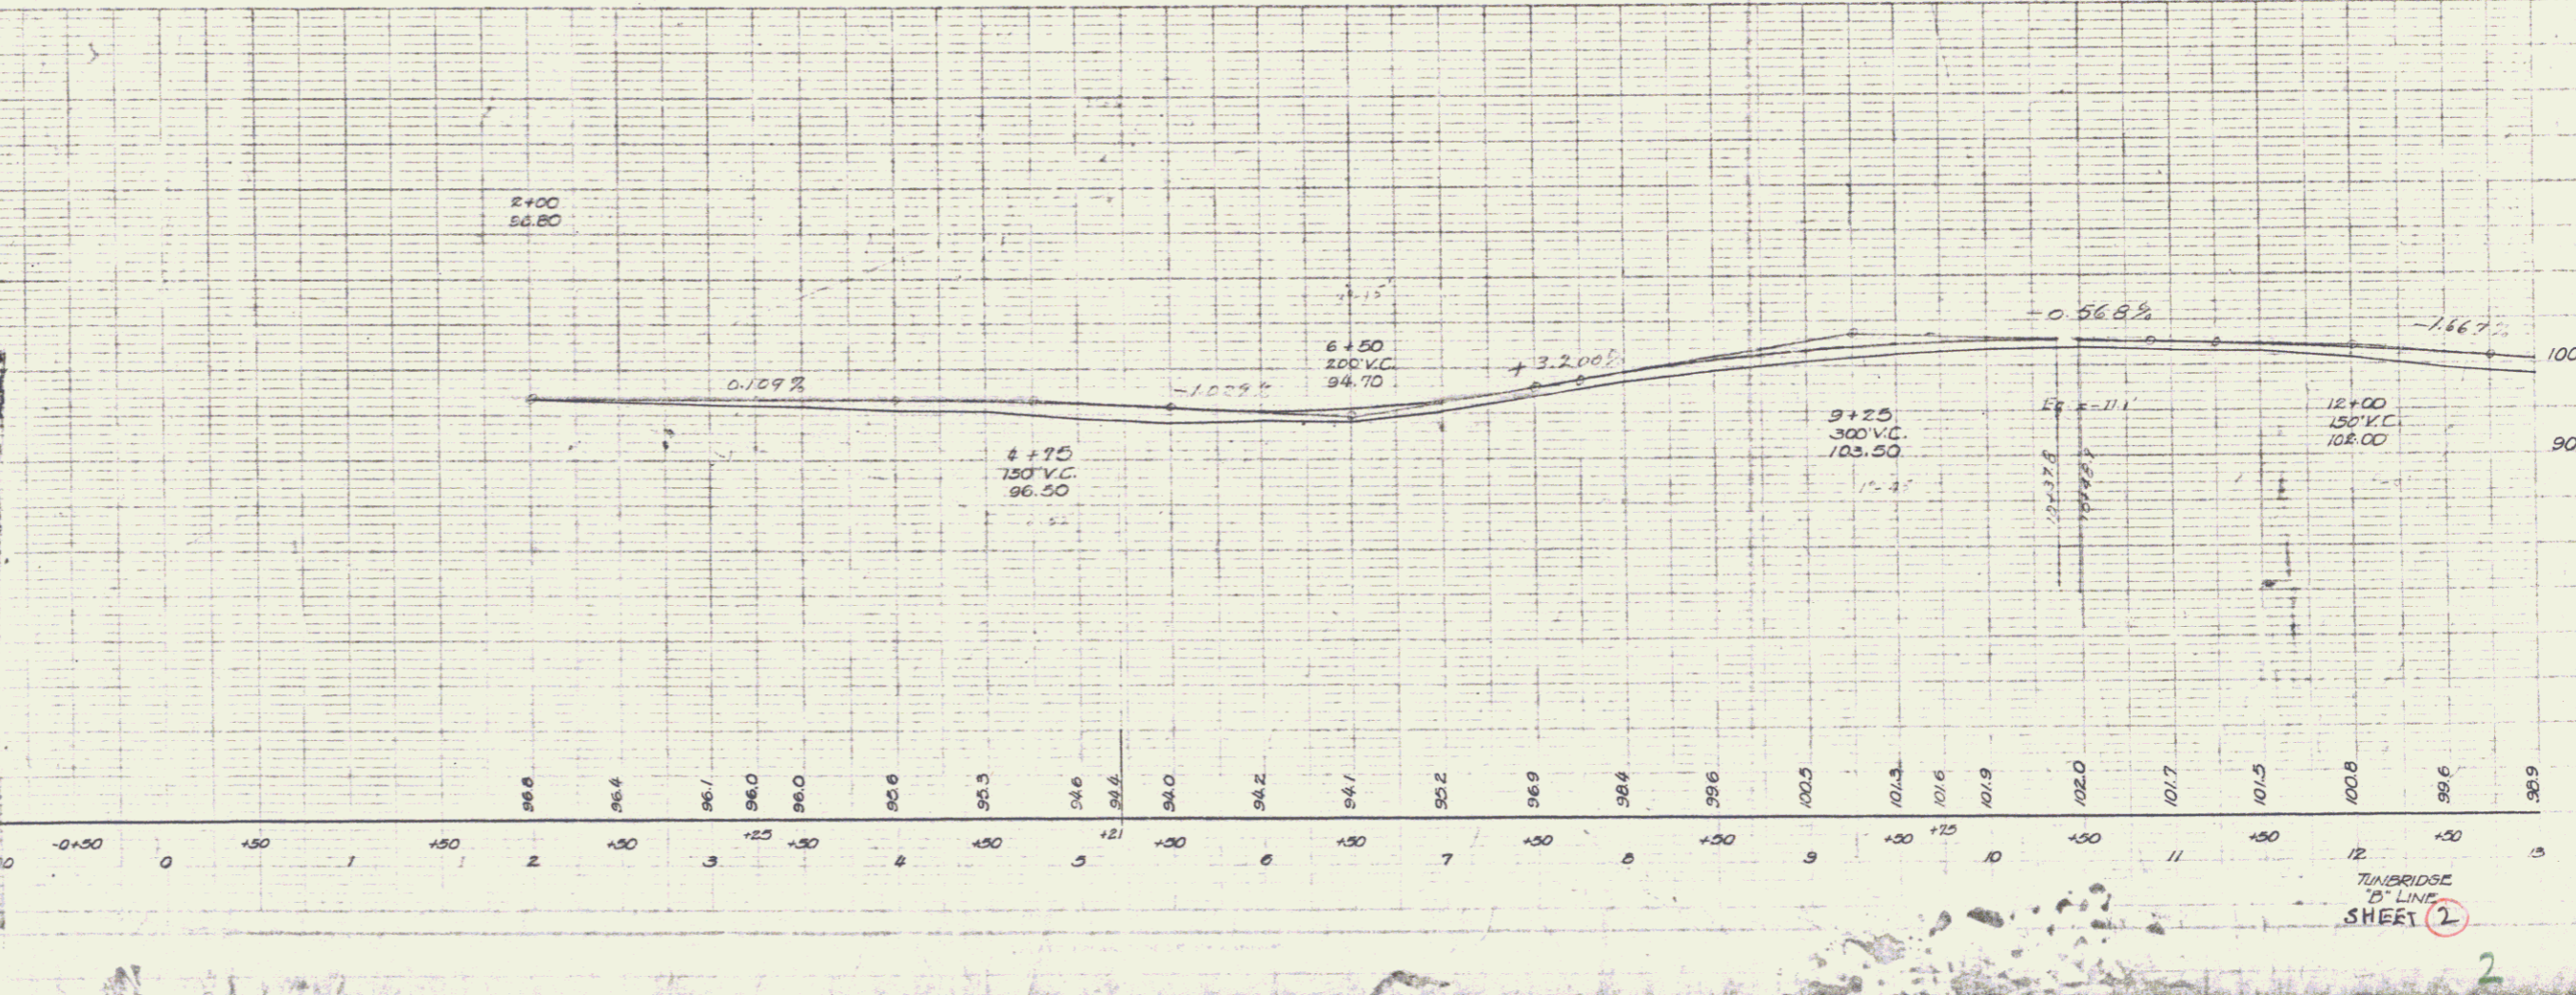

TIMBRIDGE
 10' LINE
 SHEET 2

PLAN
 SHEET BOOK
 DATE
 DRAWN BY
 CHECKED BY
 APPROVED BY

DATE
 DRAWN BY
 CHECKED BY
 APPROVED BY

