



PLAN
 DATE: 1948
 DRAWN BY: [Name]
 CHECKED BY: [Name]
 SCALE: 1" = 40'

PROFILE
 DATE: 1948
 DRAWN BY: [Name]
 CHECKED BY: [Name]
 SCALE: 1" = 40'

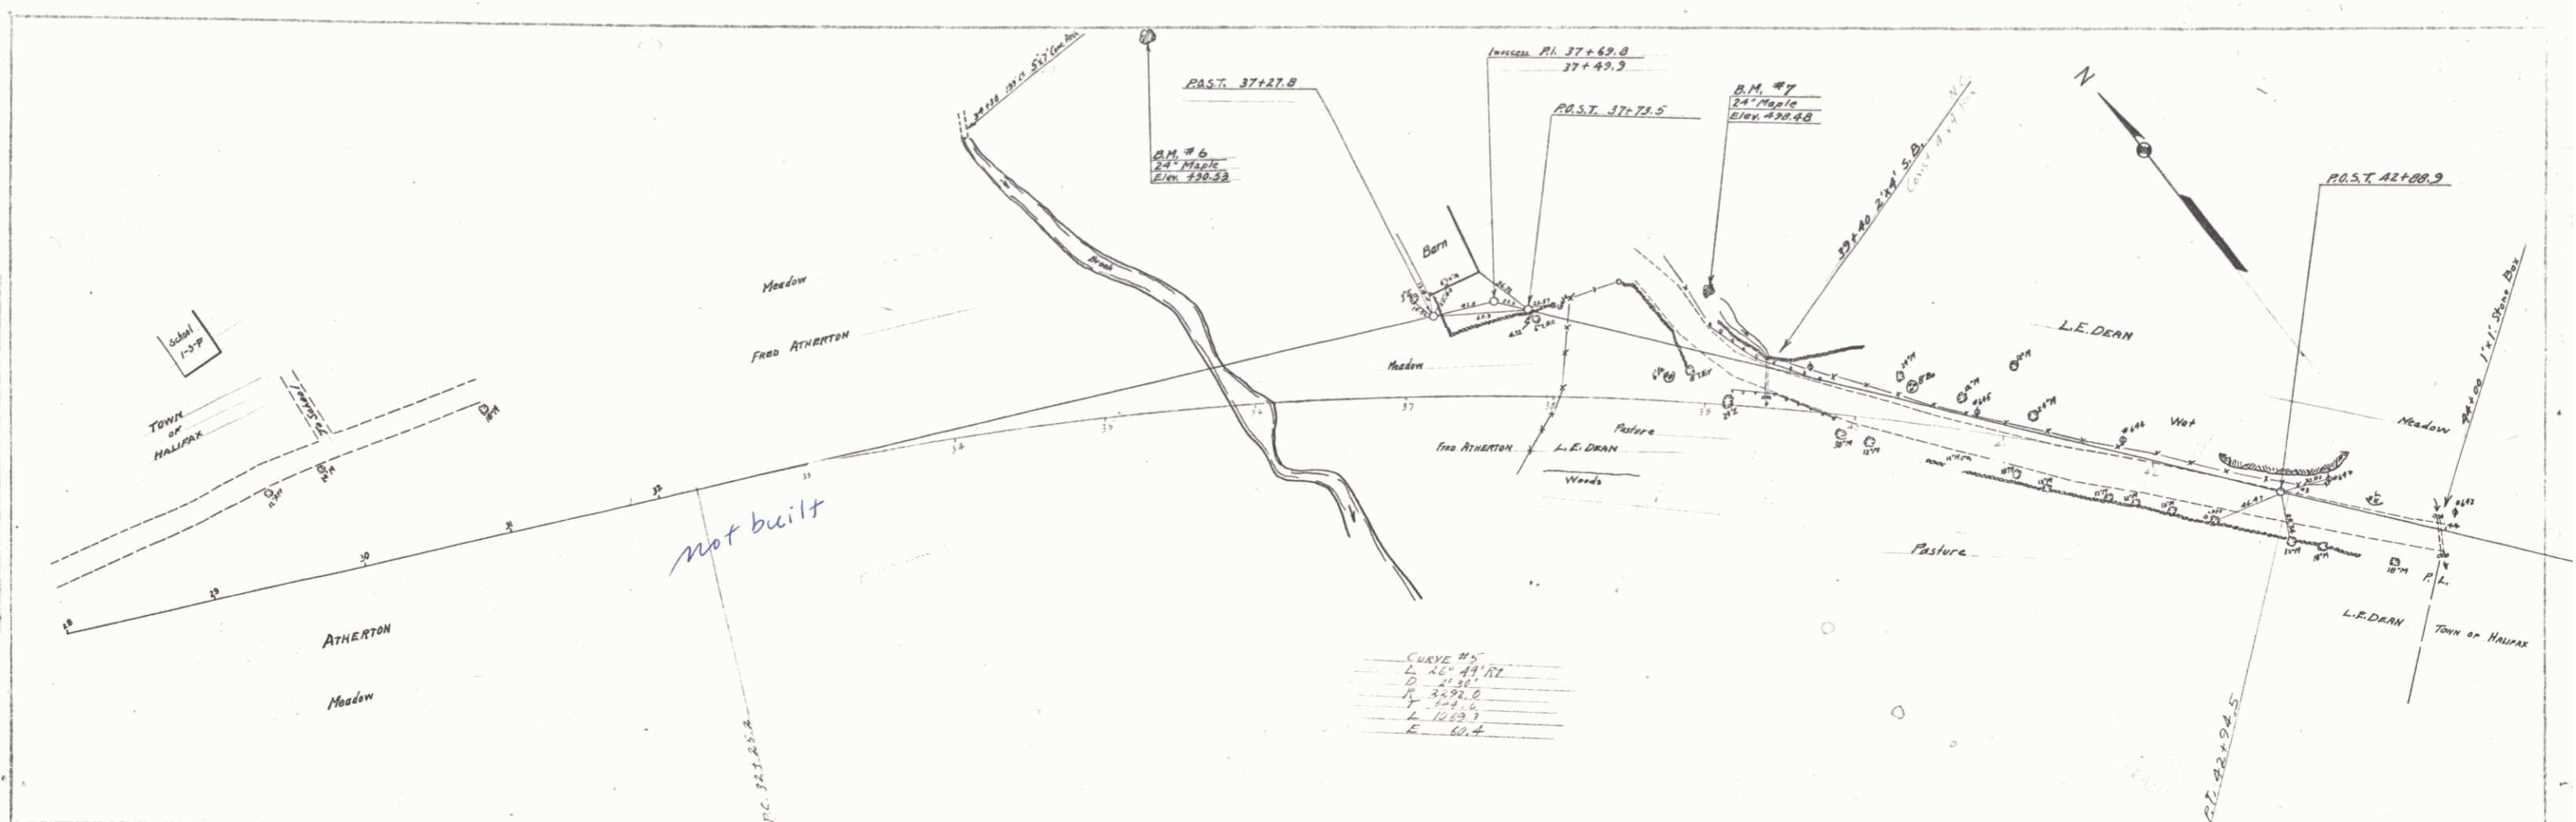

CURVE DATA

STATION	35+00
LC	125.0
PC	34+50
PT	35+50
EC	36+00
EA	36+00

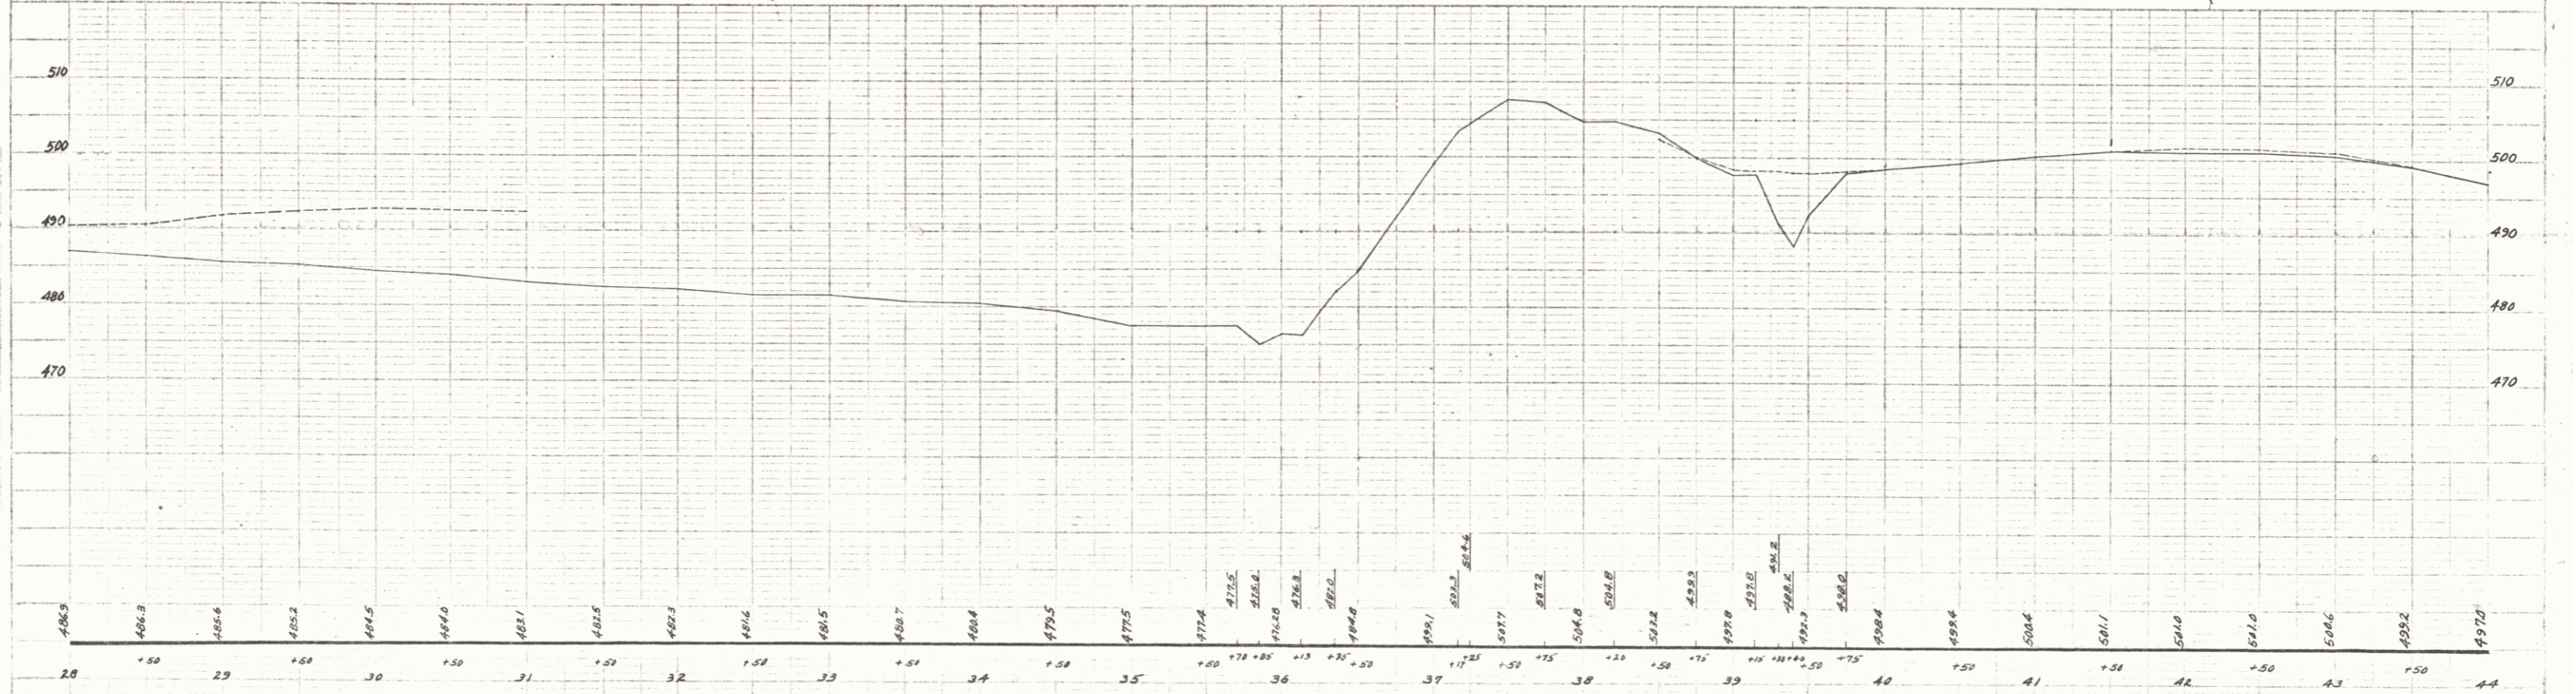

B.M. #6 SPIKE IN ROOT OF 24" MAPLE 250 FT. LT. OF STA 35+50 ELEV. 438.53
 B.M. #7 SPIKE IN ROOT OF 24" MAPLE 70 FT. LT. OF STA 38+37 ELEV. 438.46