
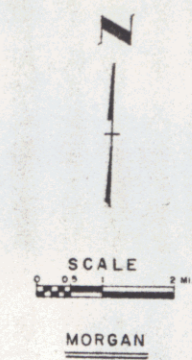



TOWN OF MORGAN
 COUNTY OF ORLEANS
 VT. ROUTE No III & STATE AID ROUTE No I
 DERBY CENTER - ISLAND POND ROAD

Pin# 00R073

BEGINNING AT THE HOLLAND-MORGAN TOWN LINE
 AND EXTENDING SOUTHEASTERLY 11. MILES
 TO THE MORGAN - BRIGHTON TOWN LINE.
 LENGTH OF PROJECT 60, FEET=11. MILES

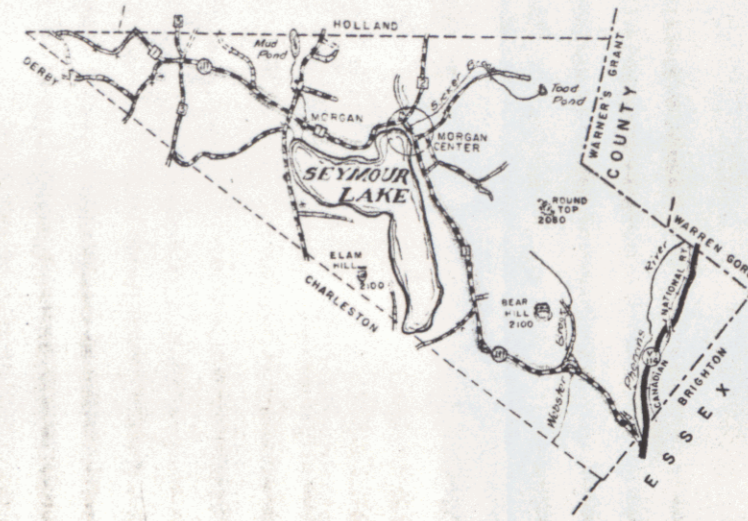


Project No. MP 0.00 - 11.064
 RIGHT-OF-WAY DIVISION
 TOWN FILE
 PERPETUAL
 Date 1/11/67
 Town of Ut 111
 (To Be Returned To R.O.W. Division)


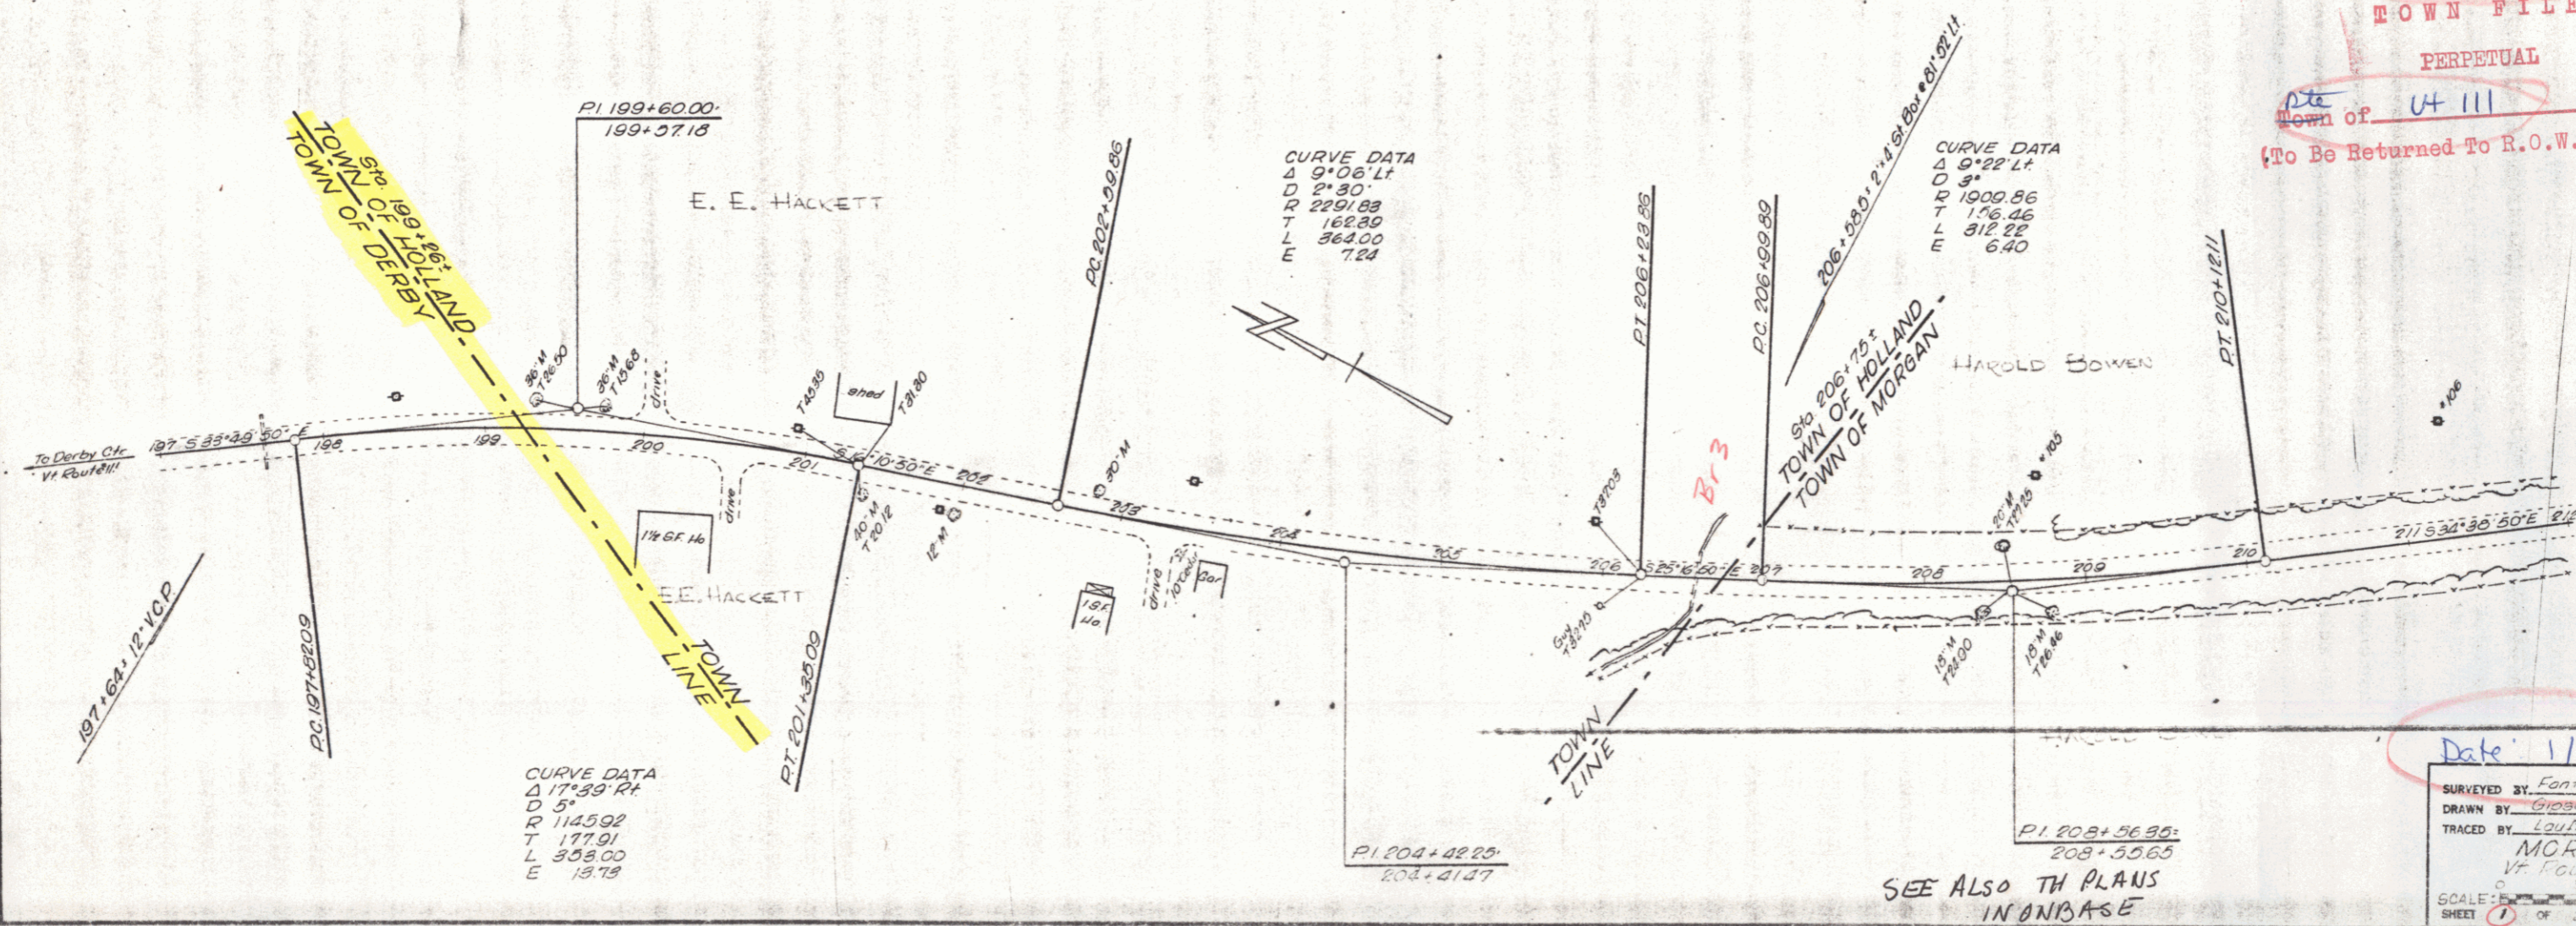


SEE ALSO TH PLANS
 IN ONBASE


Date: 1/11/67
 SURVEYED BY: Fantoni DATE: 1-67
 DRAWN BY: Gibson DATE: 1-67
 TRACED BY: Louman DATE: 1-67
 MORGAN
 Vt Route # 111
 SCALE: 1" = 100 FEET
 SHEET 1 OF 2


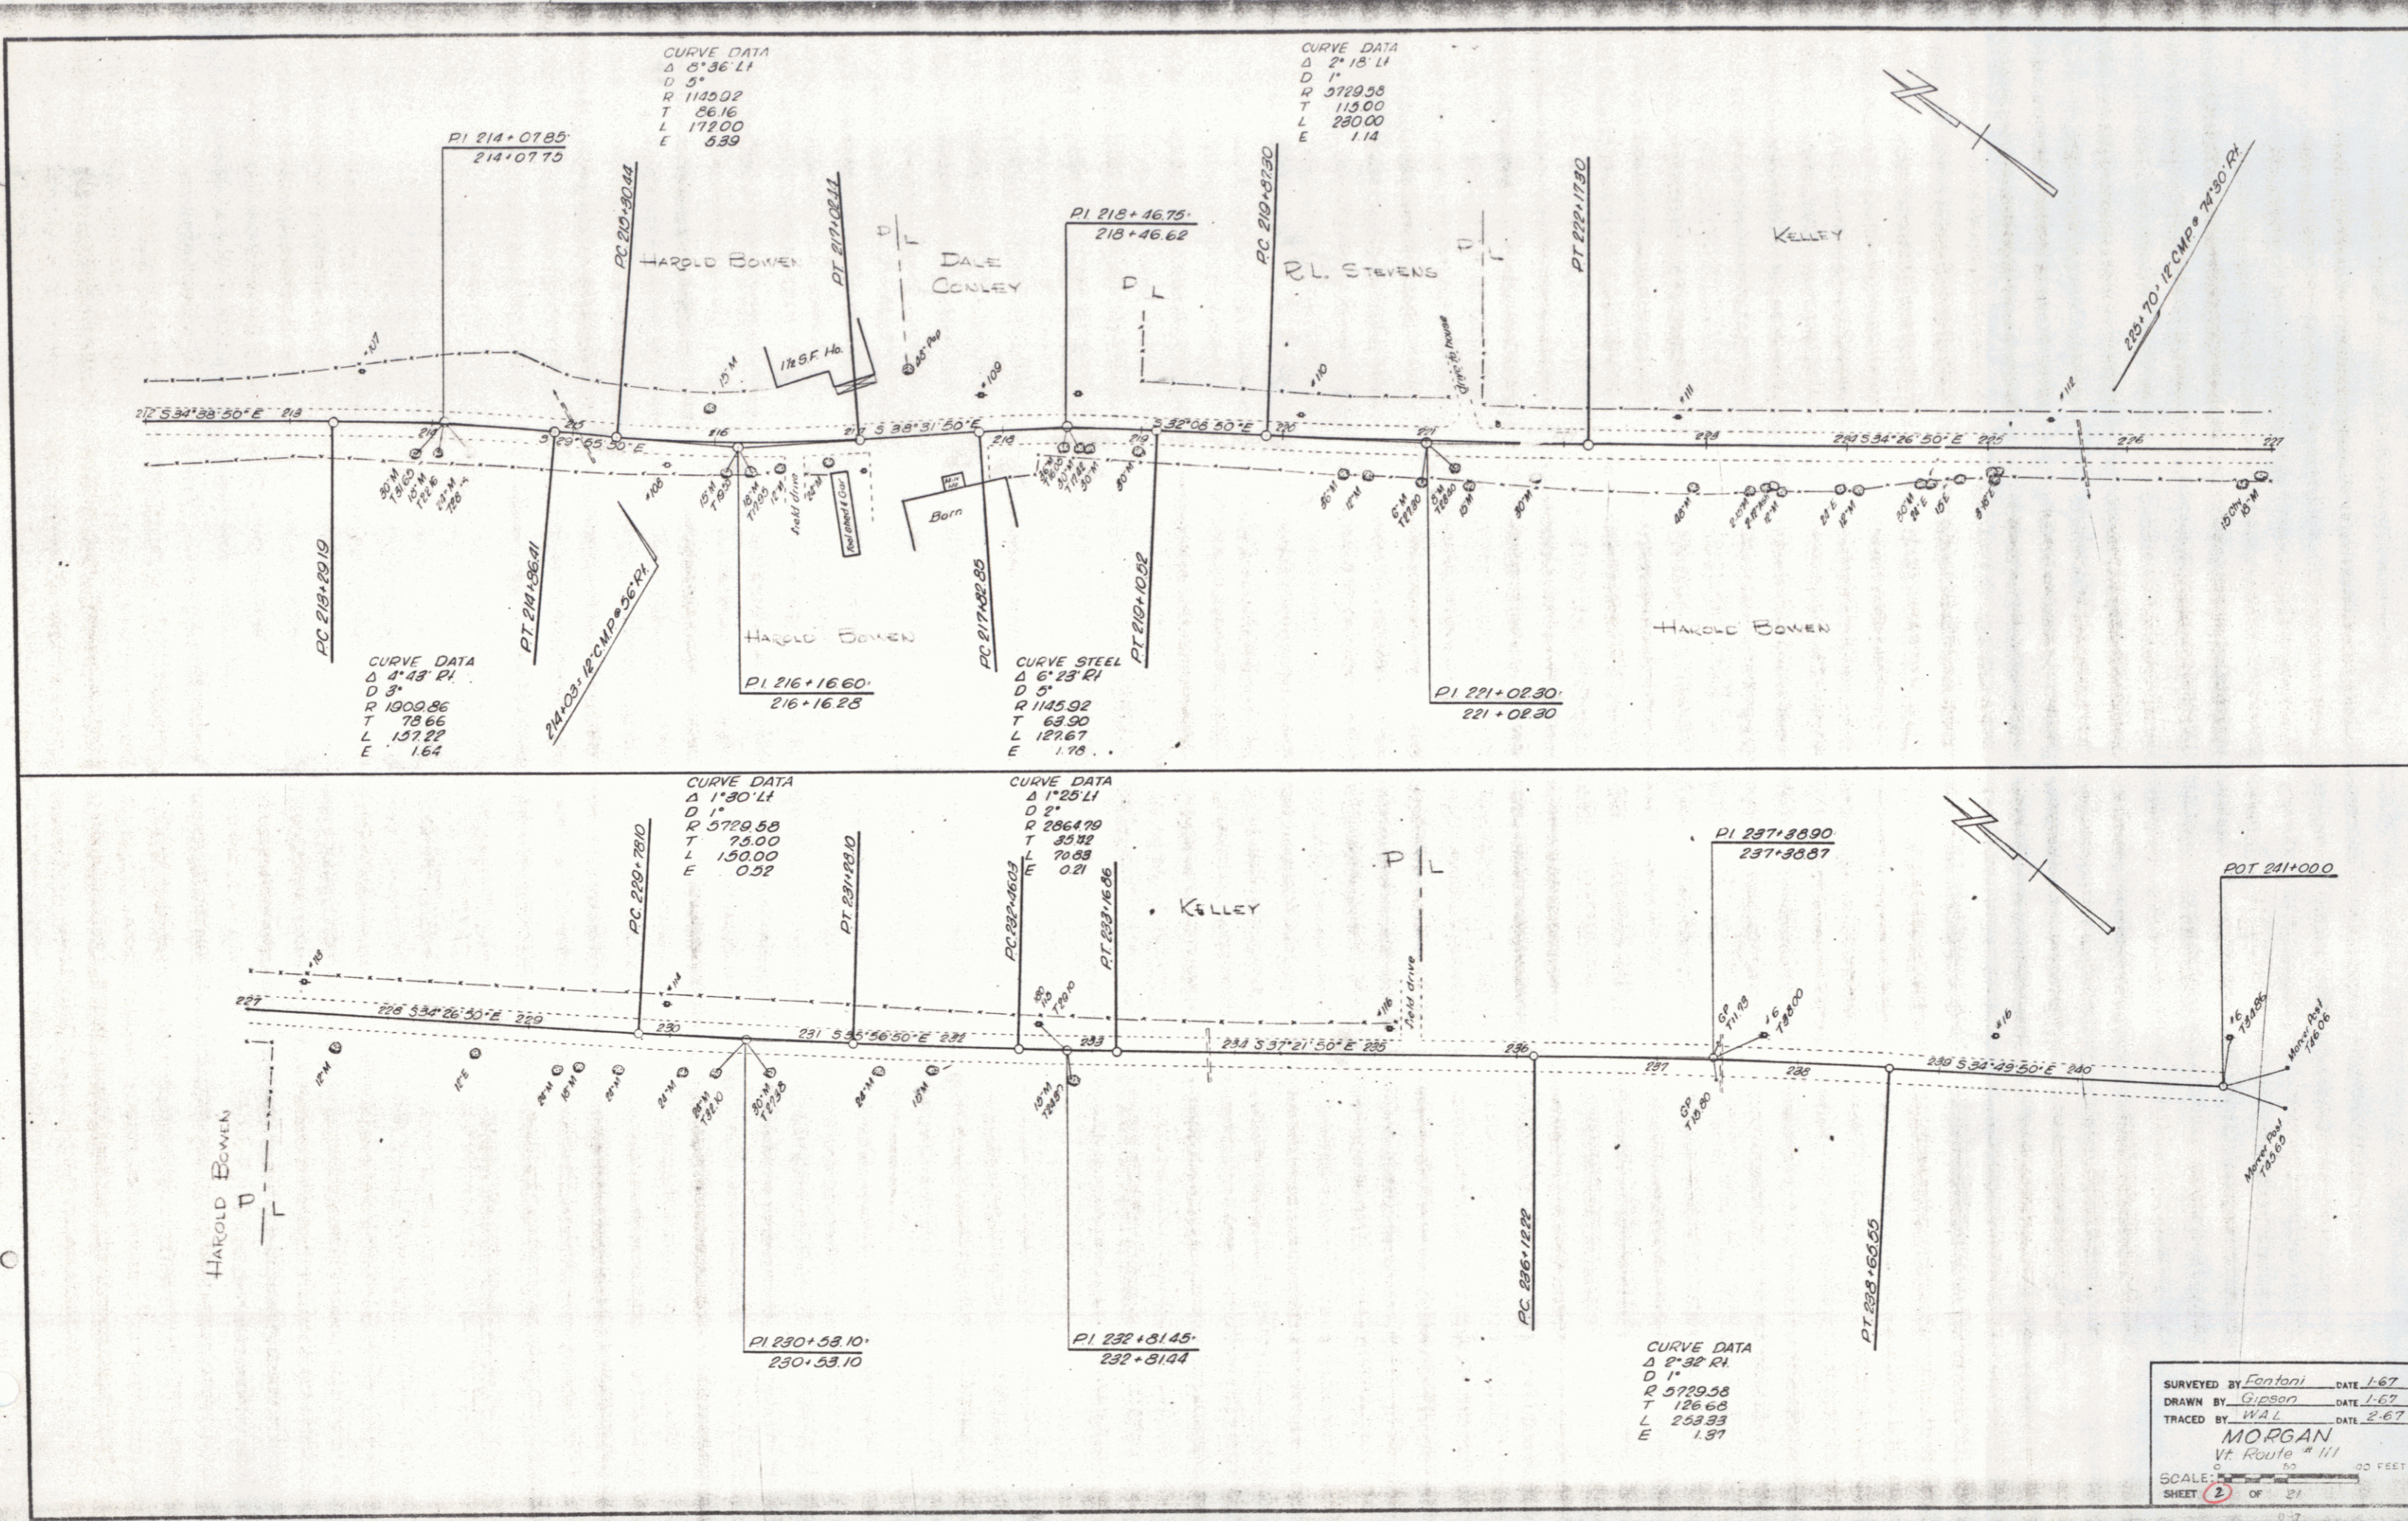


SURVEYED BY *Fantoni* DATE *1-67*
 DRAWN BY *Gipson* DATE *1-67*
 TRACED BY *WAL* DATE *2-67*
MORGAN
 Vt Route # 111
 SCALE: 1" = 20 FEET
 SHEET **2** OF 21

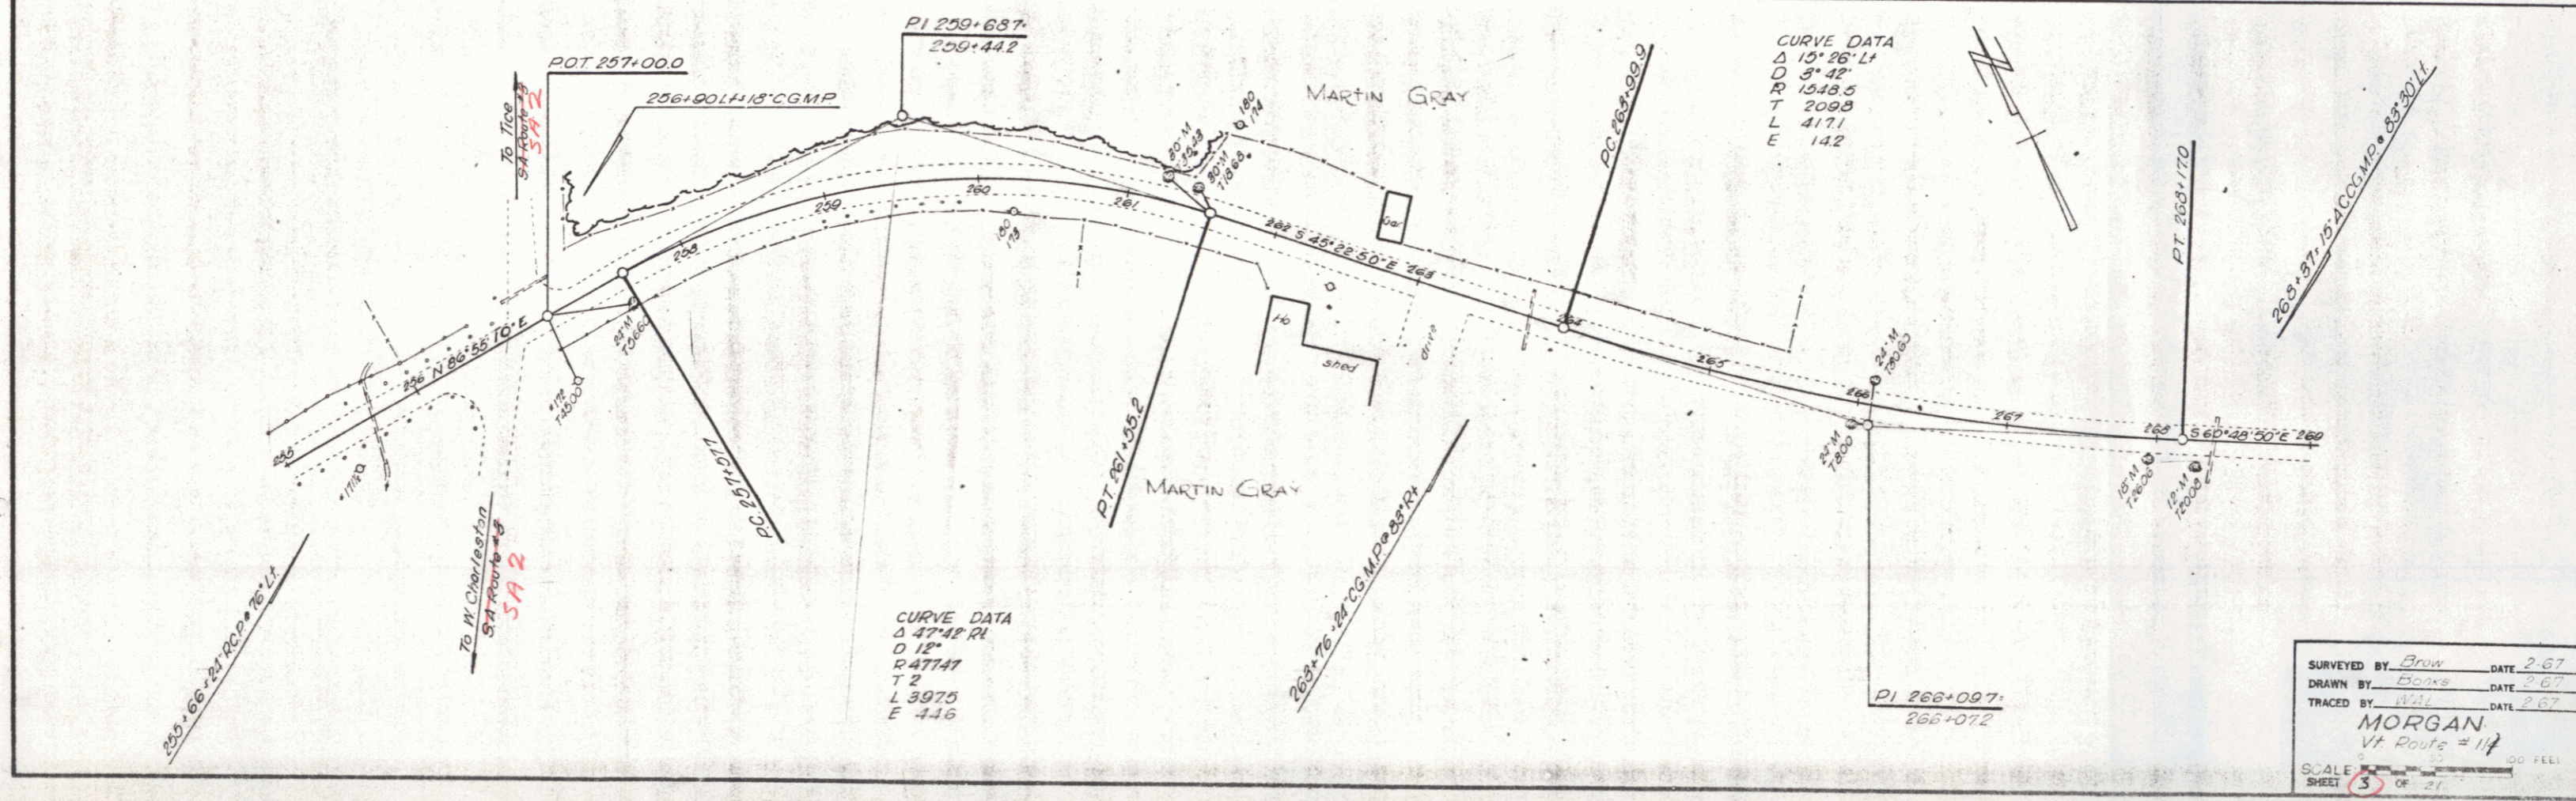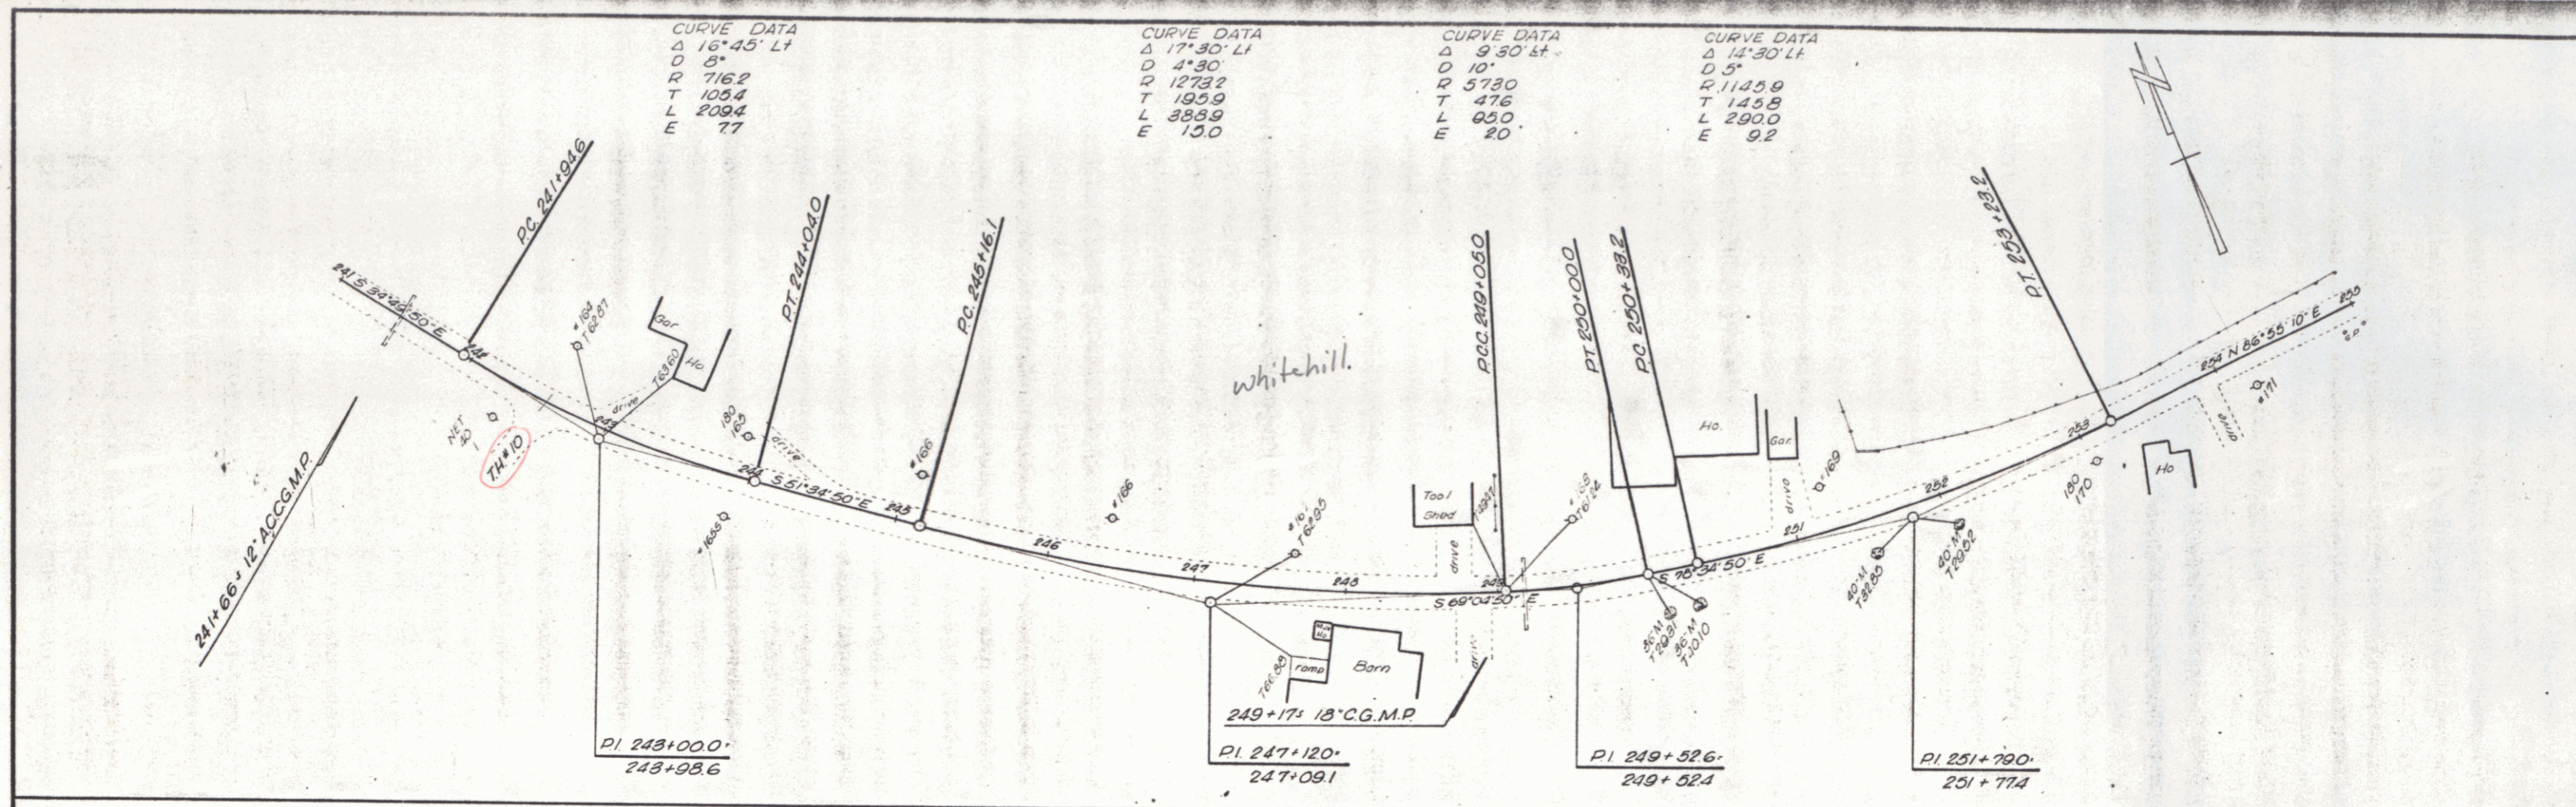


SURVEYED BY Bru DATE 2-67
 DRAWN BY Bru DATE 2-67
 TRACED BY Wile DATE 2-67
MORGAN
 Vt. Route # 117
 SCALE 3" = 100 FEET
 SHEET 3 OF 27


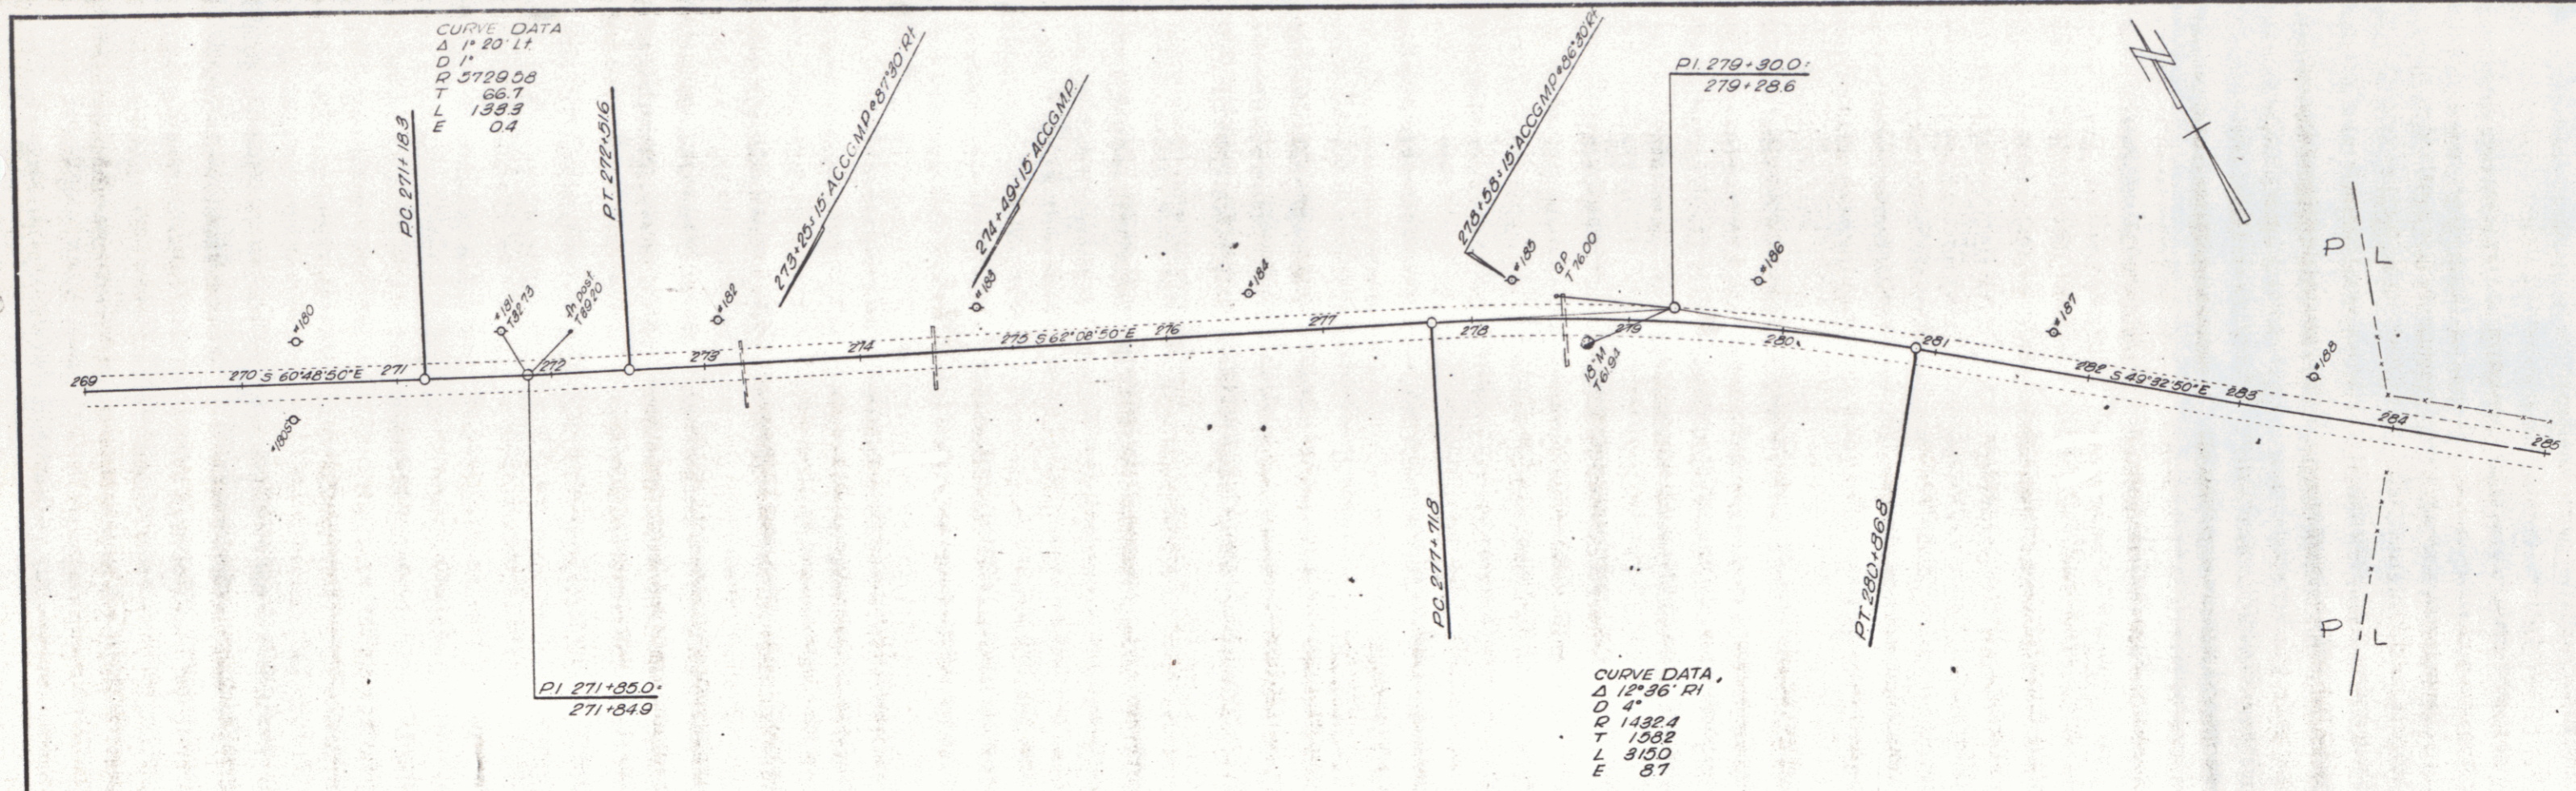


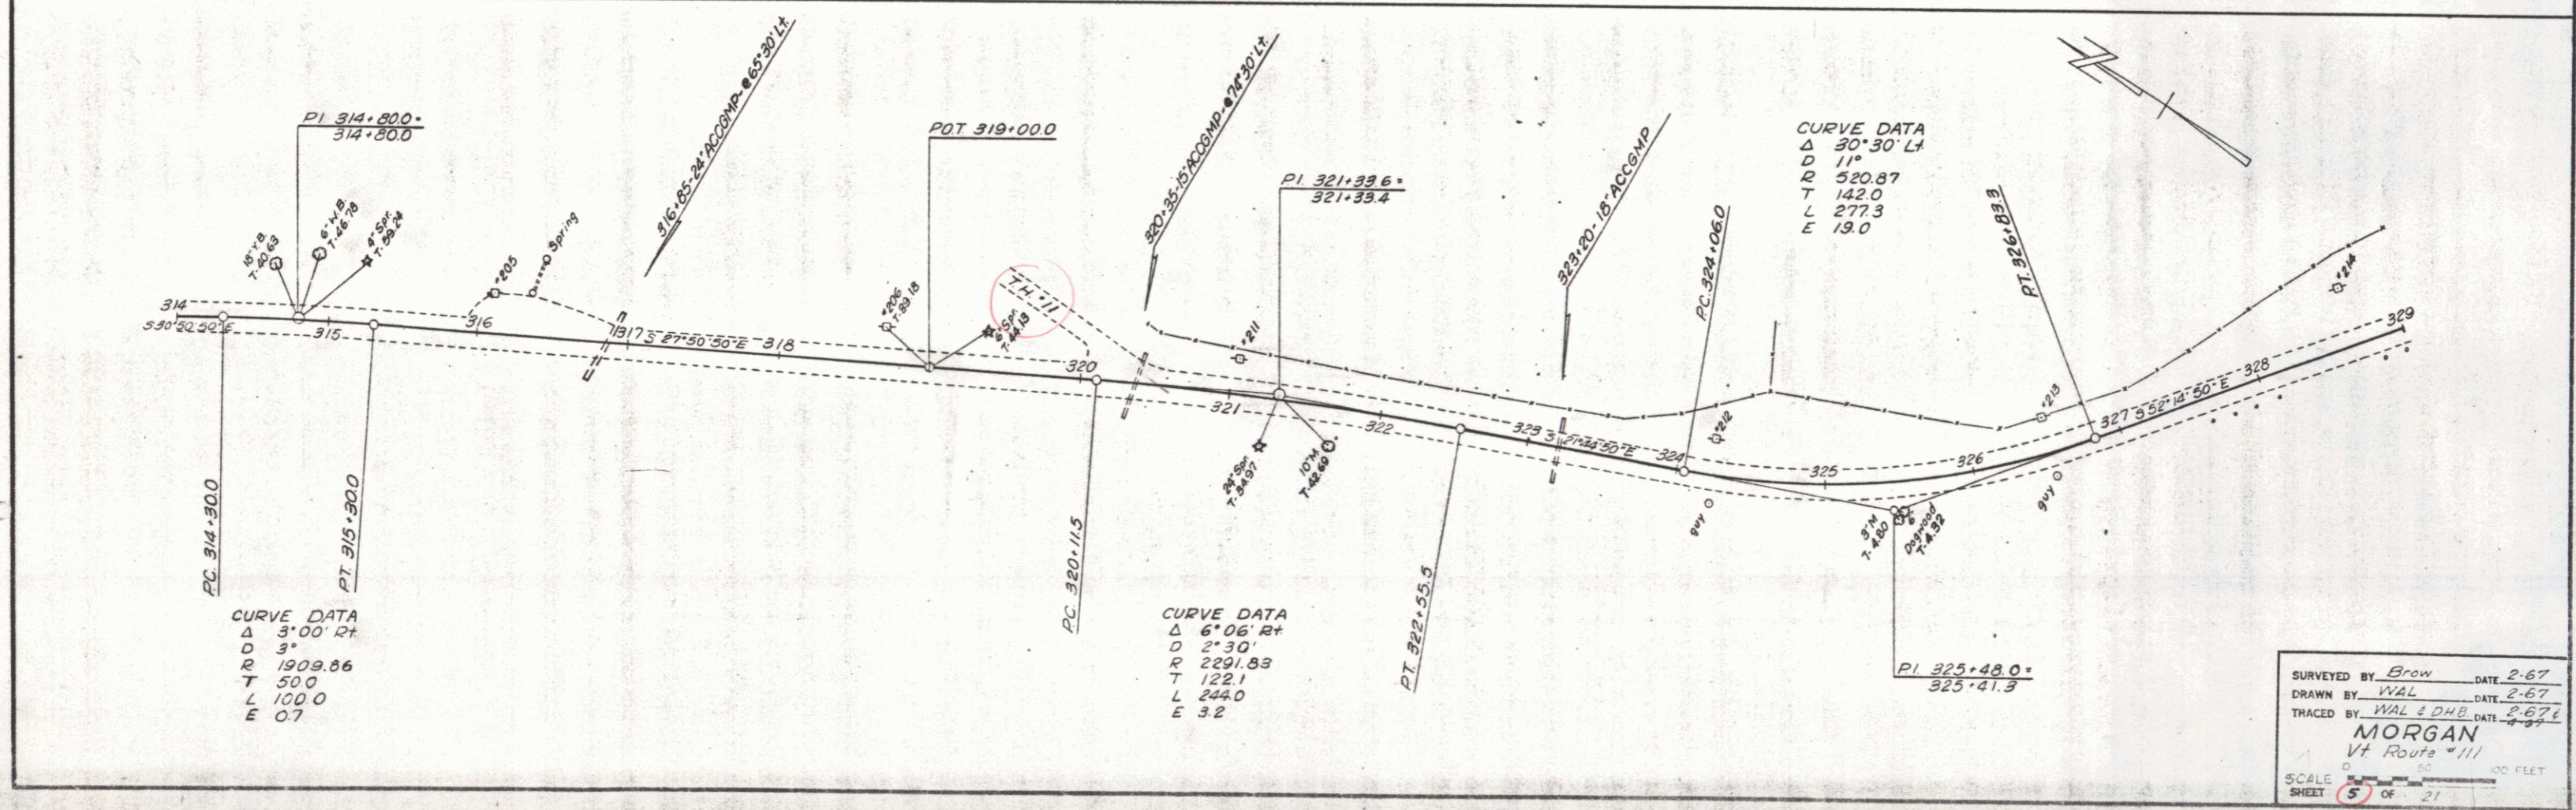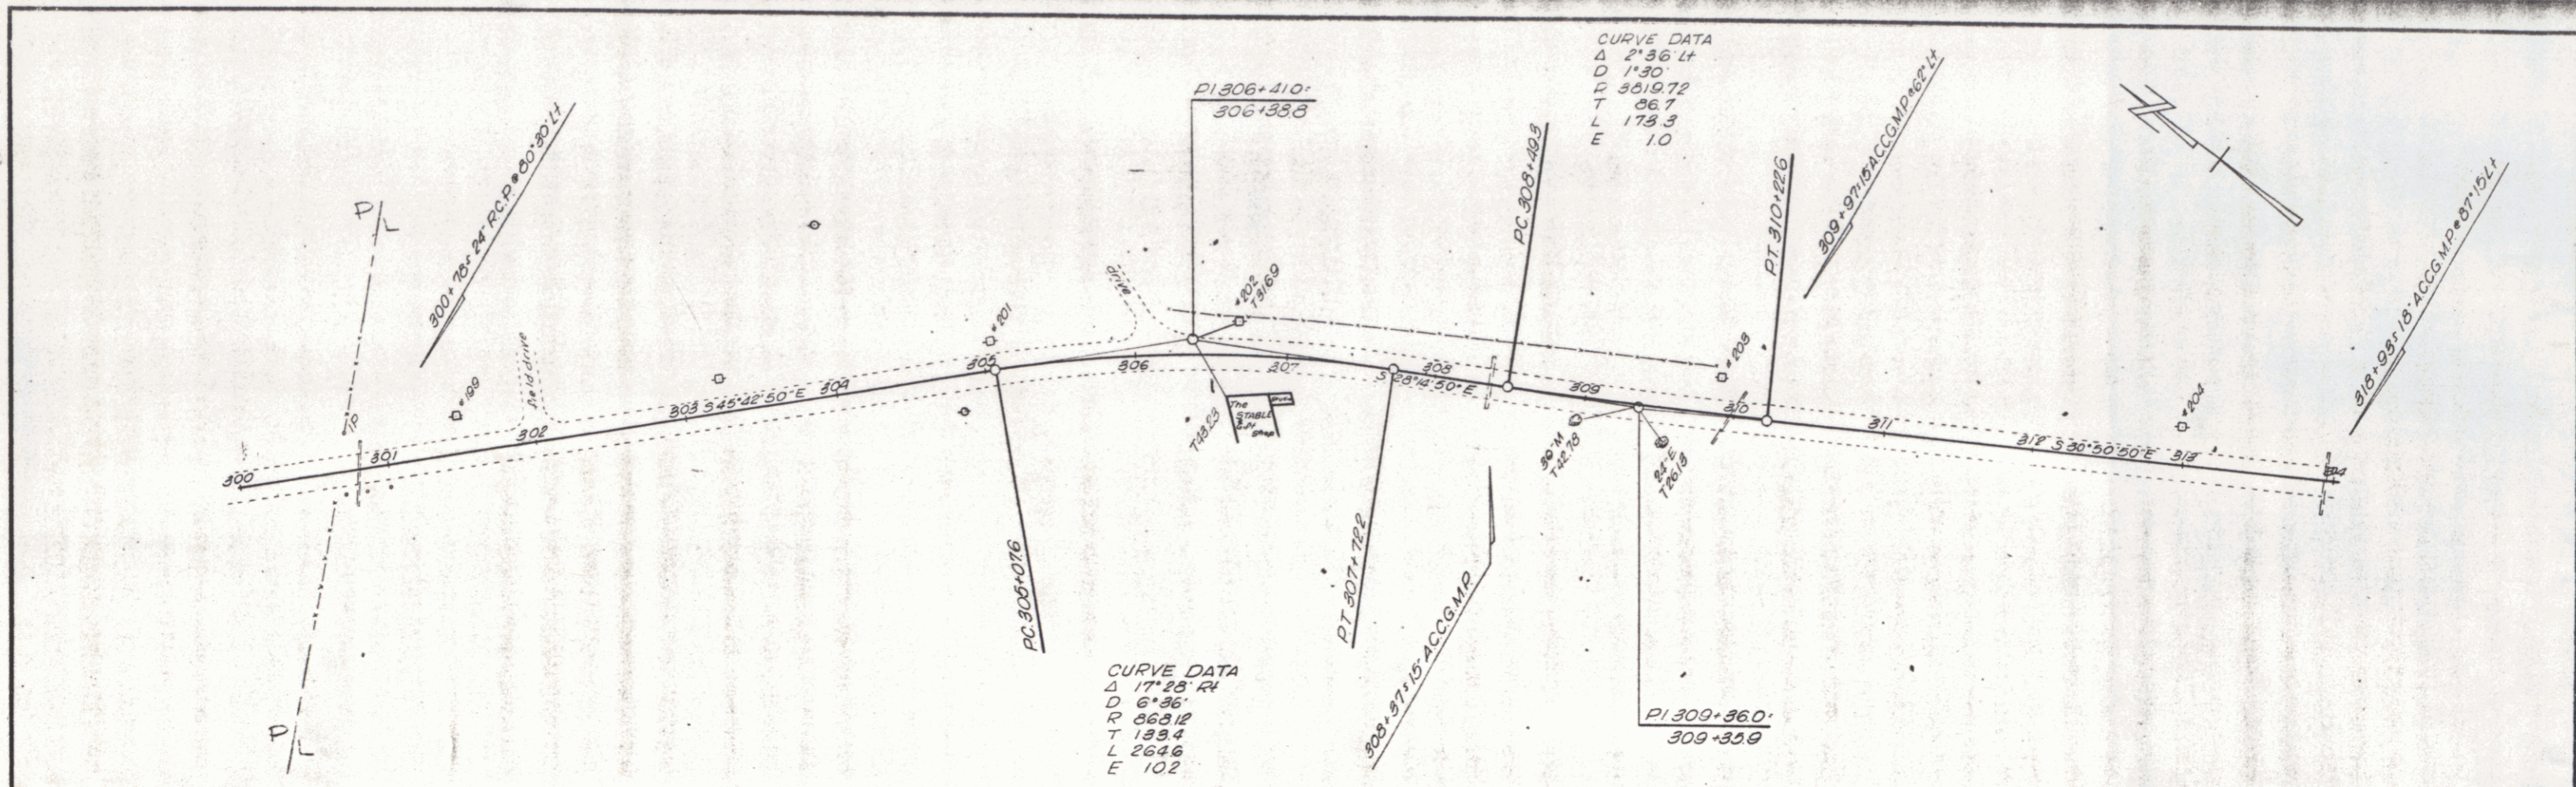



SURVEYED BY Brow DATE 2-67
 DRAWN BY WAL DATE 2-67
 THACED BY WAL & DHE DATE 2-67
MORGAN
 Vt Route #111
 SCALE 1" = 50' FEET
 SHEET 5 OF 21

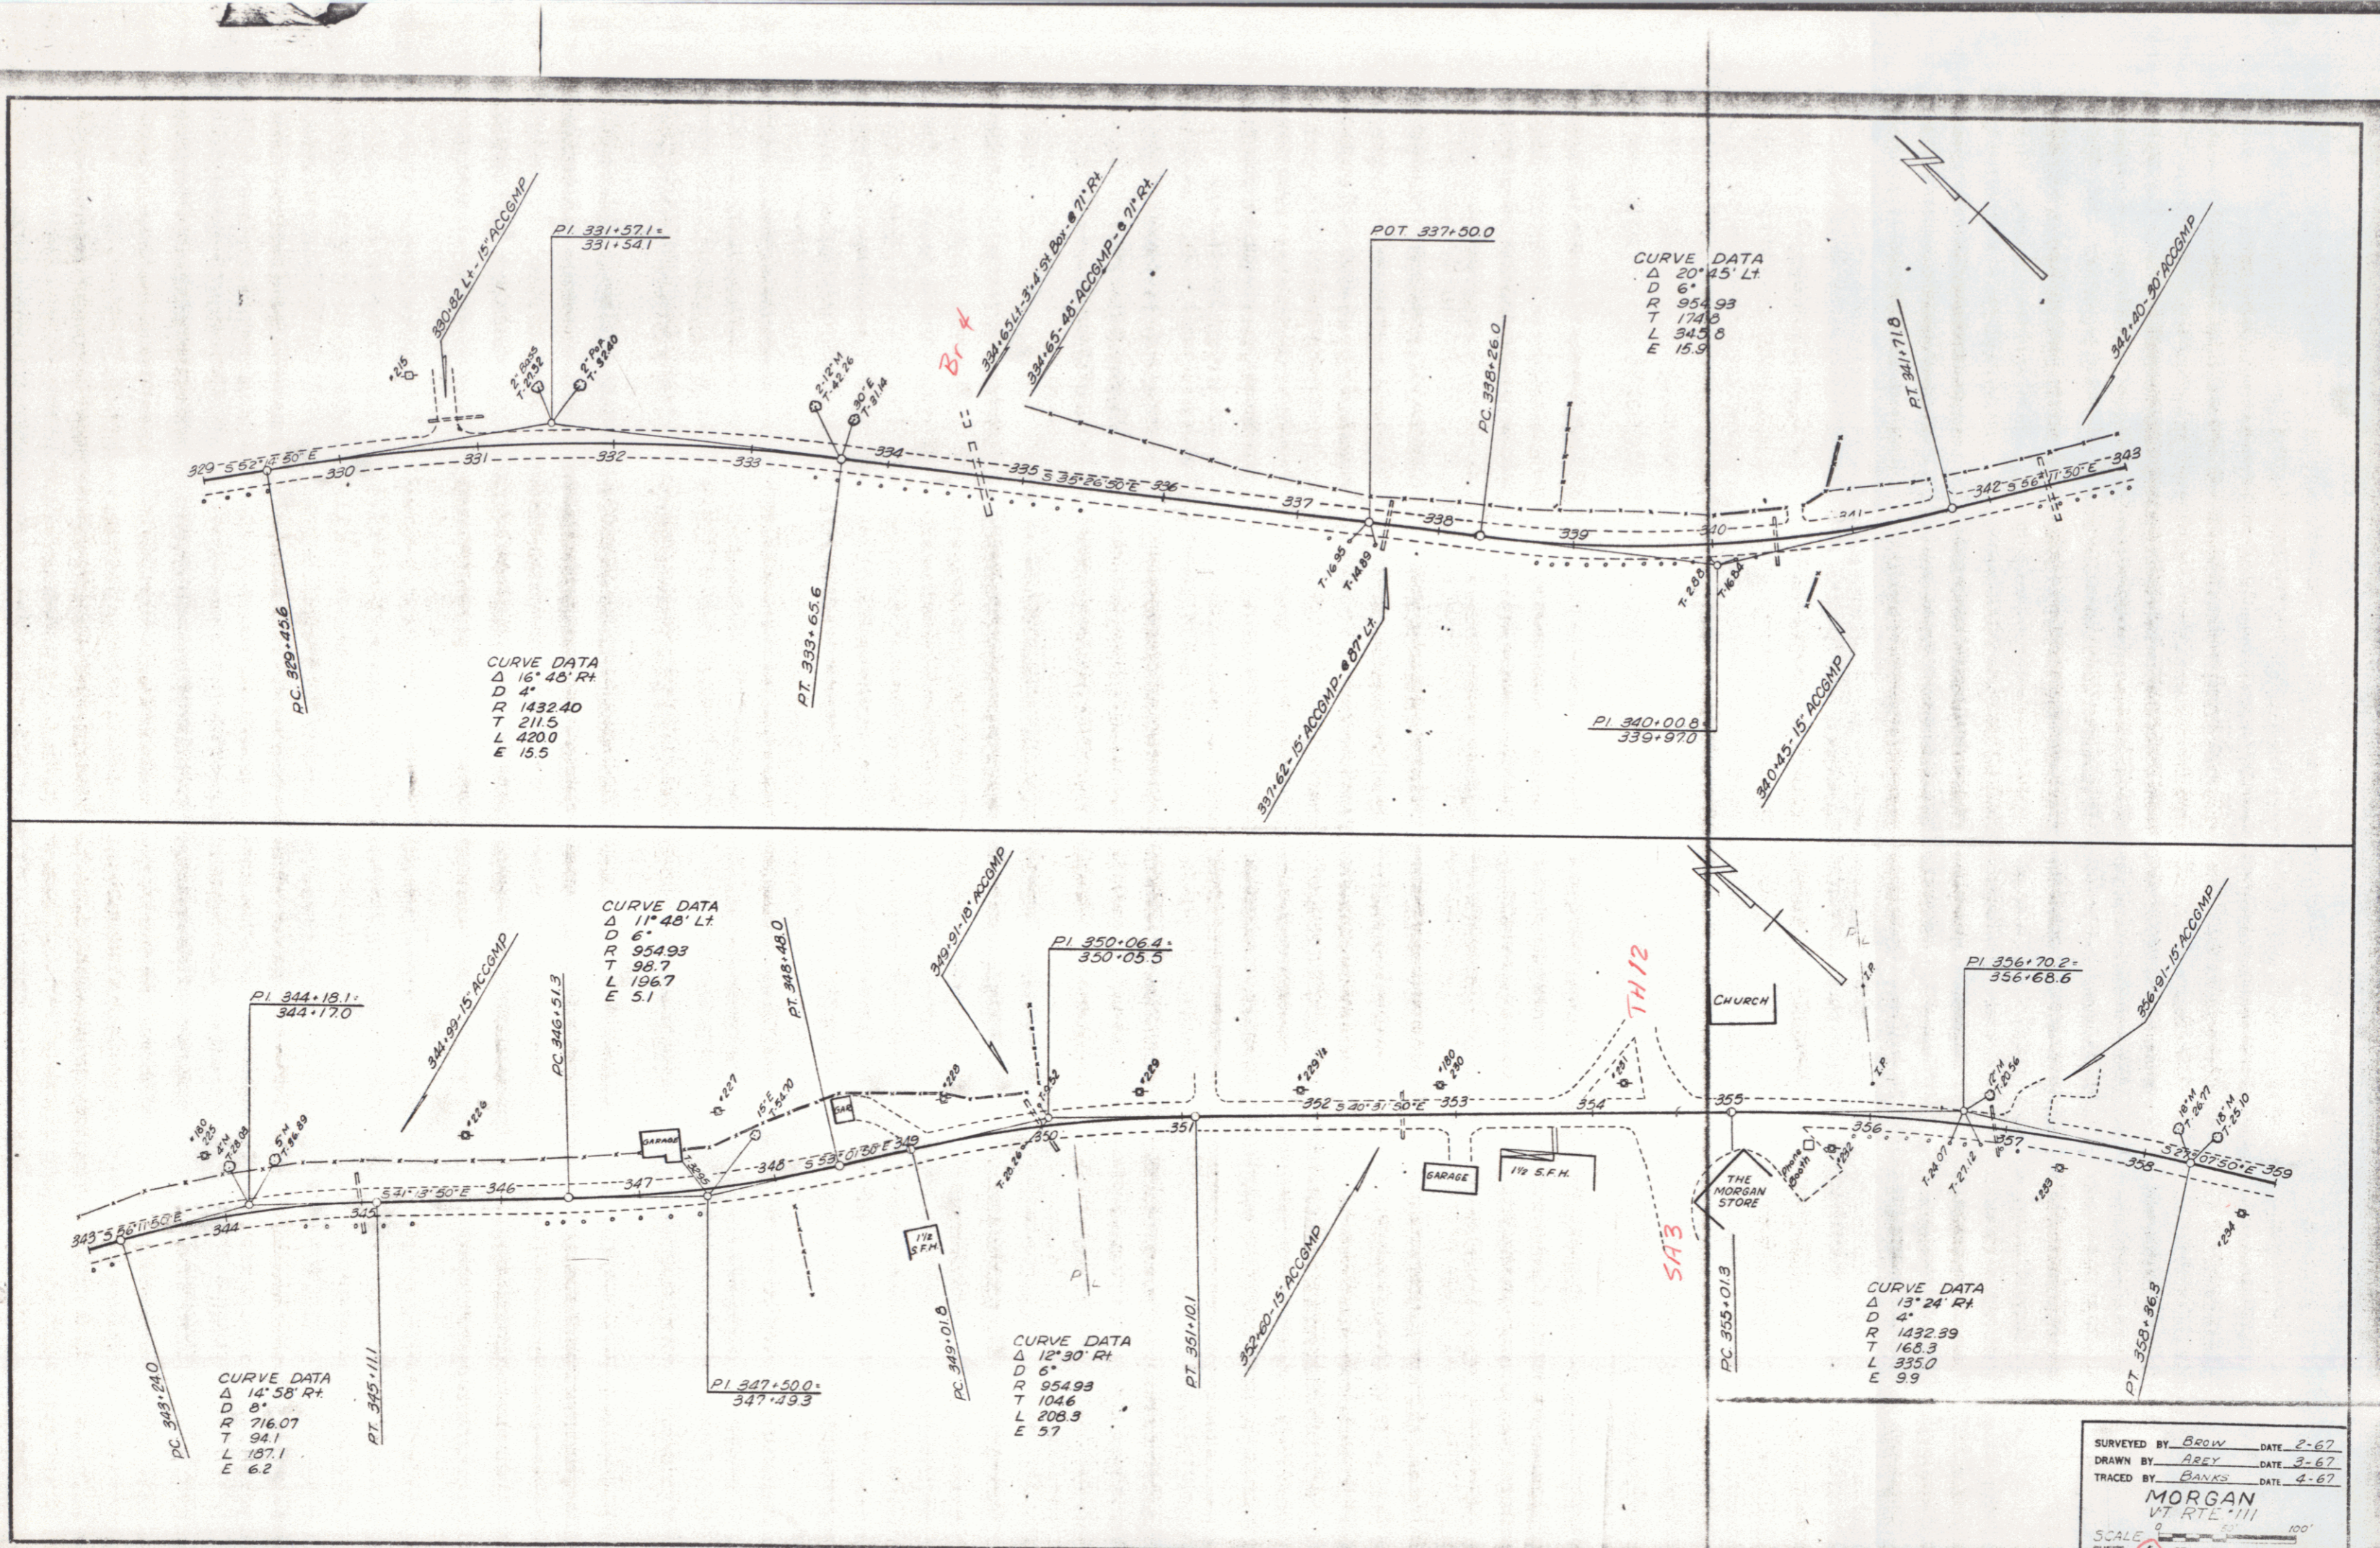

SURVEYED BY BROW DATE 2-67
 DRAWN BY AREY DATE 3-67
 TRACED BY BANKS DATE 4-67
MORGAN
 VT RTE 111
 SCALE 1" = 100'
 SHEET 6 OF 21
 D-7

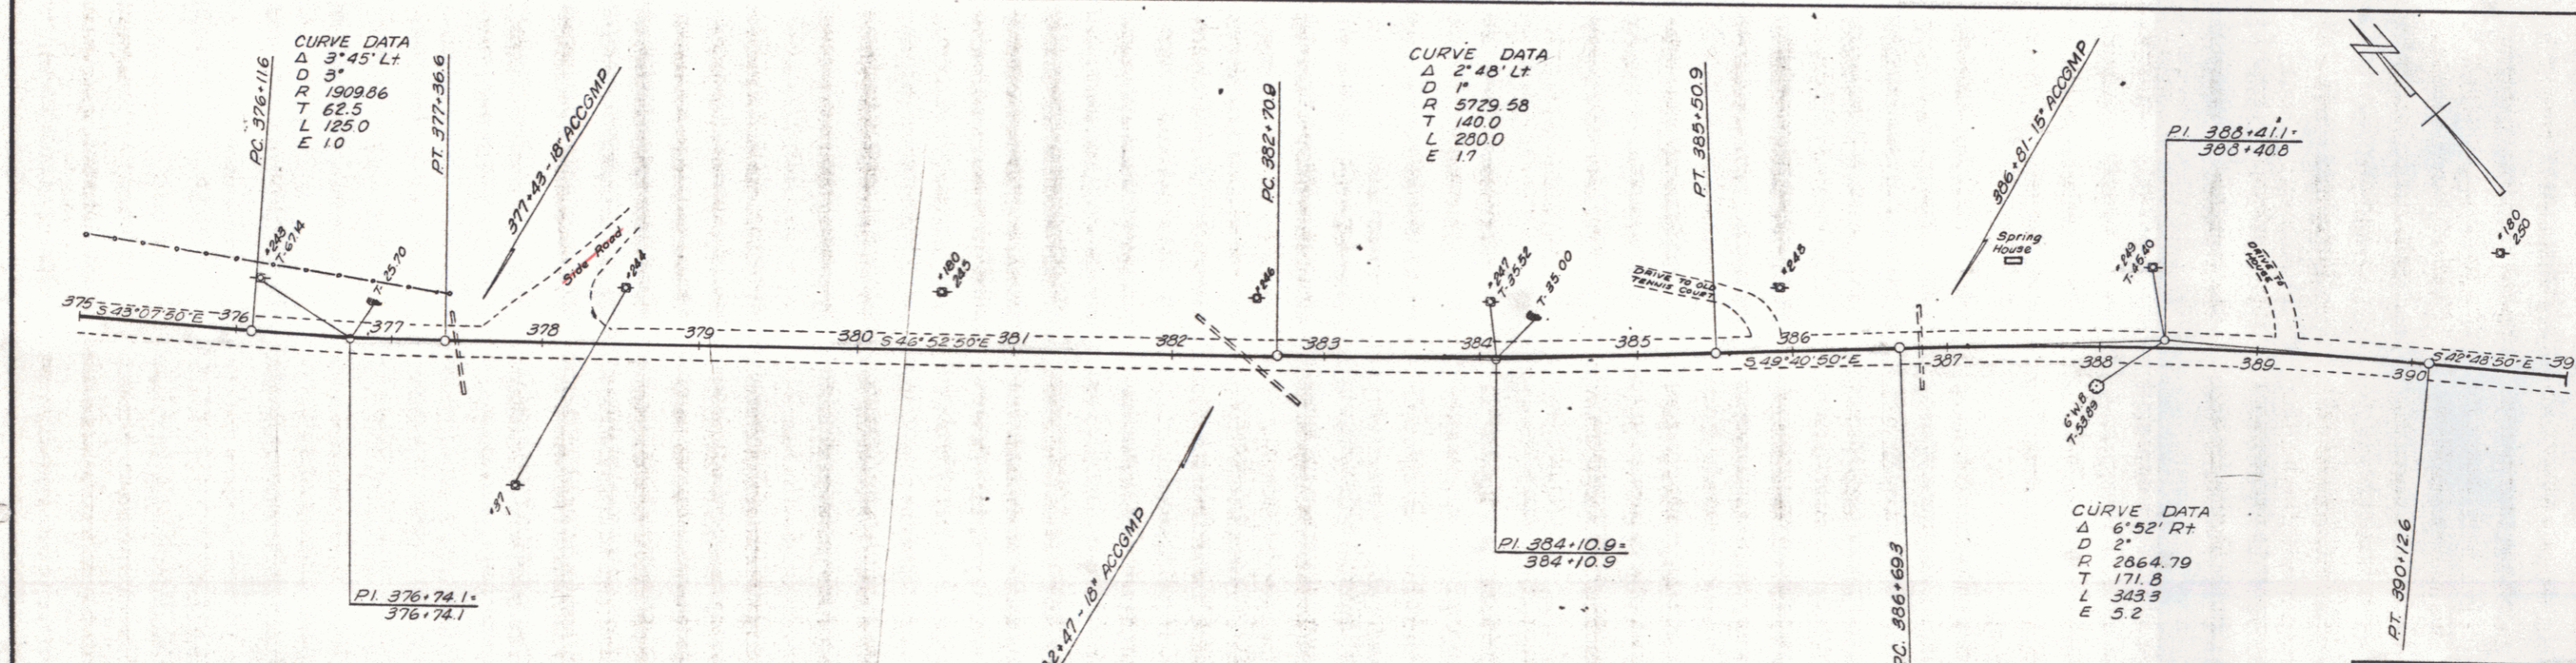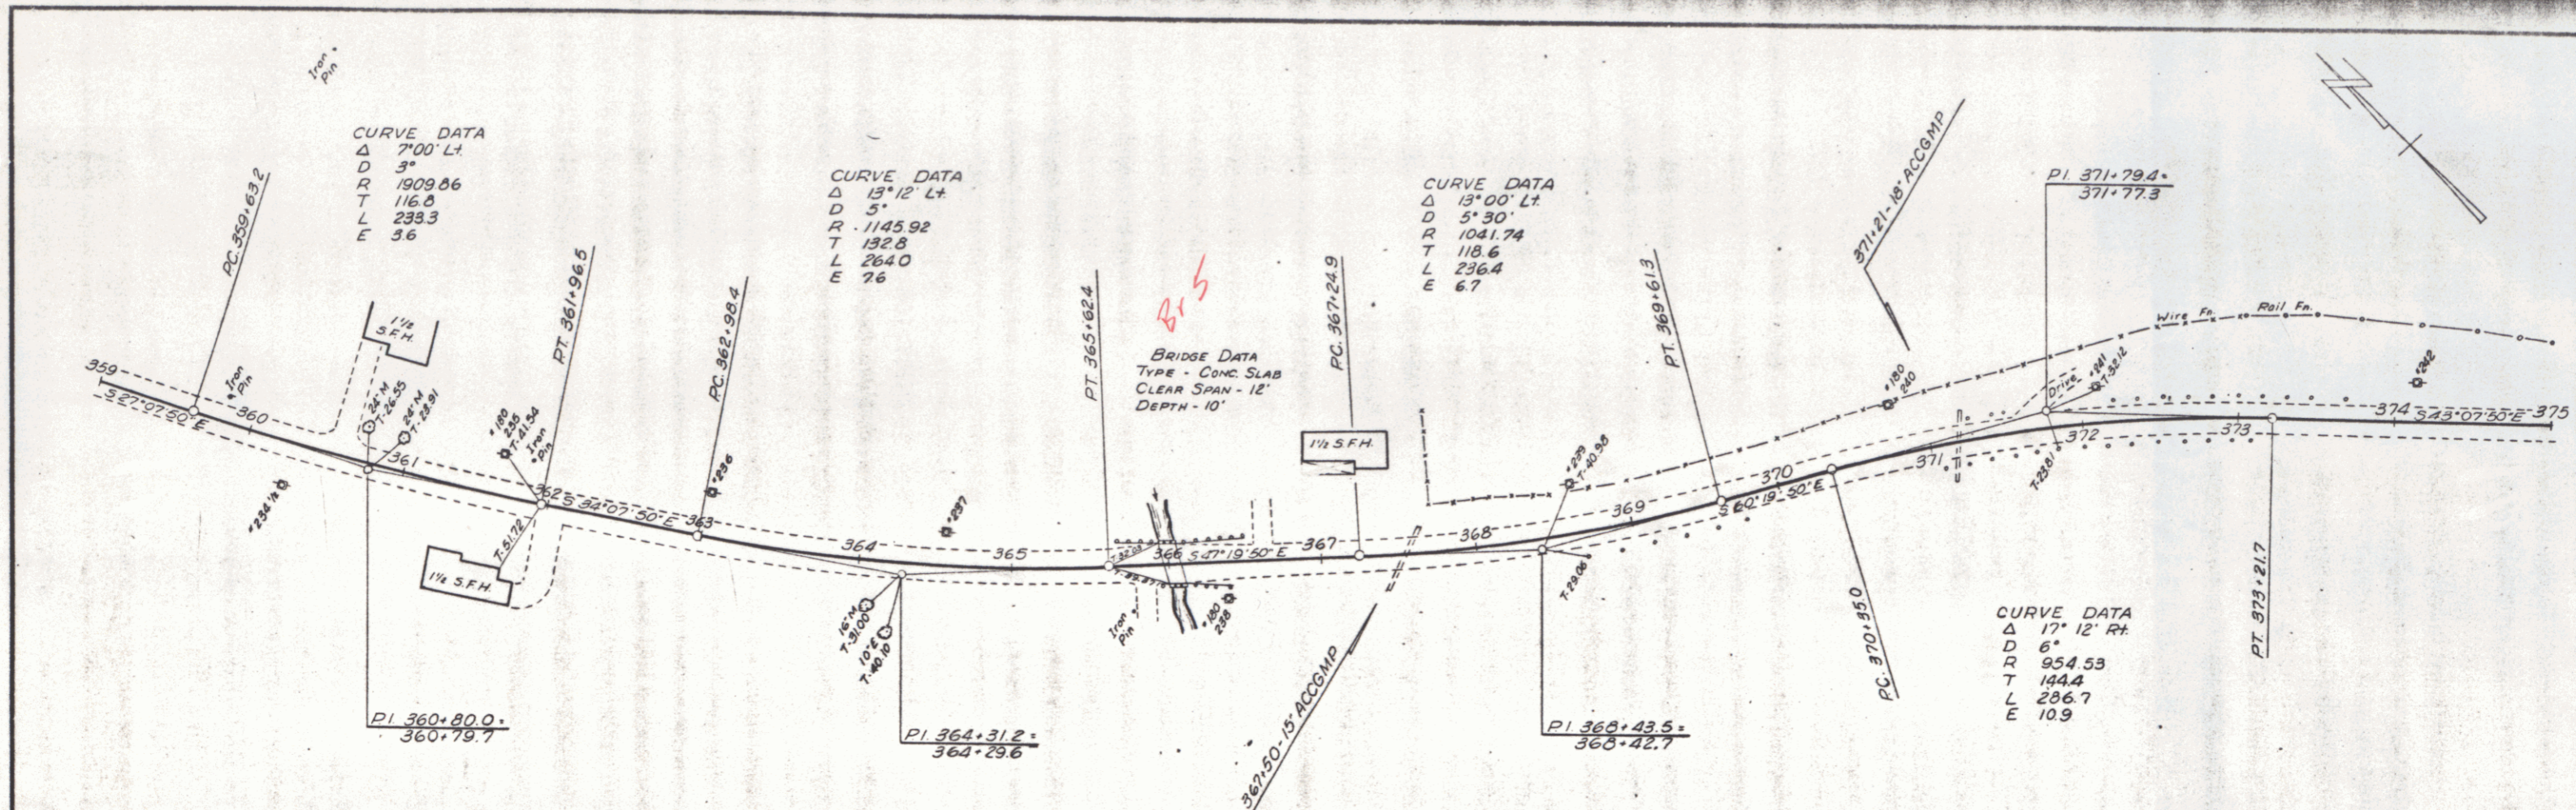



SURVEYED BY Brook DATE 3-67
 DRAWN BY ABEY & BANKS DATE 2-67
 TRACED BY BANKS DATE 4-67
MORGAN
 Vt. Rte. #111
 SCALE 1" = 50'
 SHEET 7 OF 21

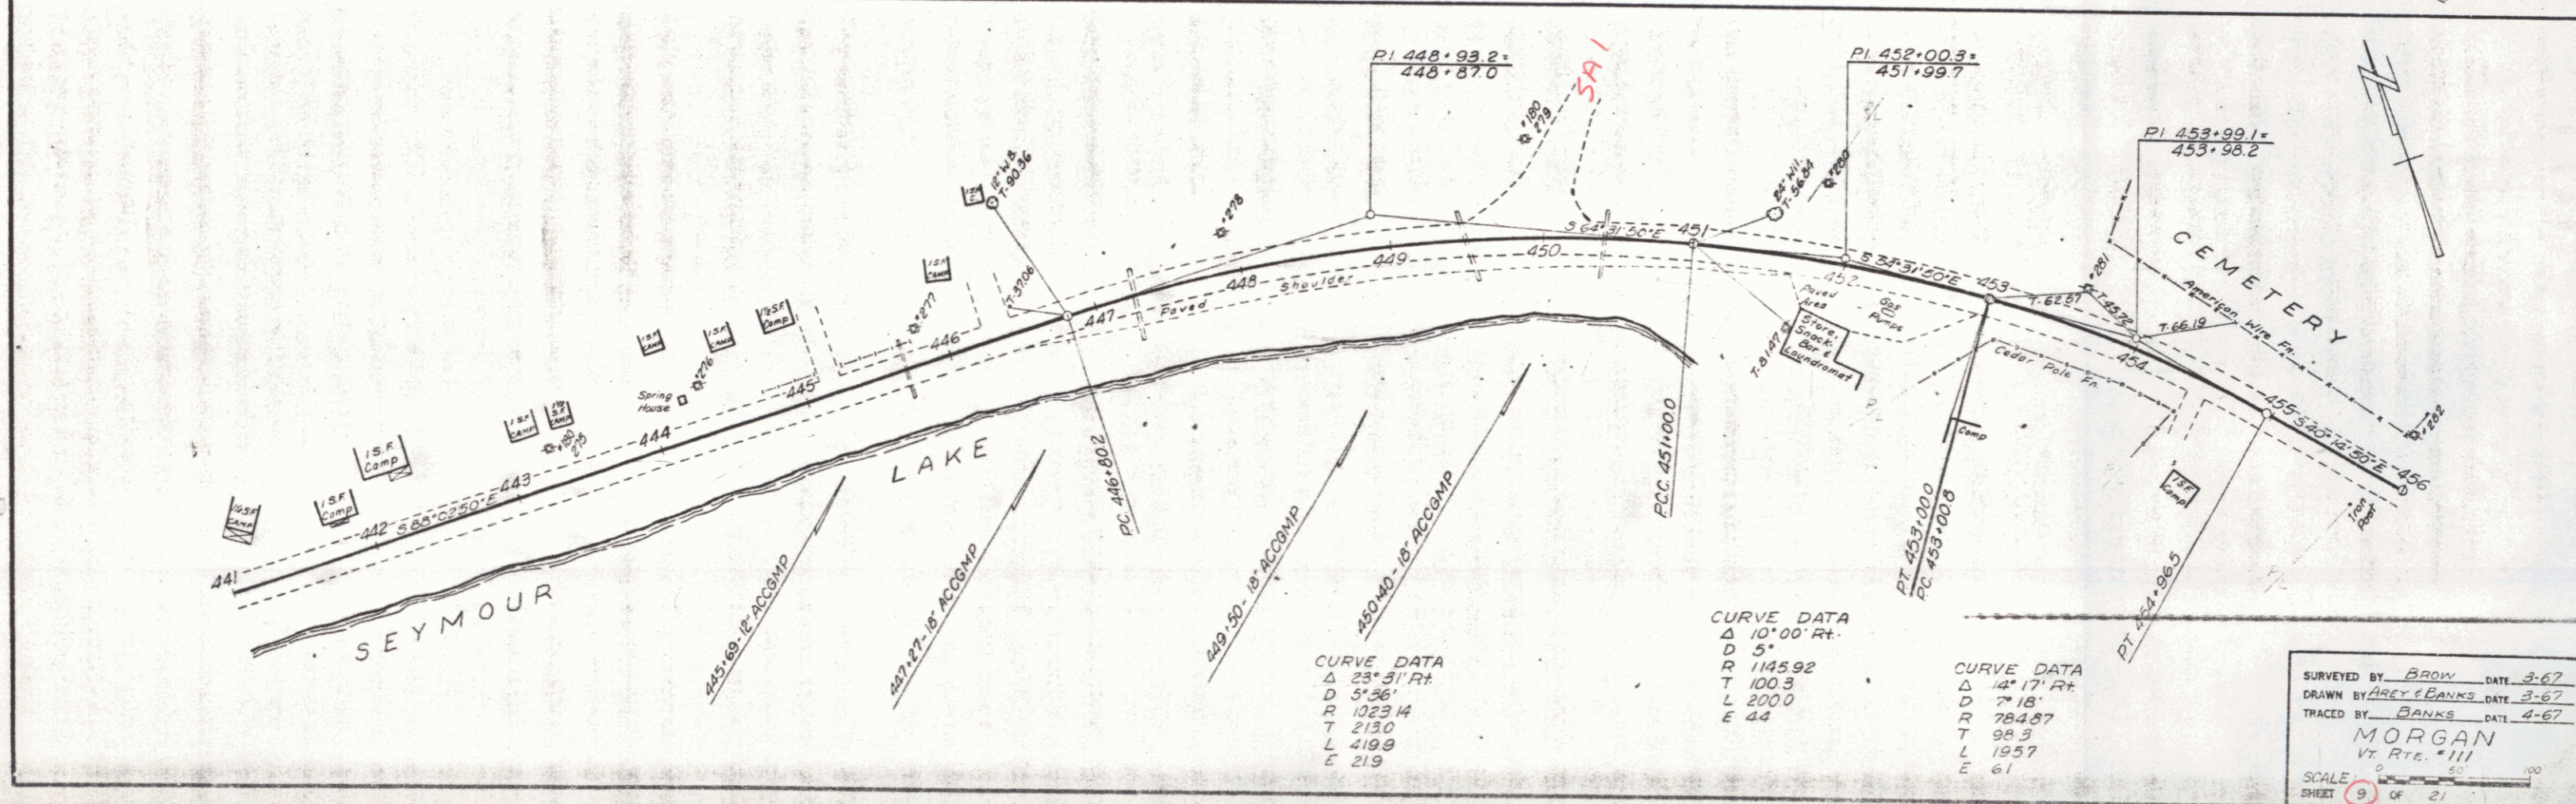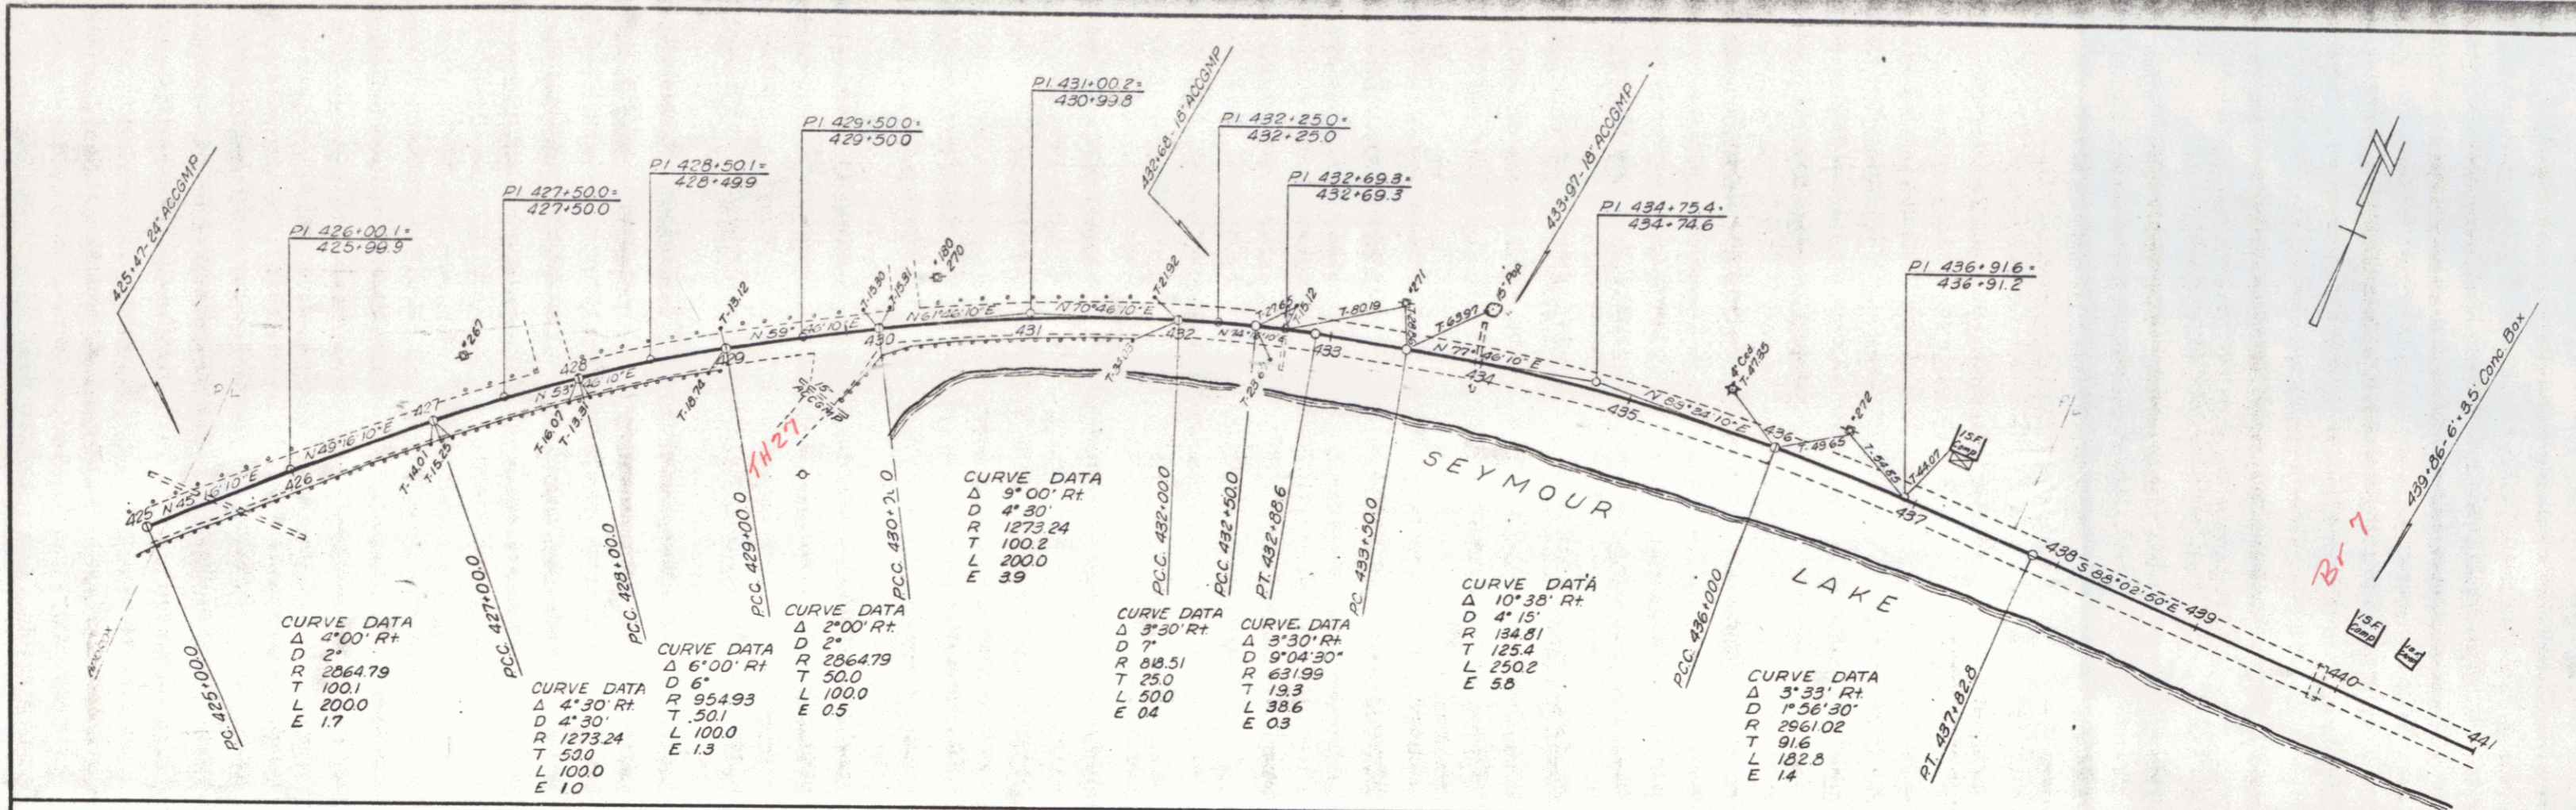



SURVEYED BY BROW DATE 3-67
 DRAWN BY BRET LEANKS DATE 3-67
 TRACED BY BARKS DATE 4-67
MORGAN
 Vt. Rtg. #111
 SCALE 1" = 100'
 SHEET 9 OF 21

CURVE NO 1
 Δ 42°09' LT
 D 20°
 R 20.8
 T 110.4
 L 210.8
 E

CURVE No 2
 Δ 48°00' LT
 D 5°
 R 1146
 T 5709
 L 7600
 E

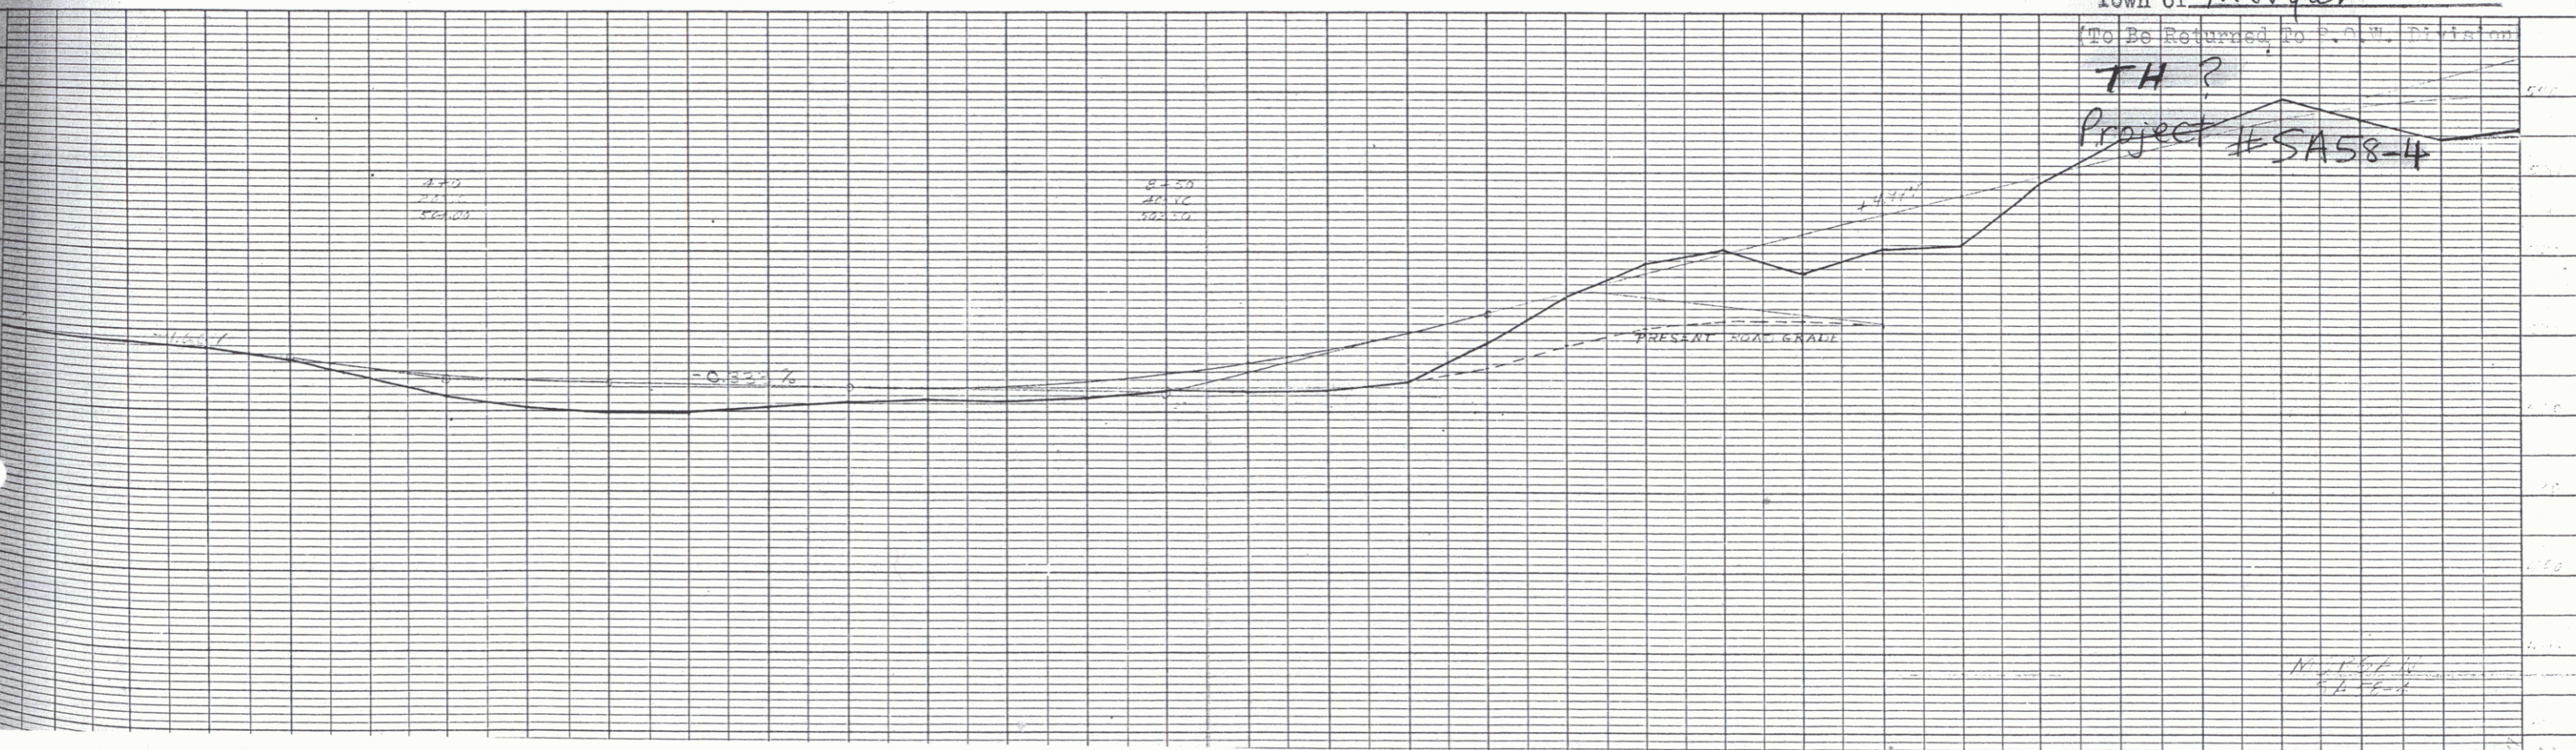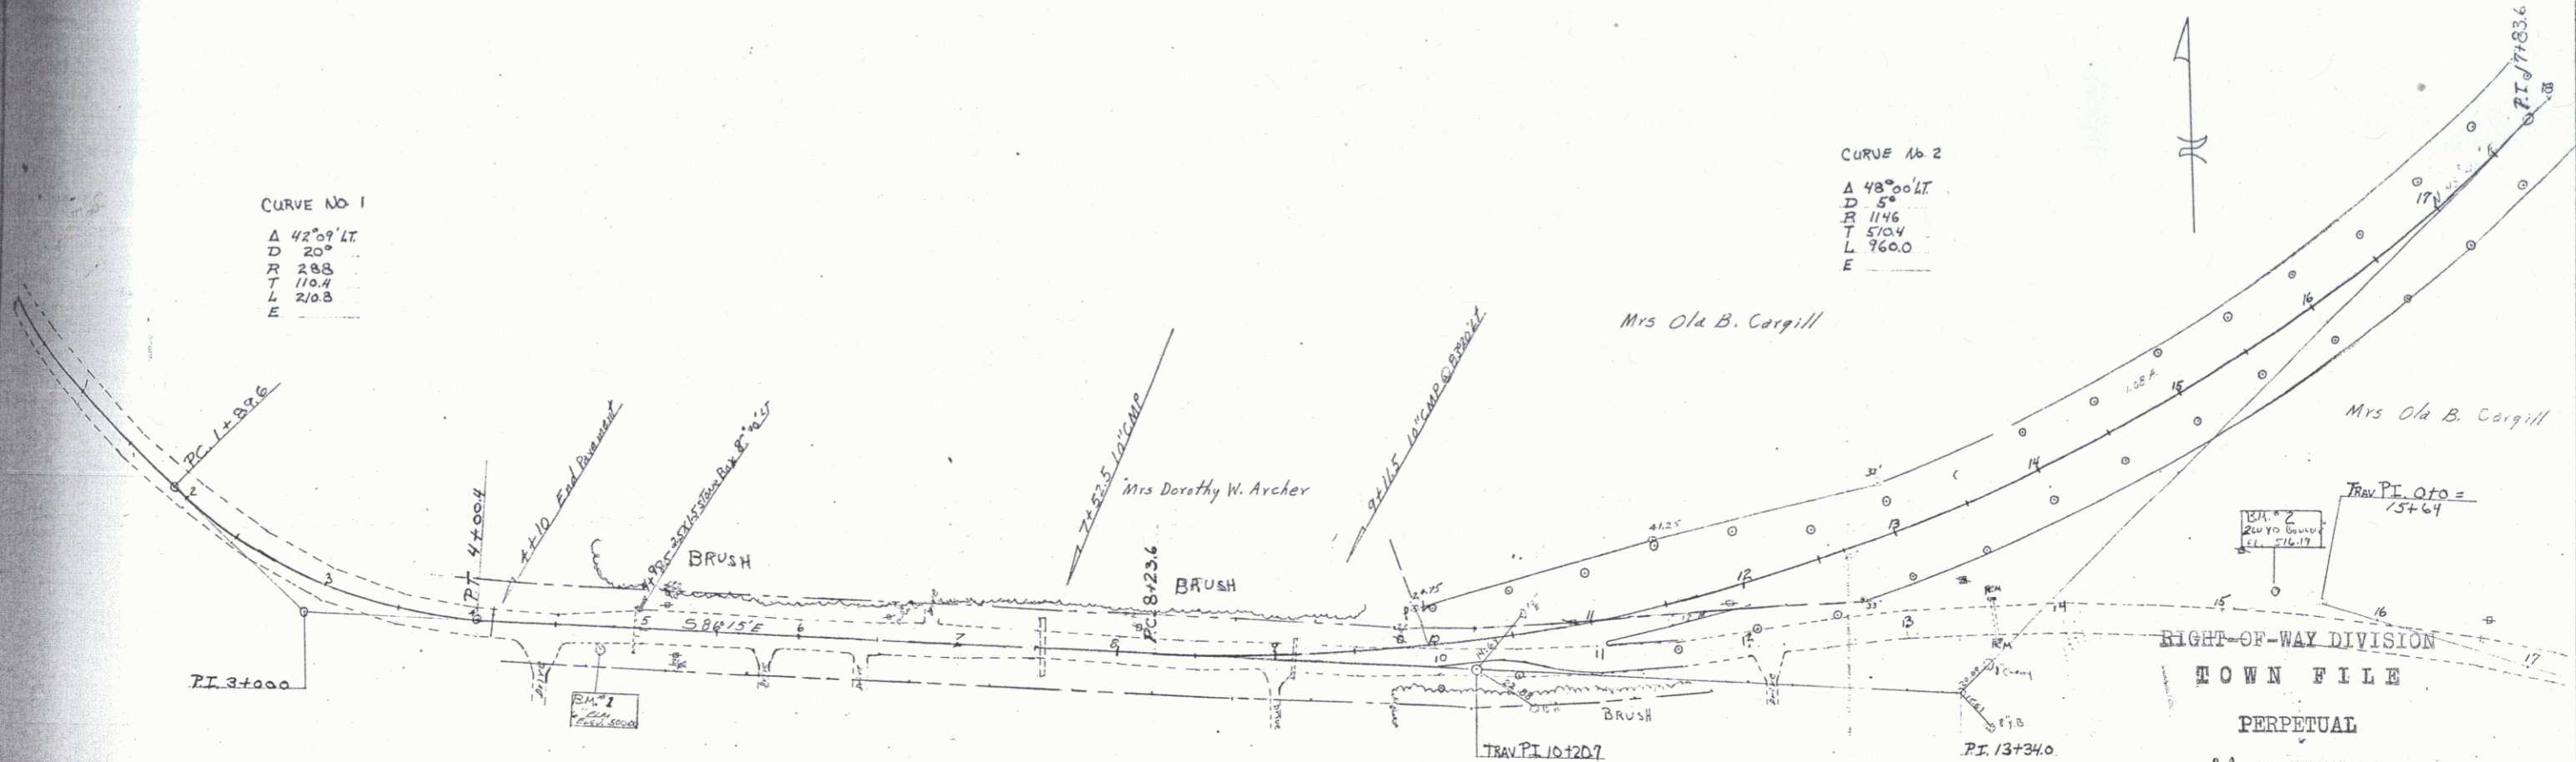


Town of Morgan
 (To Be Returned to P.O. Division)
 TH?
 Project #SAS8-4

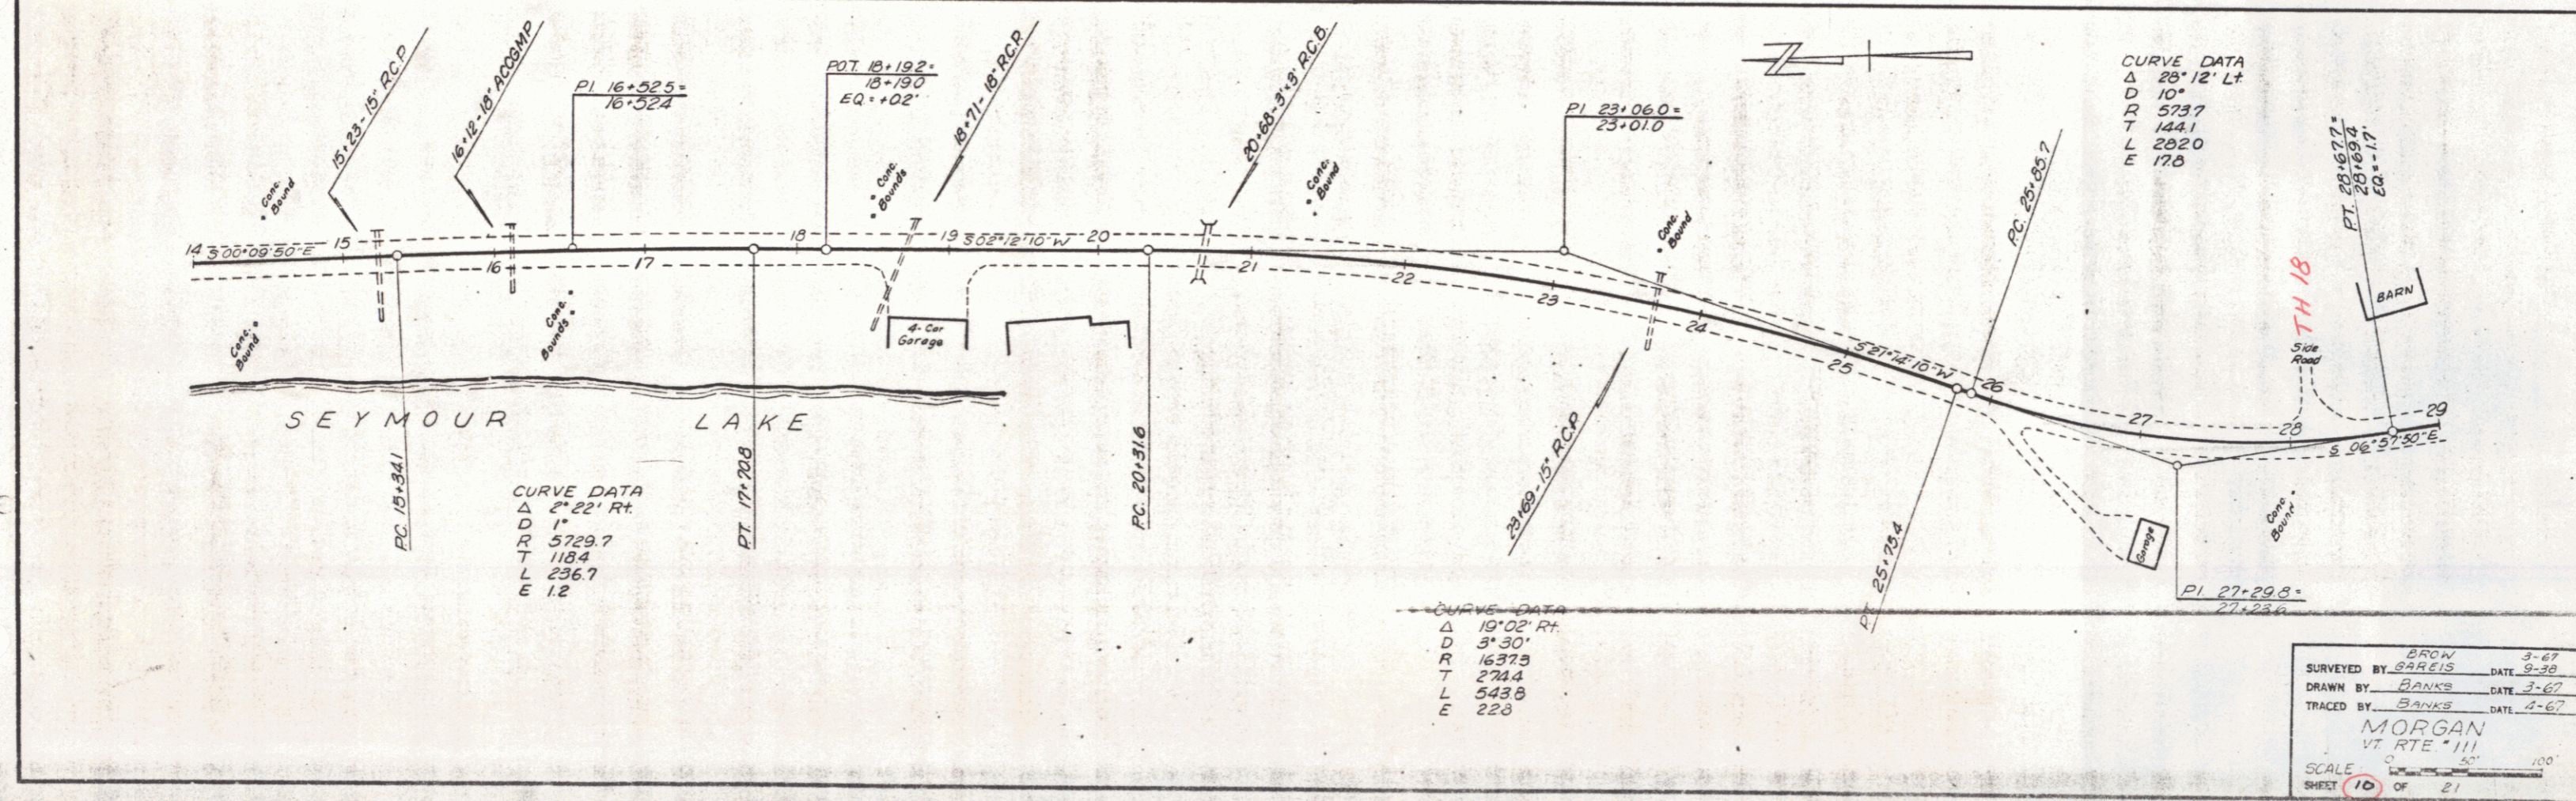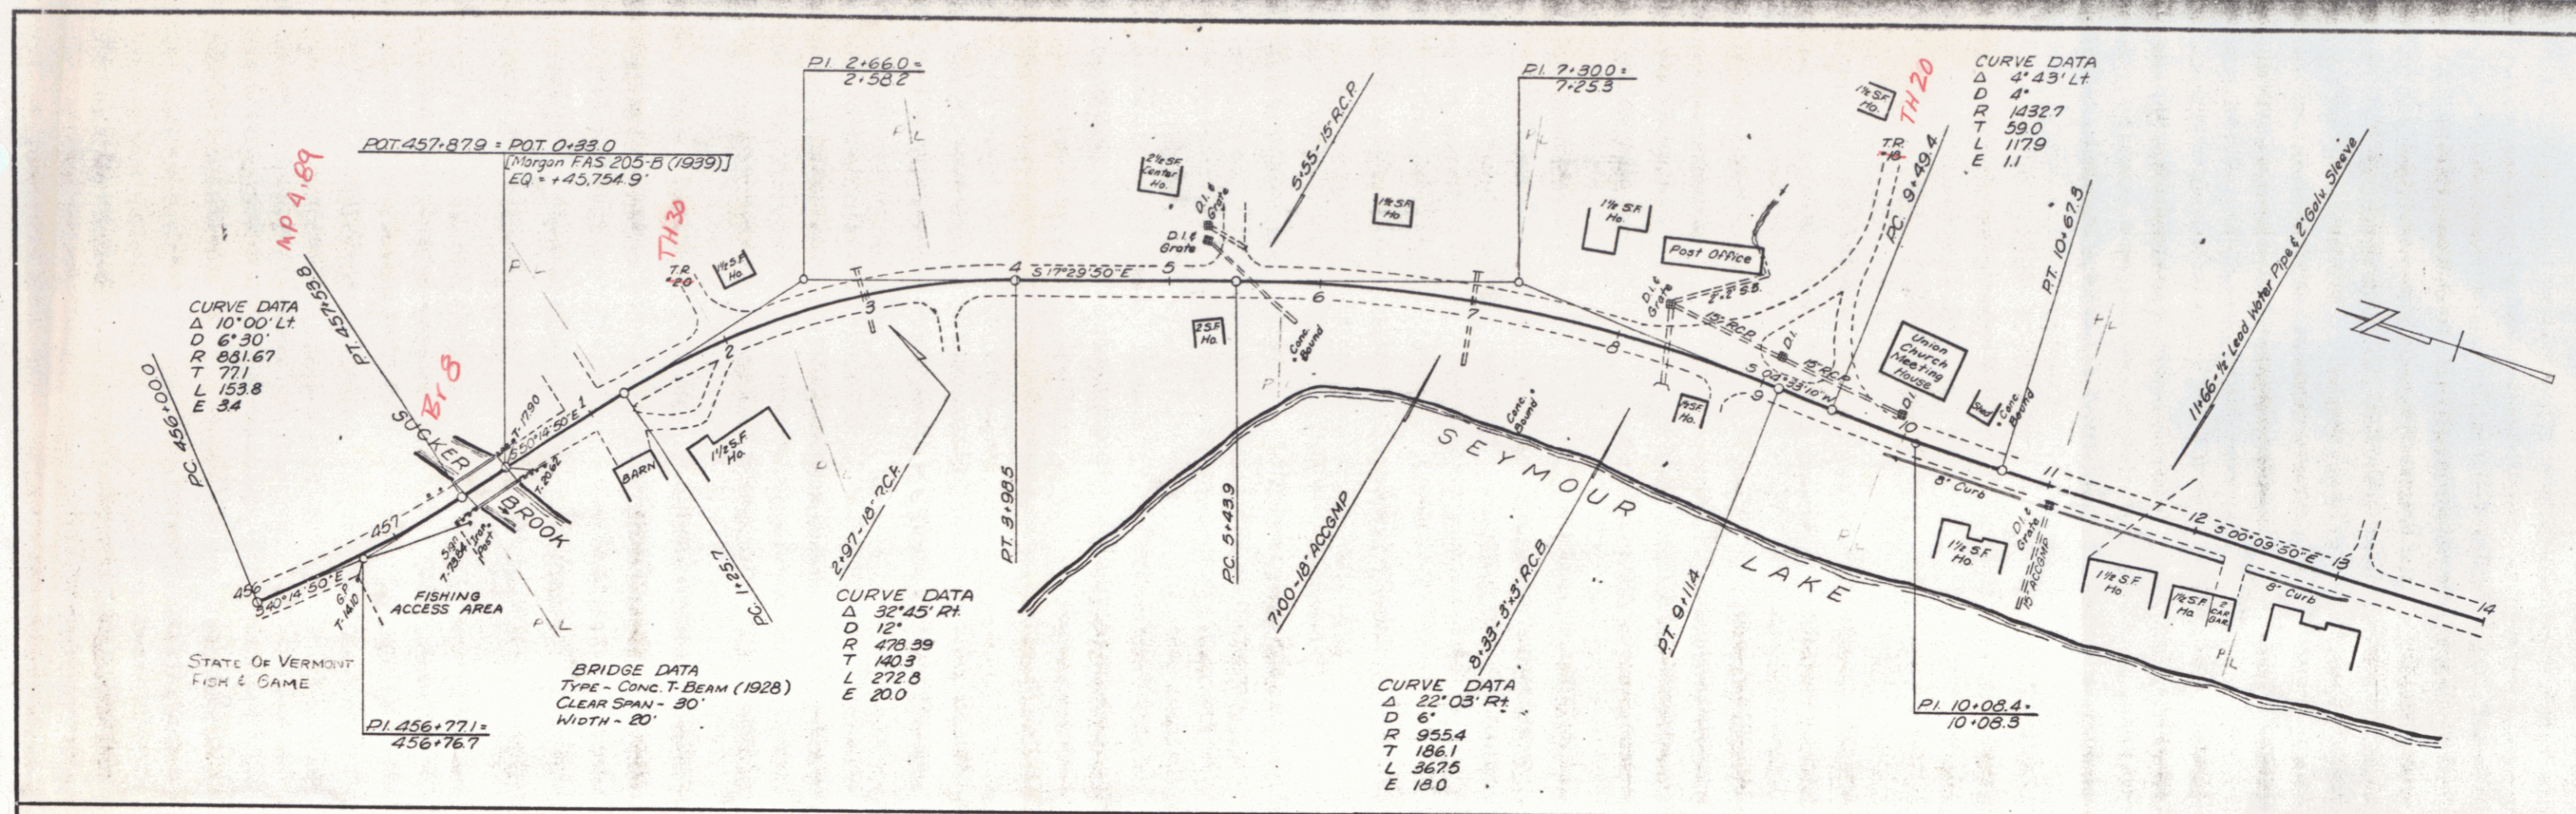

SURVEYED BY BROWN DATE 3-67
 DRAWN BY BANKS DATE 3-67
 TRACED BY BANKS DATE 4-67

MORGAN
 VT. RTE. #111

SCALE 1" = 100'
 SHEET 10 OF 21

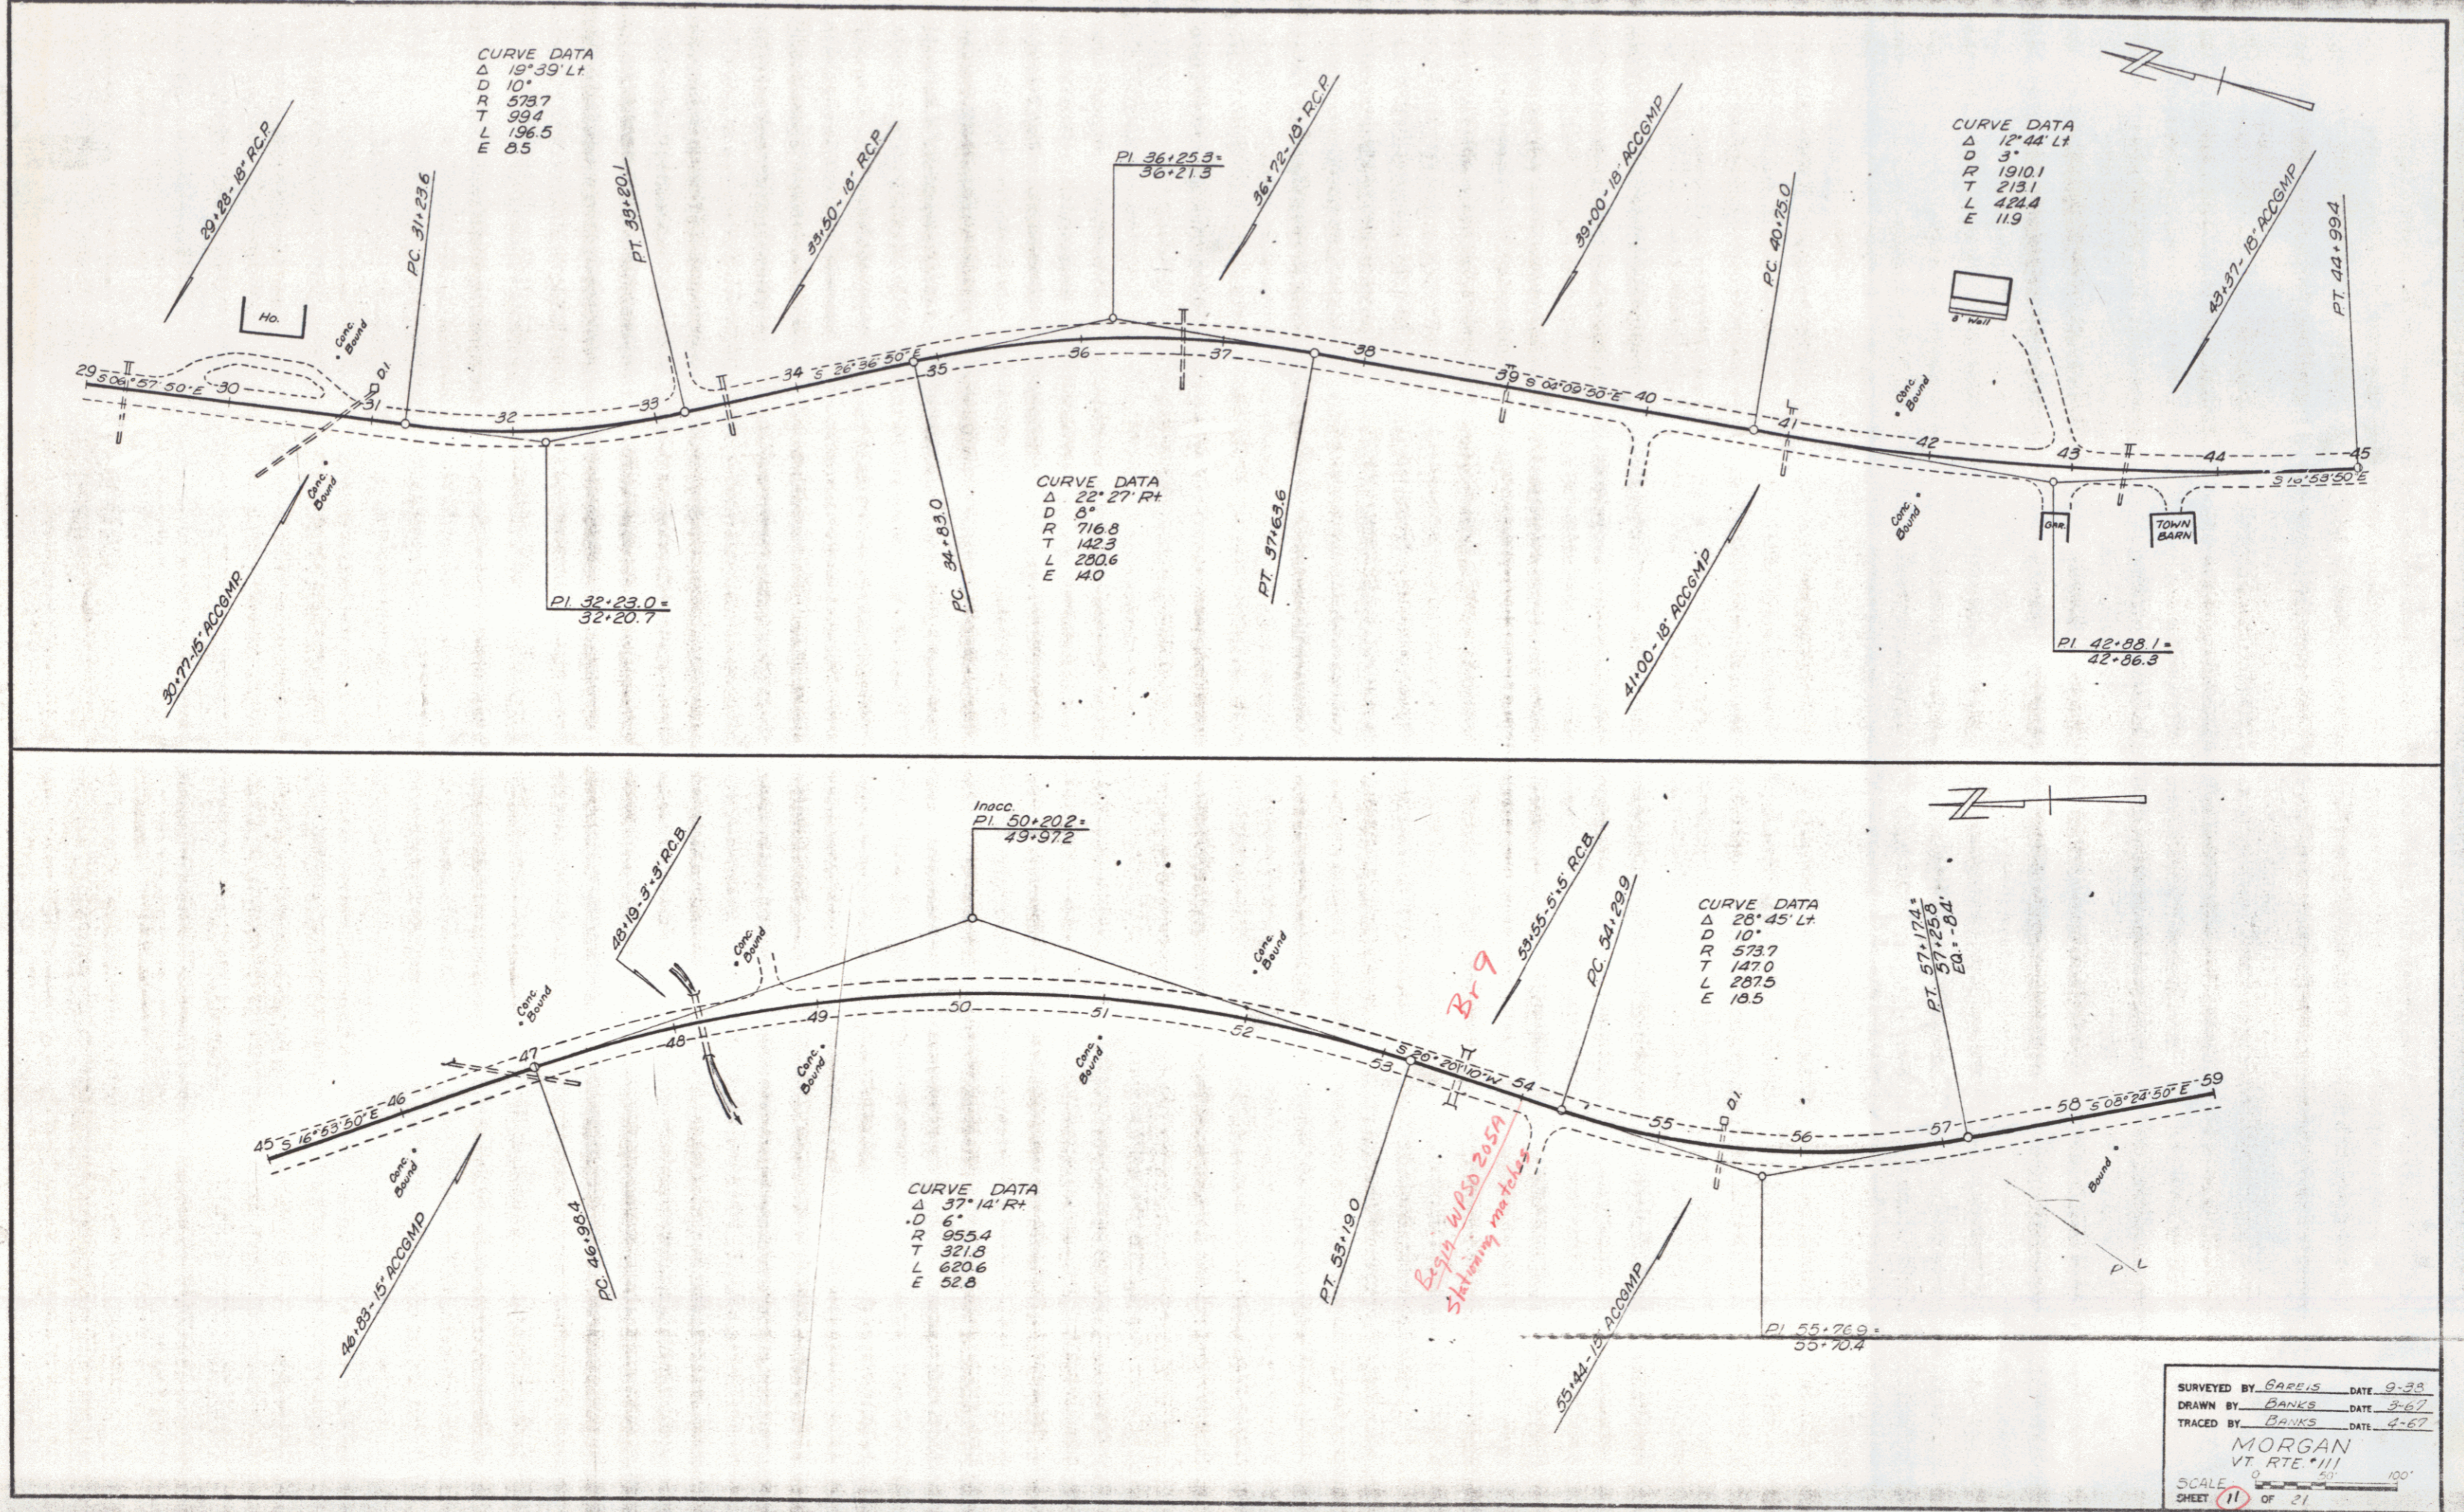

CURVE DATA
 Δ 19° 39' Lt
 D 10'
 R 573.7
 T 99.4
 L 196.5
 E 85


CURVE DATA
 Δ 22° 27' Rt
 D 8'
 R 716.8
 T 142.3
 L 200.6
 E 40

CURVE DATA
 Δ 12° 44' Lt
 D 3'
 R 1910.1
 T 213.1
 L 424.4
 E 119



CURVE DATA
 Δ 26° 45' Lt
 D 10'
 R 573.7
 T 147.0
 L 287.5
 E 18.5

CURVE DATA
 Δ 37° 14' Rt
 D 6'
 R 955.4
 T 321.8
 L 620.6
 E 52.8

SURVEYED BY BANKS DATE 9-38
 DRAWN BY BANKS DATE 3-67
 TRACED BY BANKS DATE 4-67
 MORGAN
 VT. RTE #111
 SCALE 0 50 100'
 SHEET 11 OF 21

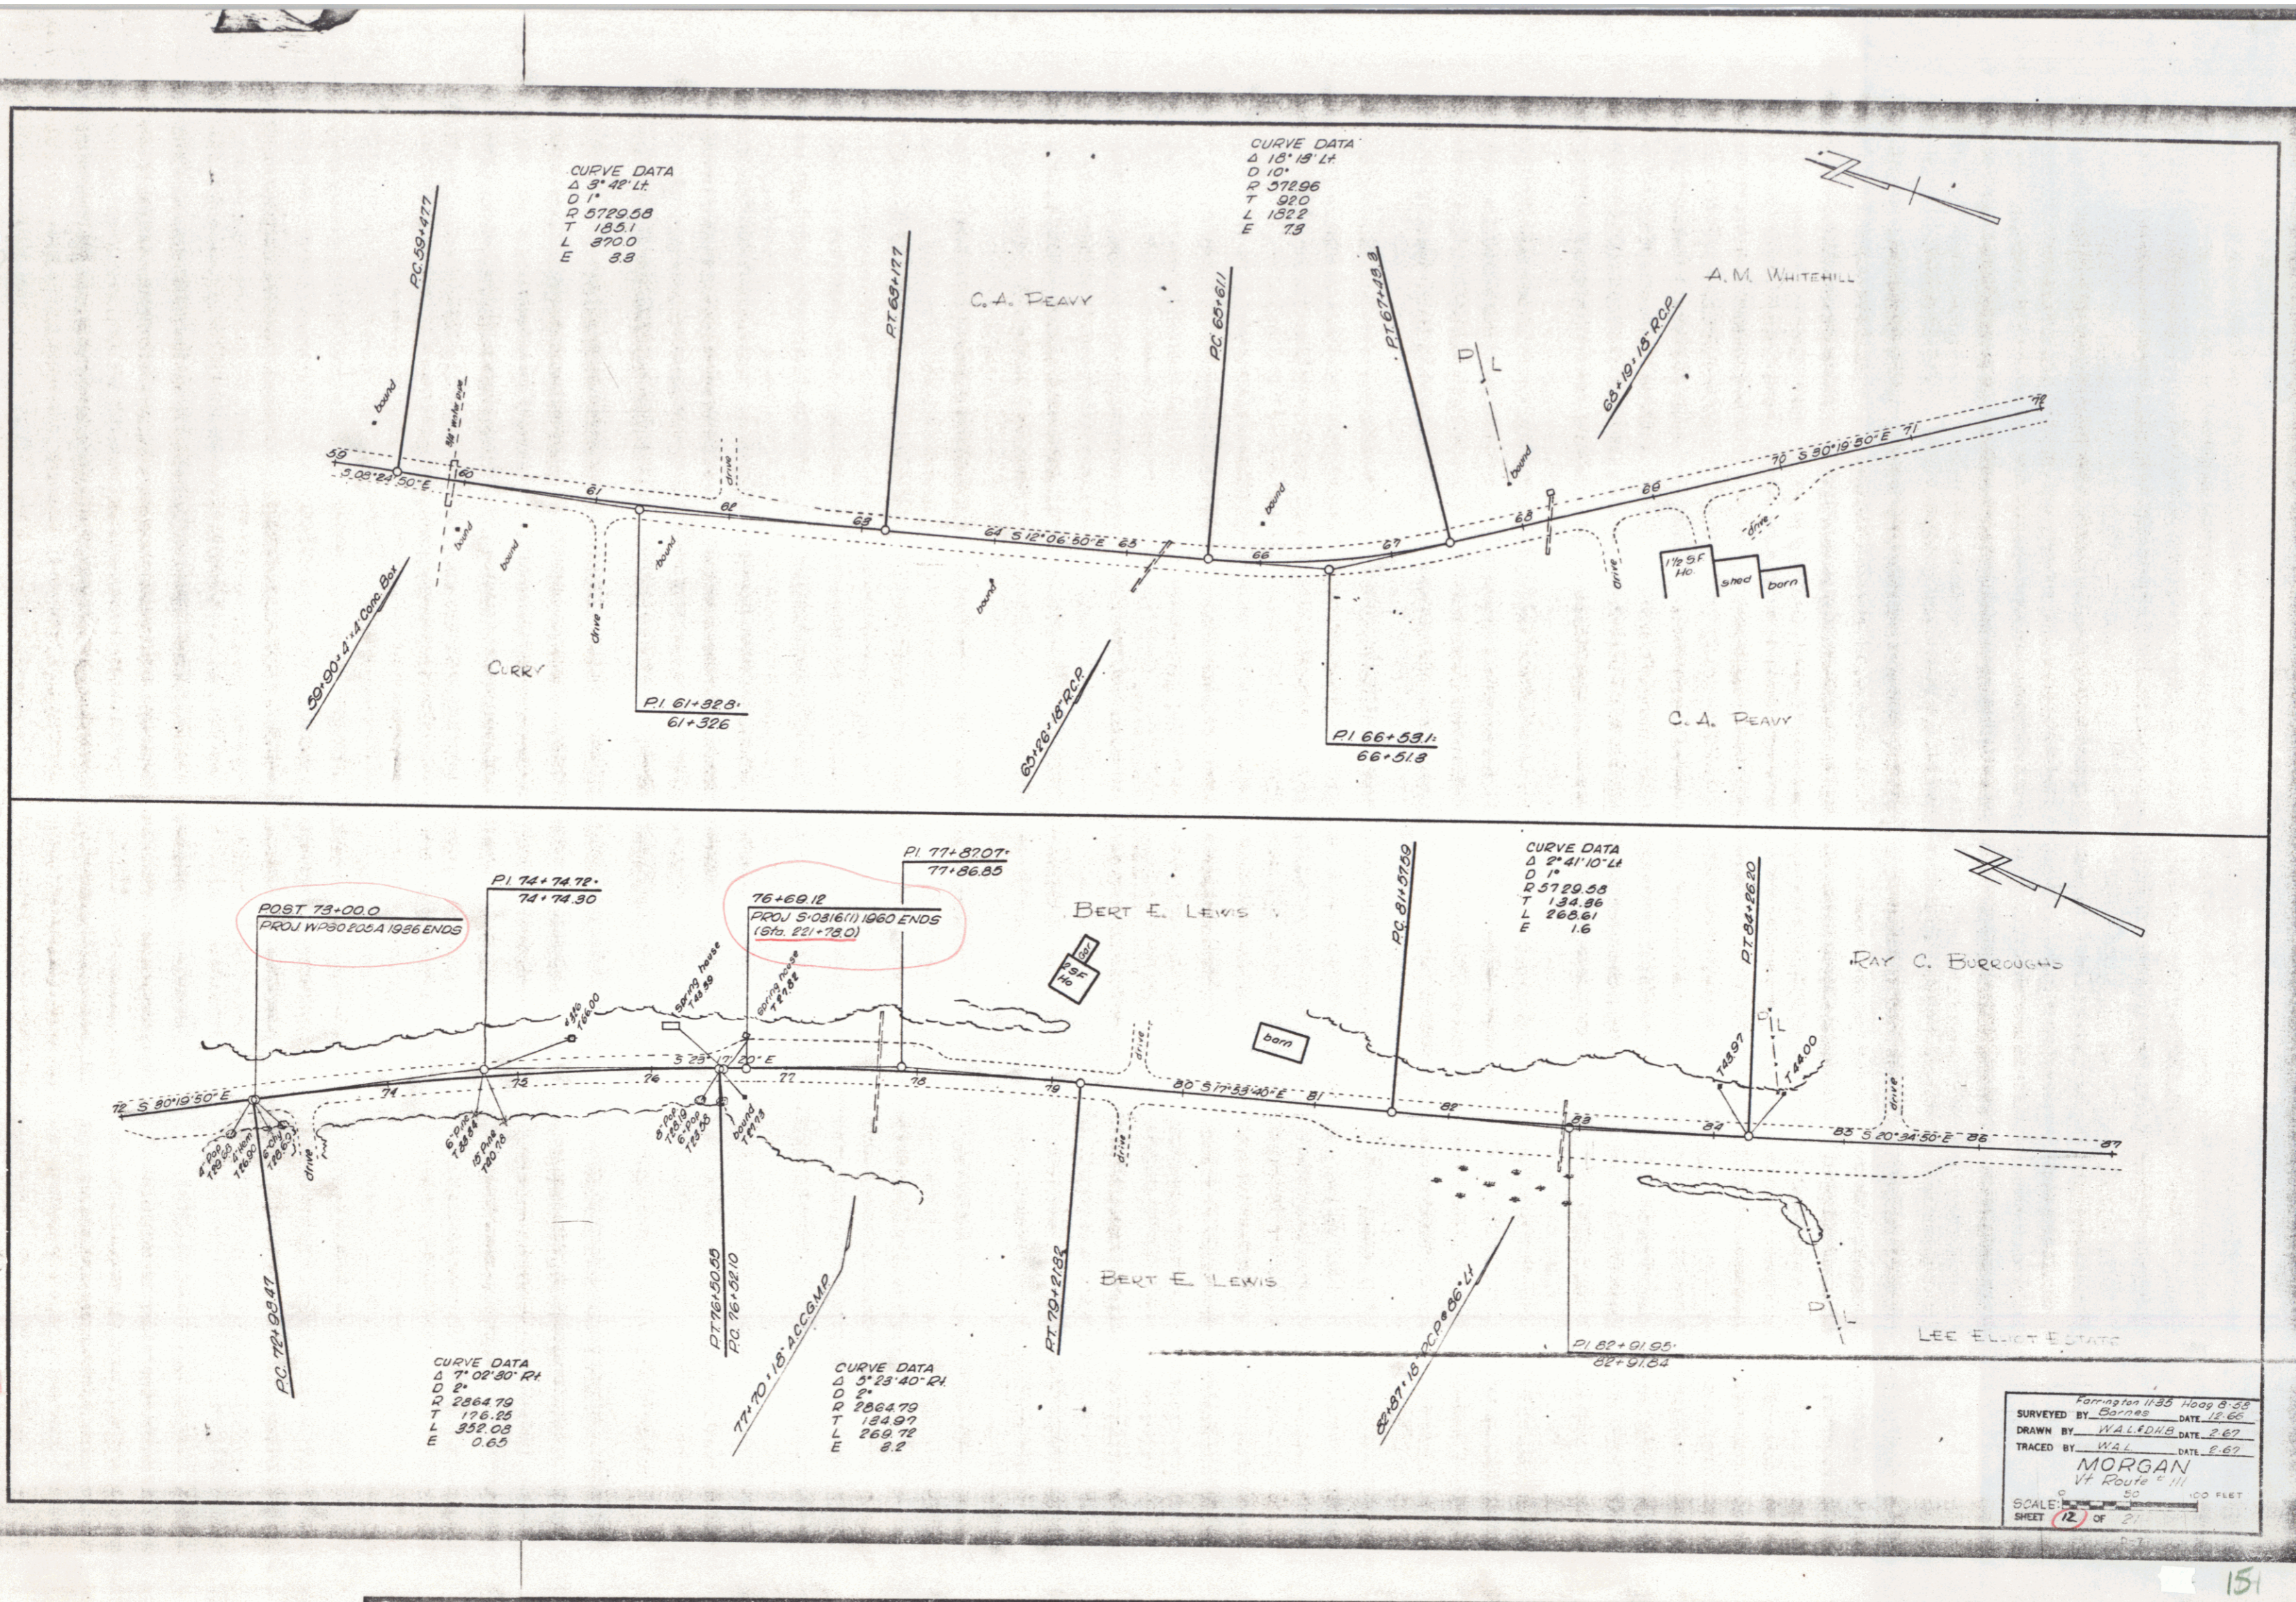


Farrington 1133 Hoop B-55
 SURVEYED BY Barnes DATE 12.66
 DRAWN BY WALDHE DATE 2.67
 TRACED BY WAL DATE 8.67
MORGAN
 Vt Route 111
 SCALE 1" = 50' 100 FEET
 SHEET 12 OF 21

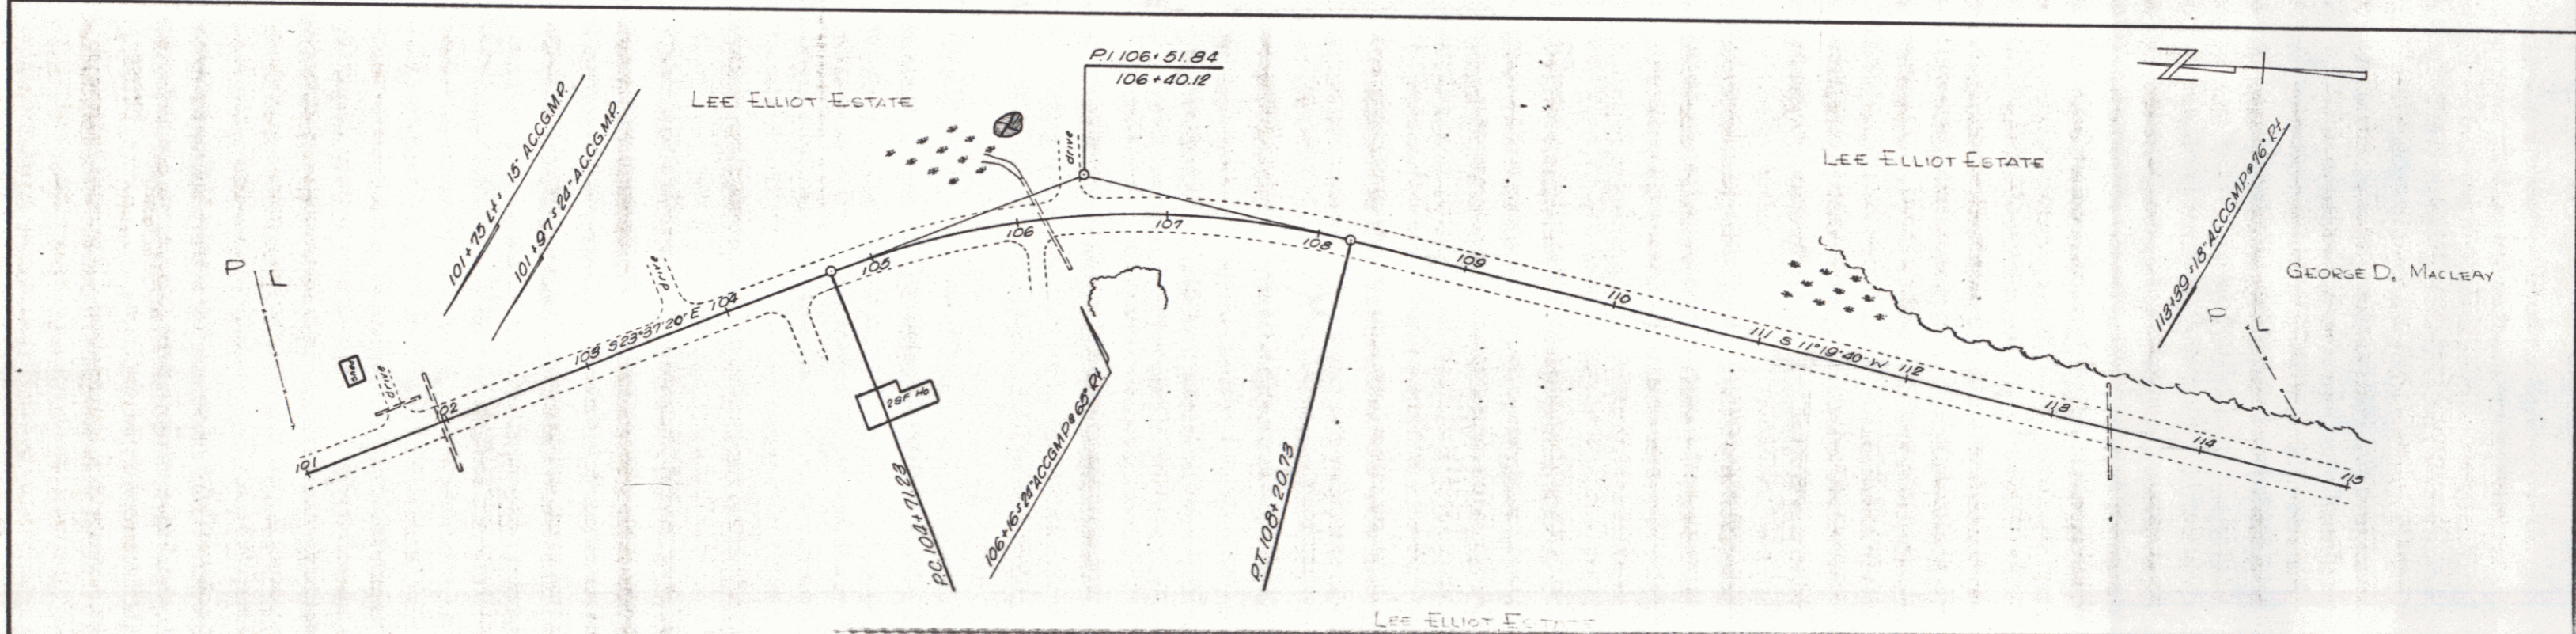
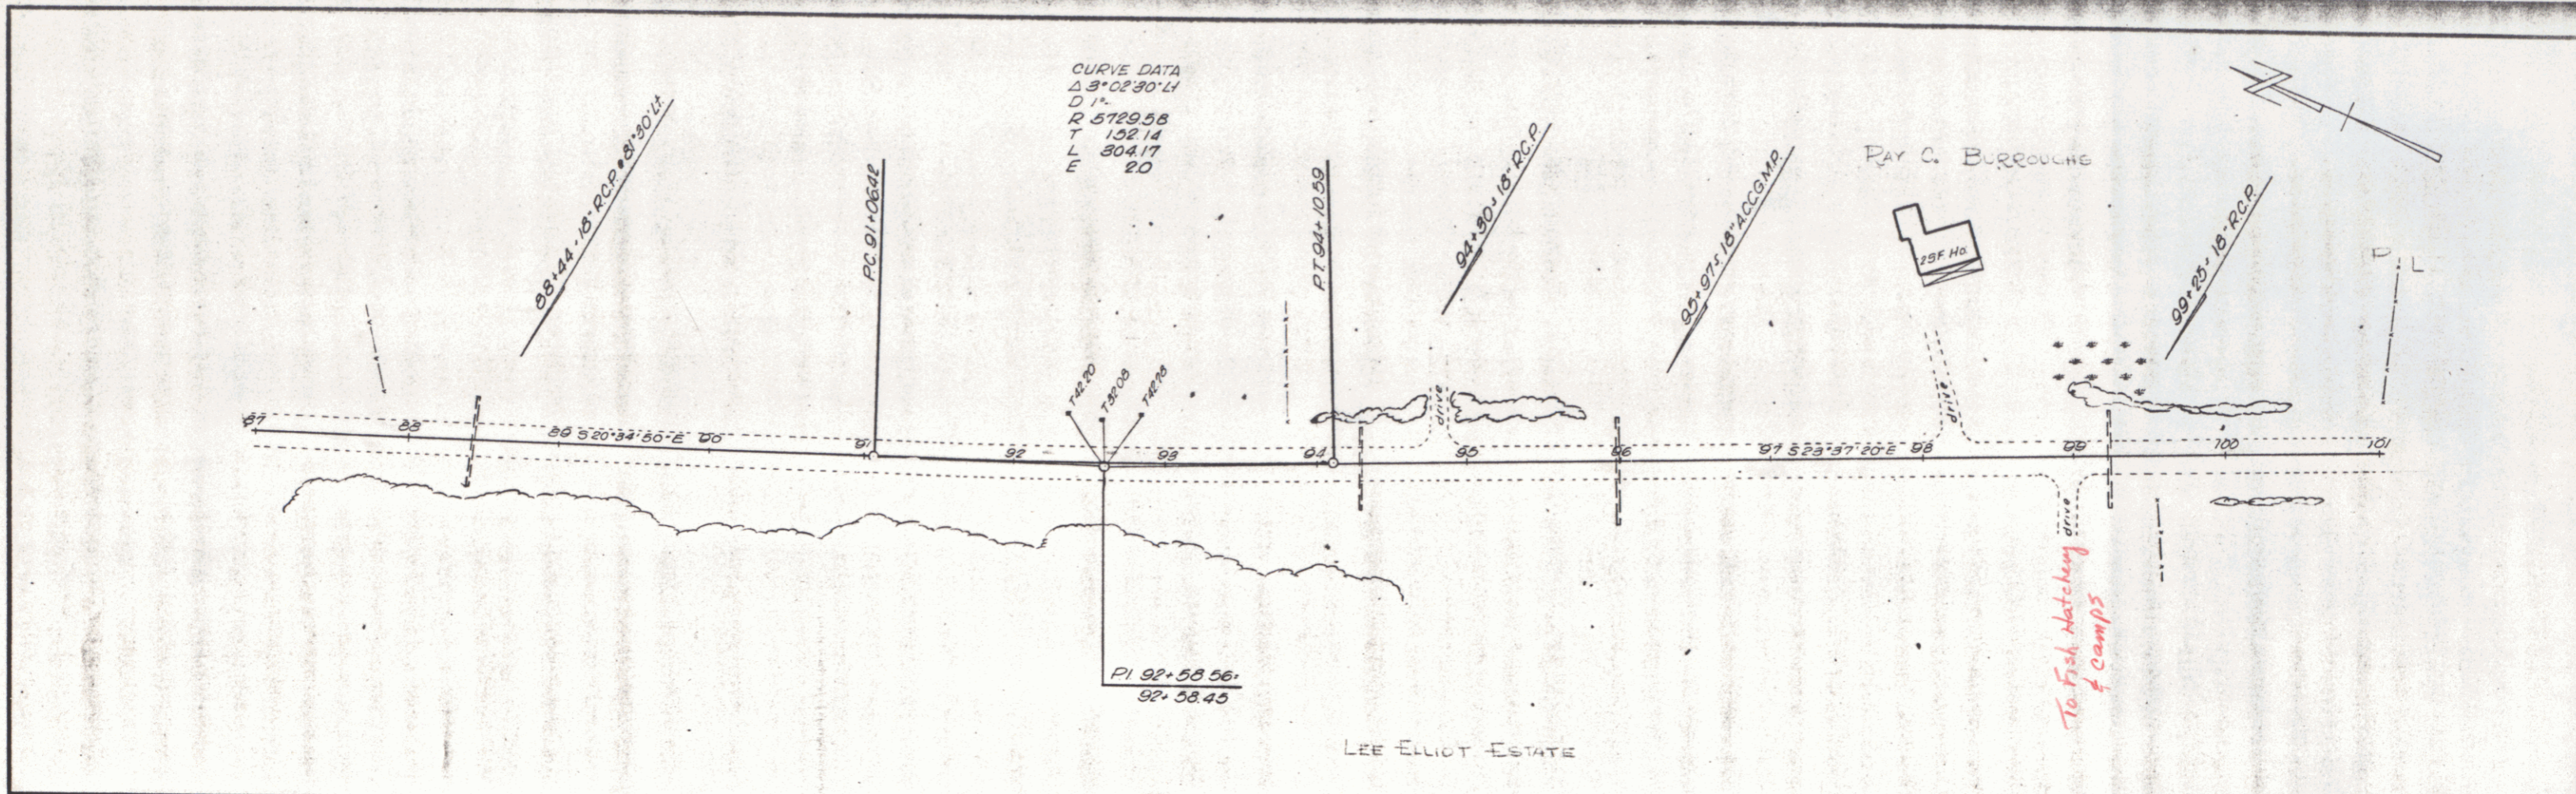


CURVE DATA
 $\Delta 34^{\circ}57'21''$
 D 10'
 R 5720.6
 T 180.67
 L 349.50
 E 27.7

SURVEYED BY	Haag	DATE	8-58
DRAWN BY	WAL	DATE	2-67
TRACED BY	WAL	DATE	2-67
MORGAN Vt Route # 111			
SCALE:	0 50 100 FEET		
SHEET	13	OF	21

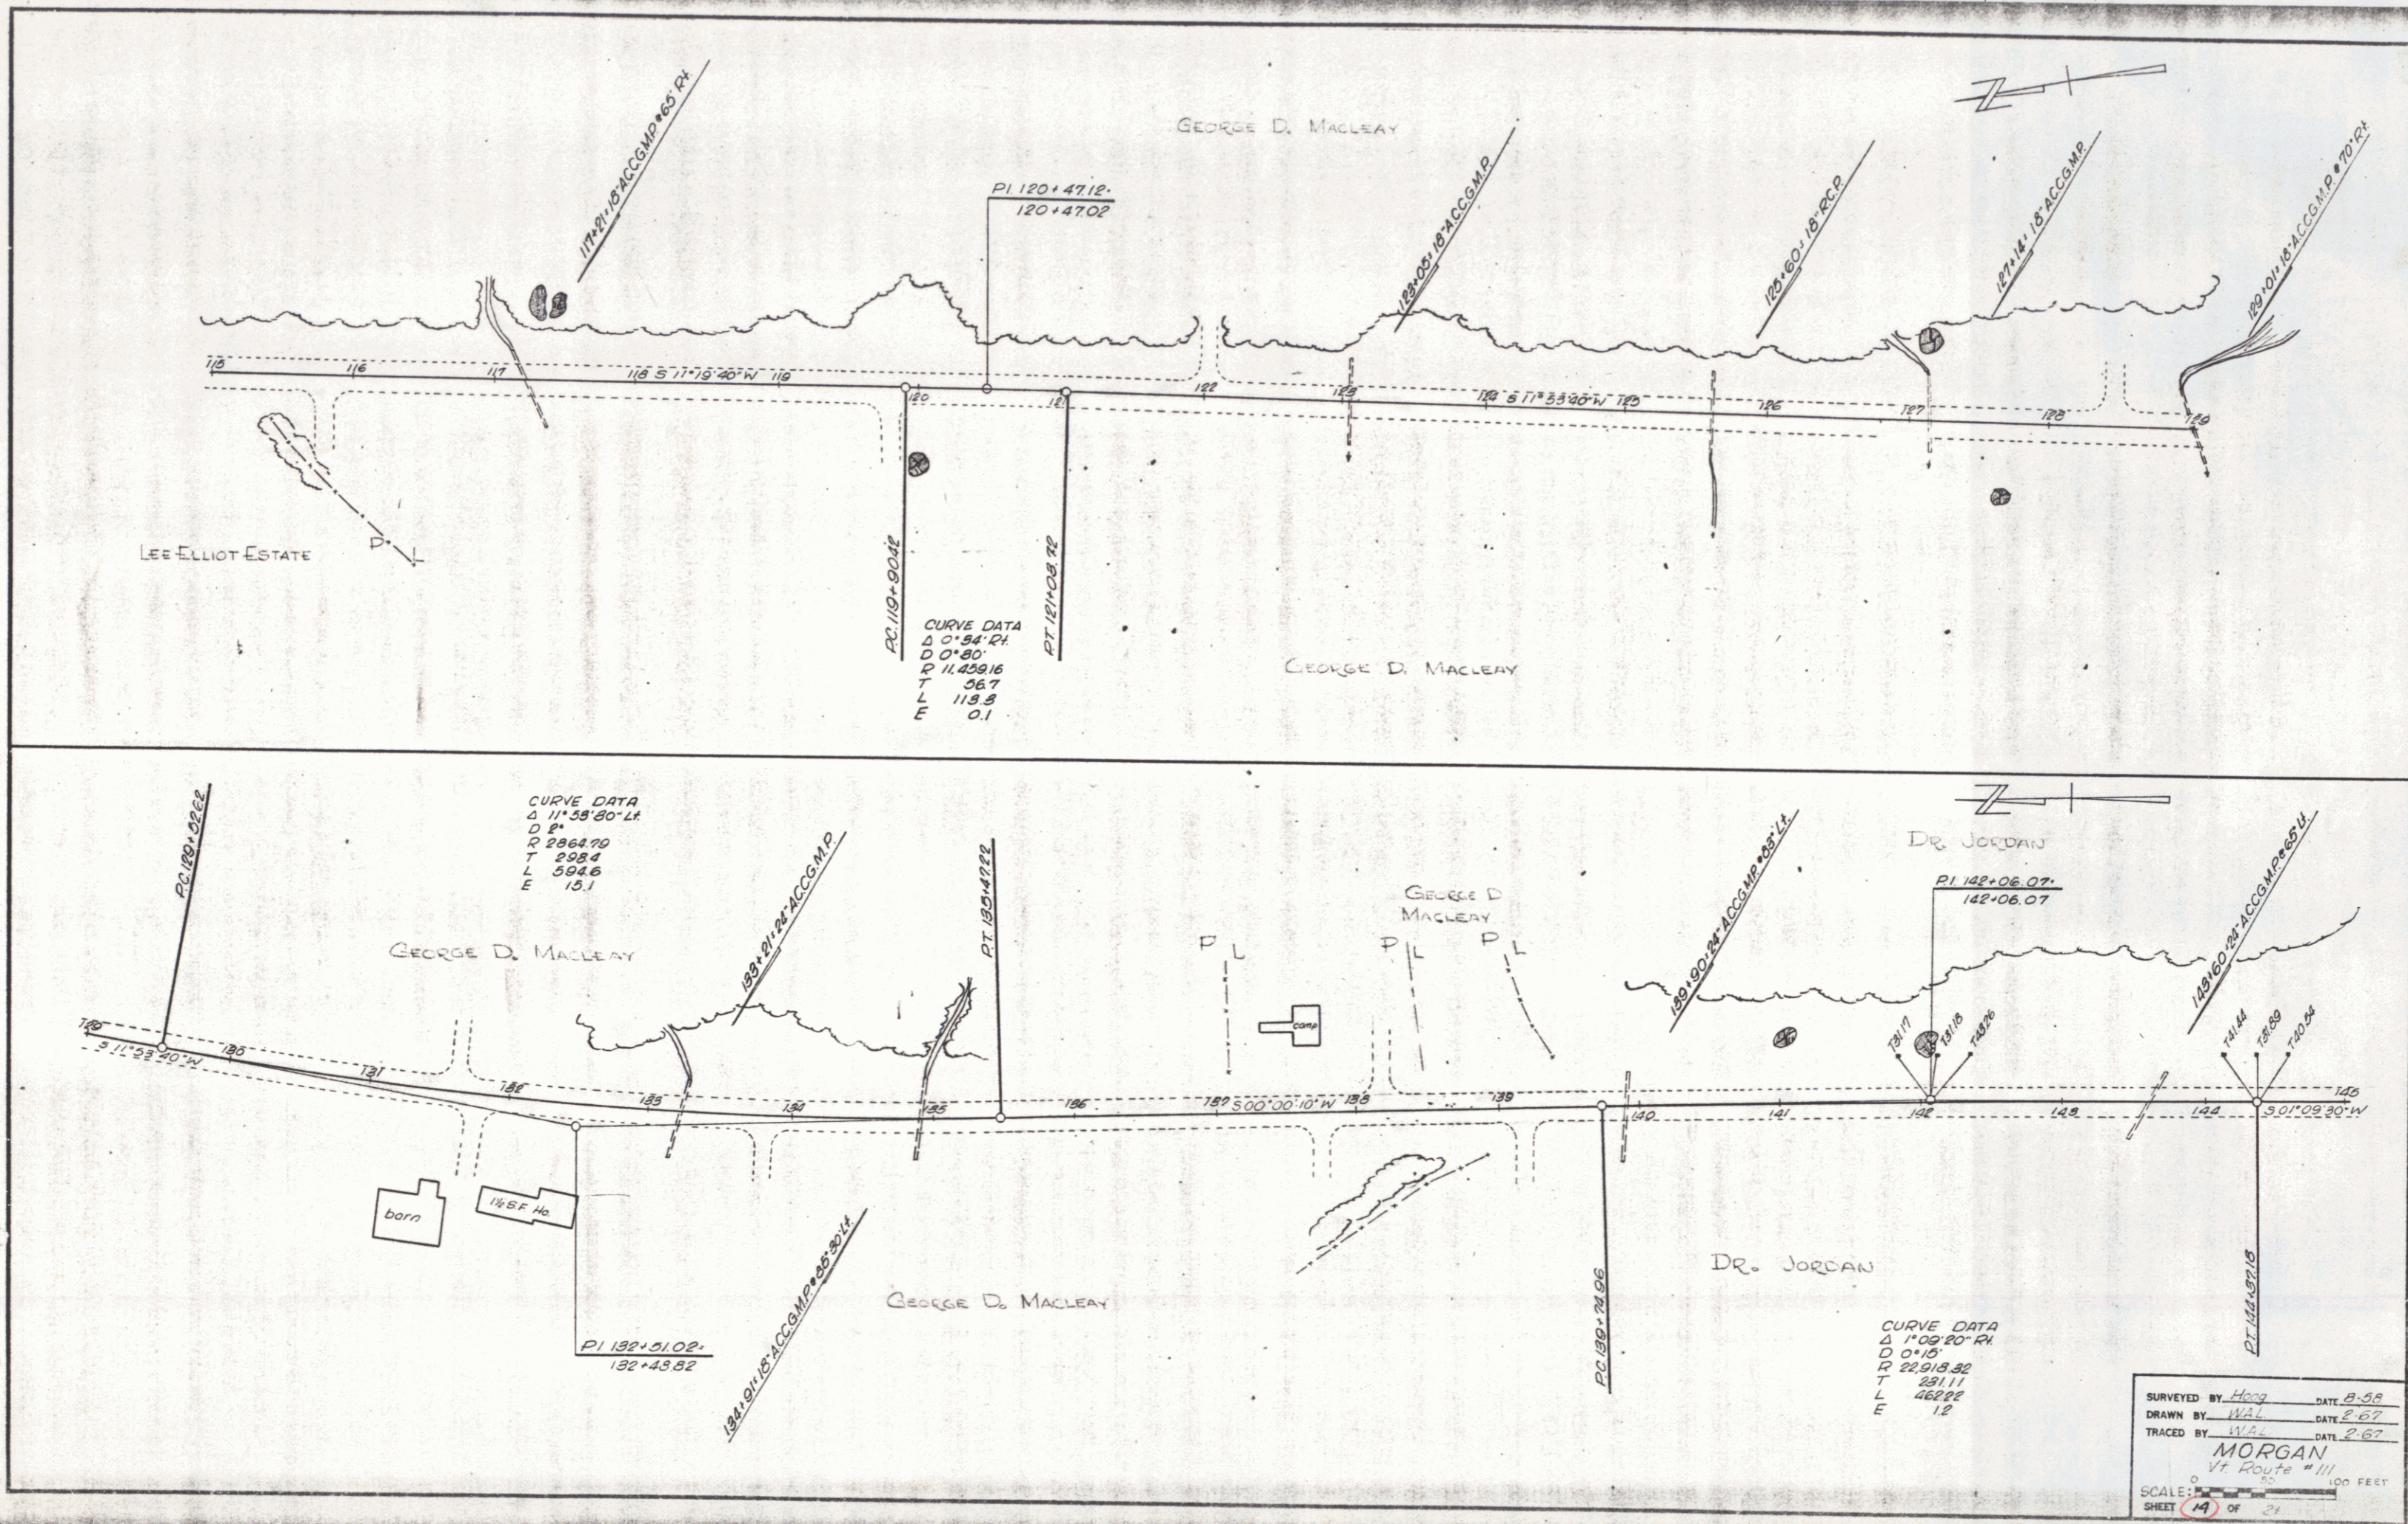


SURVEYED BY: HCG DATE: 8-58
 DRAWN BY: WSL DATE: 2-67
 TRACED BY: WSL DATE: 2-67
MORGAN
 1/4" Route # 111
 SCALE: 1" = 100 FEET
 SHEET 14 OF 24

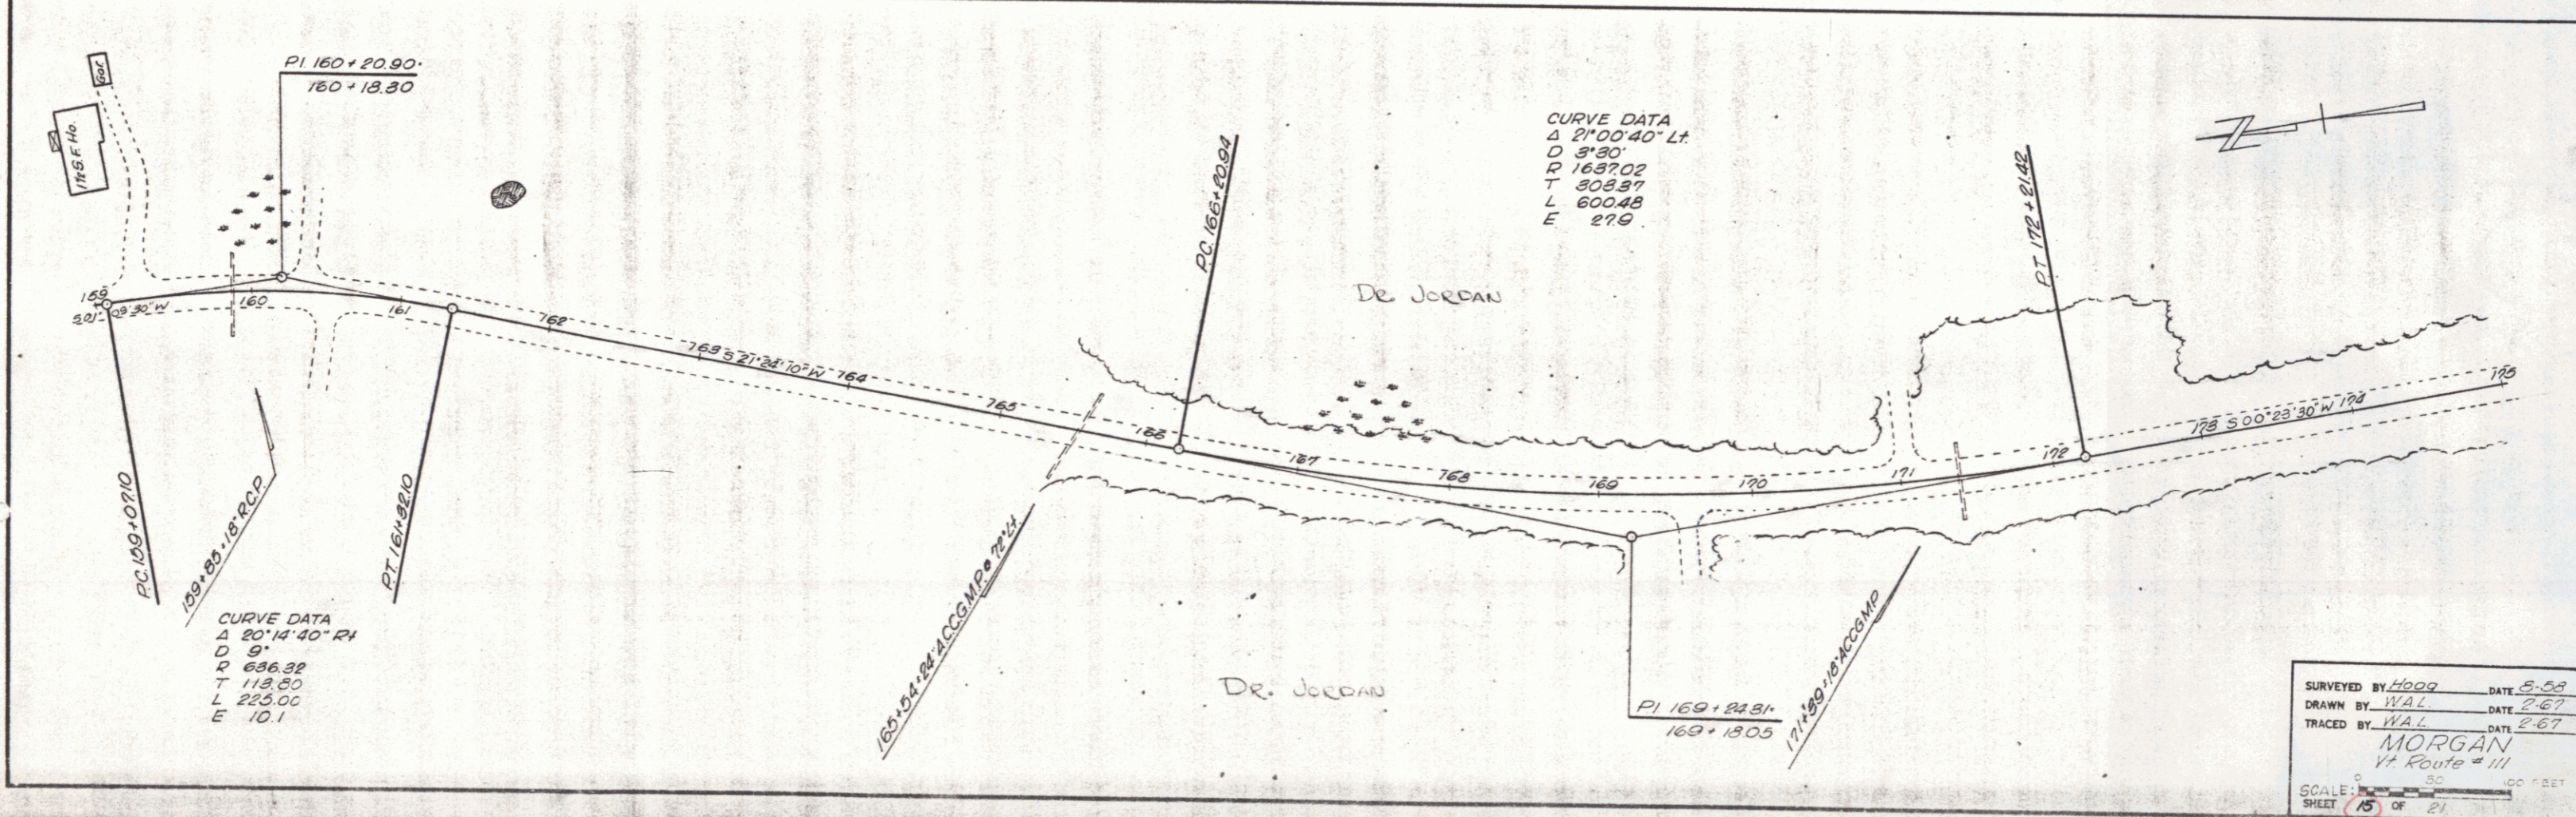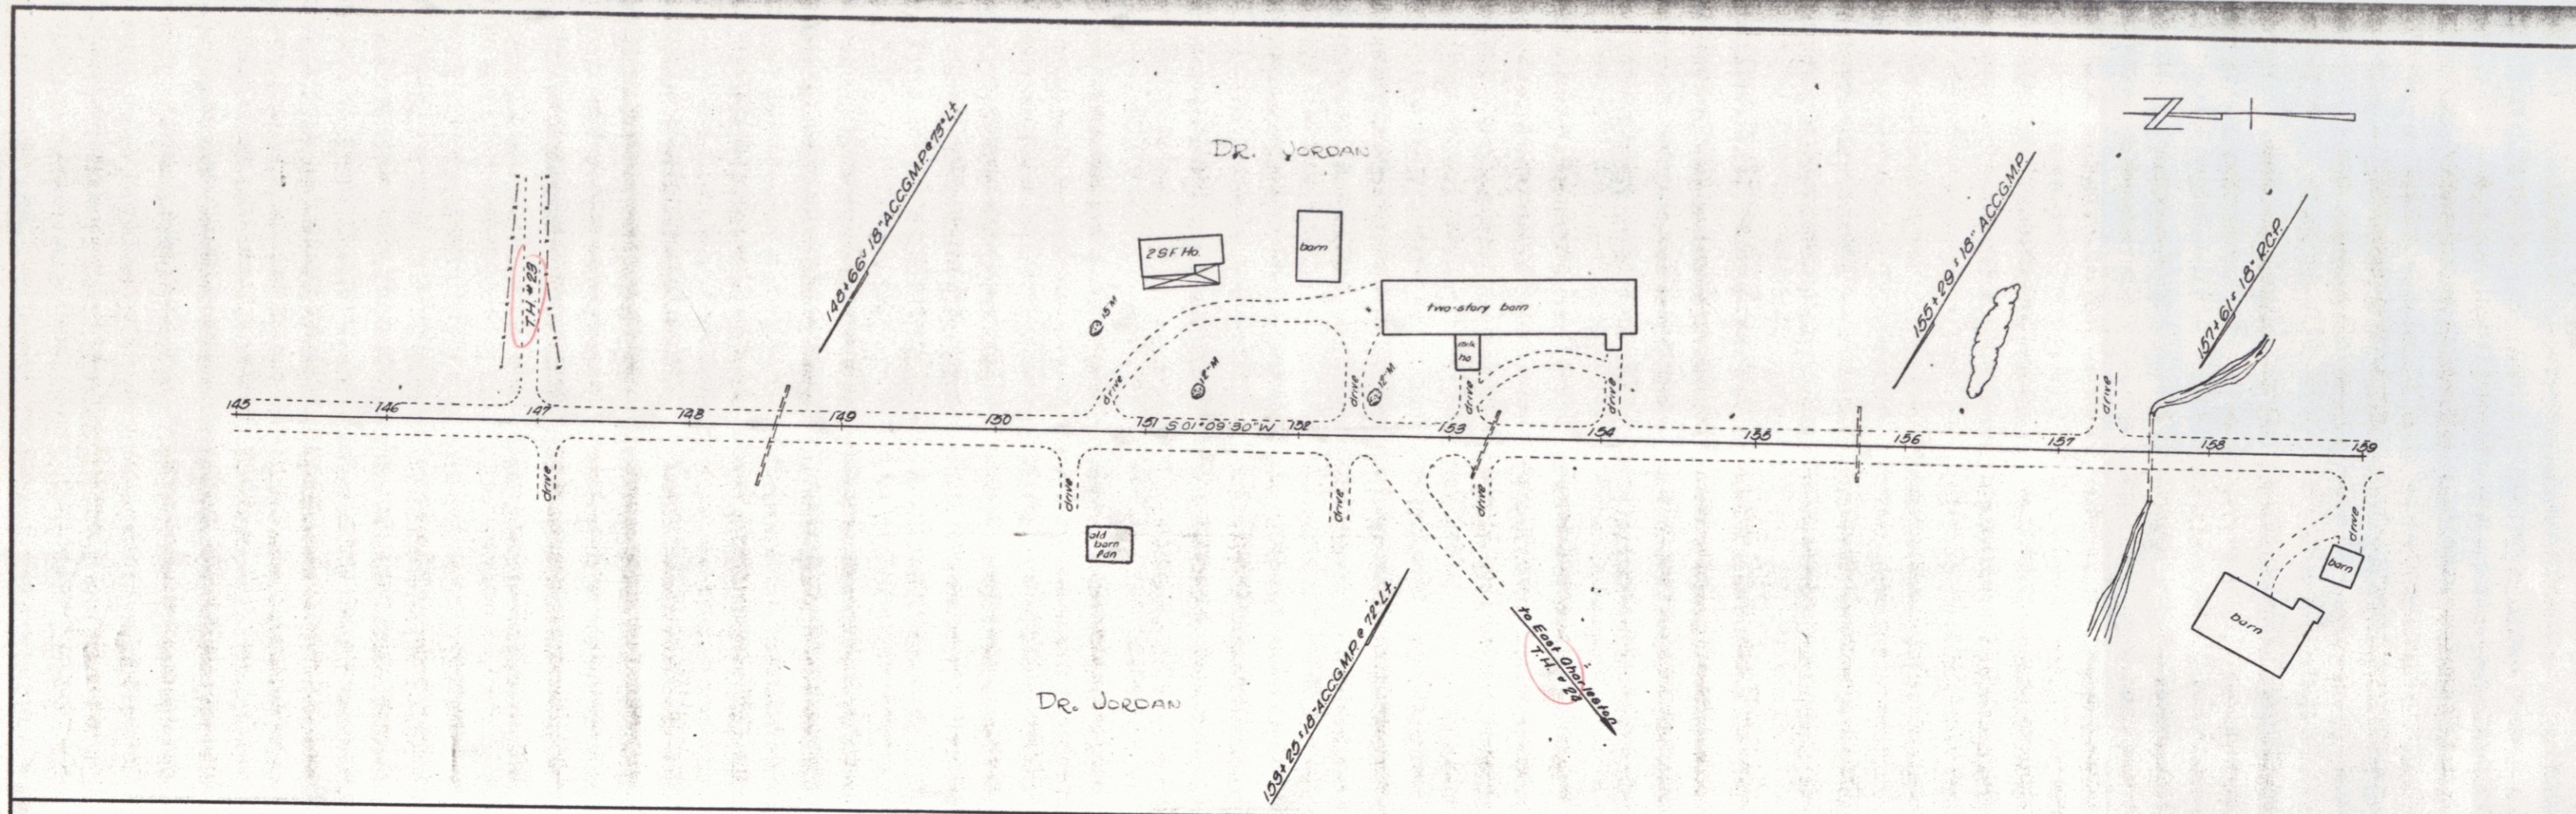


CURVE DATA
 Δ 21°00'40" Lt
 D 3130
 R 1637.02
 T 308.37
 L 600.48
 E 279

CURVE DATA
 Δ 20°14'40" Rt
 D 9
 R 636.32
 T 113.80
 L 225.00
 E 10.1

SURVEYED BY Hoot DATE 5-58
 DRAWN BY WAL DATE 2-67
 TRACED BY WAL DATE 2-67
 MORGAN
 Vt. Route # 111
 SCALE: 1" = 100' ± DET
 SHEET 15 OF 21
 D-7


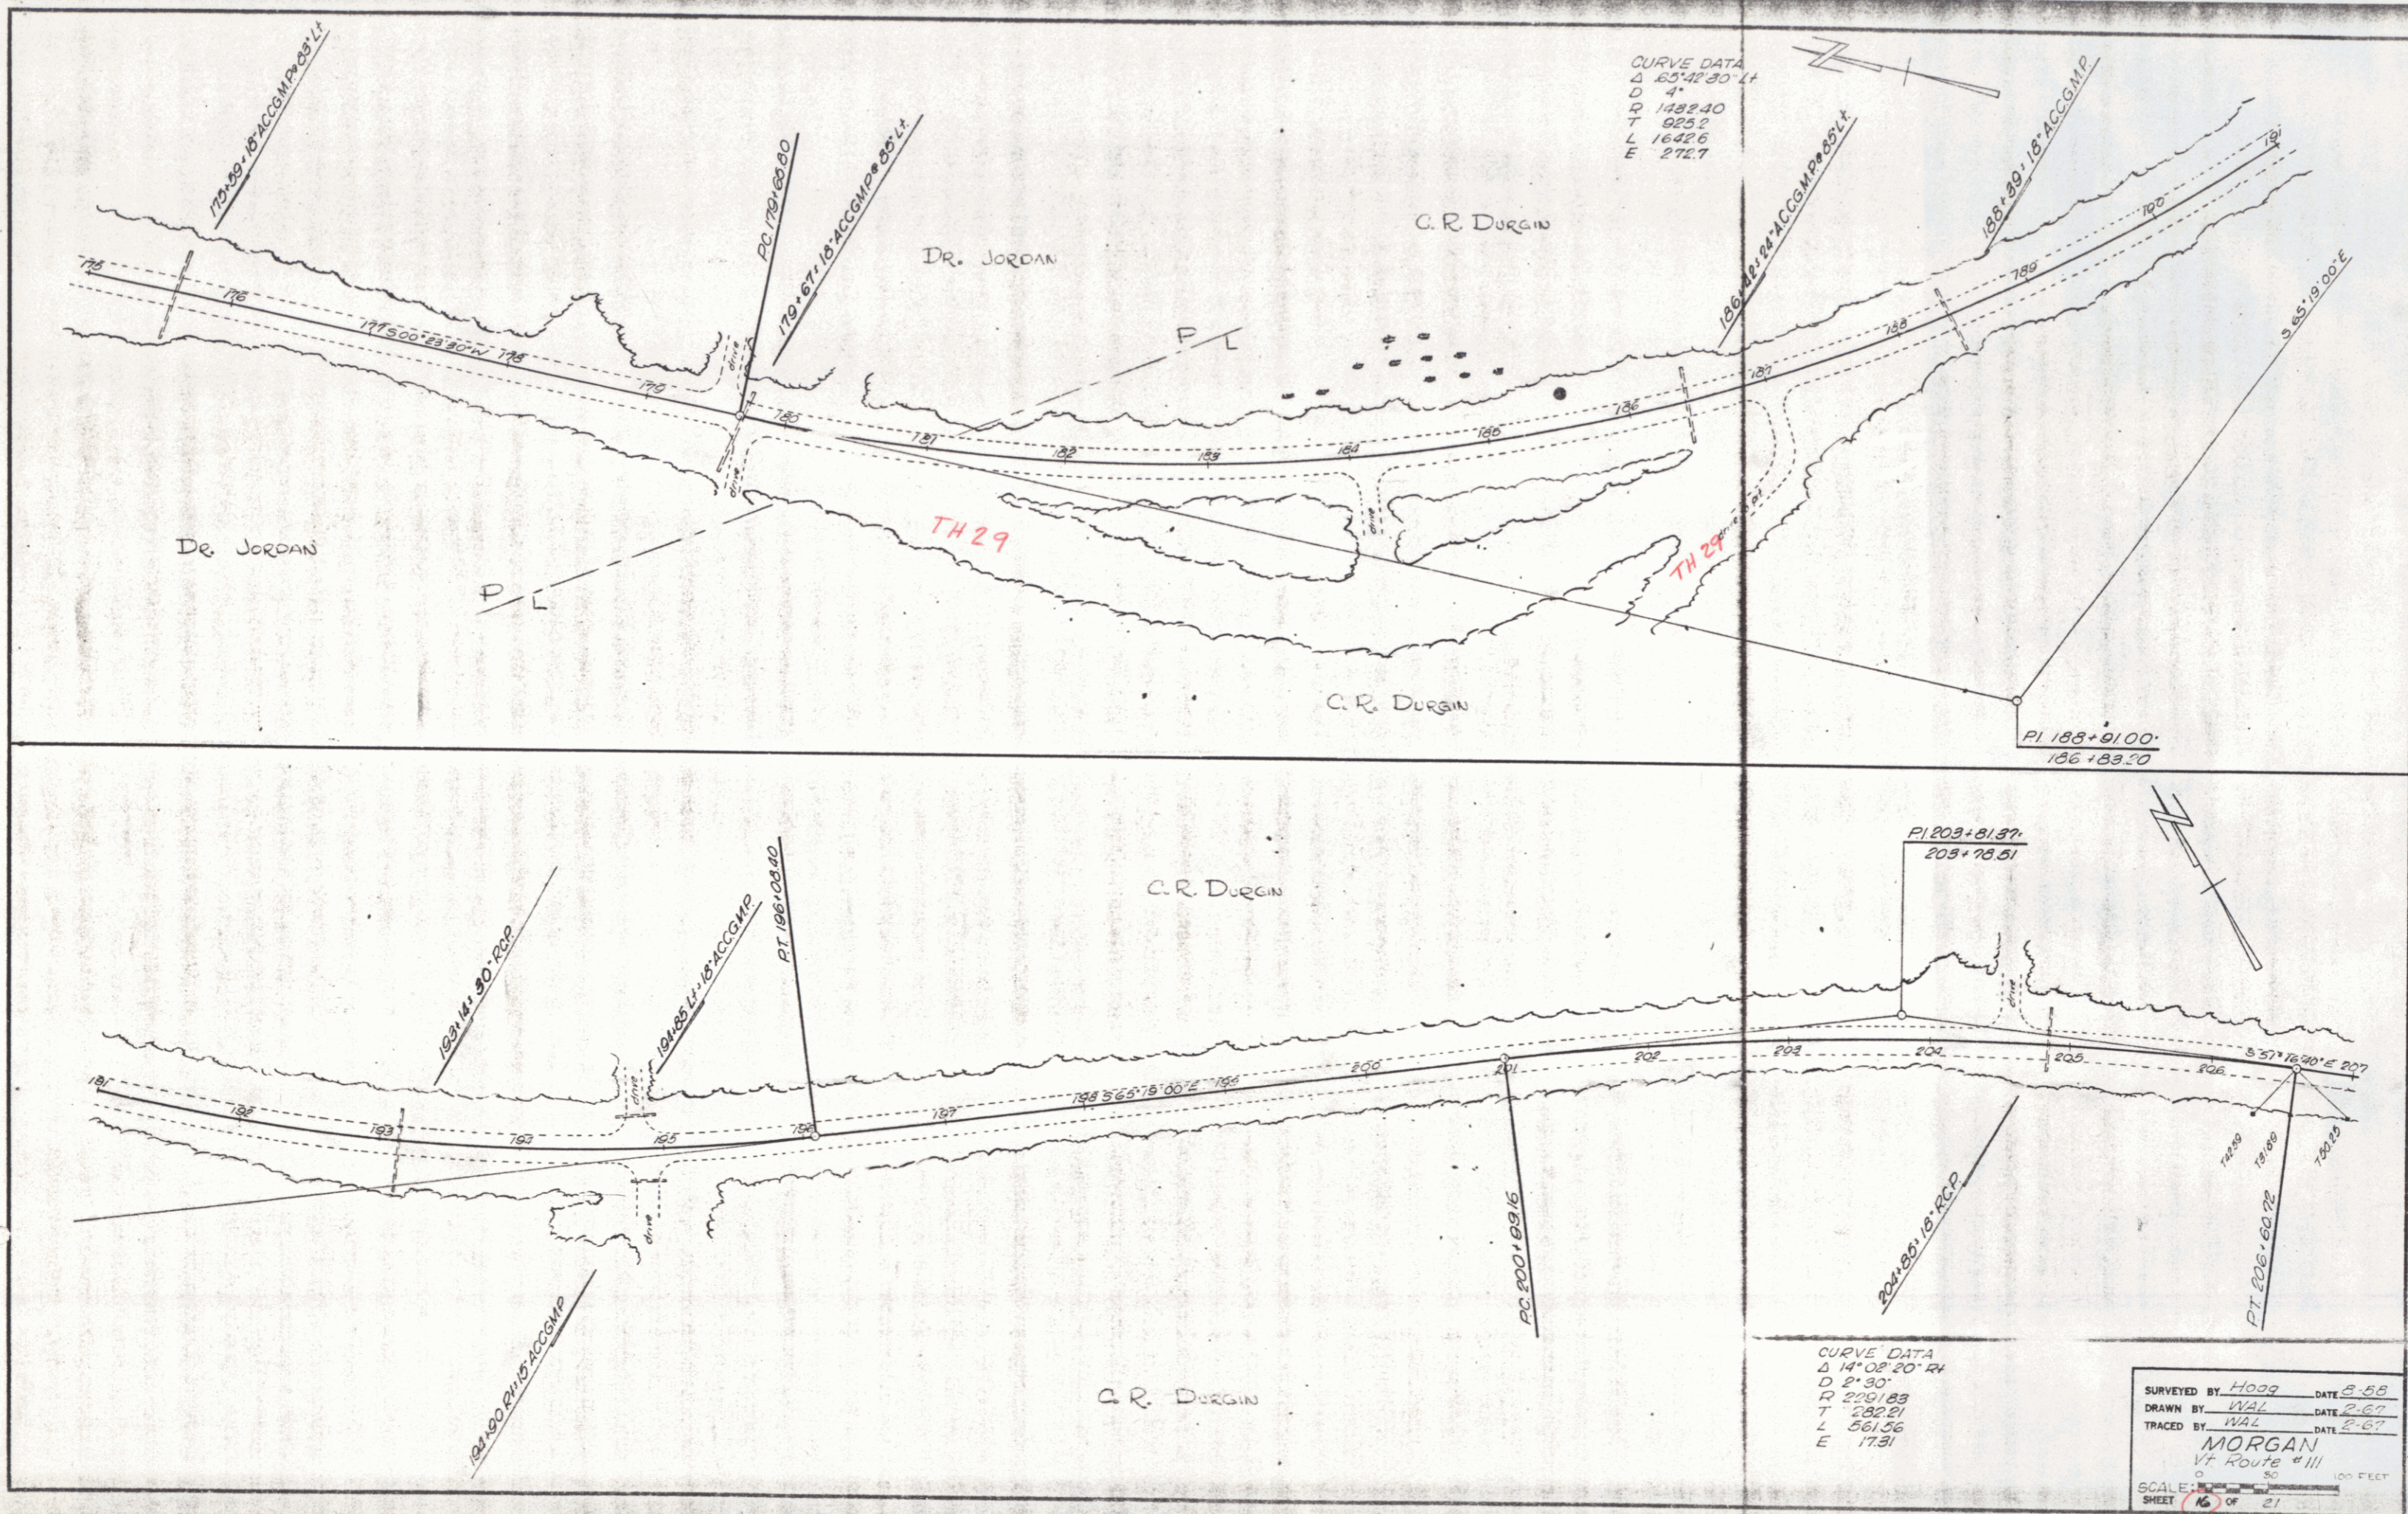


CURVE DATA
 Δ 65°42'30" LT
 D 4'
 R 1482.40
 T 925.2
 L 1642.6
 E 272.7

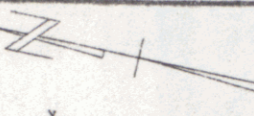


CURVE DATA
 Δ 14°08'20" RH
 D 2'30"
 R 220/83
 T 232.21
 L 361.26
 E 17.31

SURVEYED BY Hogg DATE 8-58
 DRAWN BY WAL DATE 2-67
 TRACED BY WAL DATE 8-67
MORGAN
 VT ROUTE #111
 SCALE: 1" = 50' 100 FEET
 SHEET 16 OF 21

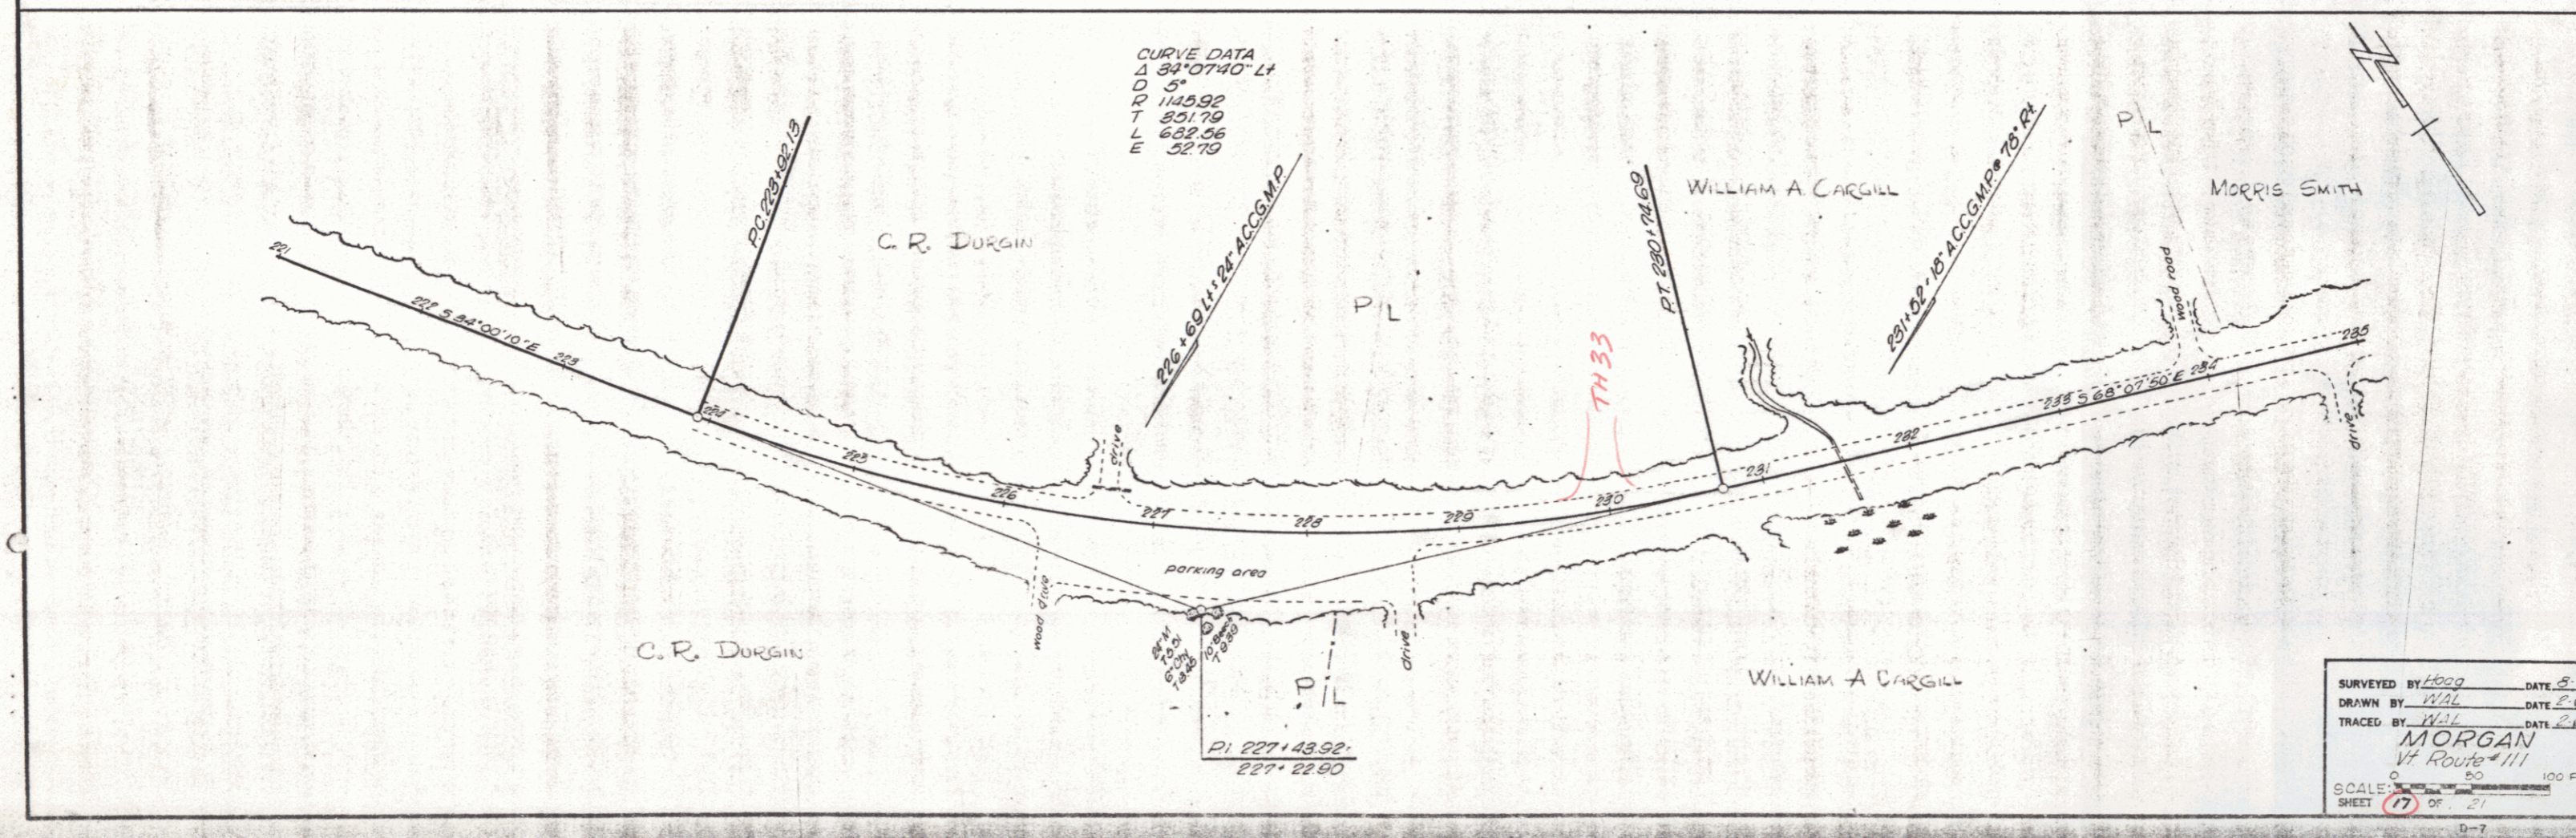
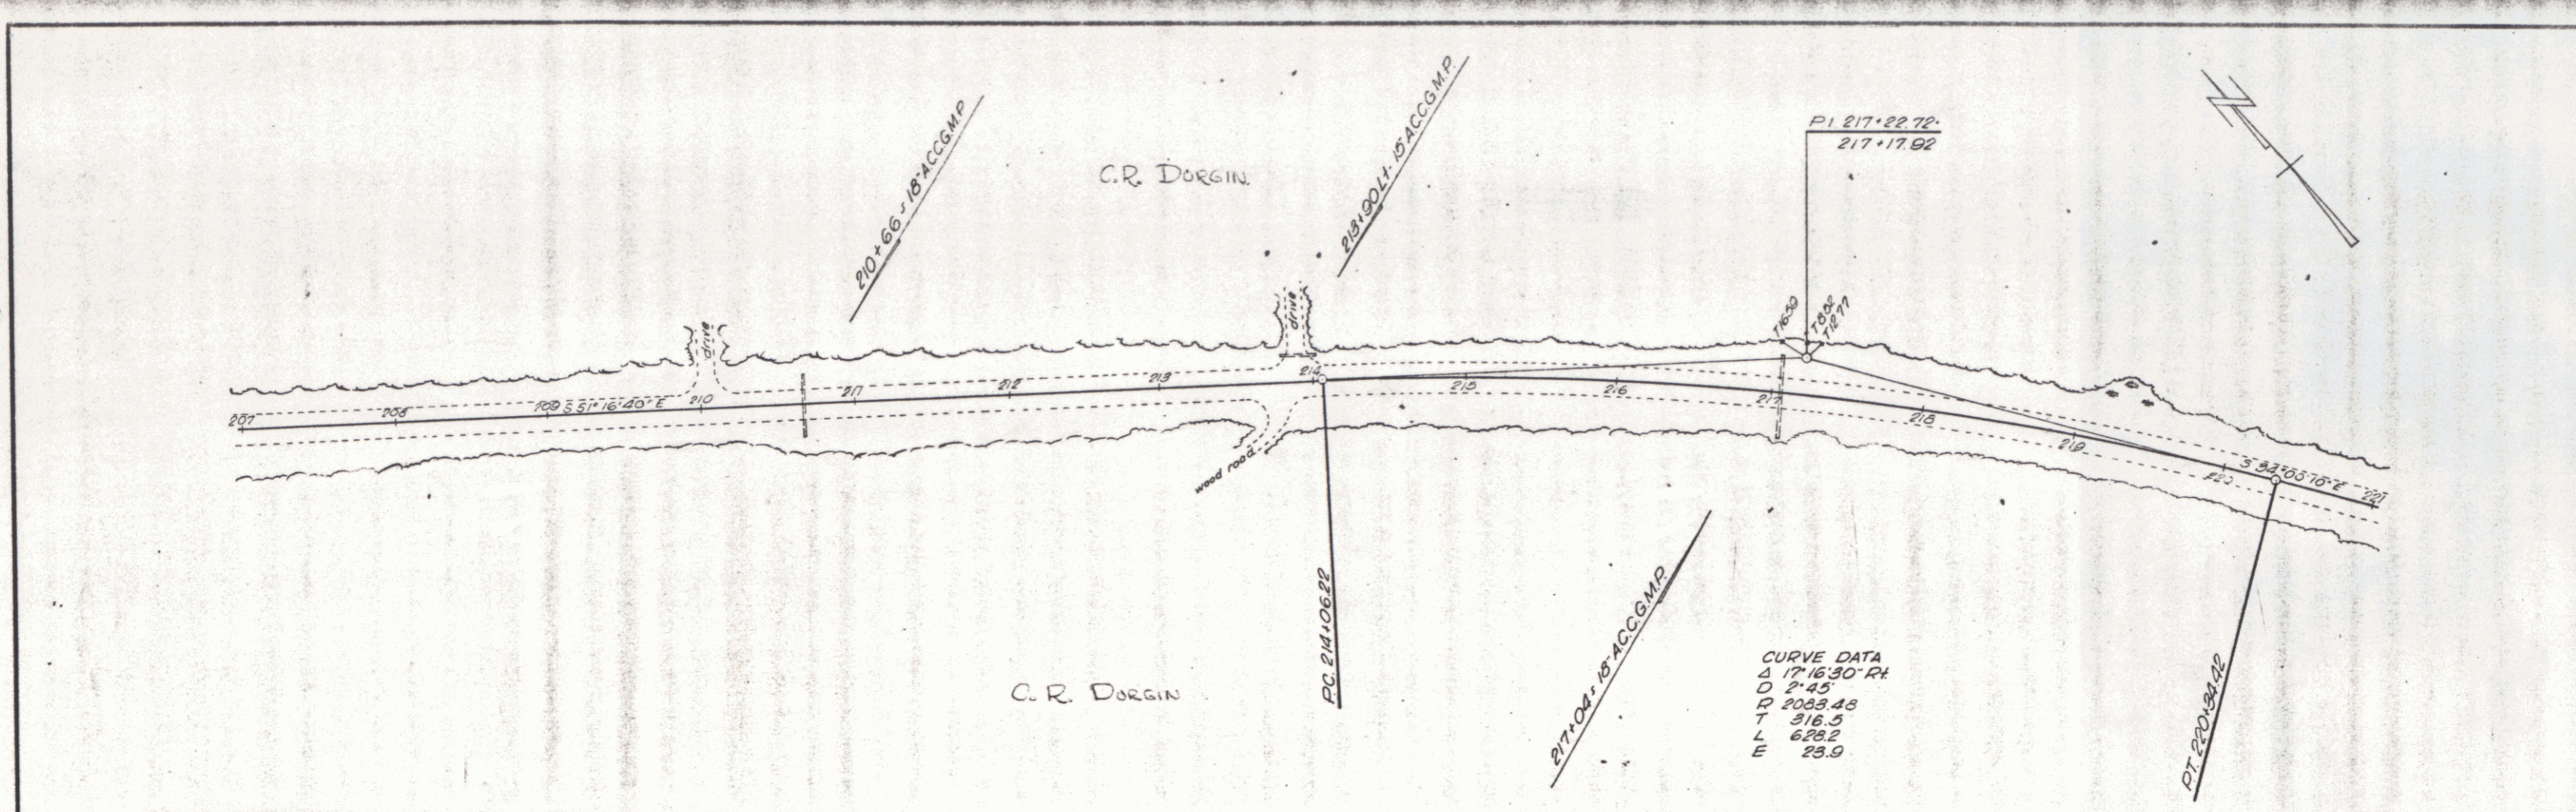


SURVEYED BY	WAL	DATE	5-58
DRAWN BY	WAL	DATE	2-67
TRACED BY	WAL	DATE	2-67
MORGAN			
Vt Route # 111			
SCALE:	1" = 50' 100 FEET		
SHEET	(7)	OF	21

20

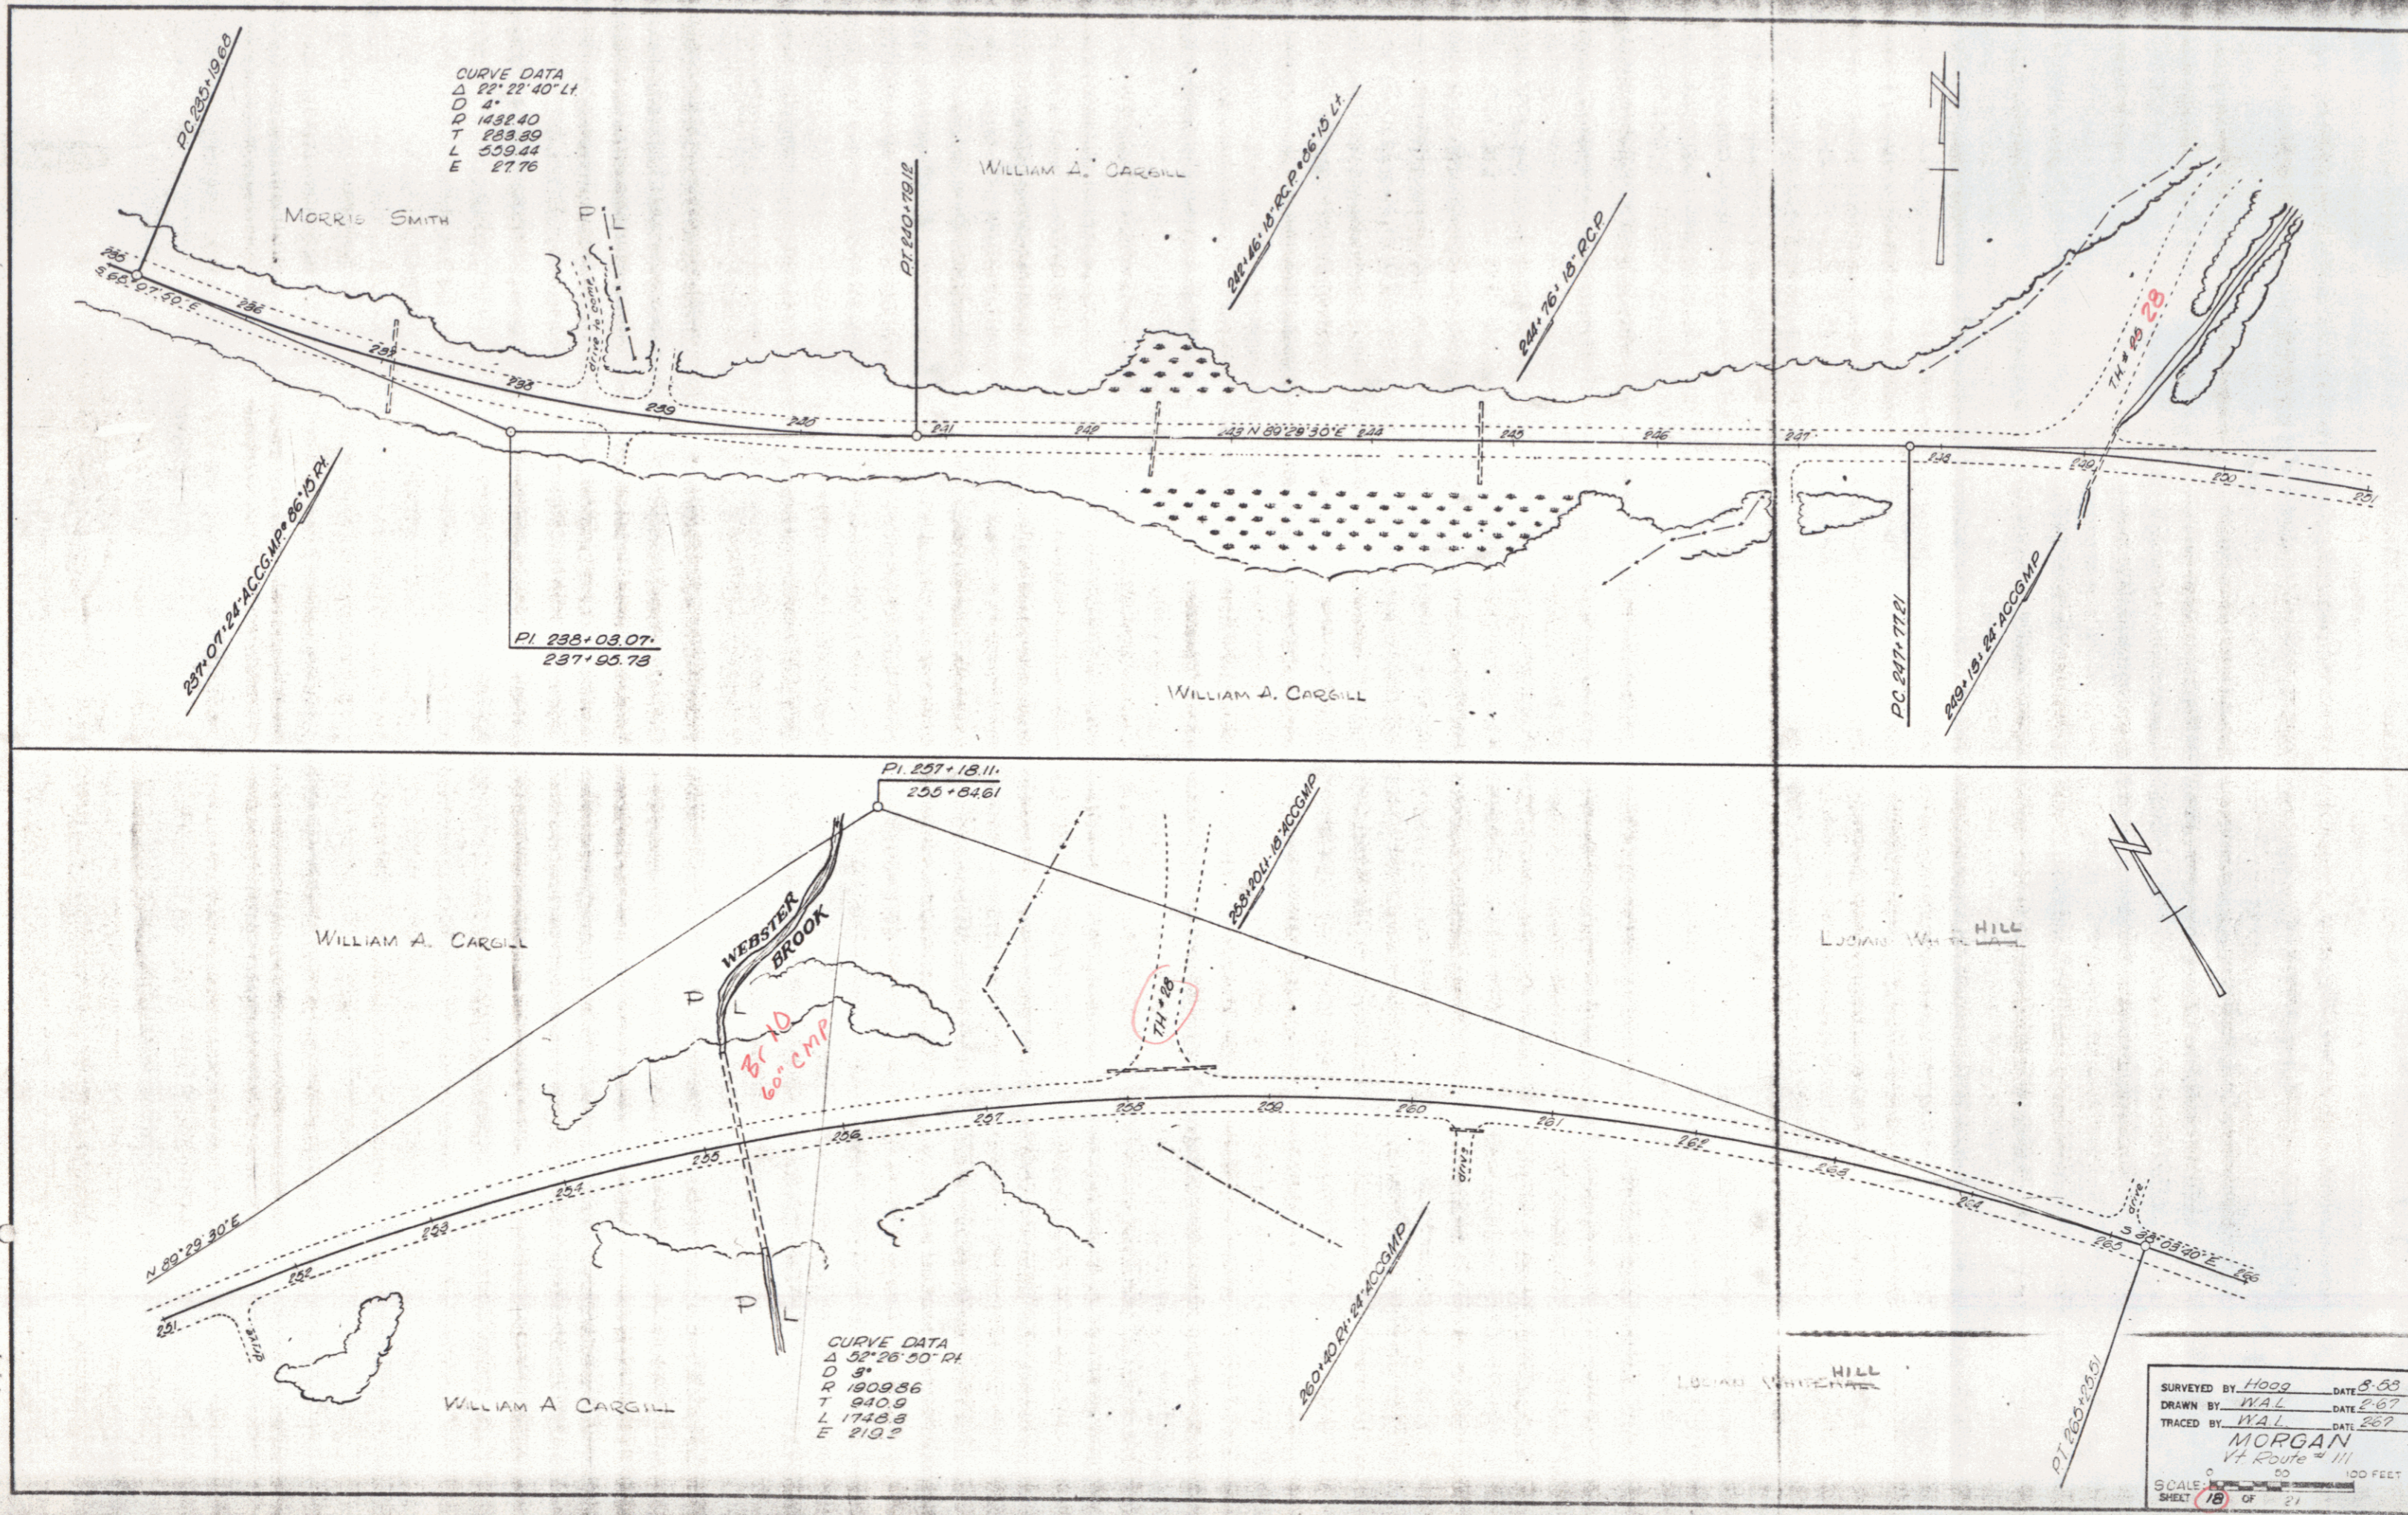


SURVEYED BY Hoag DATE 3-03
 DRAWN BY WAL DATE 2-67
 TRACED BY WAL DATE 2-67
MORGAN
 Vt. Route 111
 SCALE 1" = 50' 100 FEET
 SHEET 18 OF 27
 D-7

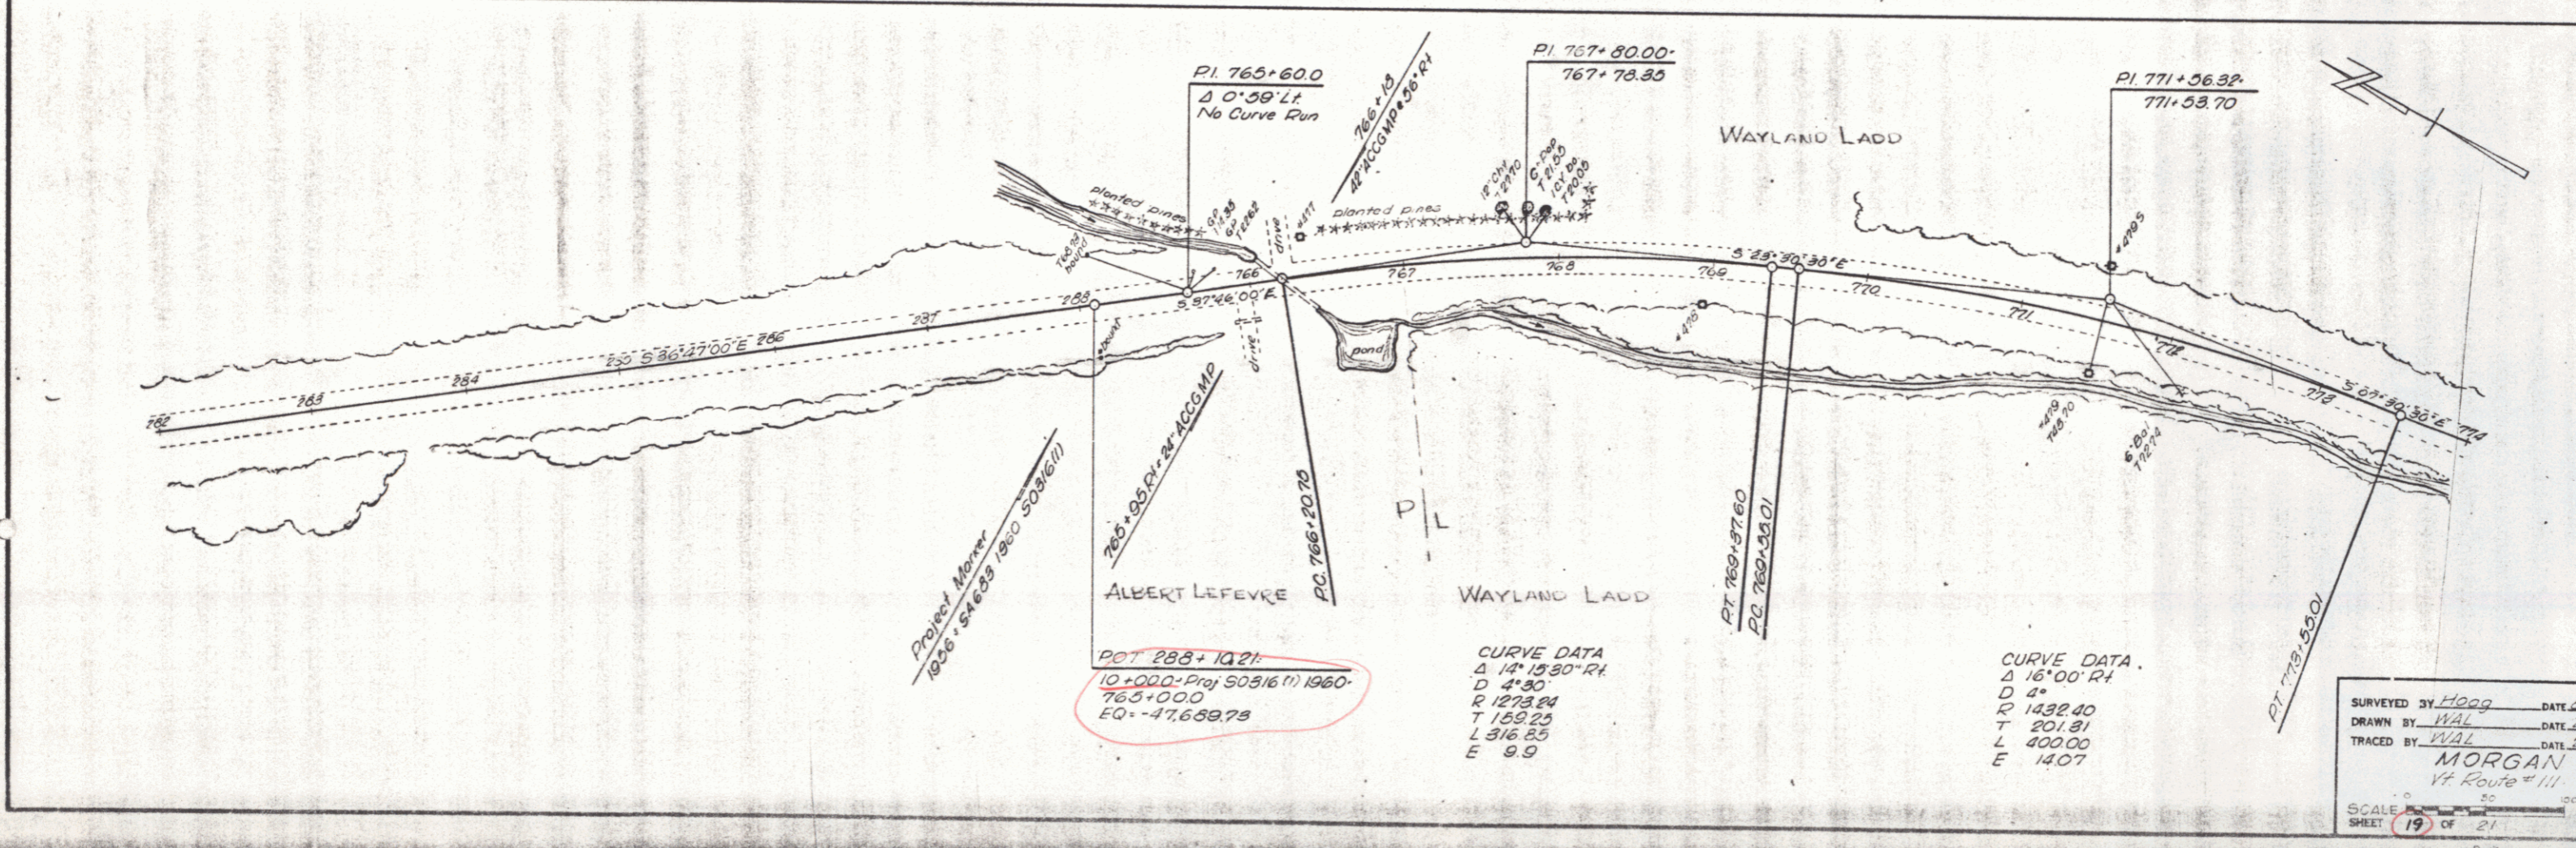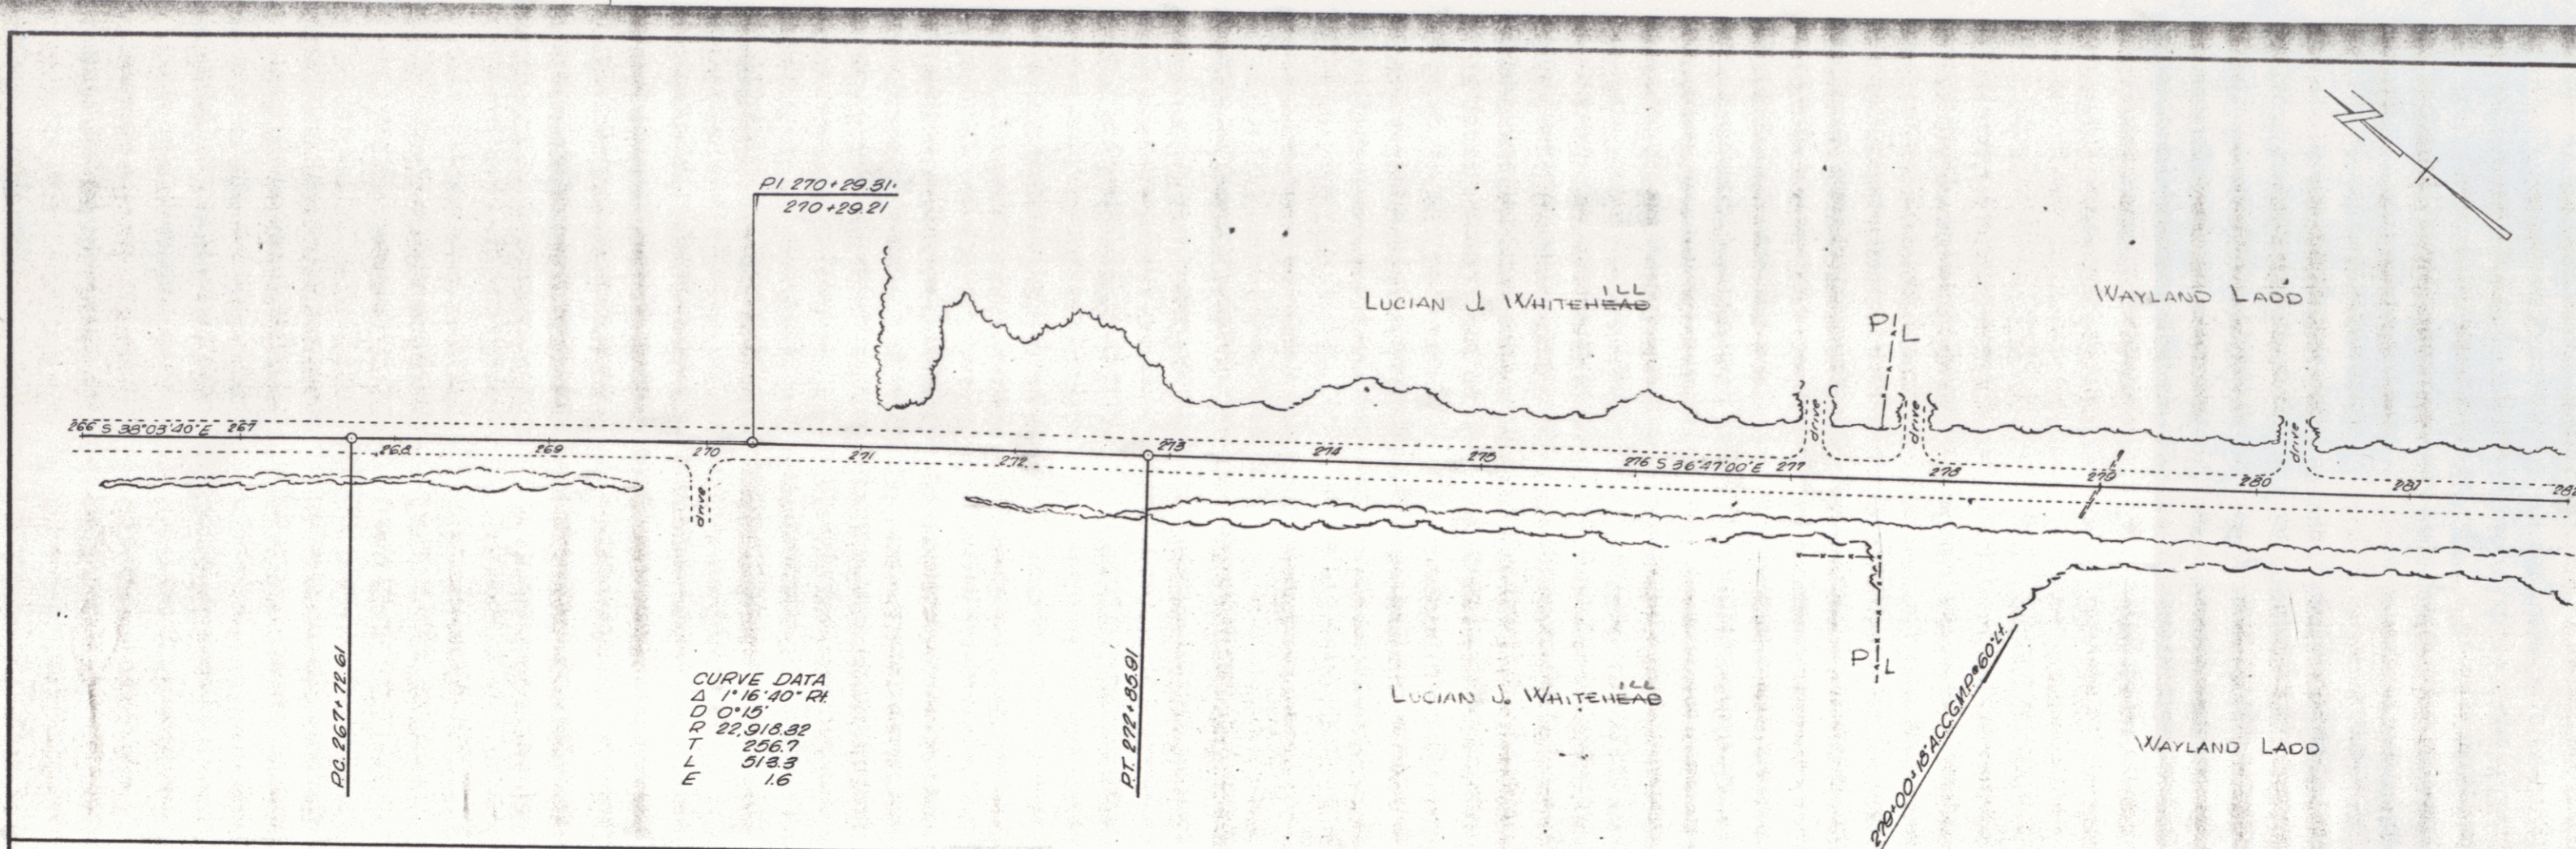

PC 765+10.21
 10+000-Proj 50316(1) 1960
 765+00.00
 EQ -47.658,73

SURVEYED BY Hoag DATE 2.58
 DRAWN BY WAL DATE 2.67
 TRACED BY WAL DATE 2.67
 MORGAN
 Vt Route # 111
 SCALE 1" = 50 FEET
 SHEET 19 OF 21

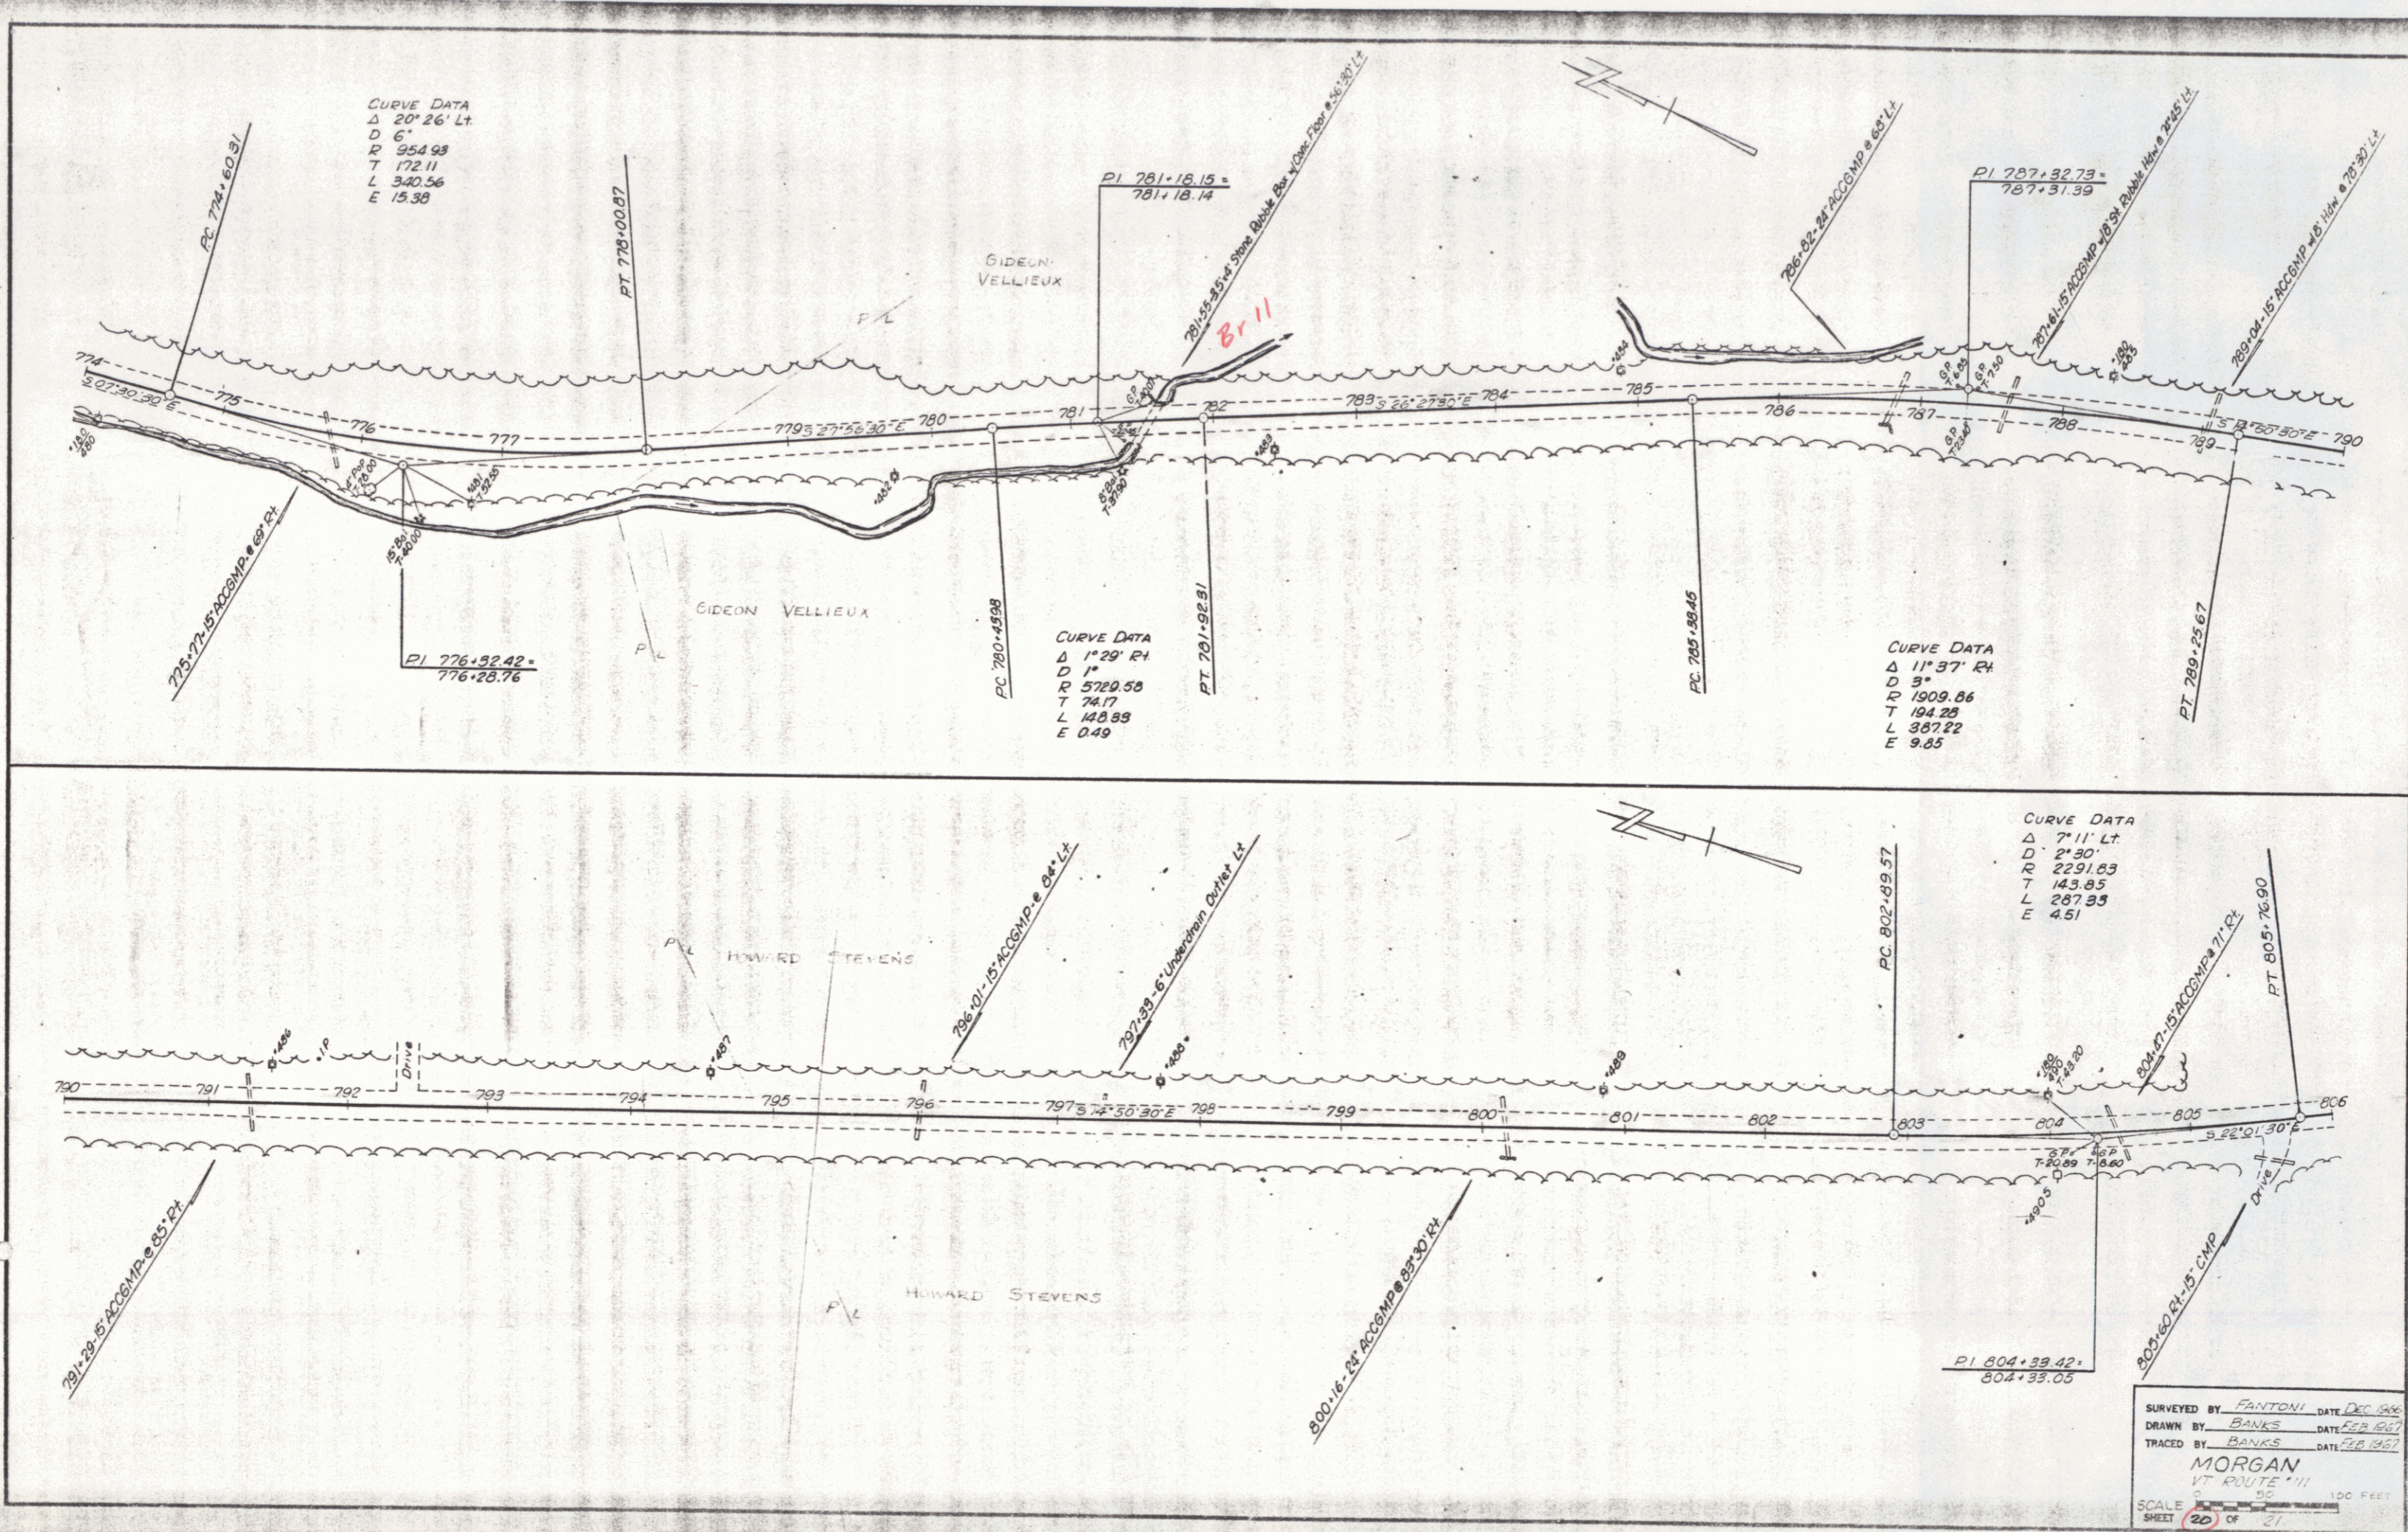


CURVE DATA
 Δ 20° 26' Lt
 D 6'
 R 350.98
 T 172.11
 L 340.56
 E 15.38

CURVE DATA
 Δ 1° 29' Rt
 D 1'
 R 5729.58
 T 74.17
 L 143.88
 E 0.49

CURVE DATA
 Δ 11° 37' Rt
 D 3'
 R 1909.86
 T 194.28
 L 387.22
 E 9.85

CURVE DATA
 Δ 7° 11' Lt
 D 2° 30'
 R 2291.63
 T 143.85
 L 287.93
 E 4.51

SURVEYED BY FANTONI DATE DEC 1956
 DRAWN BY BANKS DATE FEB 1957
 TRACED BY BANKS DATE FEB 1957
MORGAN
 VT ROUTE #111
 SCALE 1" = 50' 100 FEET
 SHEET 20 OF 21

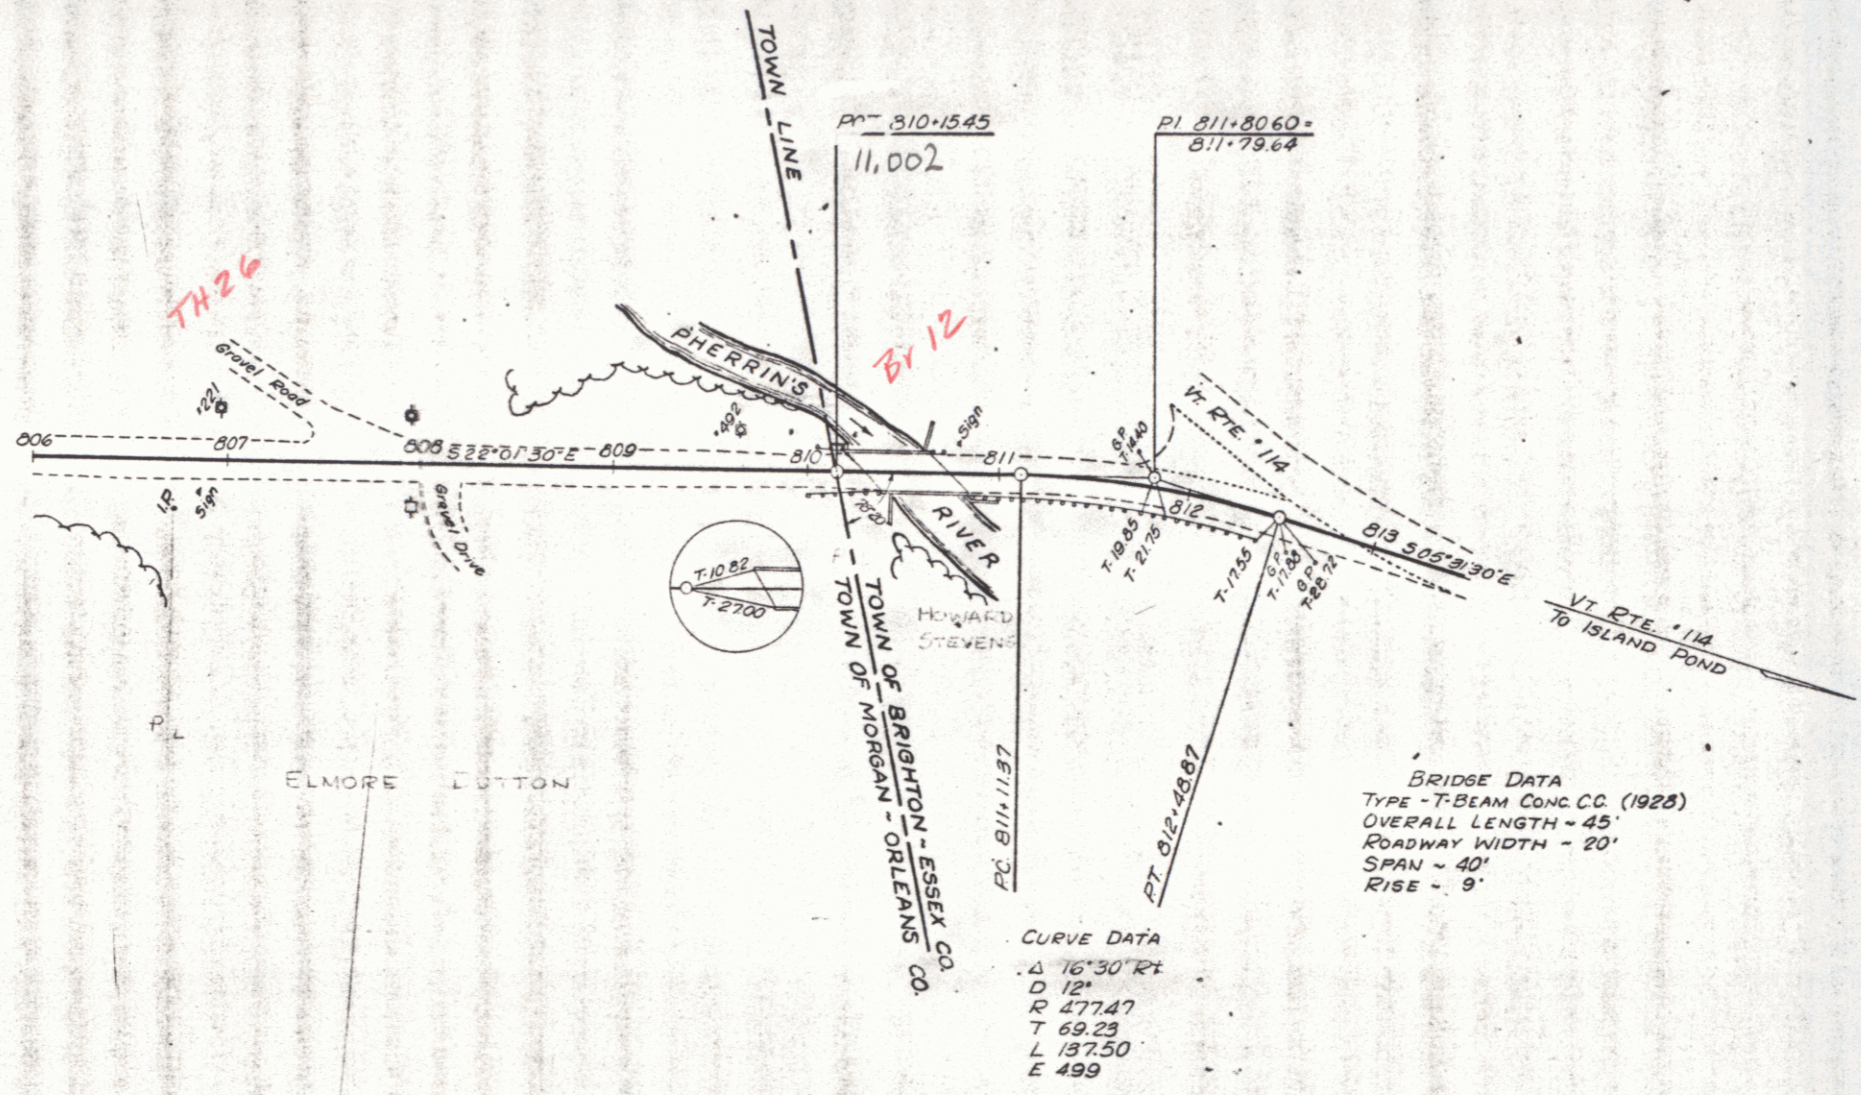

BRIDGE DATA
 TYPE - T-BEAM CONC CC (1928)
 OVERALL LENGTH - 45'
 ROADWAY WIDTH - 20'
 SPAN - 40'
 RISE - 9'

CURVE DATA
 Δ 16°30' RT
 D 12'
 R 477.47
 T 69.23
 L 137.50
 E 499

SURVEYED BY FANTONI DATE DEC 1966
 DRAWN BY BANKS DATE FEB 1967
 TRACED BY BANKS DATE FEB 1967
MORGAN
 VT ROUTE #14
 SCALE 1" = 50 FEET
 SHEET 21 OF 27