


PLAN
 Description
 CHAINING
 DATE
 TRIP

Profile
 CHAINING
 DATE

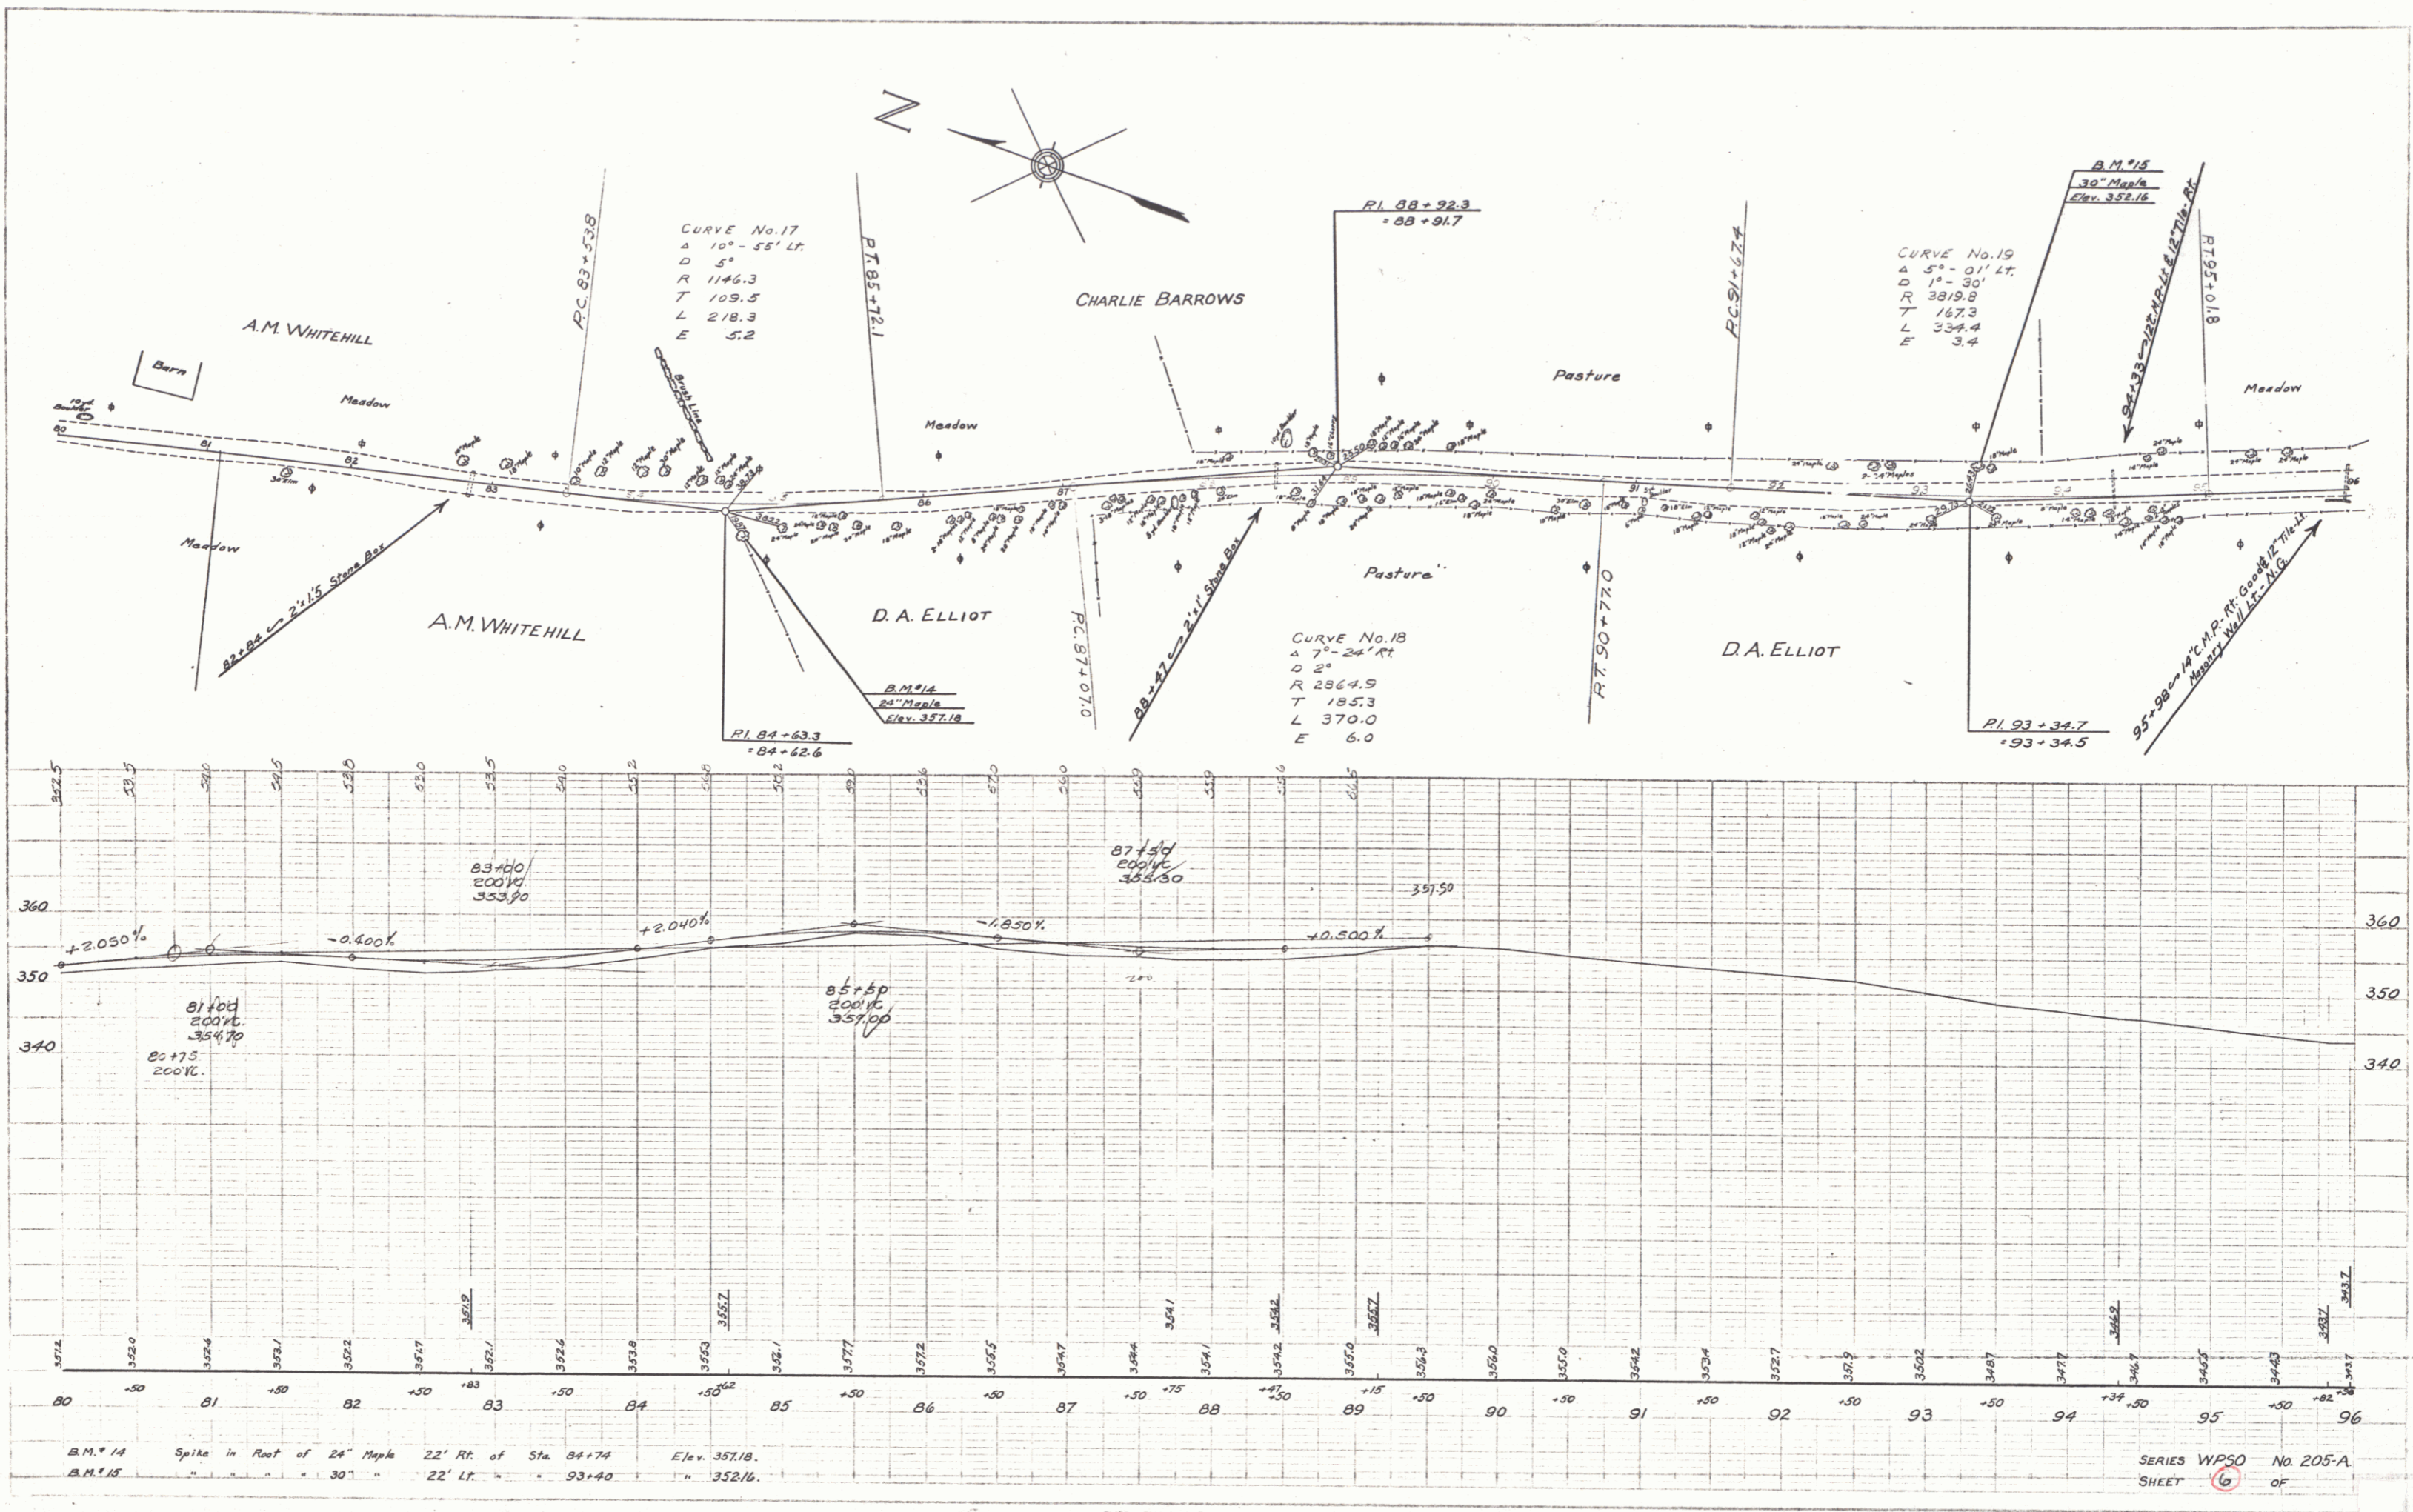

B.M. #14 Spike in Root of 24" Maple 22' Rt. of Sta. 84+74 Elev. 357.18.
 B.M. #15 " " " 30" " " 93+40 " 352.16.

SERIES WPSO No. 205-A
 SHEET 6 OF

MORGAN