


PLAN	DATE	BY
REVISED		
NOTED		
BY ROOM		
NO. OF MATCHES		
NO.		

PROFILE	DATE	BY
REVISED		
NOTED		
BY ROOM		
NO. OF MATCHES		
NO.		

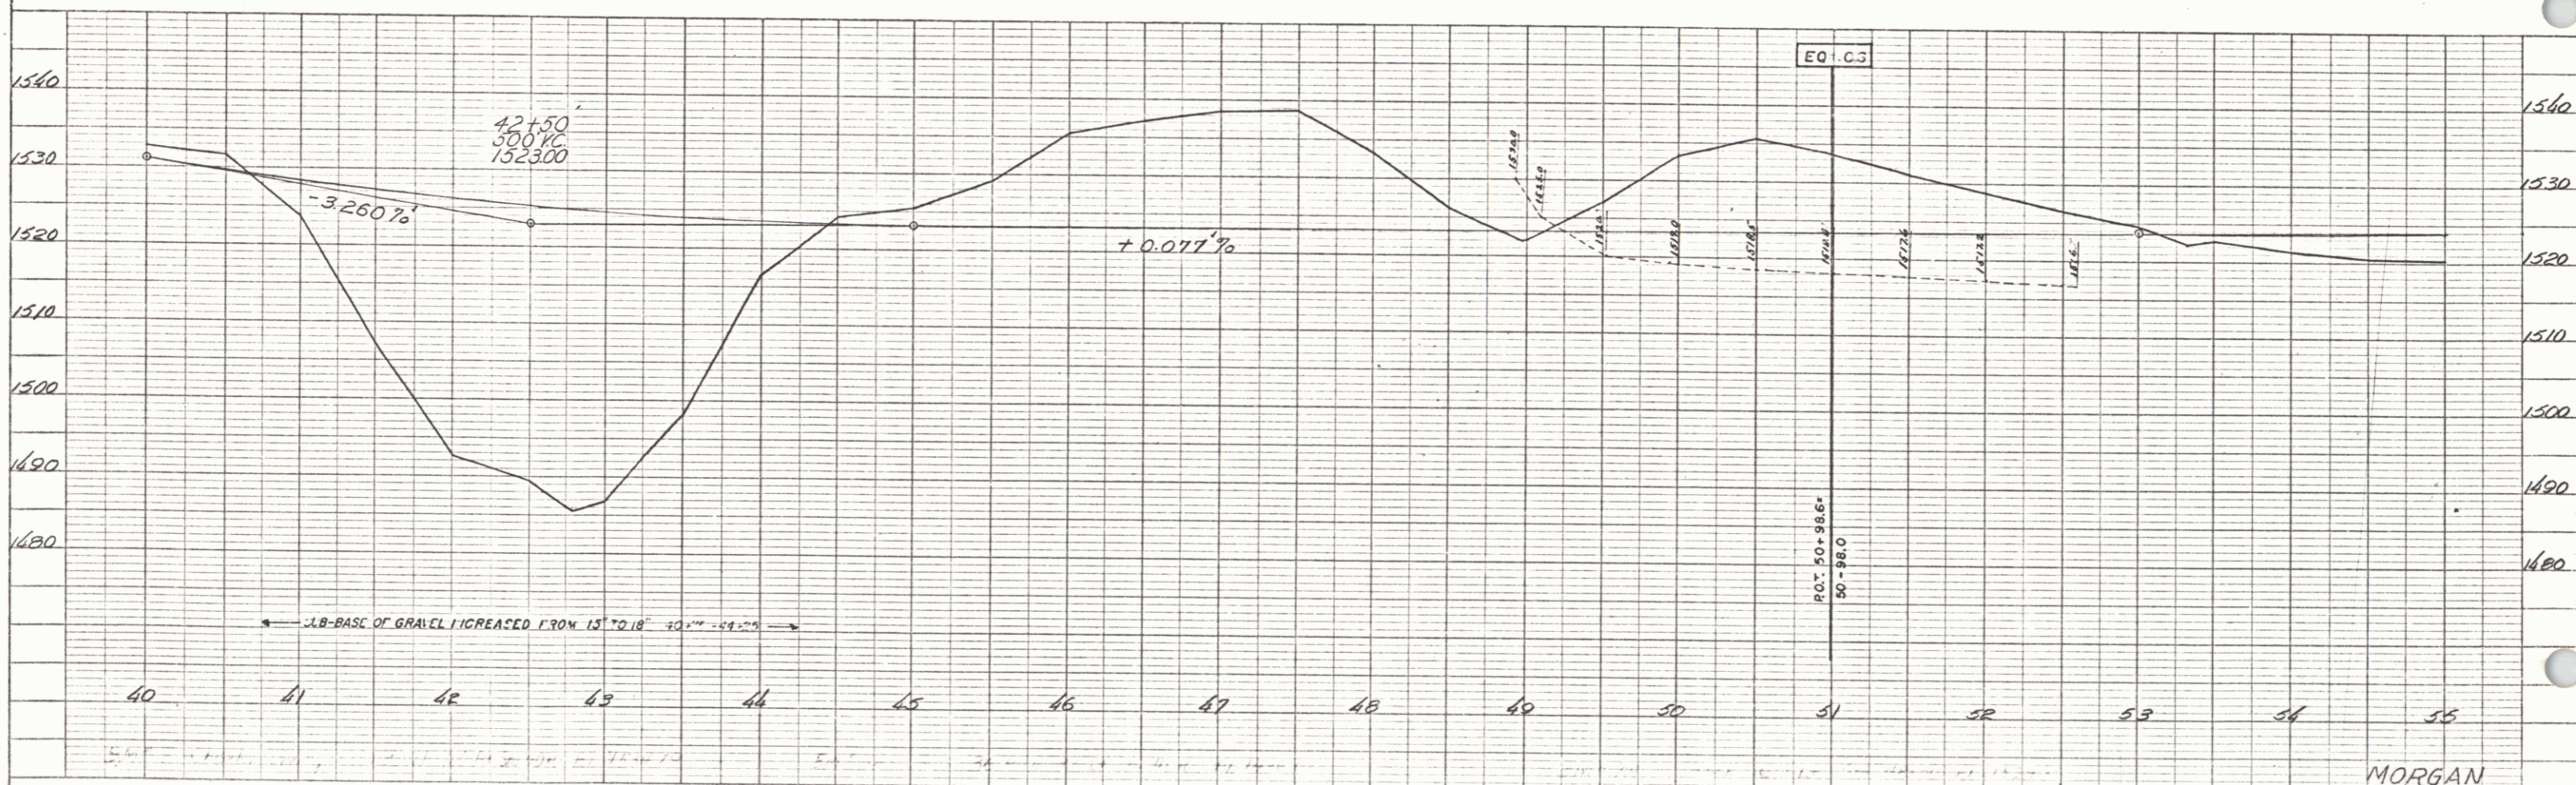

MORGAN  
Prof. S. No. 0316.11  
Sheet 19 of 27