
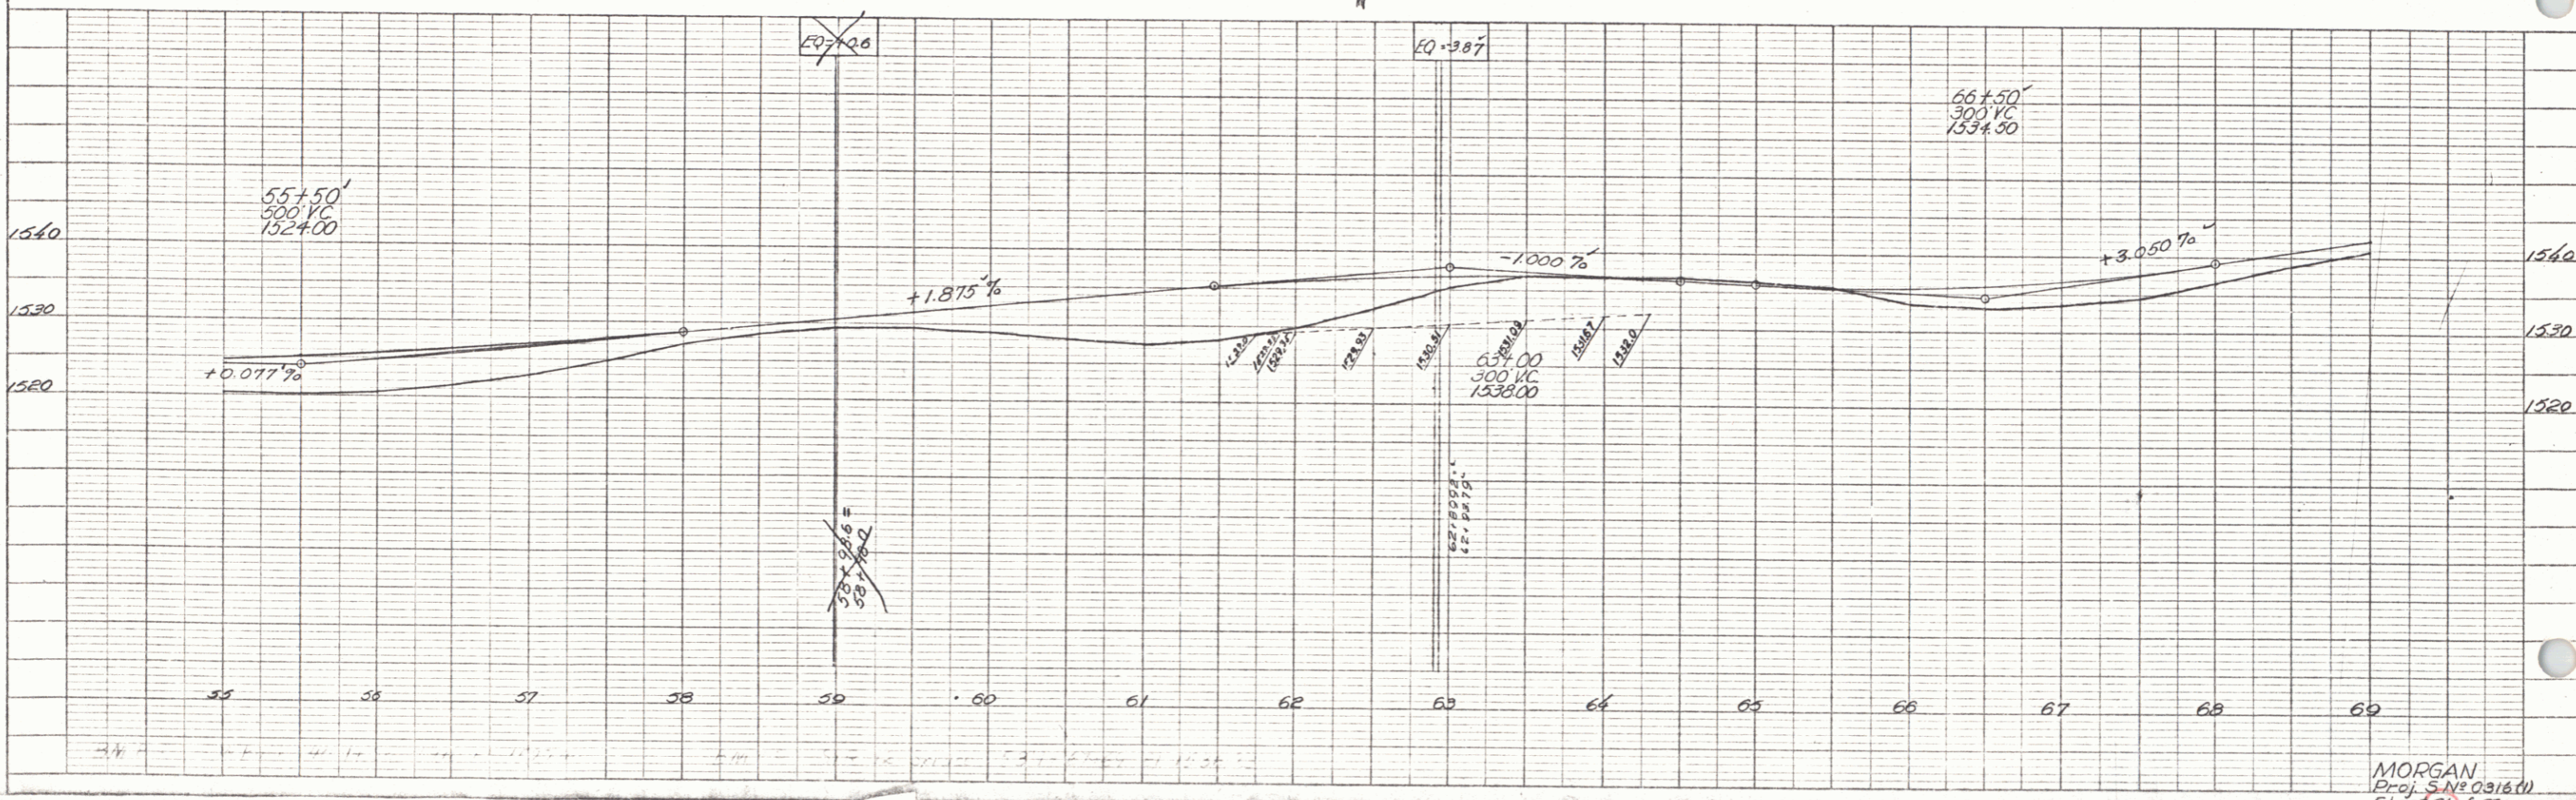


PLAN	REVISION
1	AS SHOWN
2	AS SHOWN
PROFILE	REVISION
1	AS SHOWN
2	AS SHOWN
3	AS SHOWN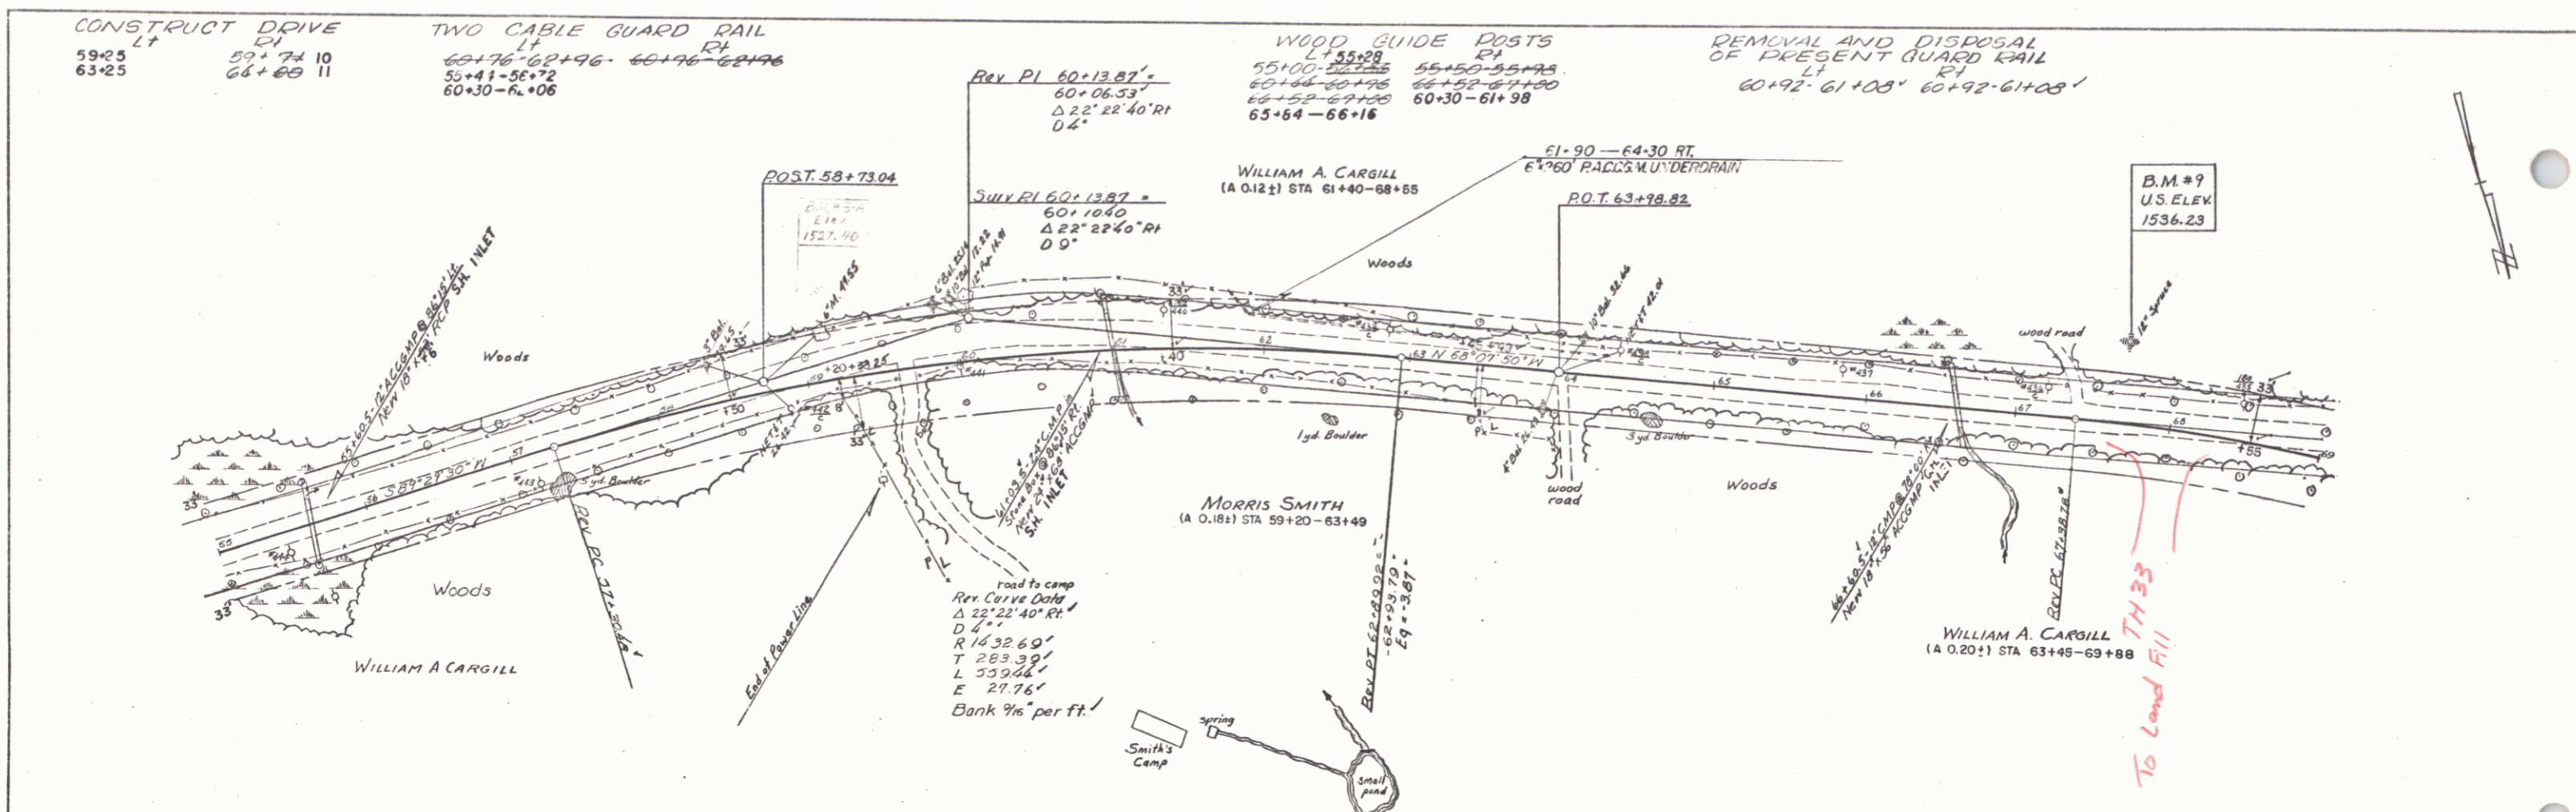
MORGAN
 Proj. S.N. 0316(1)
 Sheet 21 of 57