



CONSTRUCT DRIVE		TWO CABLE GUARD RAIL		WOOD GUIDE POSTS	
LT	RT	LT	RT	LT	RT
120+25	117+09	122+60-122+80	122+80-122+80	122+75-122+85	122+80-122+96
118+50	127+50.5	122+85-123+00	122+85-123+00	122+90-132+54	131+82-133+50
128+90	118+67	122+70-124+38	122+70-124+38	124+54-127+98	
		129+36-133+00			

DR. JORDAN
 (A 0.96%) STA 120+54 - 159+56
 SLOPE RIGHTS STA 132+50 - 127+50 LT.
 STA 132+50 - 133+50 RT.
 STA 142+50 - 143+50 LT.
 STA 143+50 - 150+50 LT.
 STA 158+00 - 159+00 LT.

PLAN
 DATE
 BY
 CHECKED
 IN CHARGE
 NOTE BOOK FILE NO.
 NO.

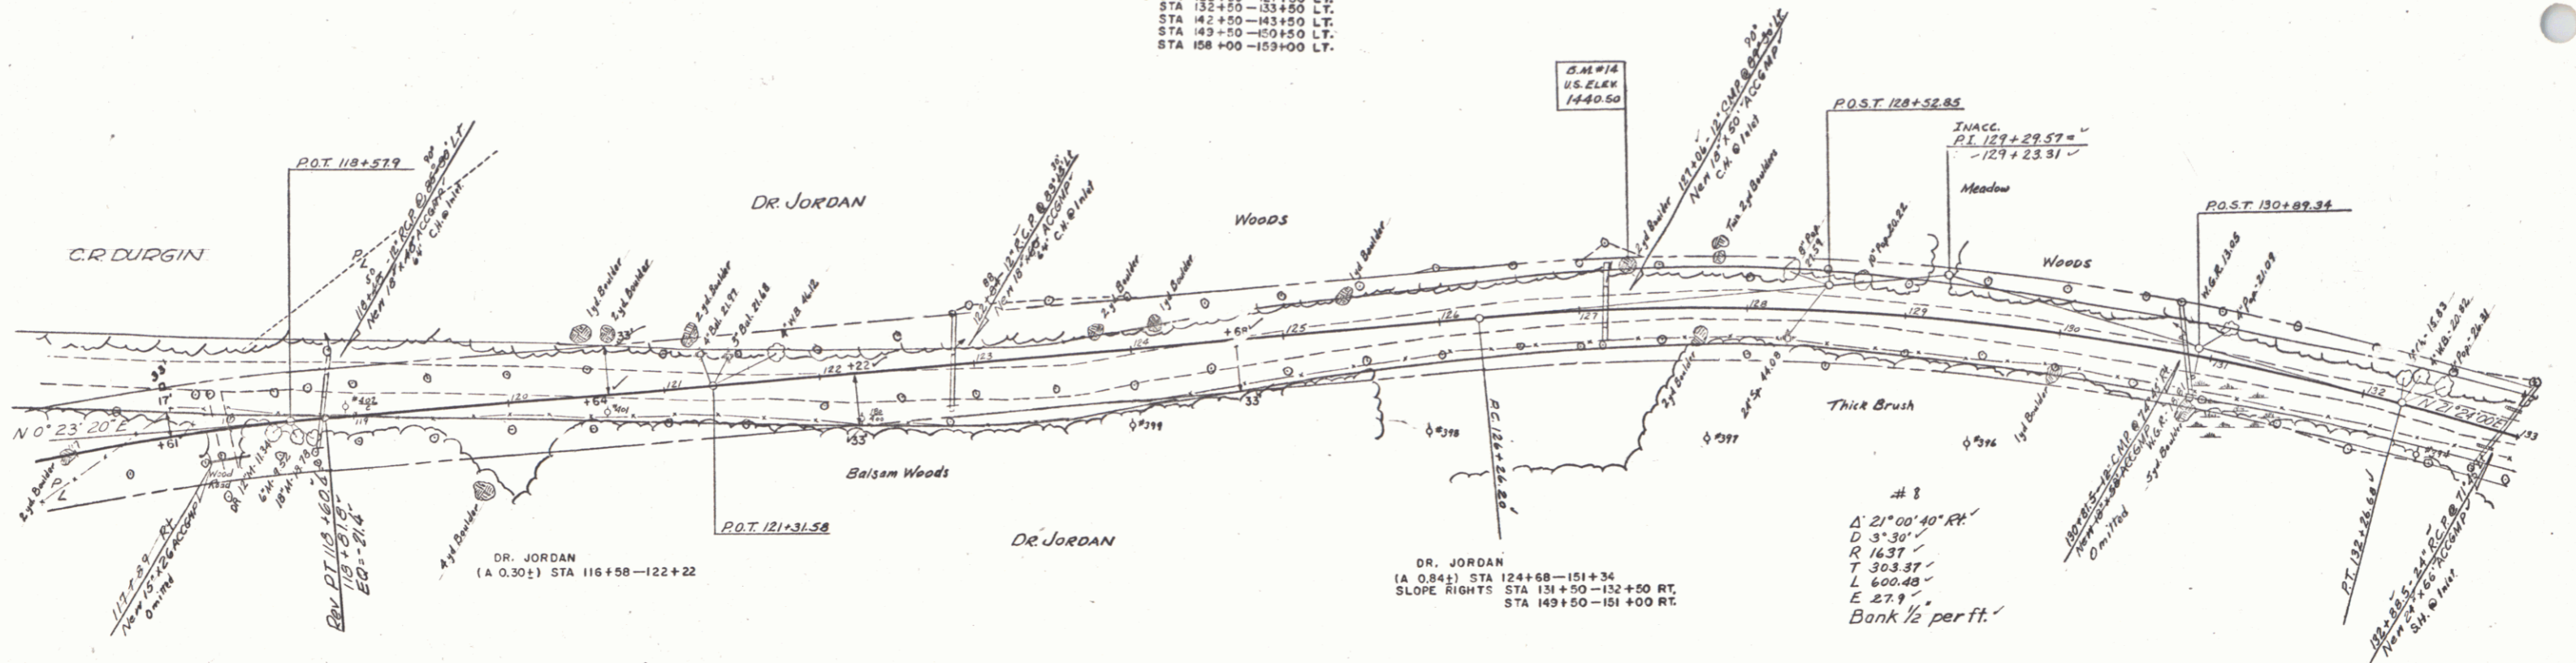

PROFILE
 DATE
 BY
 CHECKED
 IN CHARGE
 NOTE BOOK FILE NO.
 NO.

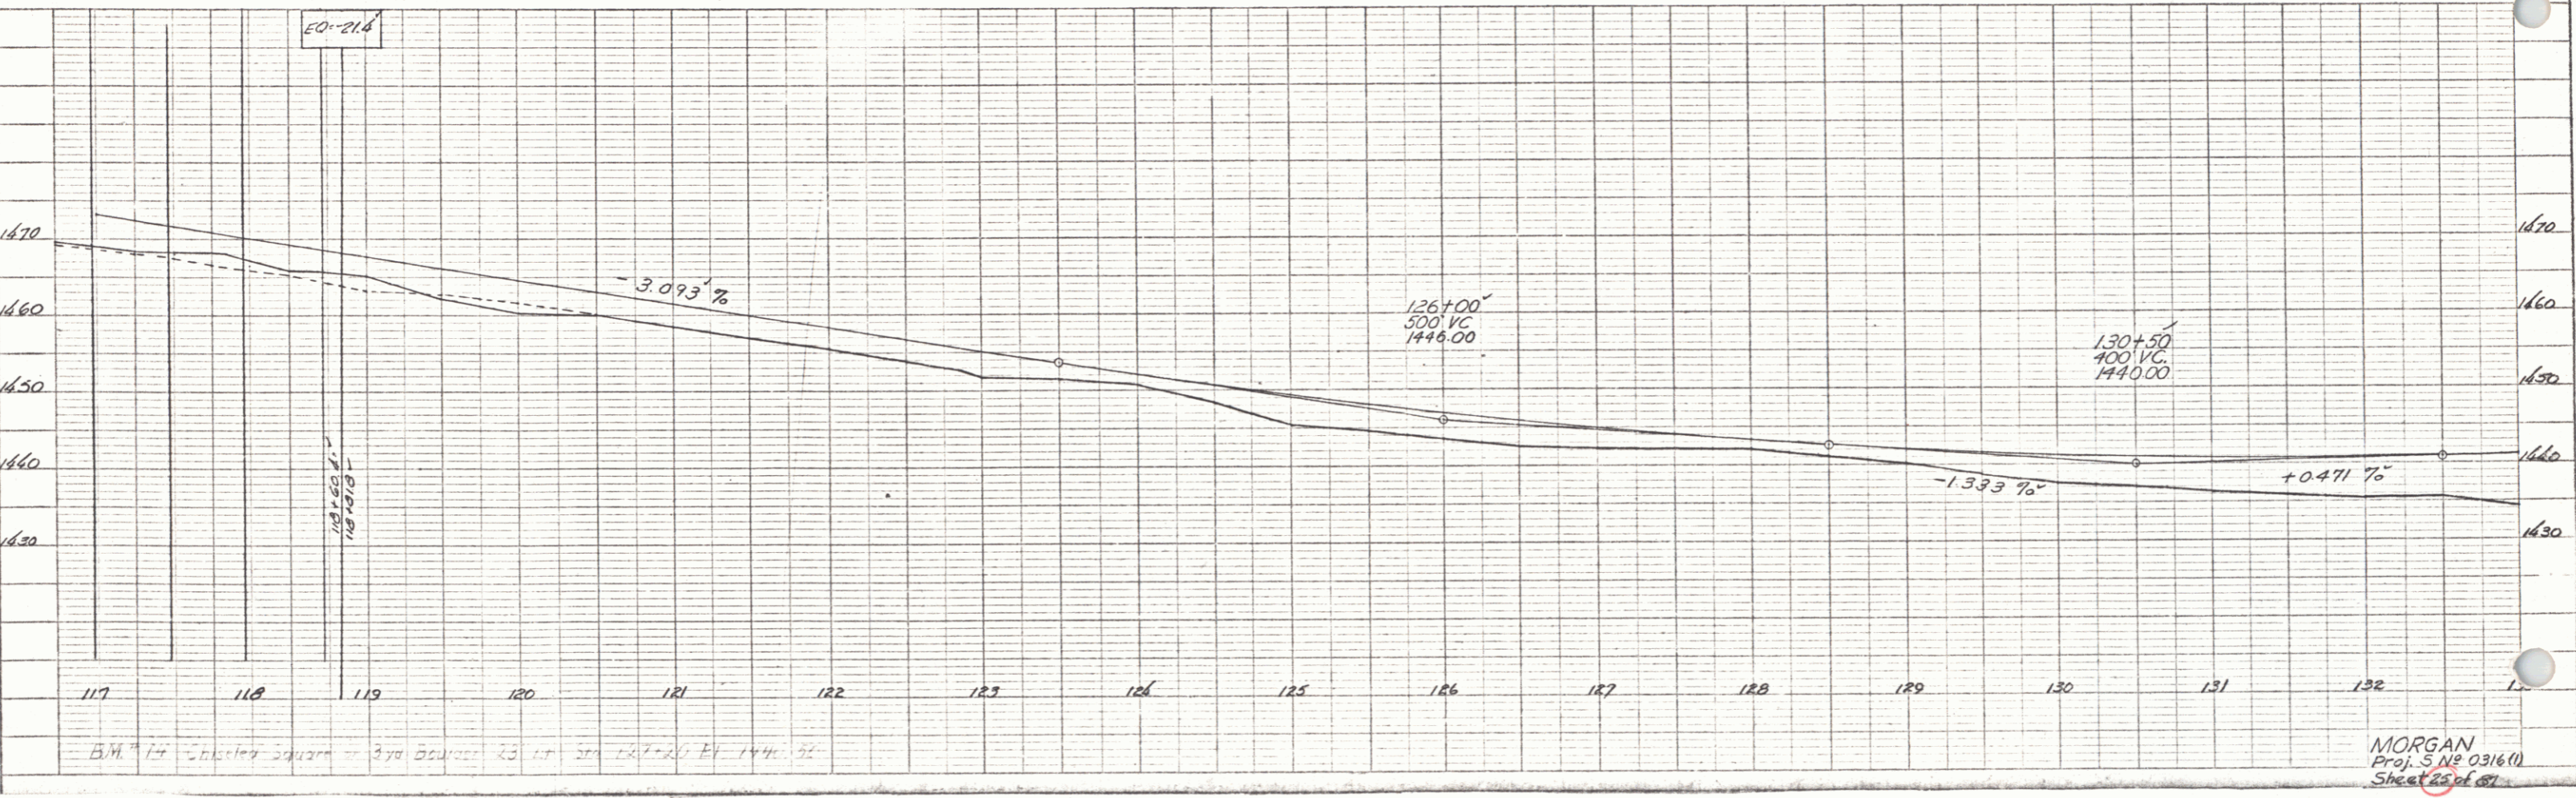

MORGAN
 Proj. S. N. E. 0316 (1)
 Sheet 25 of 87