

CONSTRUCT APPROACH
LT RT
146+00
145+32



CONSTRUCT DRIVE
LT RT
137+00-138+00
139+00-140+00
141+00-142+00
143+00-144+00
145+00-146+00
147+00-148+00

TWO CABLE GUARD RAIL
LT RT
133+00-133+00
134+00-134+00

WOOD GUIDE POSTS
LT RT
133+00-133+00
134+00-134+00

PLAN
DATE
BY
REVISIONS
NO. DATE
NOTE BOOK
ALIGNED CENTER LINE
HT. OF WIRE CHANGED

PROFILE
DATE
BY
REVISIONS
NO. DATE
NOTE BOOK
VERTICAL CURVES
HT. OF WIRE CHANGED

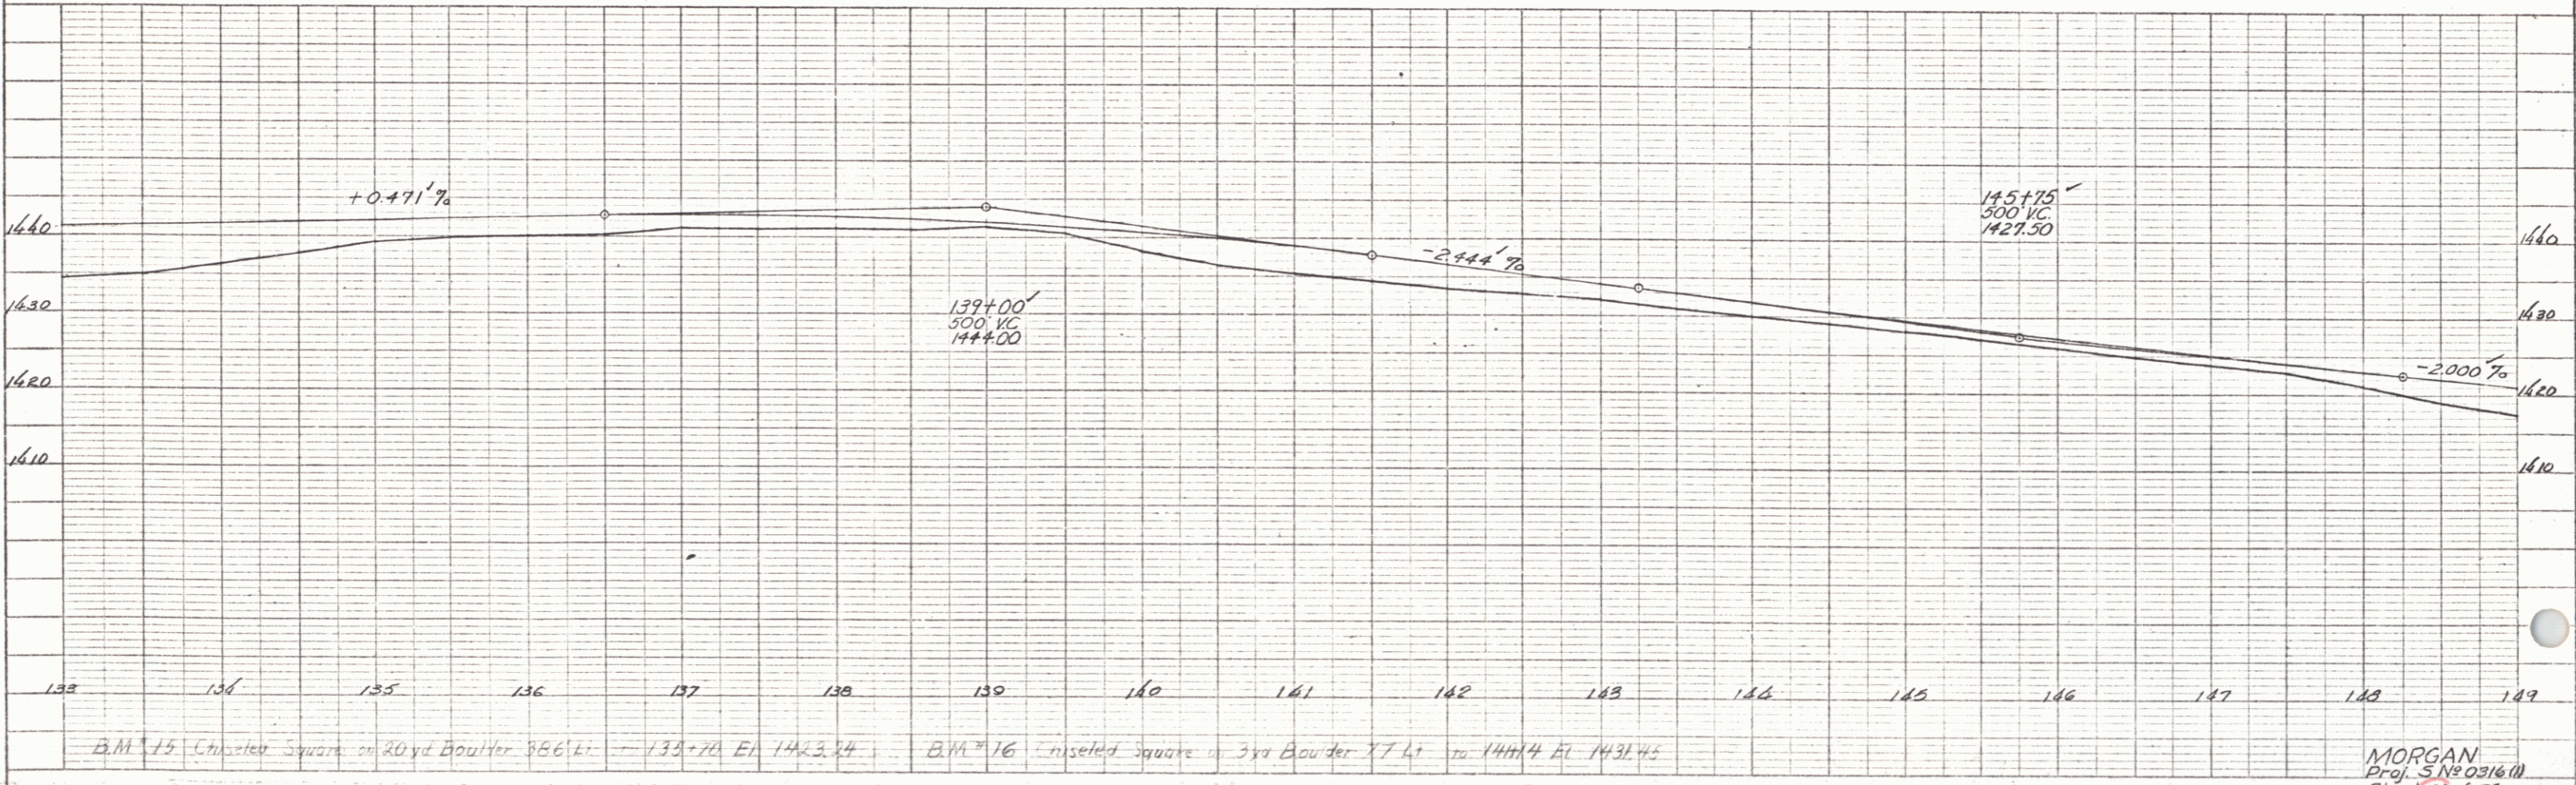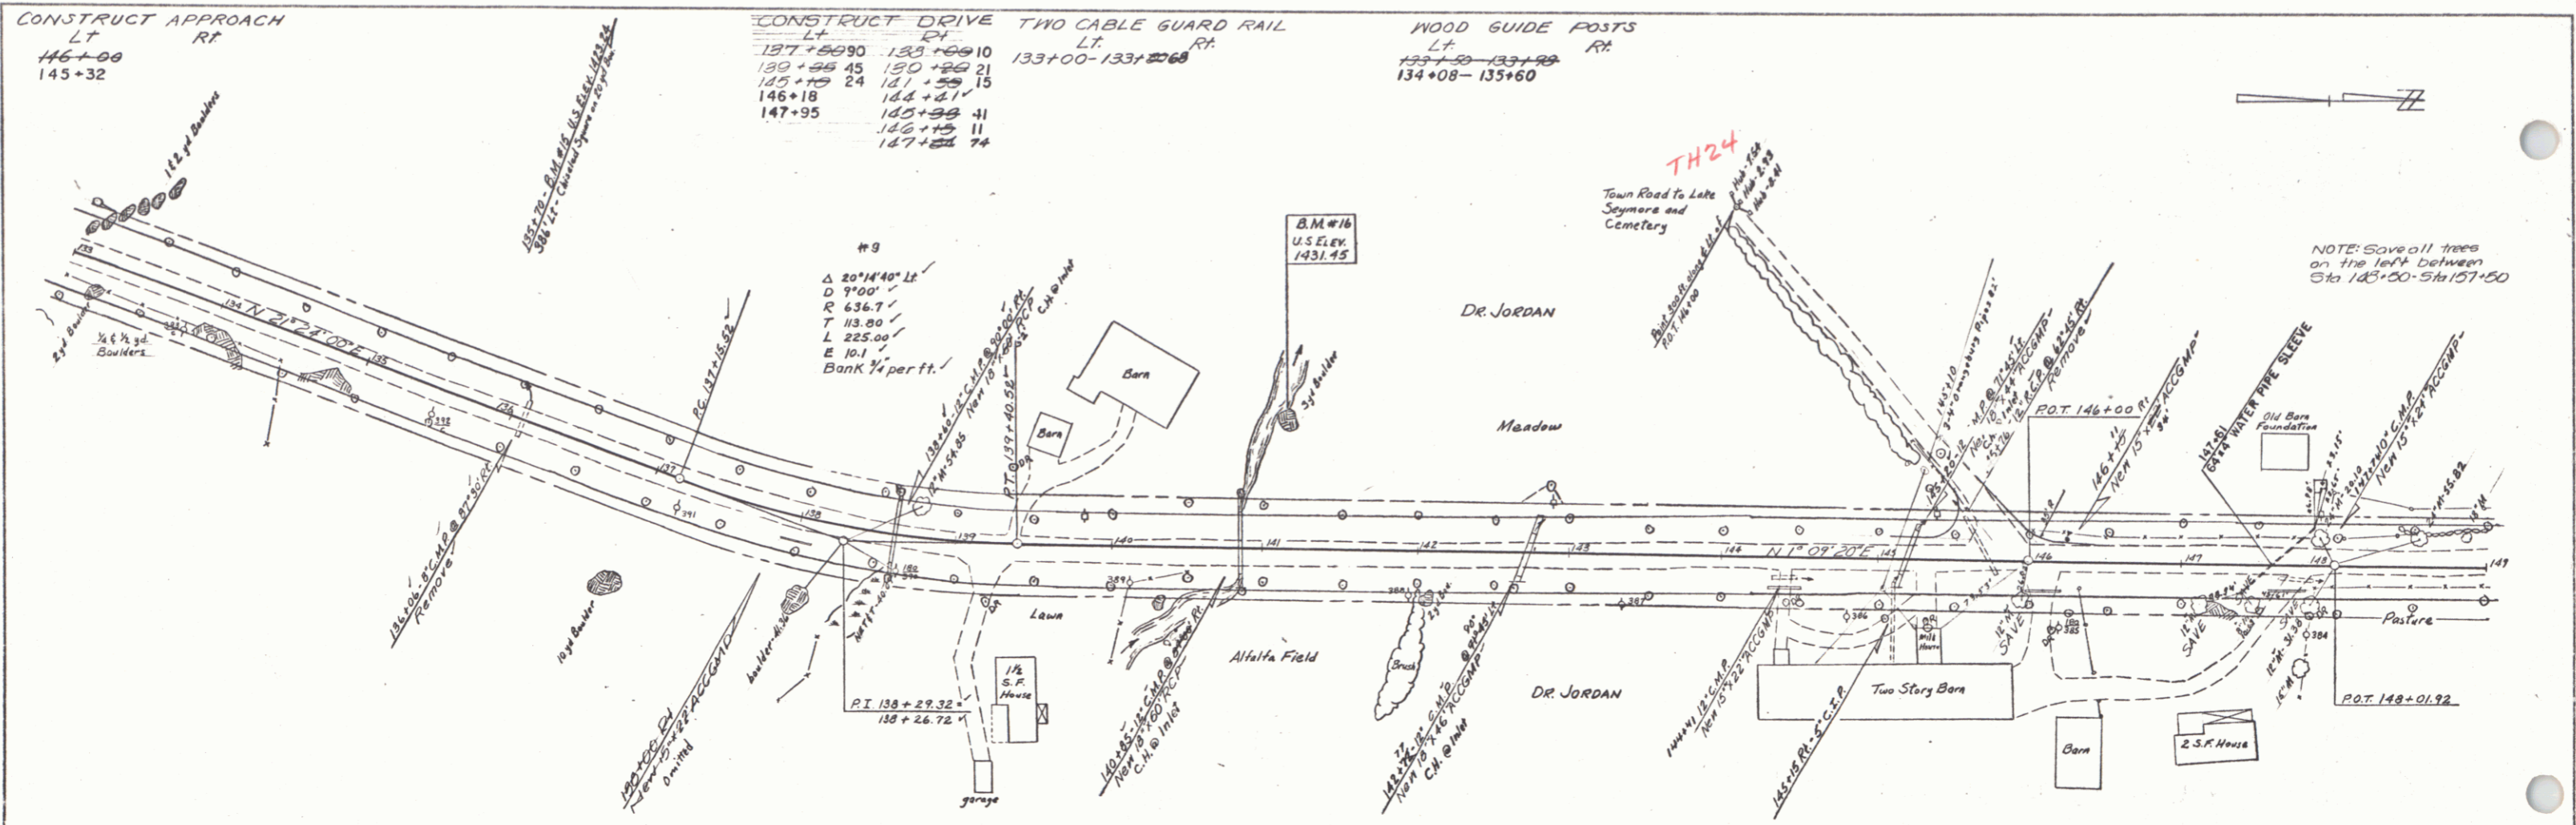

NOTE: Save all trees on the left between Sta 145+00 to Sta 157+50

MORGAN
Proj. S N 0316 (M)
Sheet 30 of 37