

CONSTRUCT DRIVE

LT	RT
165+00-165+65	176+50-176+45
164+50-165+65	166+35-166+02
176+75-176+66	170+02

WOOD GUIDE POSTS



LT	RT
163+00-164+14	
174+00-173+08	
178+00-177+04	

PLAN

DATE	
BY	
CHECKED	
APPROVED	
PROJECT NO.	
PROJECT NAME	
SCALE	
DATE	

PROFILE

DATE	
BY	
CHECKED	
APPROVED	
PROJECT NO.	
PROJECT NAME	
SCALE	
DATE	

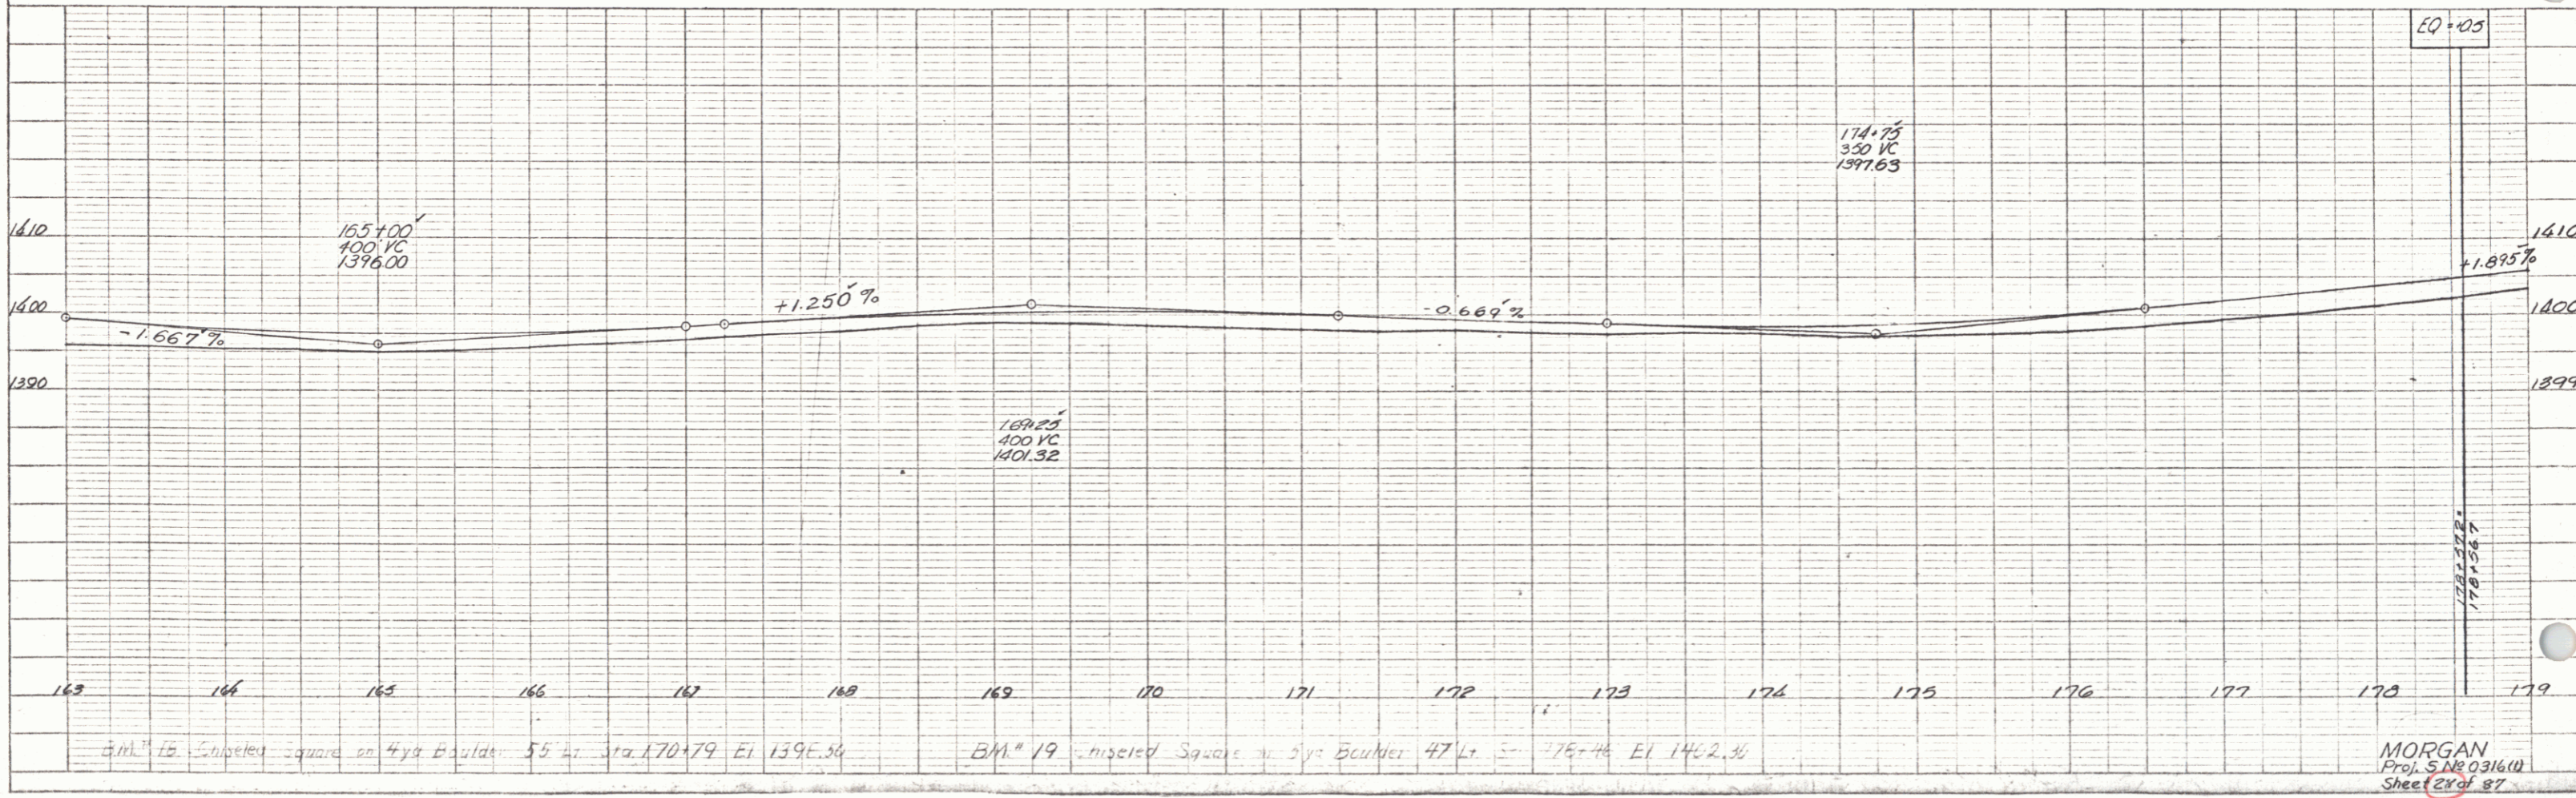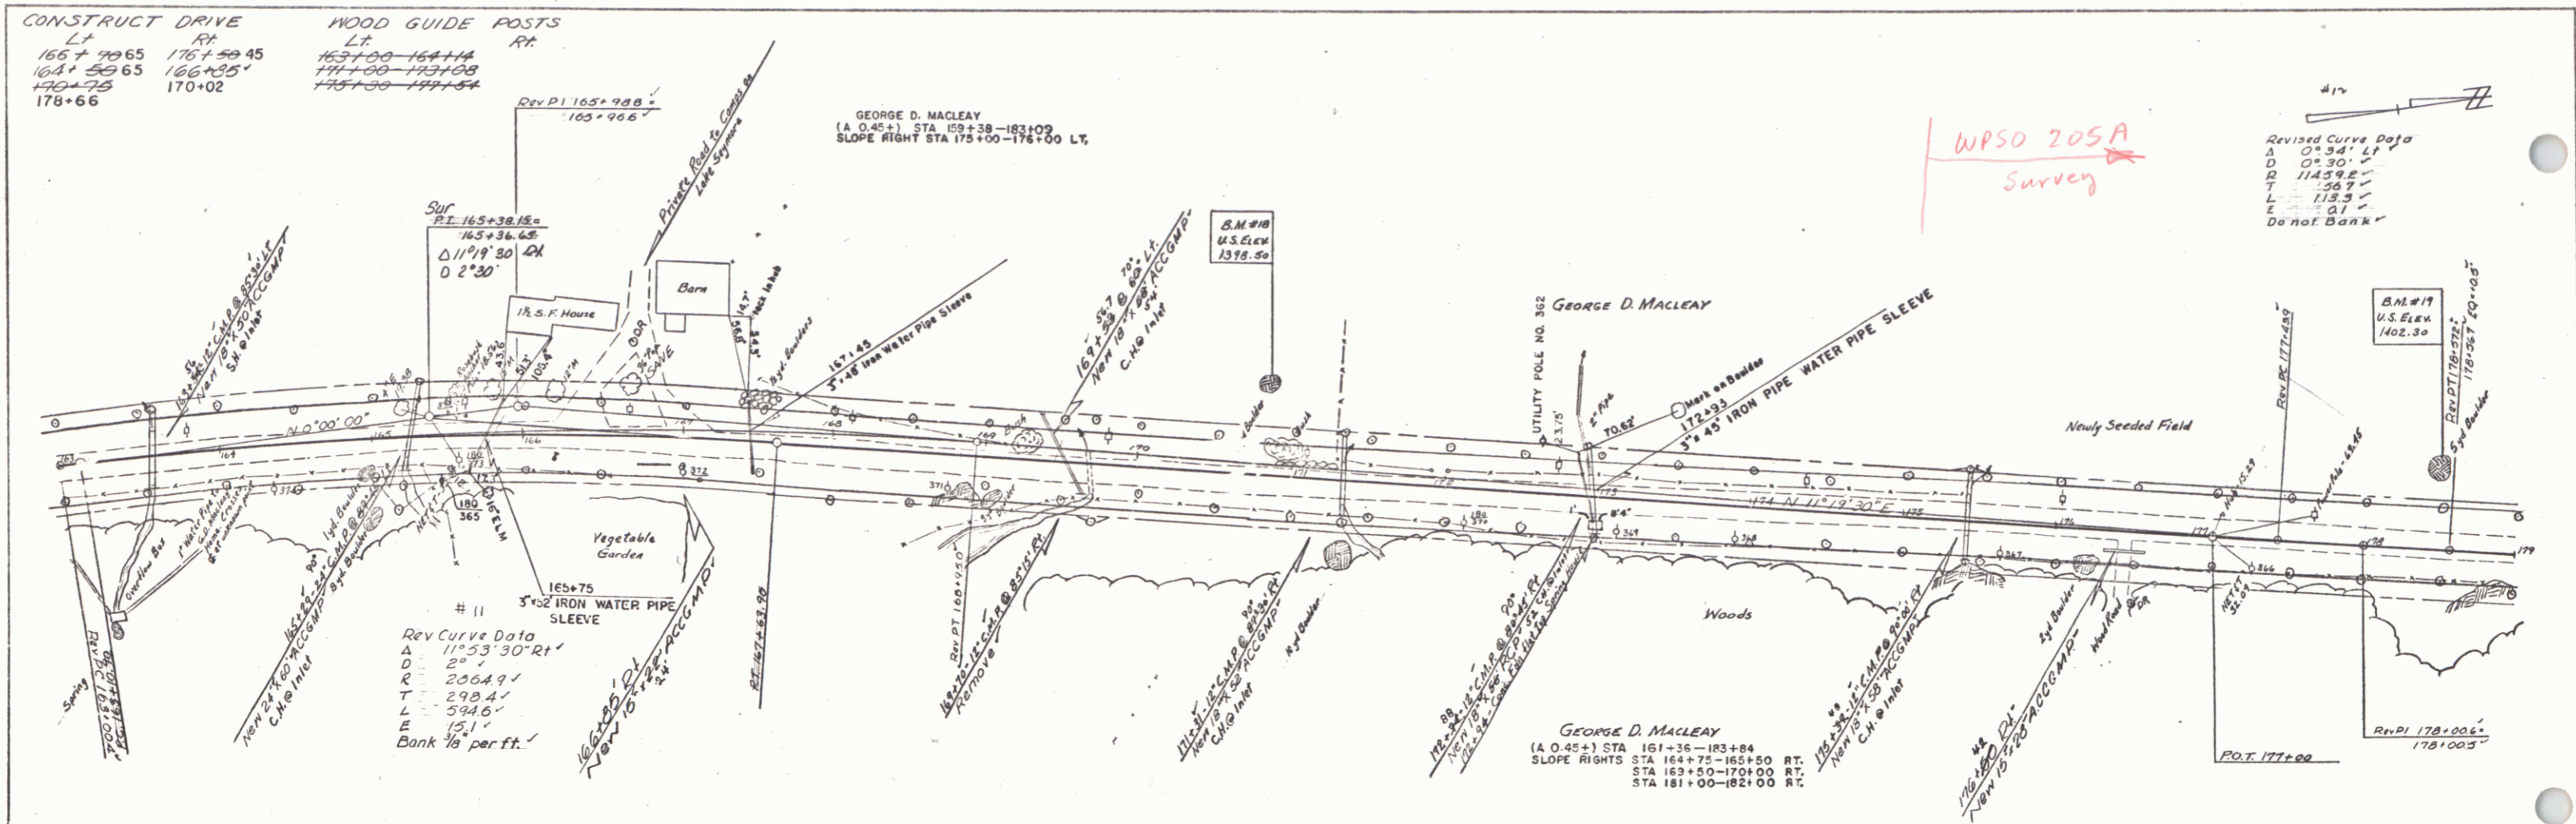

MORGAN
Proj. S.N.R. 0316(1)
Sheet 87 of 87