
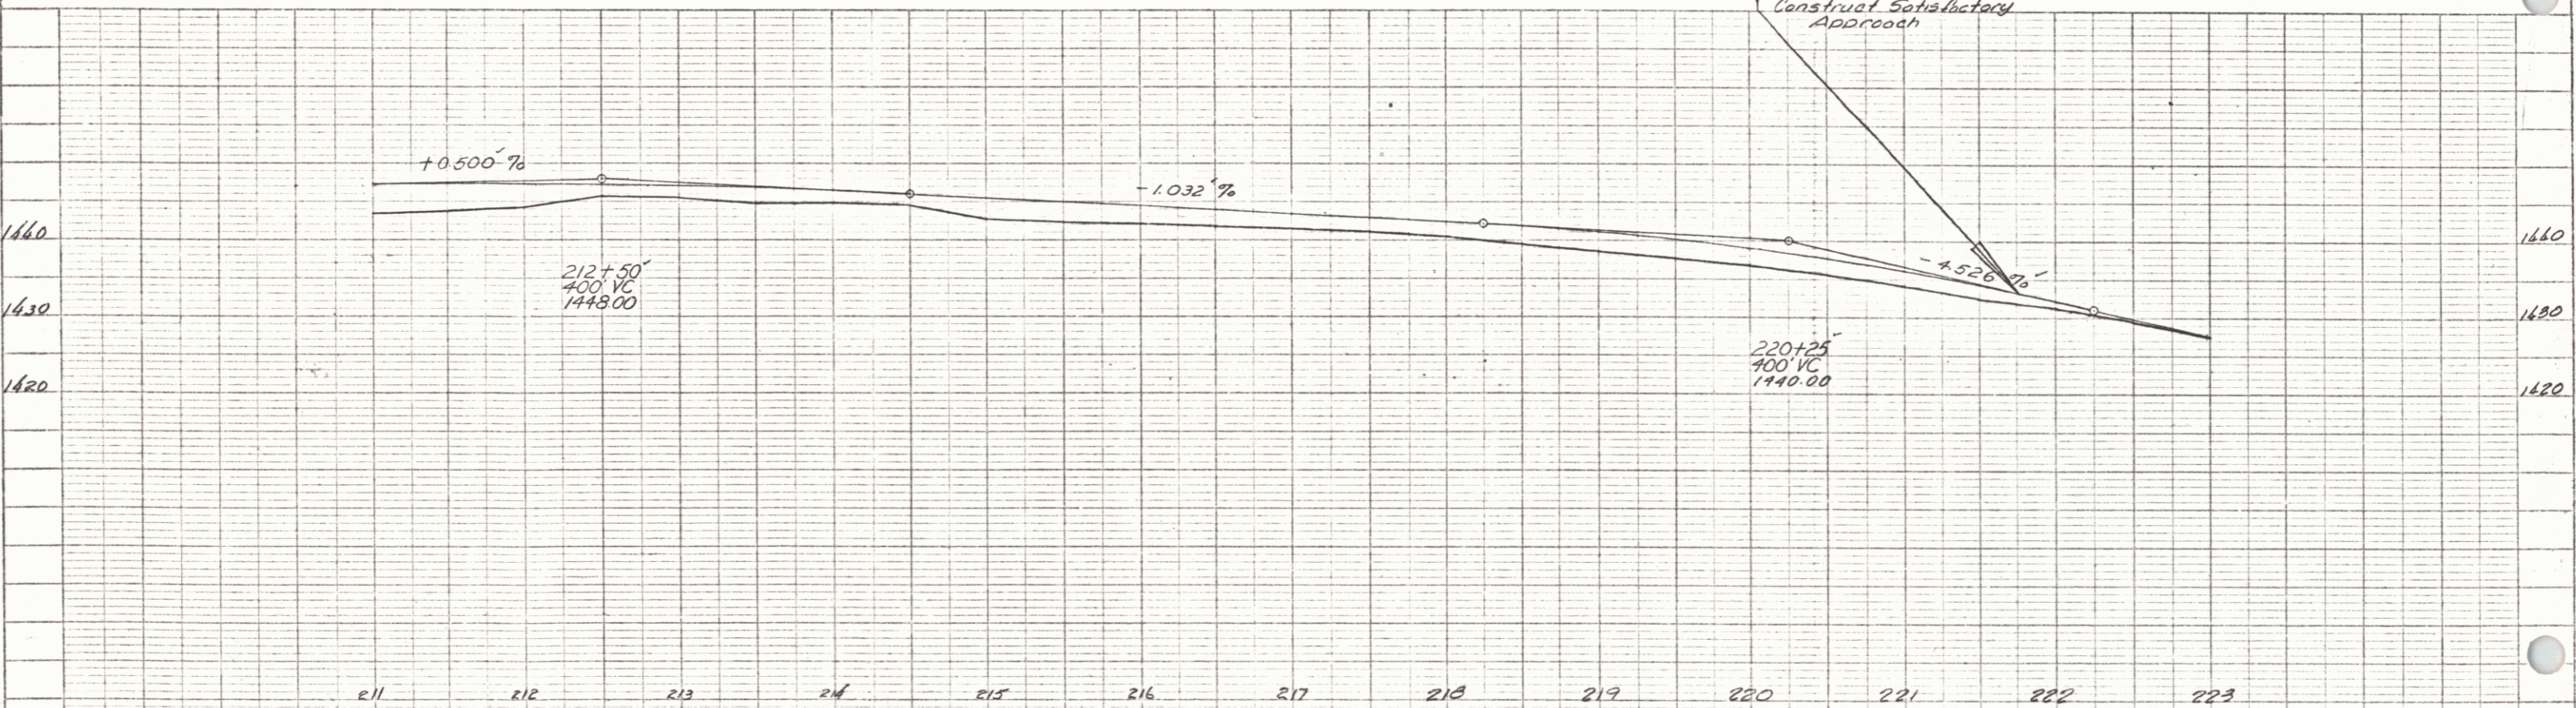


CONSTRUCT DRIVE		WOOD GUIDE POSTS		PARKING AREA	
Lt	Rt	Lt	Rt	Lt	Rt
218+03.6	218+82'	211+00-211+50	219 05'-221+10	212+90-217+24	220+50-221+78
	213+85.10	215+50-216+14			
		219+40-220+64			
		219+03-221+10			

PLAN	DATE	BY
NO.		
REVISION		
NO.		

PROFILE	DATE	BY
NO.		
REVISION		
NO.		

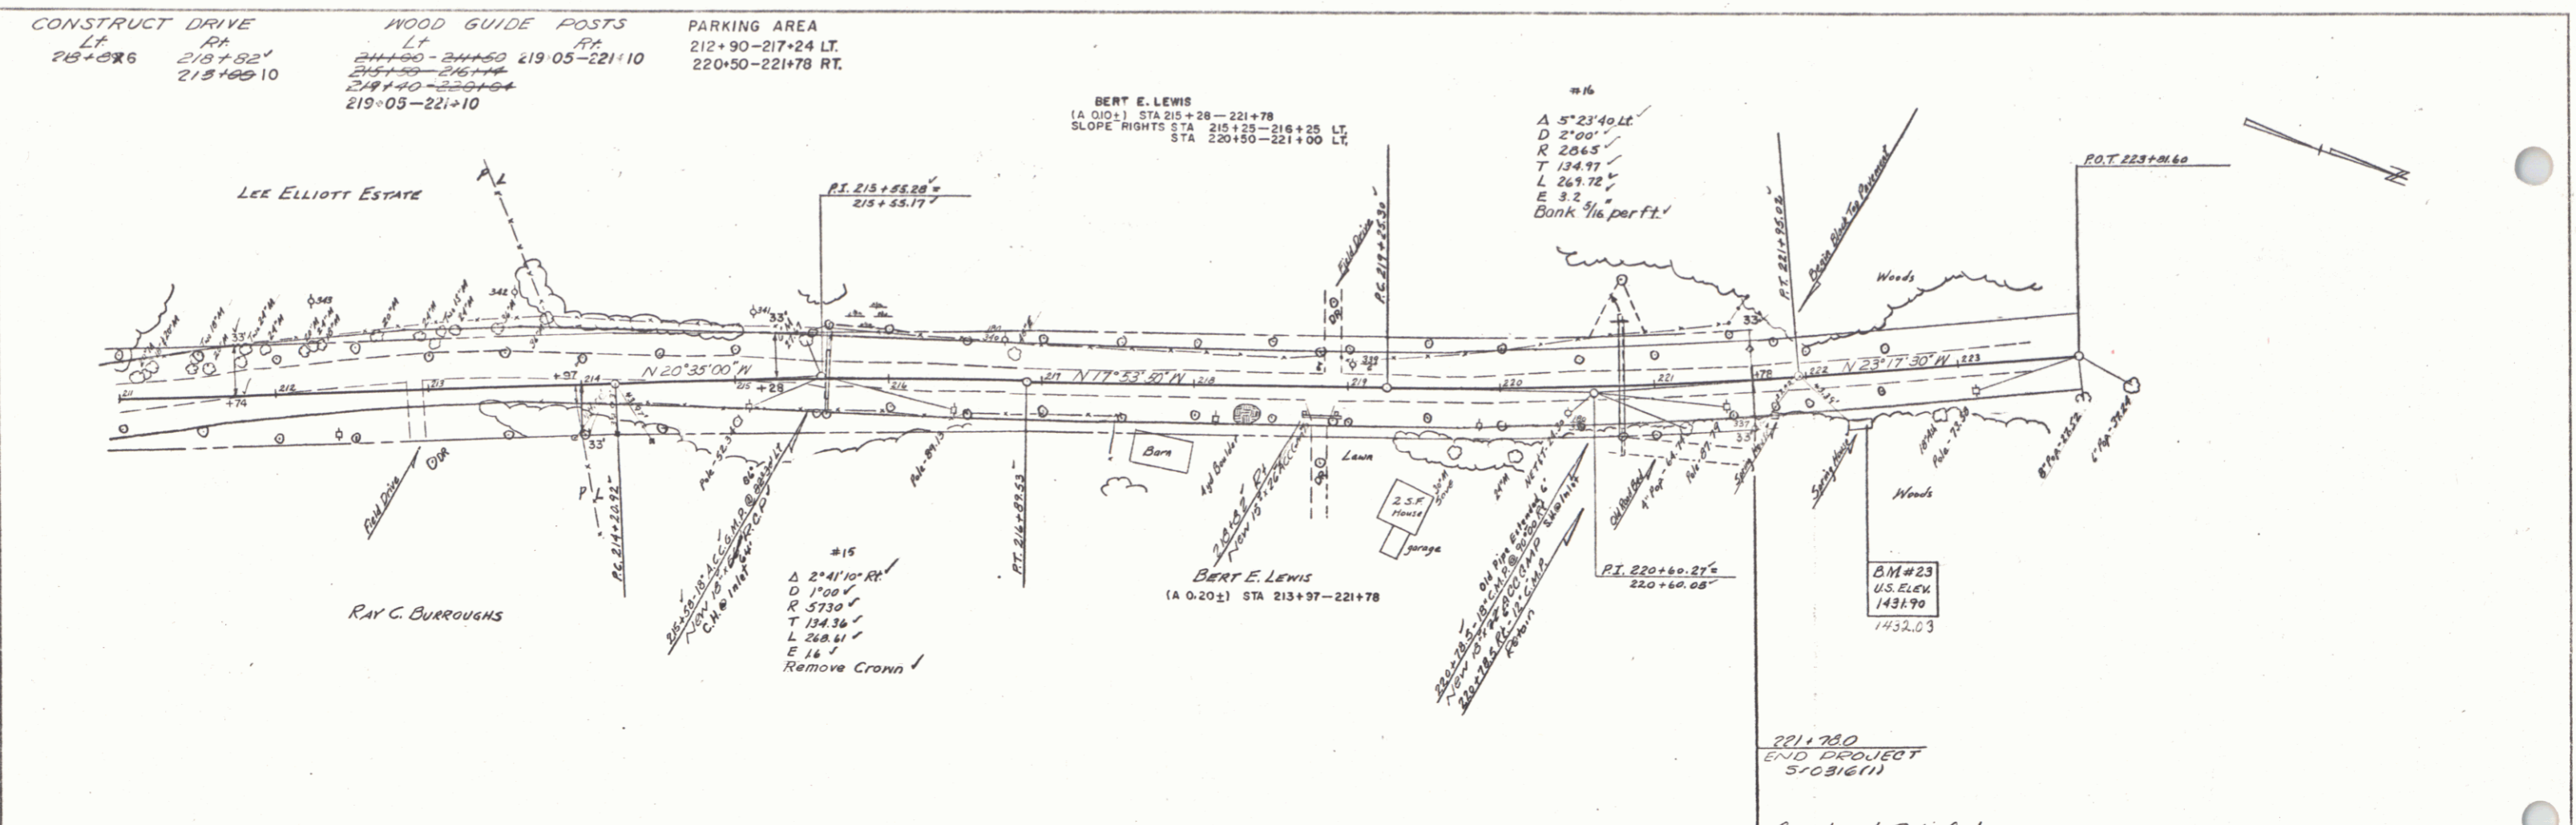

B.M. # 23 Chiswell Square on Cor. End of Spring House 29.5 Ft Sta 222+36 El. 1437

MORGAN  
Proj. S No. Q316(1)  
Sheet 31 of 68