


1937 4 24
PWA DOC. No. 232-
Contract No. 1
Bridge No. 3

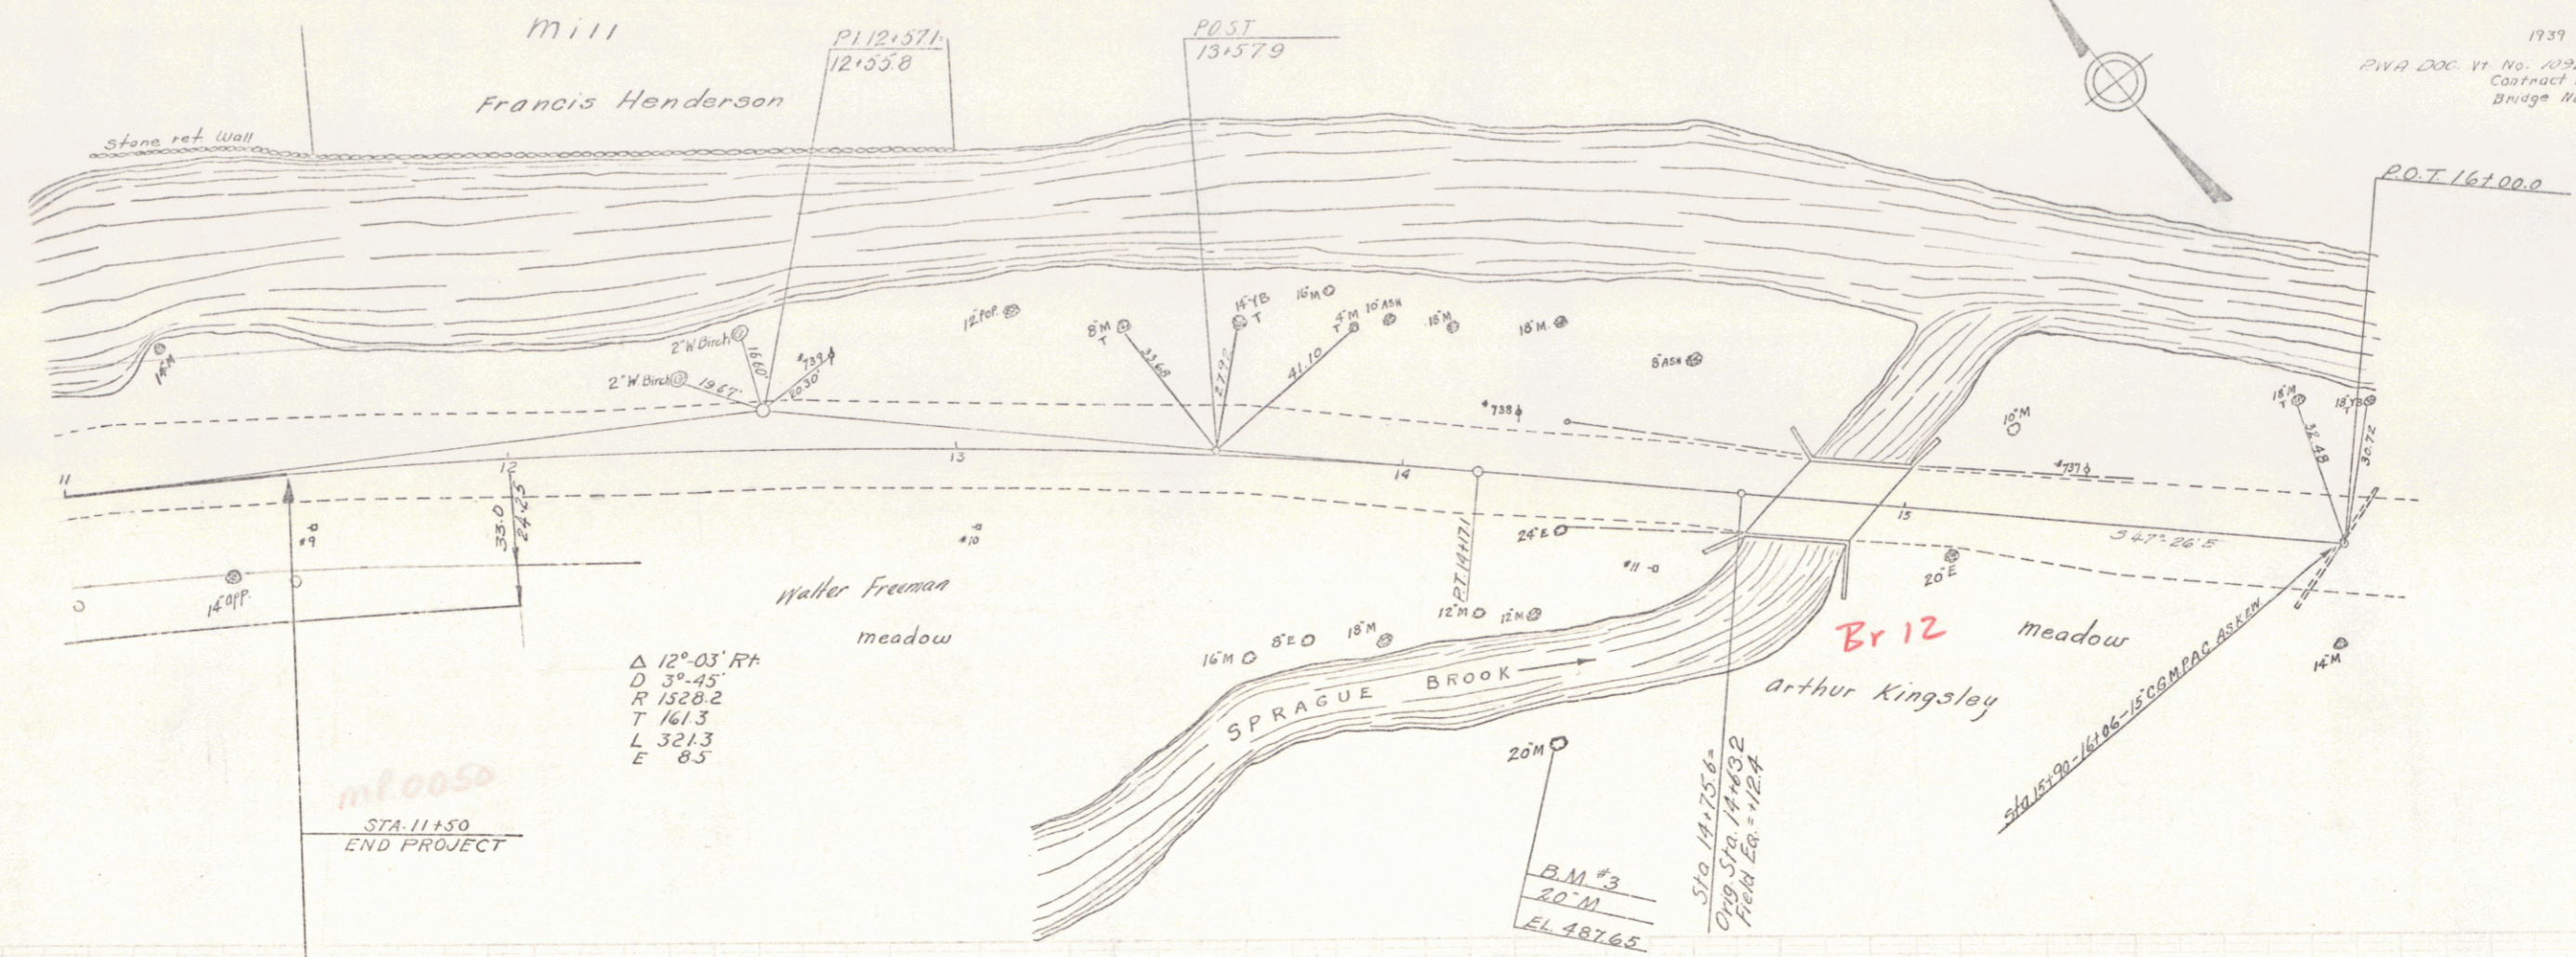


Δ 12° 03' 19.4 E
D 3° 45'
R 1528.2
T 161.3
L 321.3
E 8.5

m 0050
STA 11+50
END PROJECT

B.M. #3
20' M
EL. 487.65

FIELD EQUATION
+ 12.4 FT.

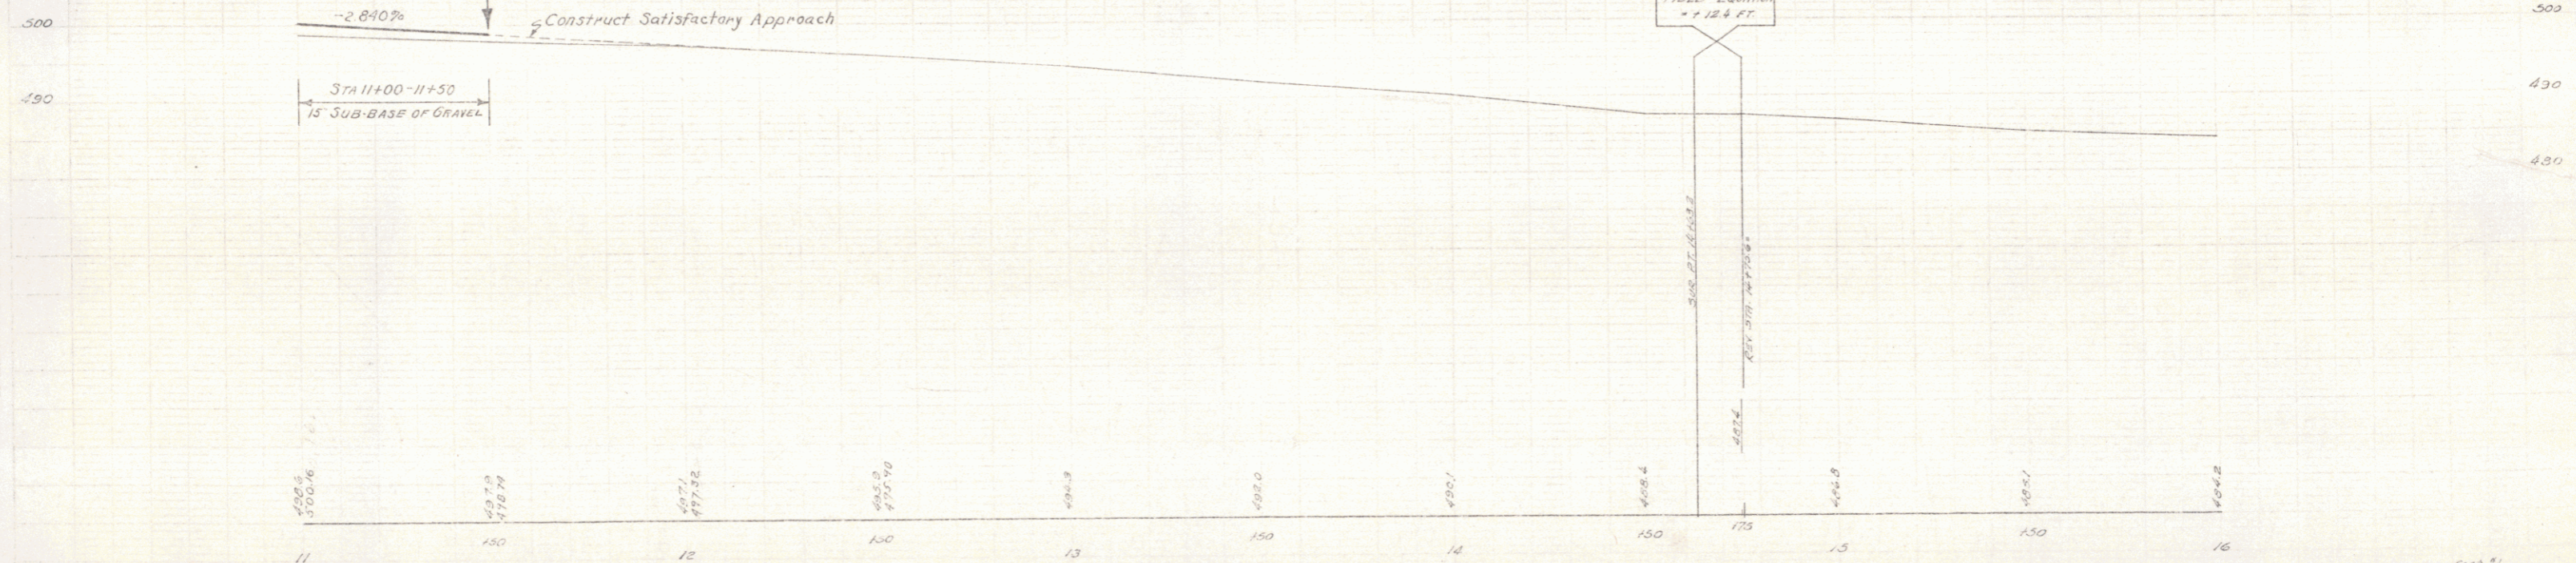

B.M. #3 51.8 20' M 58 FT STA 14+40 ELEV 487.65

CONTRACT #1
PWA CONTRACT NO. 232-
BRIDGE NO. 3
PAGE 3 OF 24