
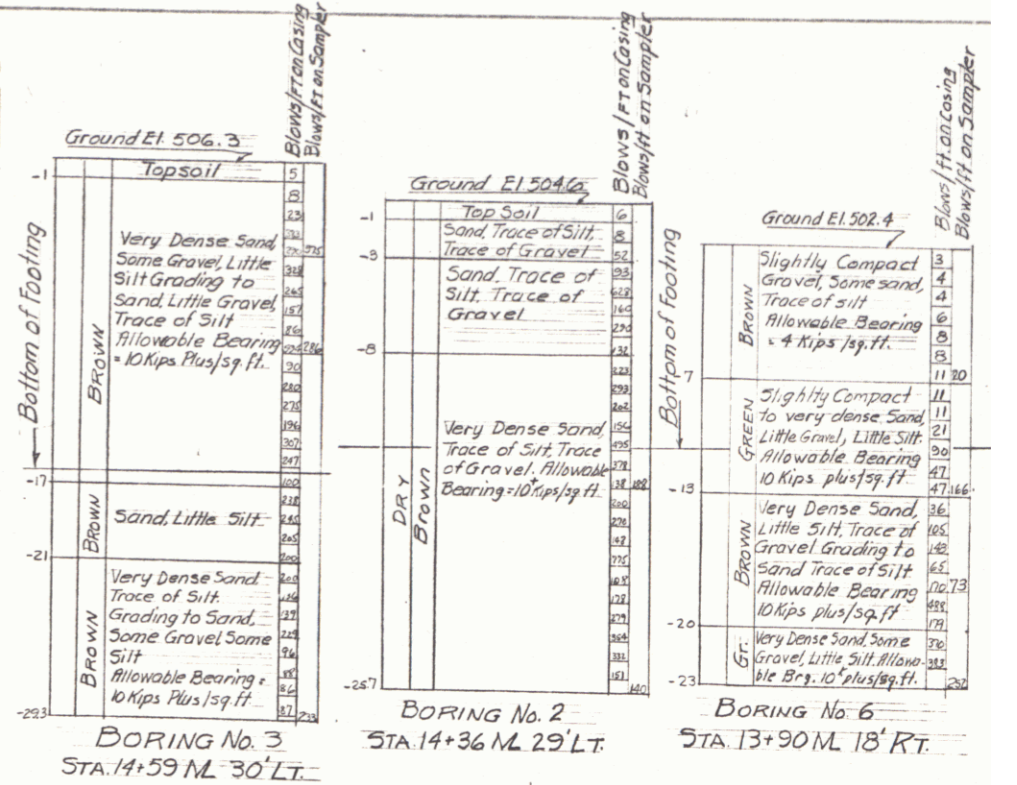


PLAN  
 DATE: 12-28-58  
 DRAWN BY: M. J. B. / S.E.B.  
 CHECKED BY: M. J. B. / S.E.B.  
 TITLE: PLAN  
 PROJECT: 15100-15128

PROFILE  
 DATE: 12-28-58  
 DRAWN BY: M. J. B. / S.E.B.  
 CHECKED BY: M. J. B. / S.E.B.  
 TITLE: PROFILE  
 PROJECT: 15100-15128

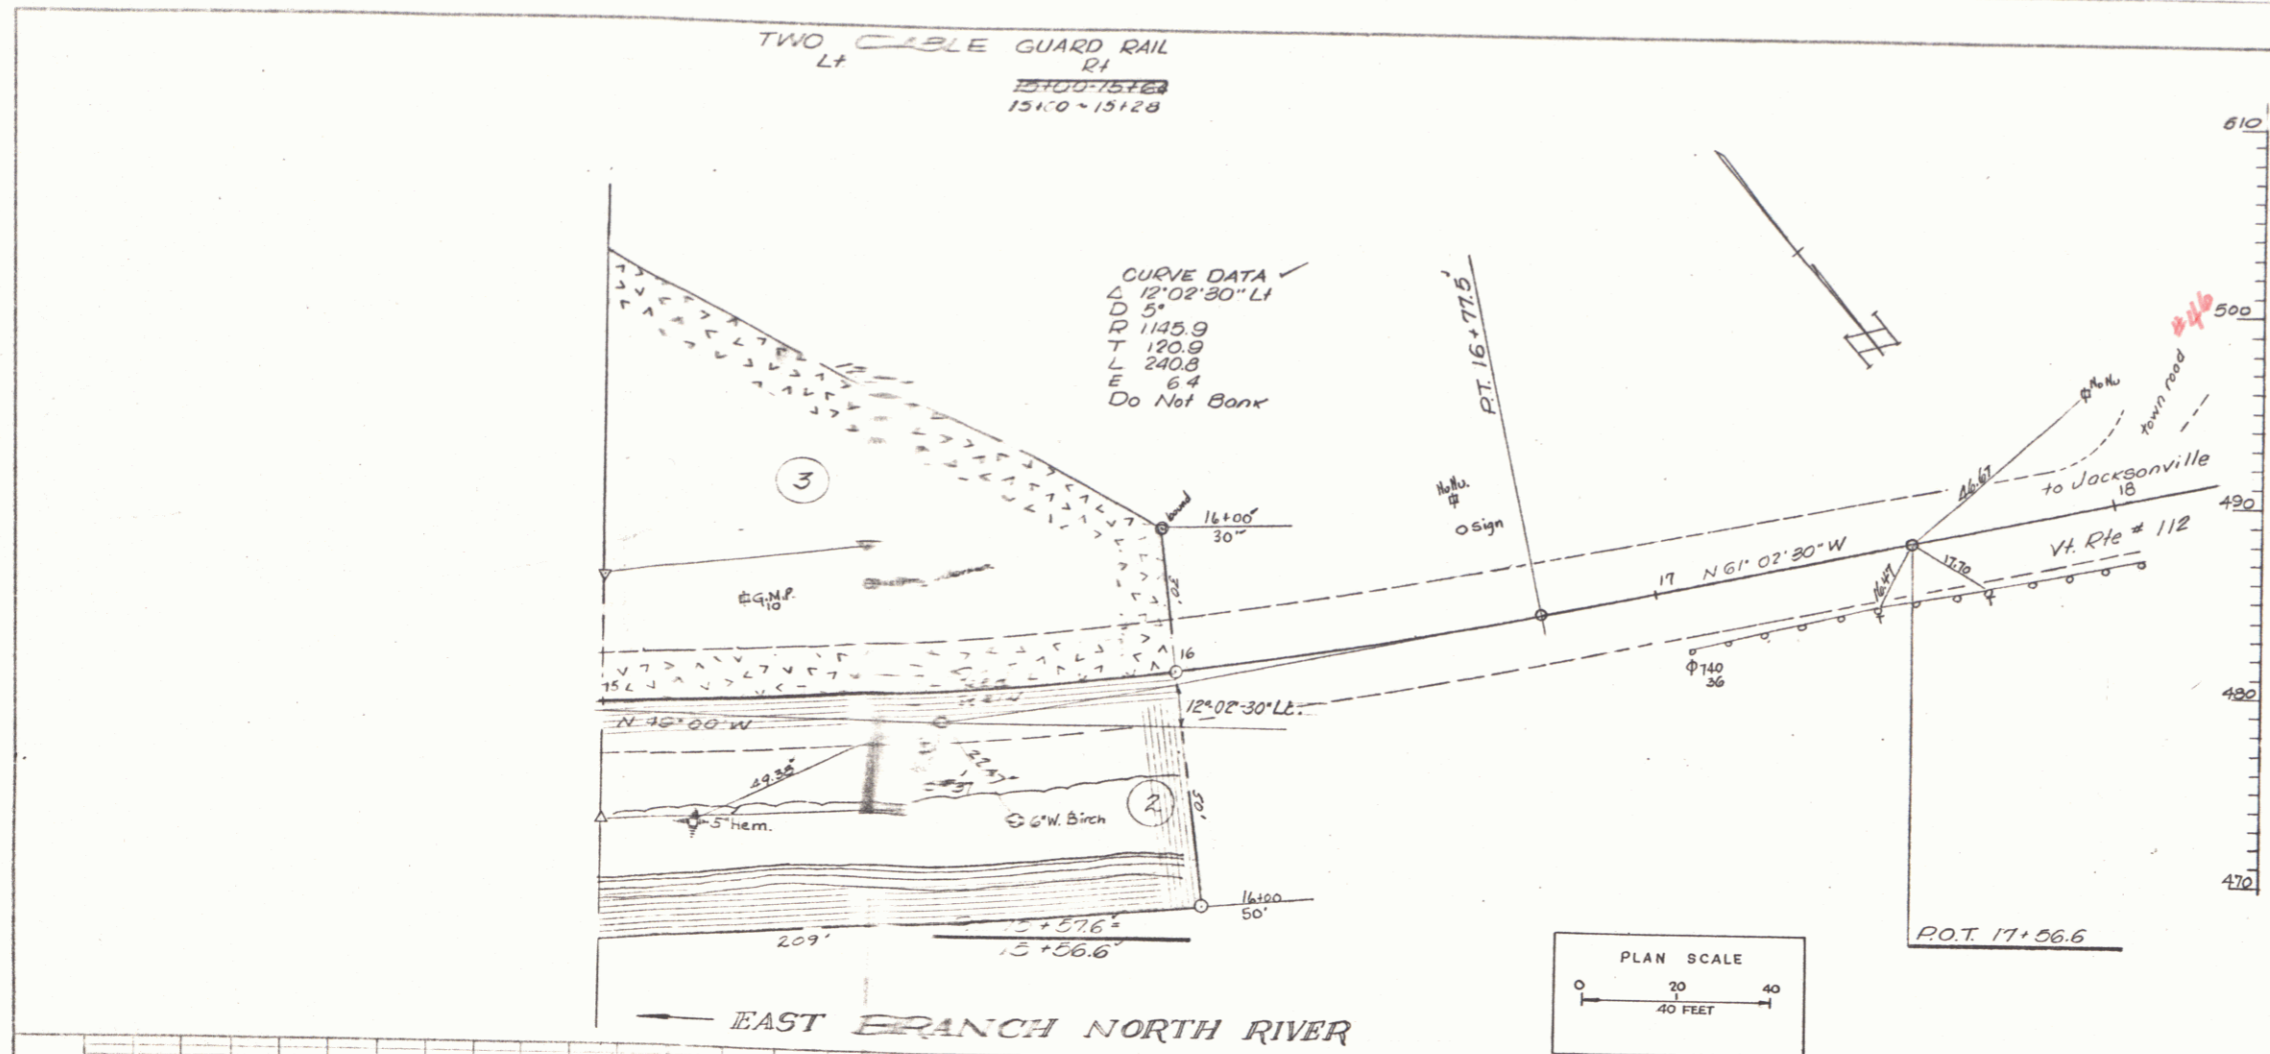

	CASING	SAMPLER
Inside Diameter	2 1/4"	1 3/8"
Outside Diameter	3"	2"
Wgt. Hammer	350#	140#
Hammer Fall	24"	30"

**BORING DETAILS**  
 SCALE: 1" = 10'



PLATE 1 - PLAN - PROFILE OF BRIDGE APPROACH  
 PROJECT: 15100-15128  
 DATE: 12-28-58

WHITINGHAM  
 Proj. S-N-0107(11)  
 Sheet 4 of 15 Sheets