


PLAN
 DATE 12-31-12
 DRAWN BY [unclear]
 CHECKED BY [unclear]
 PROJECT [unclear]

[unclear]
 [unclear]
 [unclear]

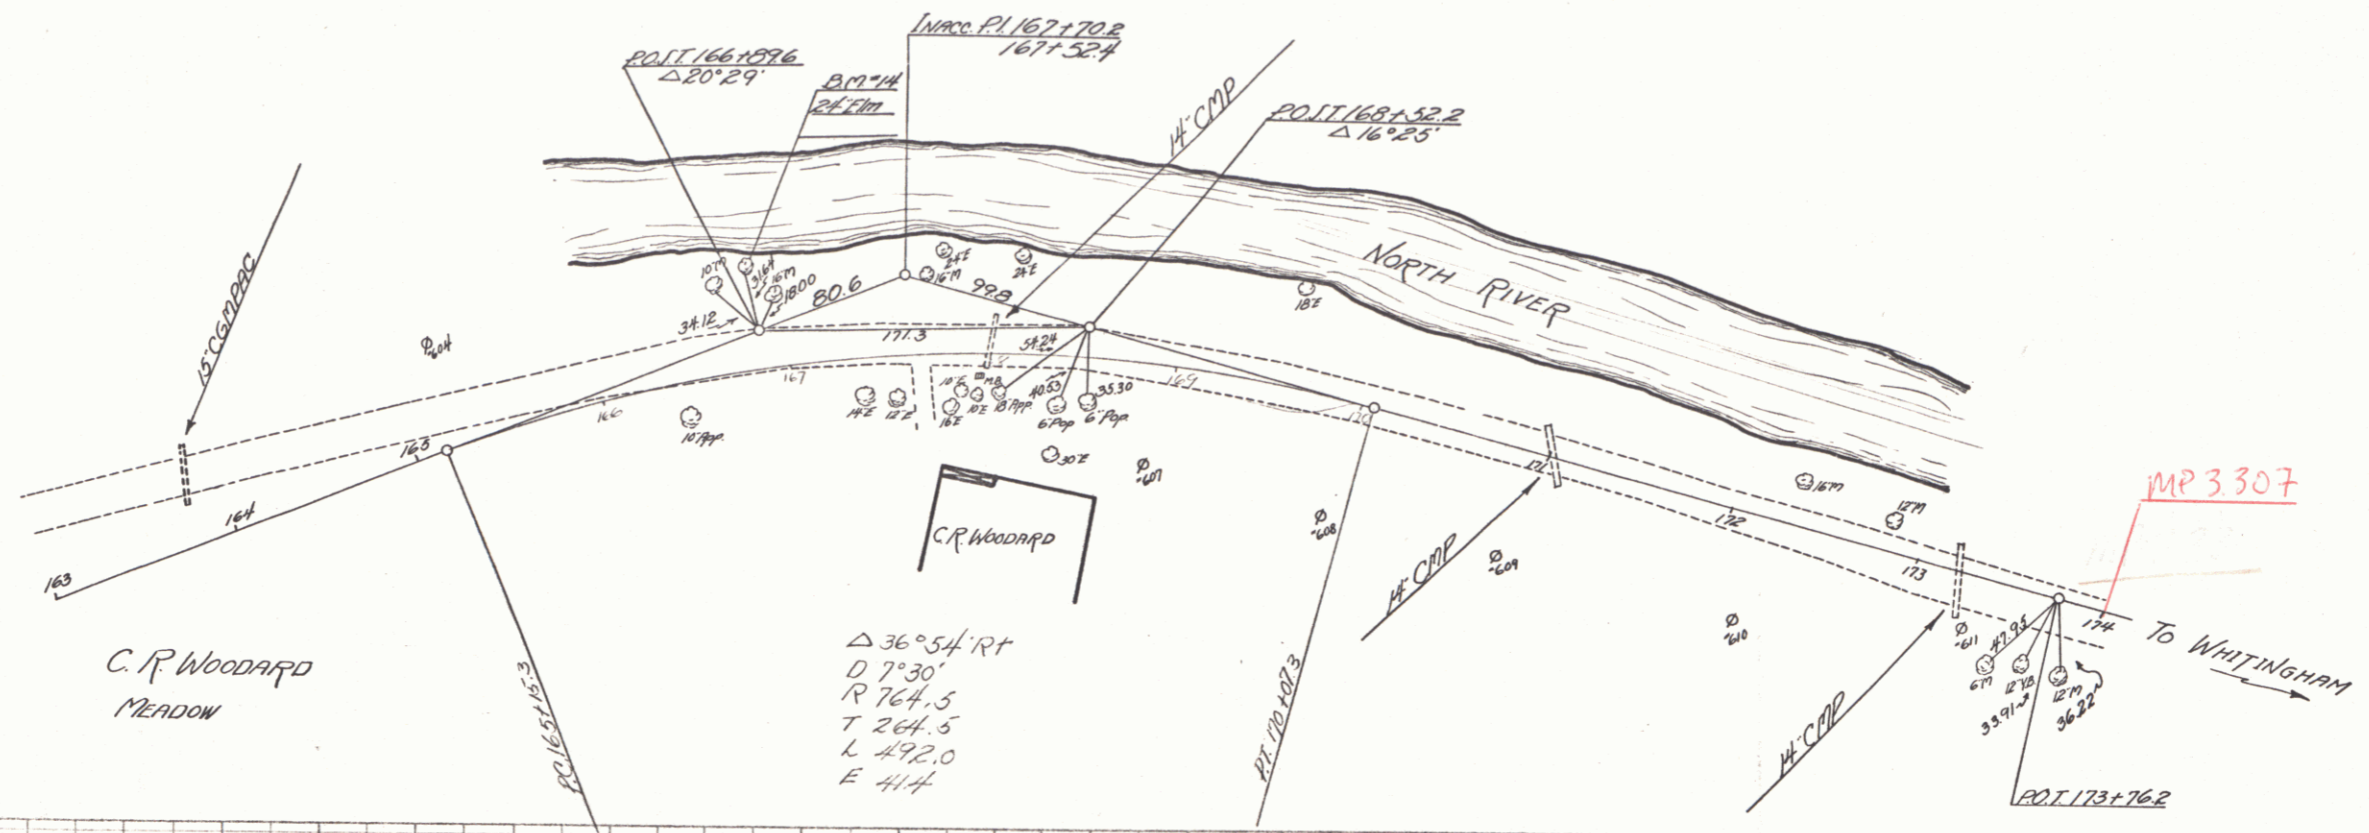

MILLER ET AL
 SHEET 5

5