
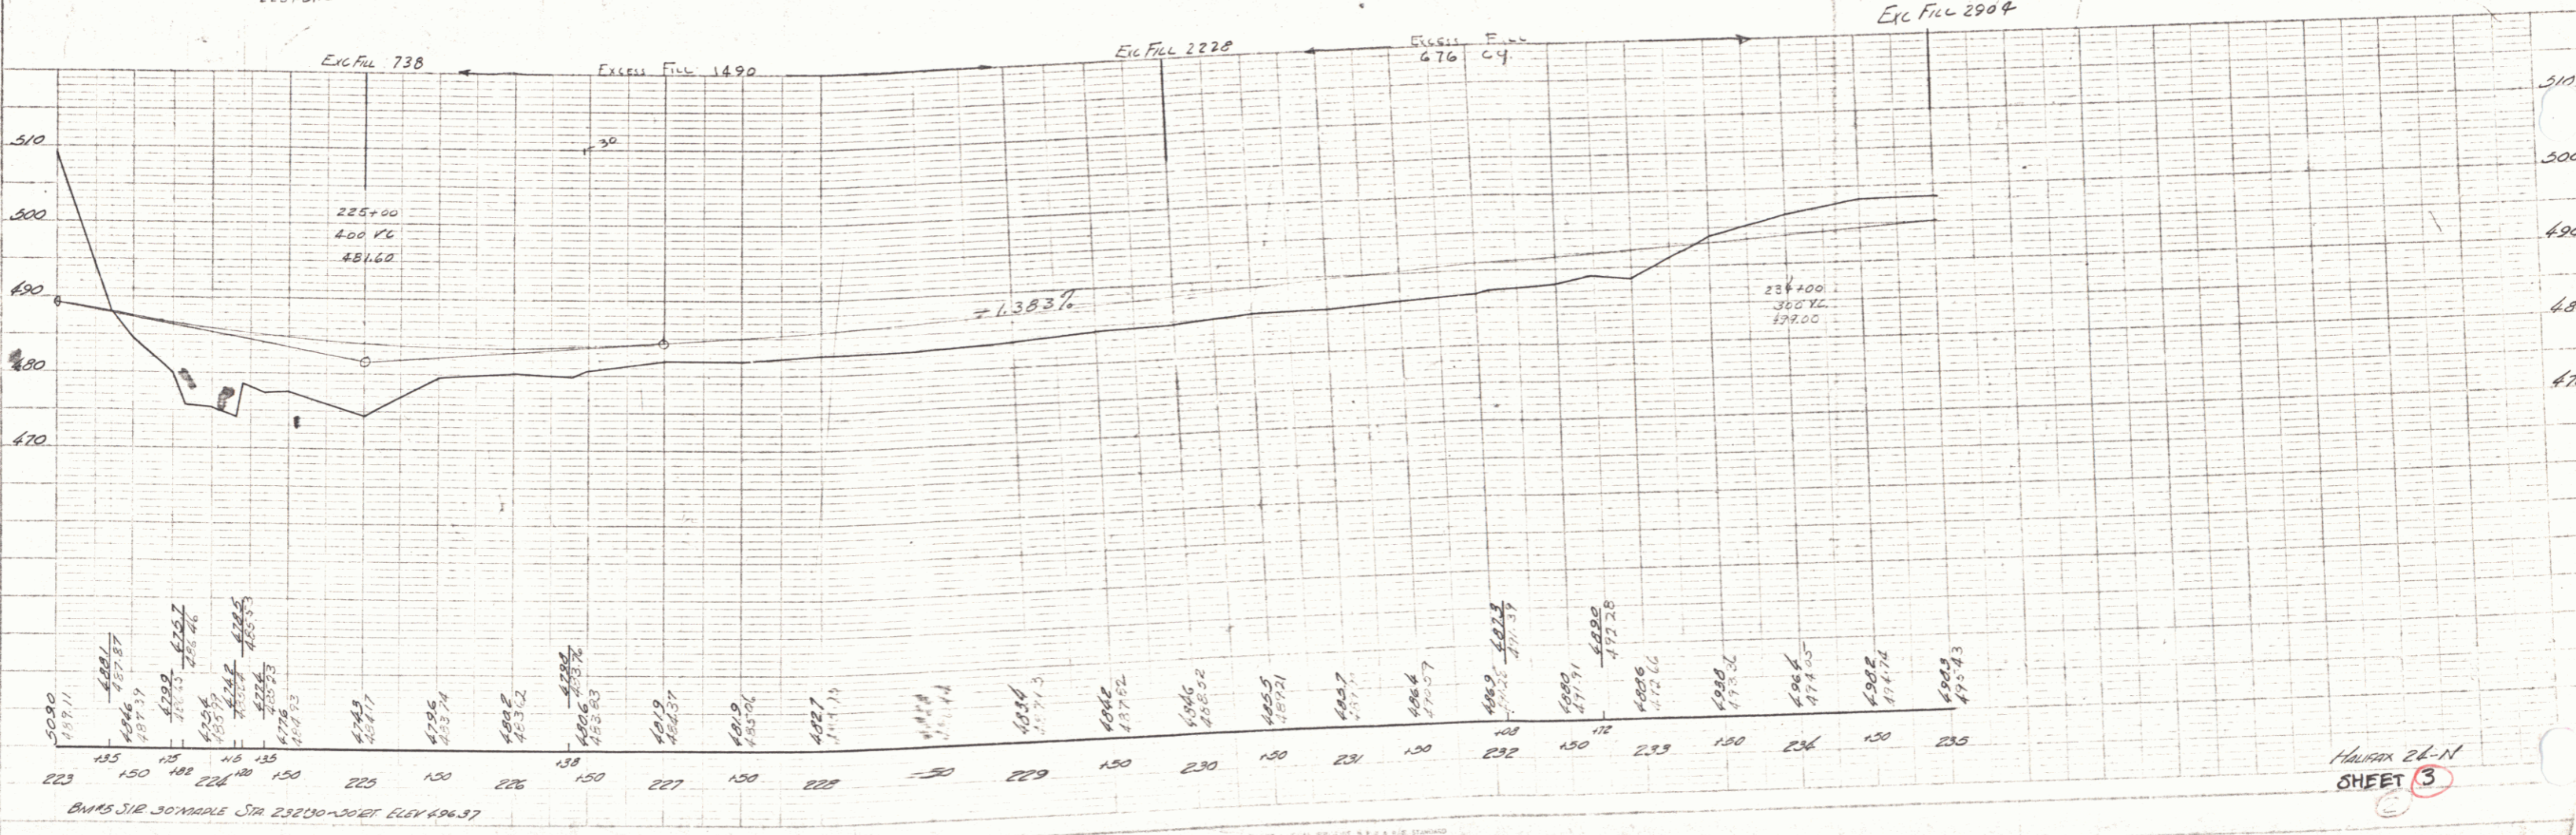


DATE	NO.	BY
1953	239	...
1953	239	...

DATE	NO.	BY
1953	239	...
1953	239	...

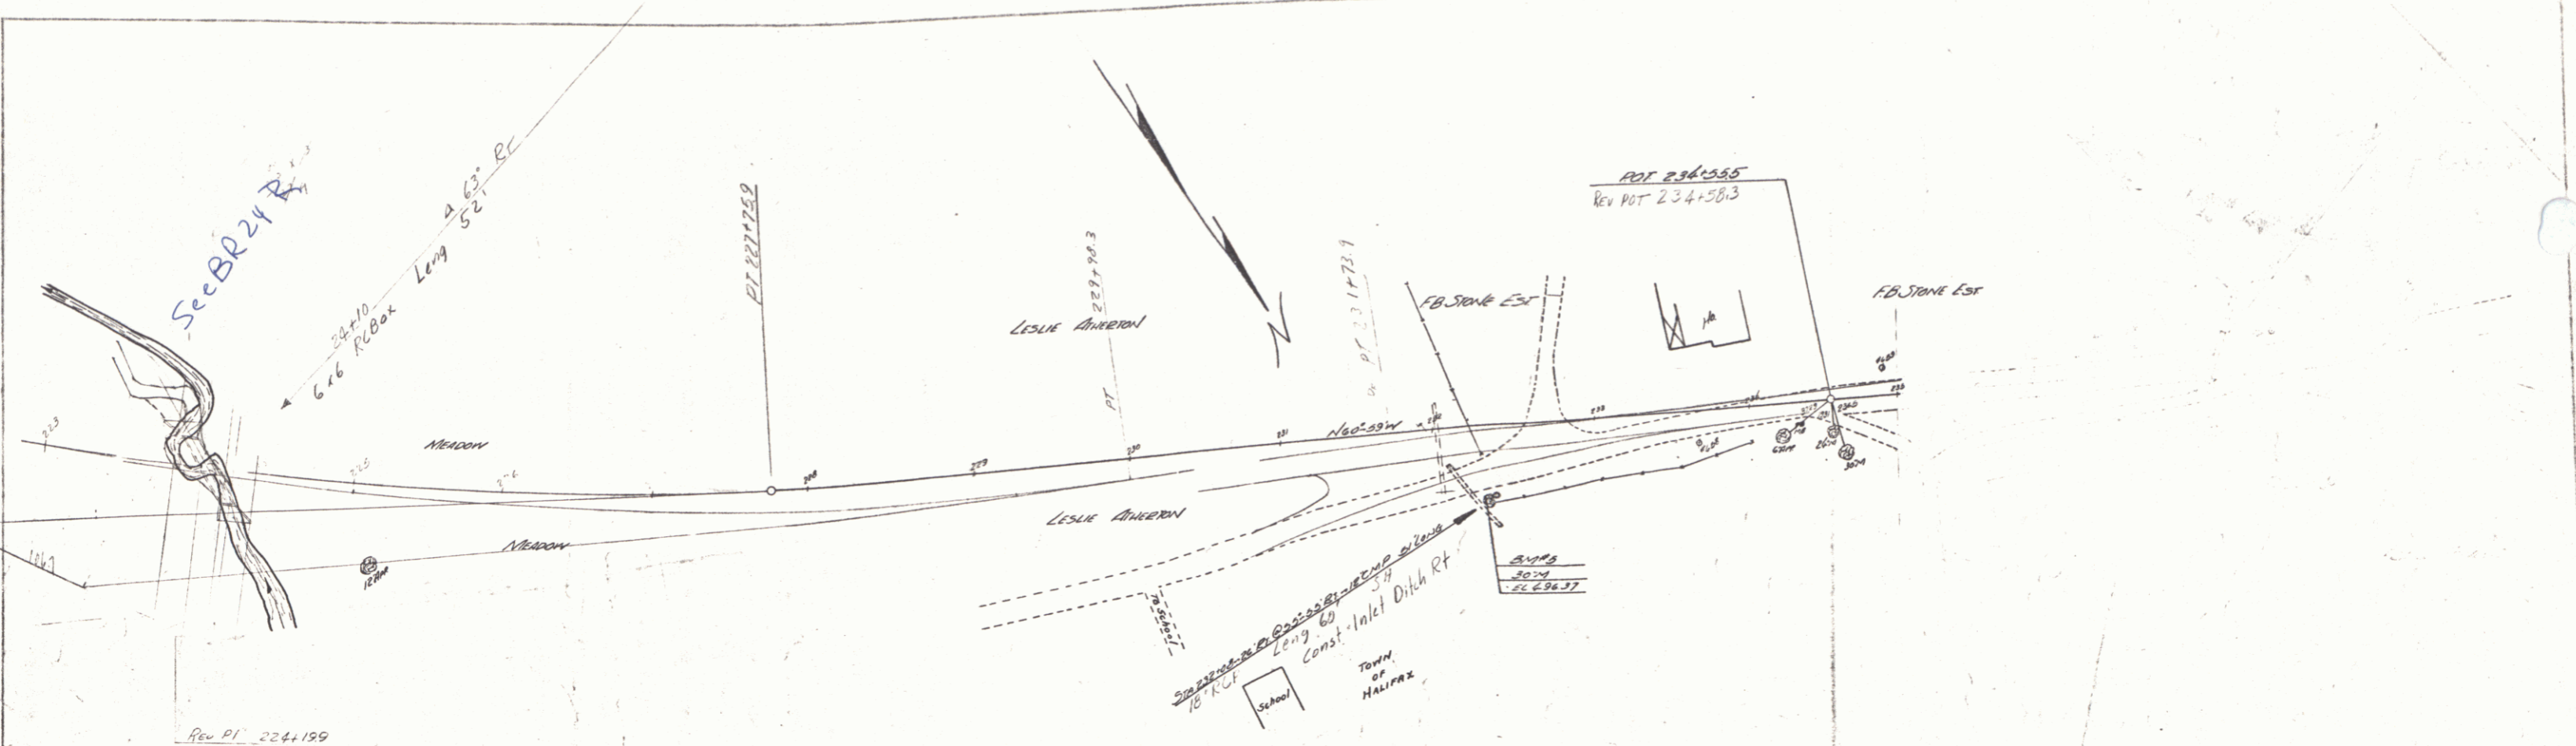

CHMS JIB 30MMALS STA 23200-200FT ELEV 496.37

HALIFAX 24-N
SHEET 3