



PLAN	DATE	BY	CHKD

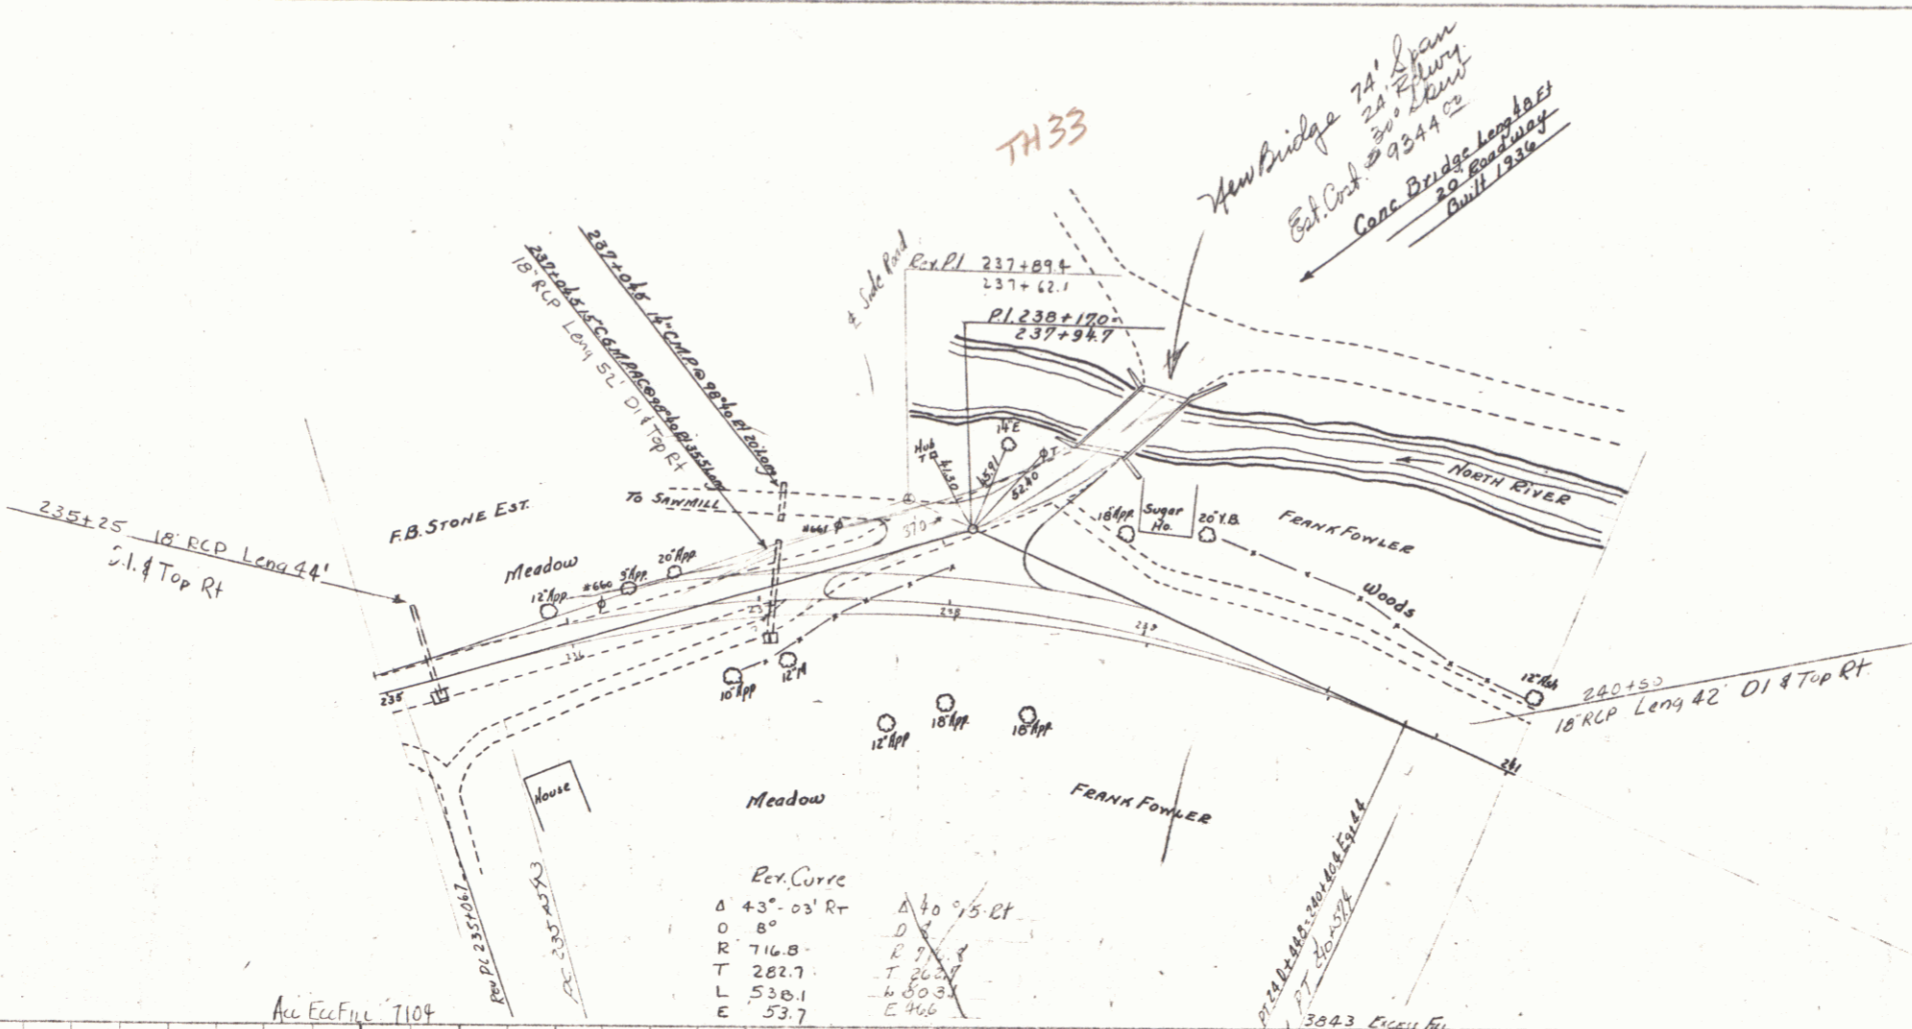

Ex. Curve

Δ	43° 03' Rt	Δ	40° 15' Lt
D	8°	D	7° 15'
R	716.8	R	794.4
T	282.7	T	263.4
L	530.1	L	480.3
E	53.7	E	466

PLAN	DATE	BY	CHKD

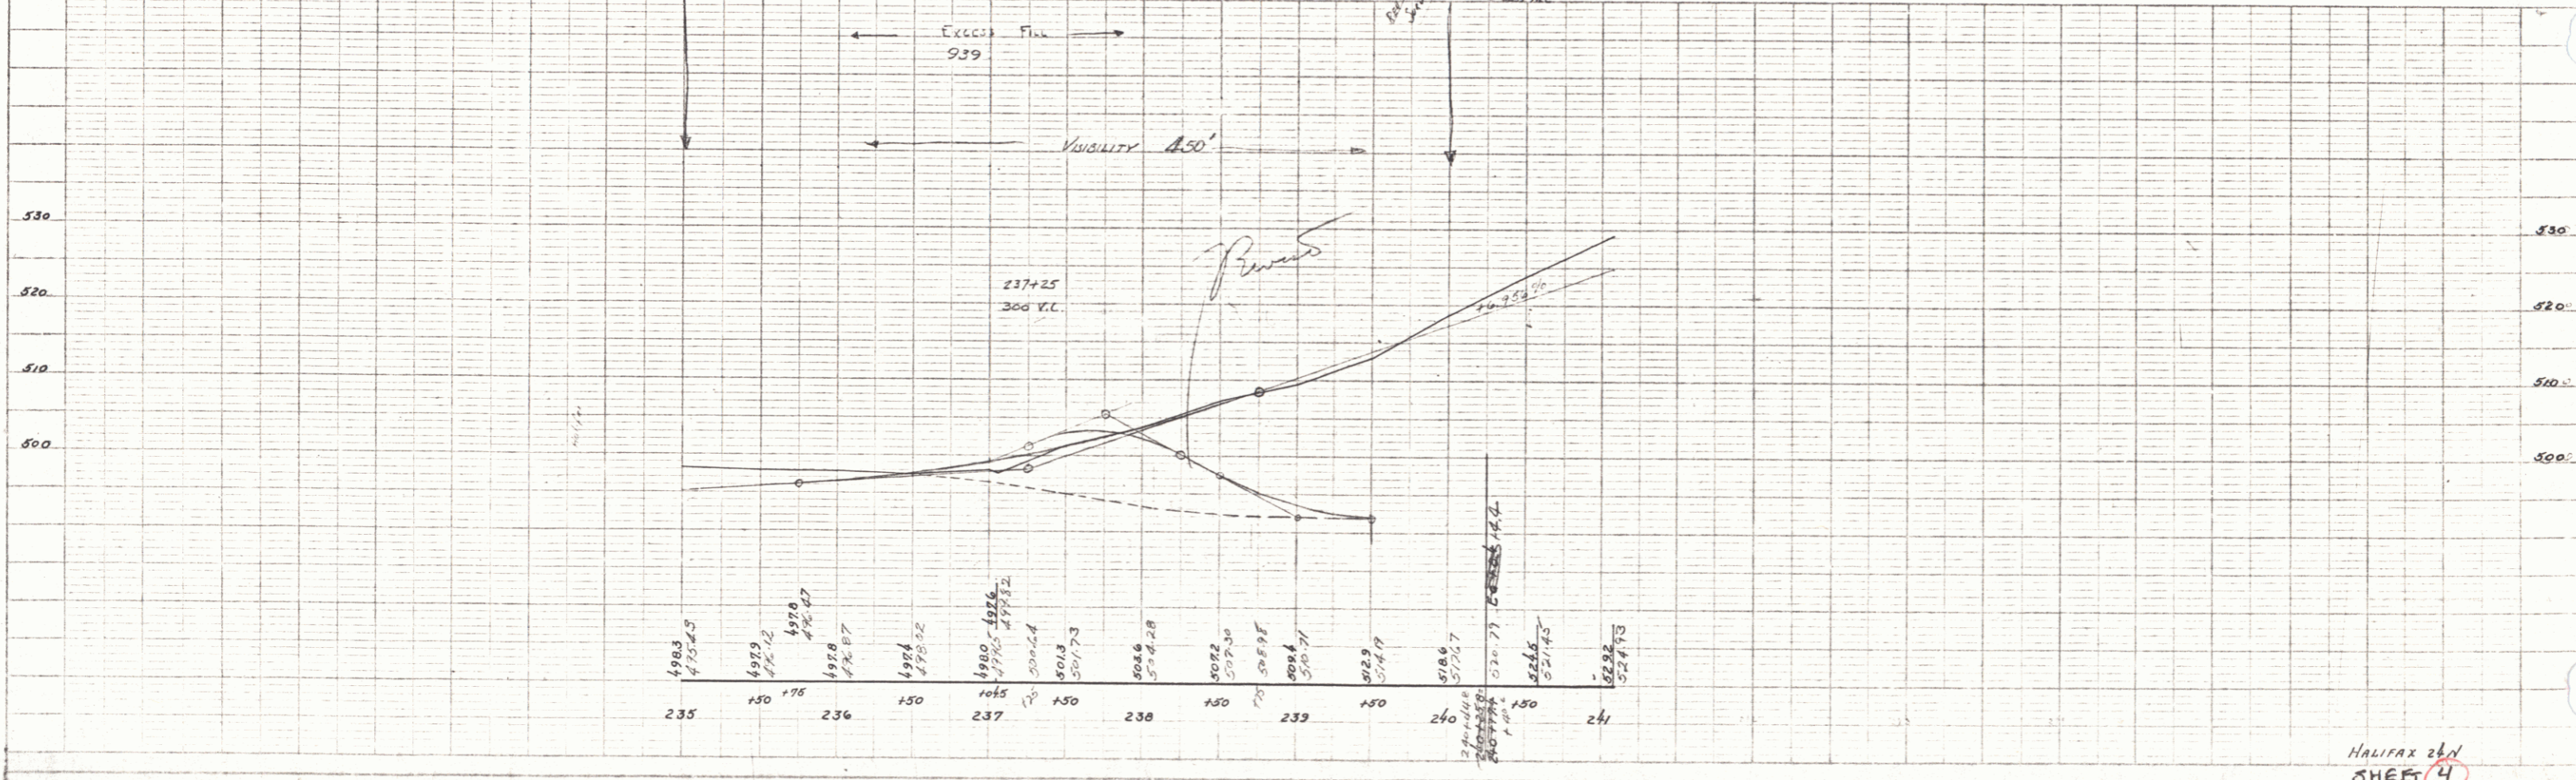

HALIFAX 2611
SHEET 4