

PLAN  
 DATE: 1954  
 DRAWN BY: [Name]  
 CHECKED BY: [Name]

PROFILE  
 DATE: 1954  
 DRAWN BY: [Name]  
 CHECKED BY: [Name]

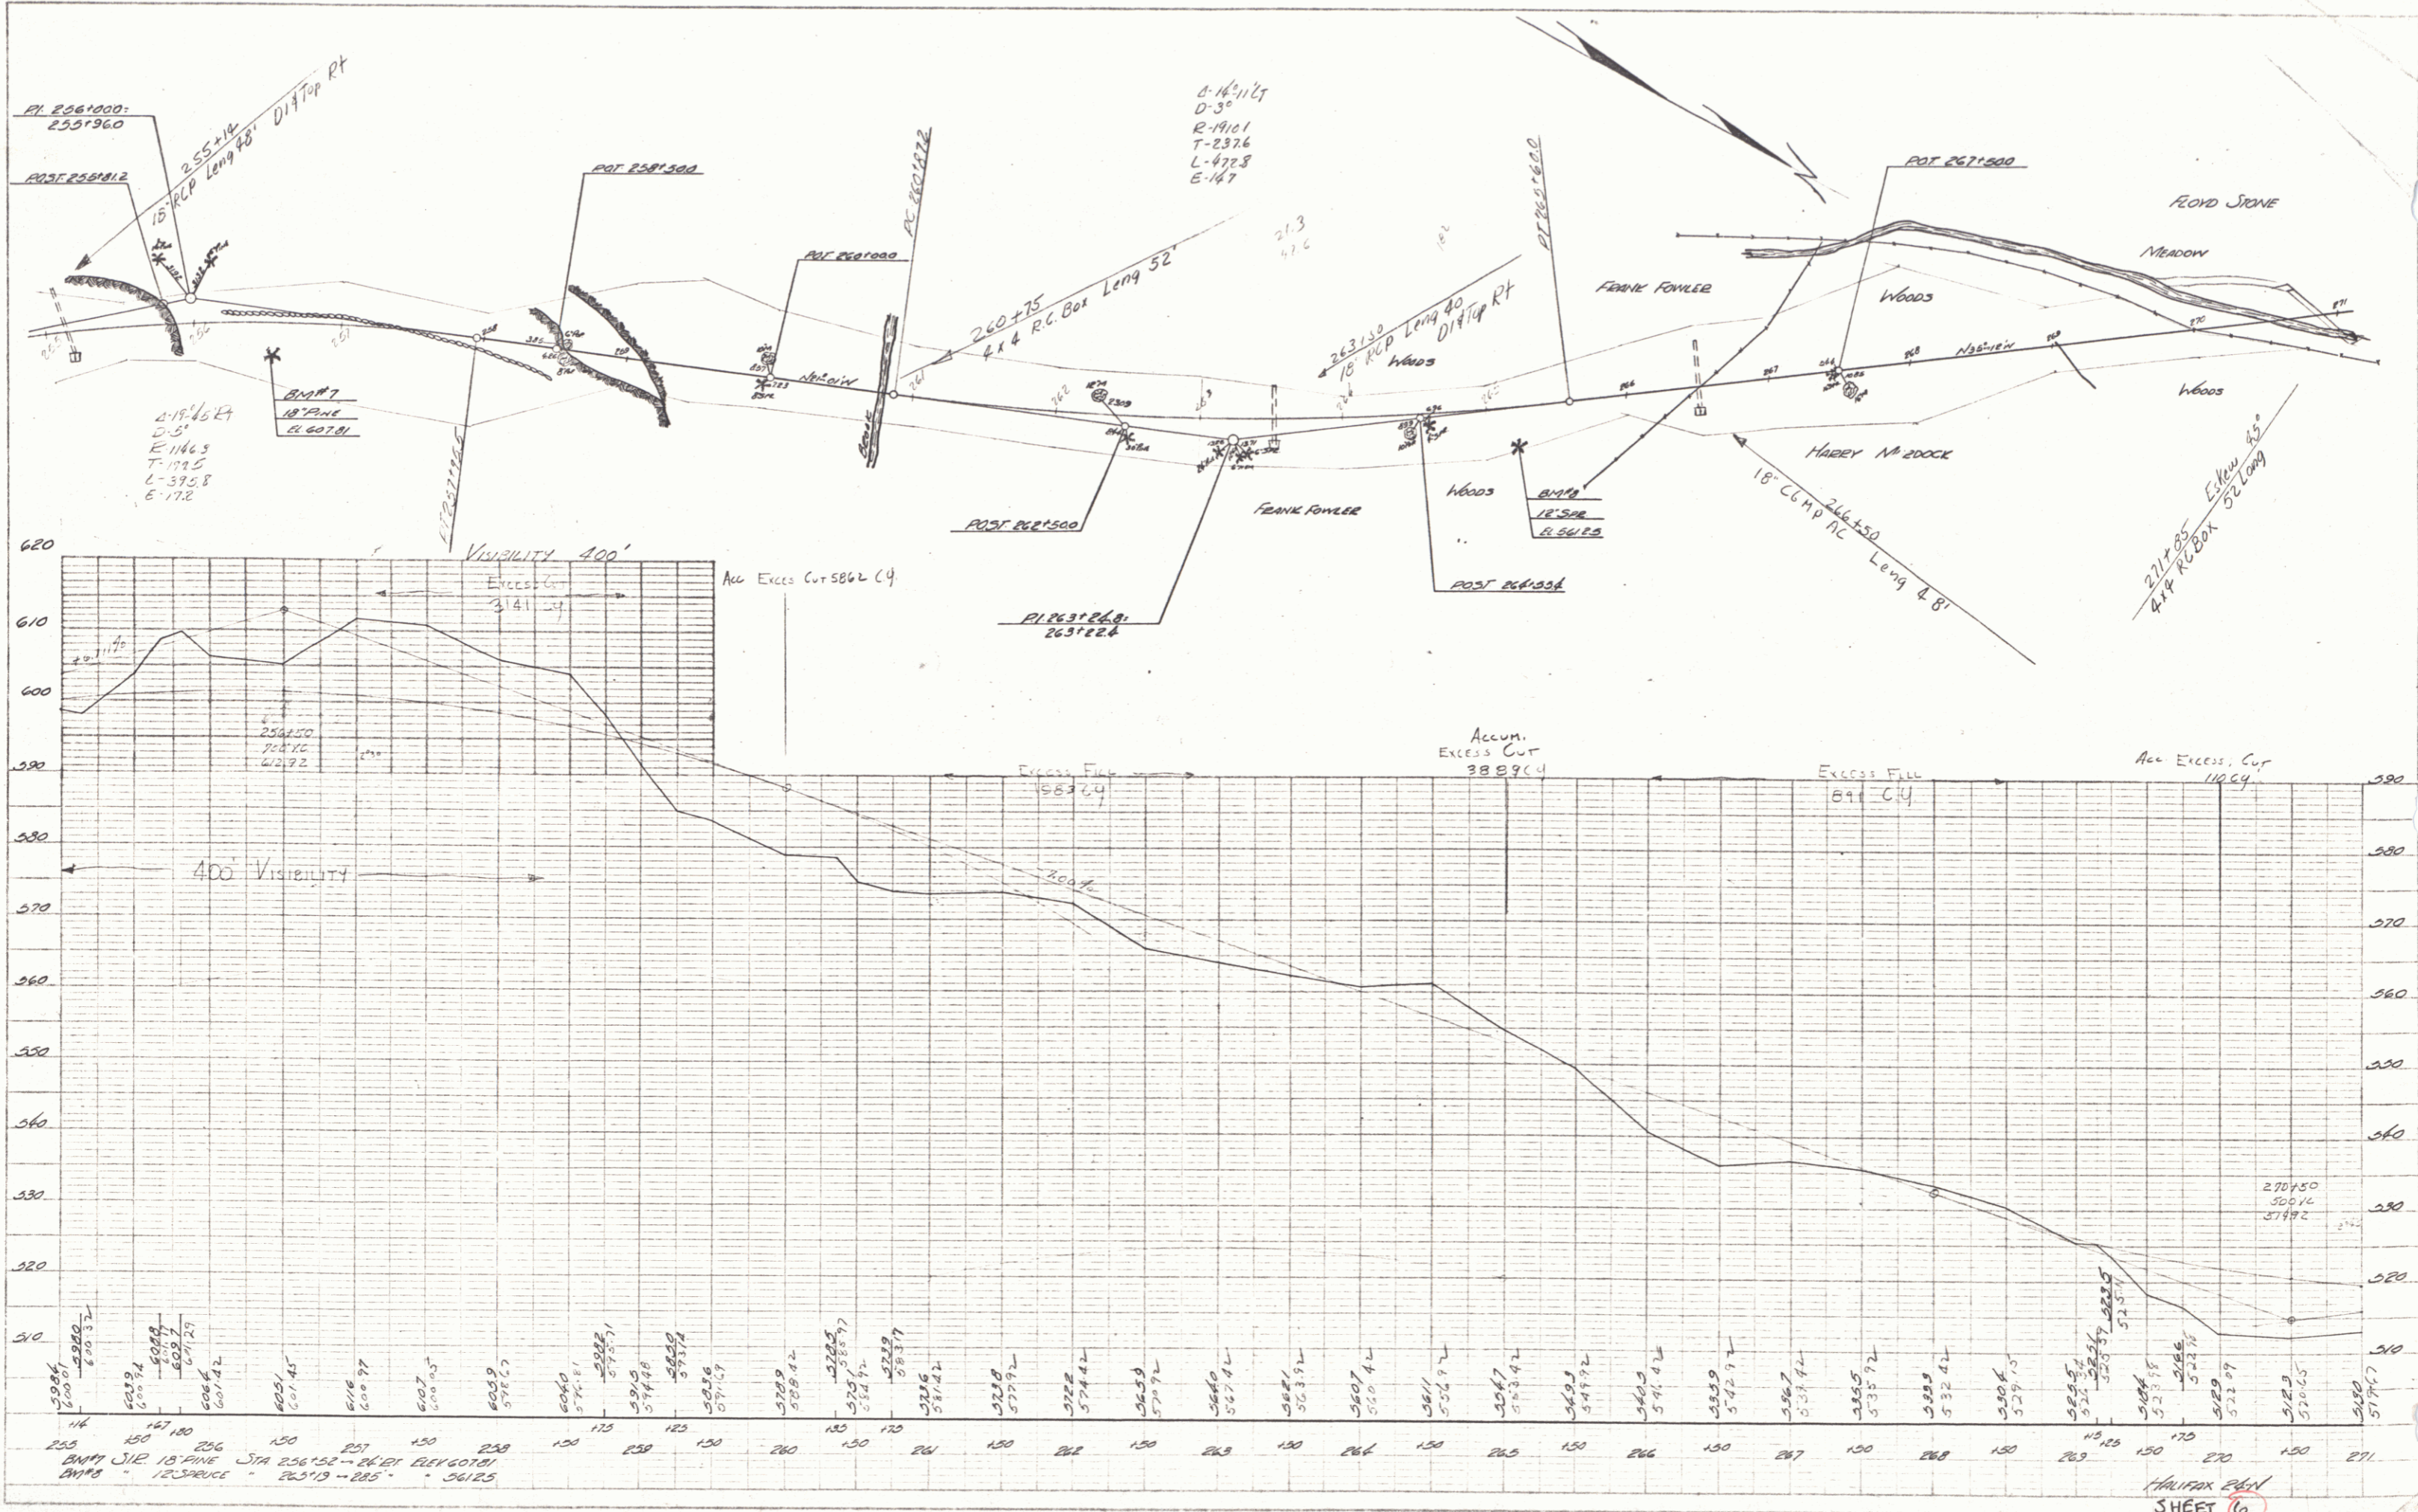


PLATE 1 - PLAN PROFILE 1:1 H.K.E. STANDARD

HALIFAX ROAD  
 SHEET 6