


PROPERTY OF
PLANNED
NOTE BOOK
NO. 1000
MADE IN U.S.A.

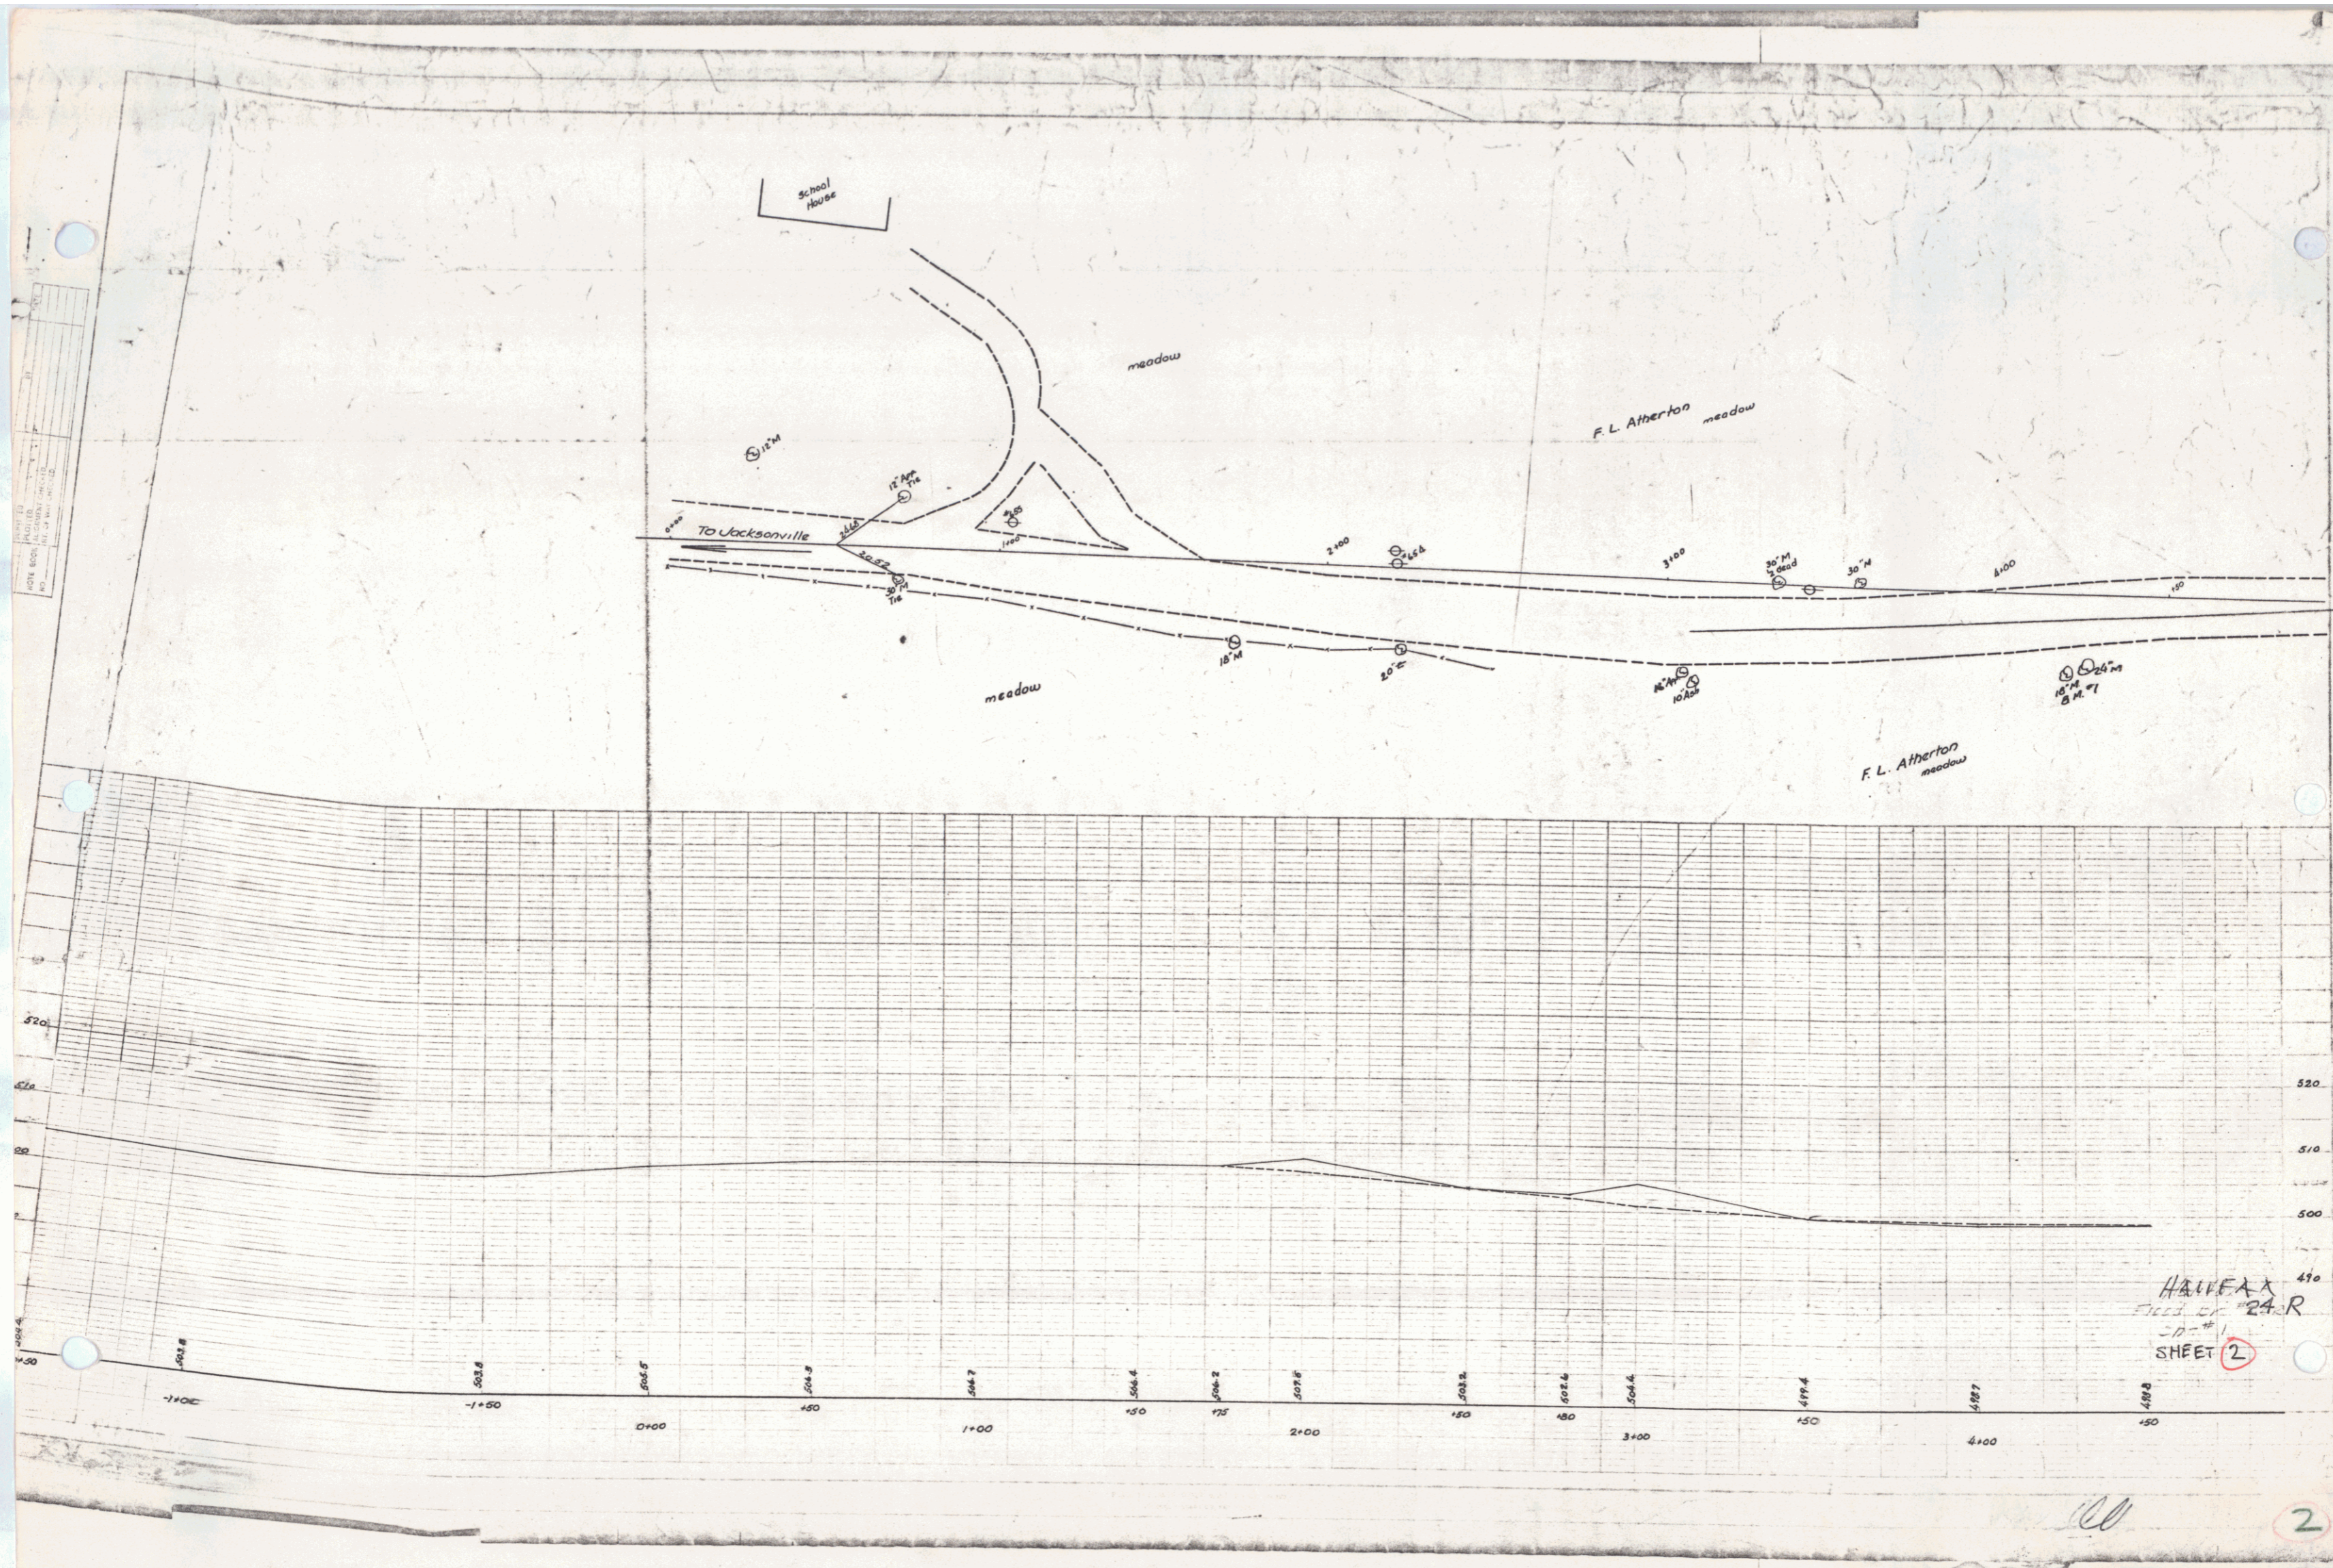

HALF AX
FIELD OF 24-R
10-11
SHEET 2

2