
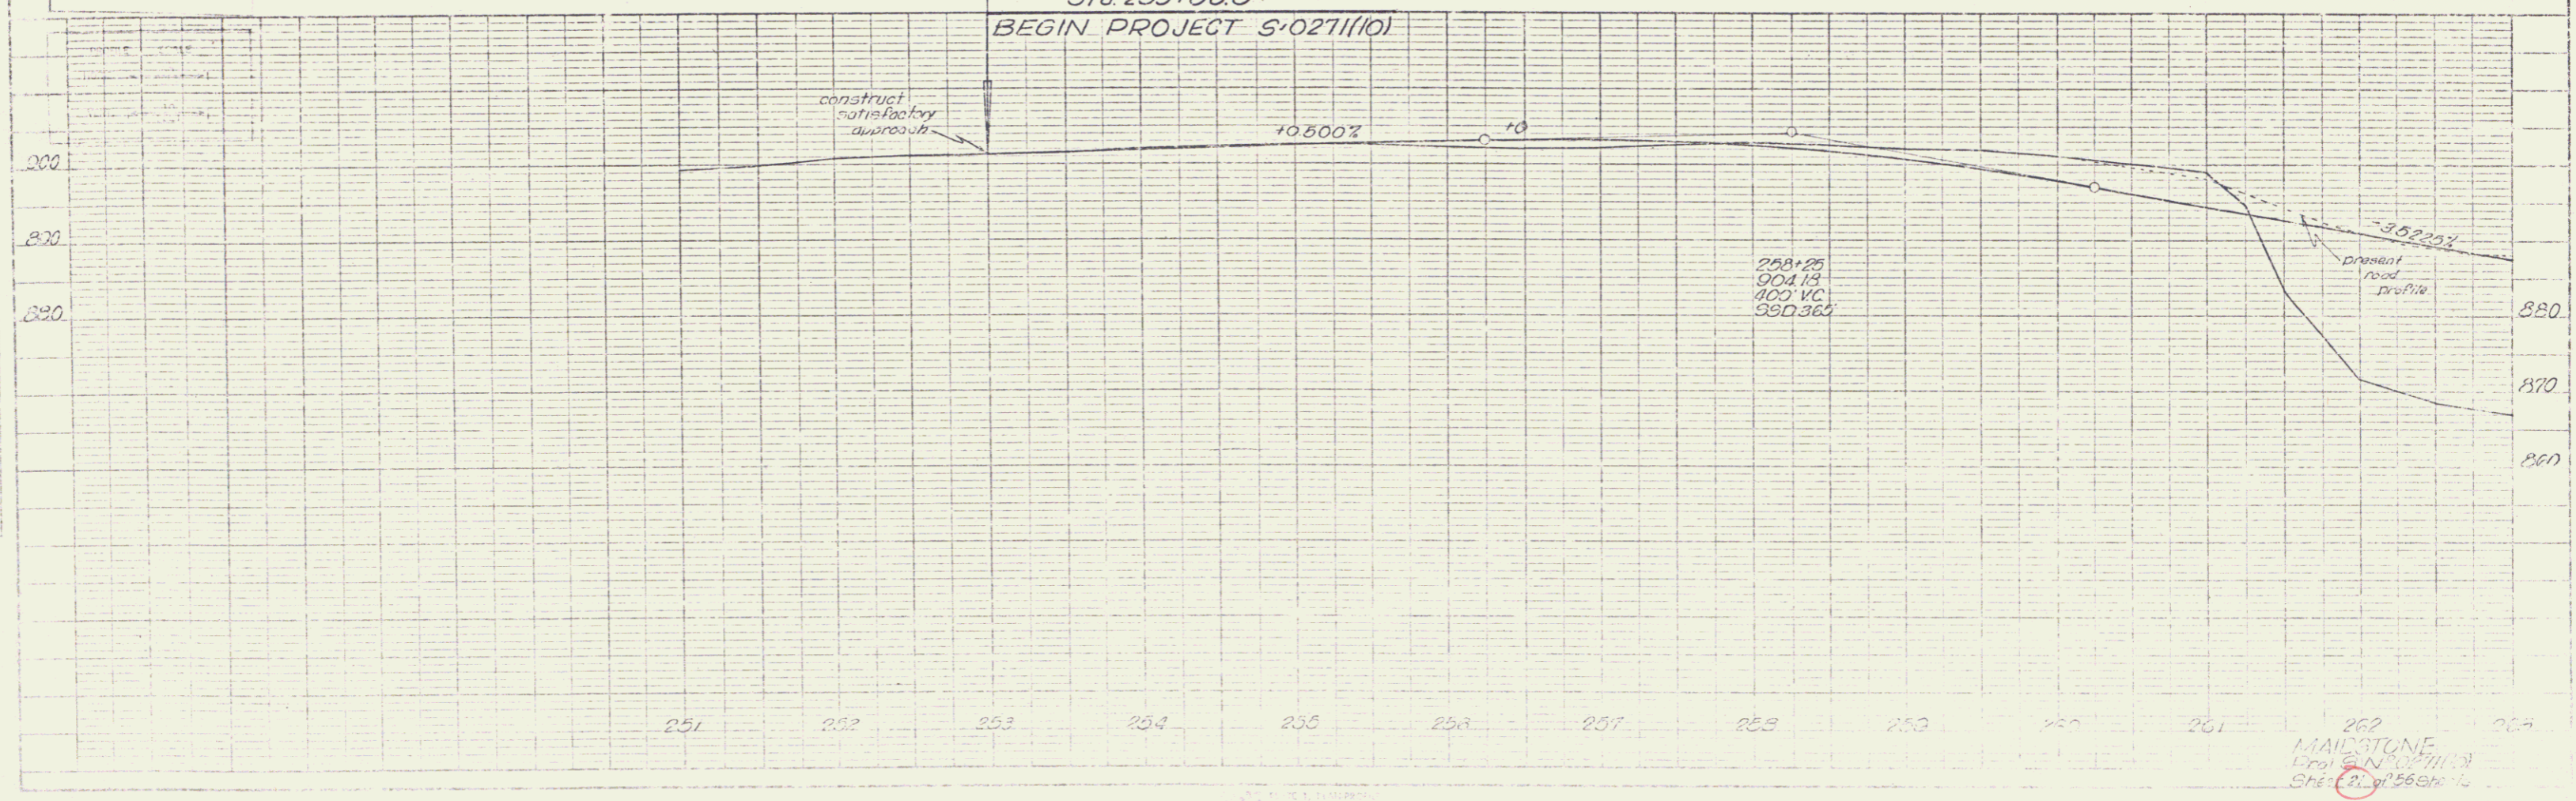
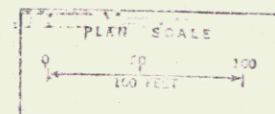


REMOVAL & DISPOSAL OF PRESENT GUARD RAIL	CONSTRUCT DRIVE	TWO CABLE GUARD RAIL	TREATED TIMBER CURB	PAVED SHOULDERS
LI	LI	LI	LI	LI
247+45 - 283+00	252+00 - 254+50	261+73 - 263+00	261+13 - 263+00	261+73 - 263+00
RI	RI	RI	RI	RI
	254+50 - 257+00	263+00 - 264+73	263+00 - 264+73	264+73 - 266+13

NOTE: Drives are to be Constructed with a 12' minimum width and 20' minimum Flores. For Right-of-Way Details see Right-of-Way Plans for this Project.

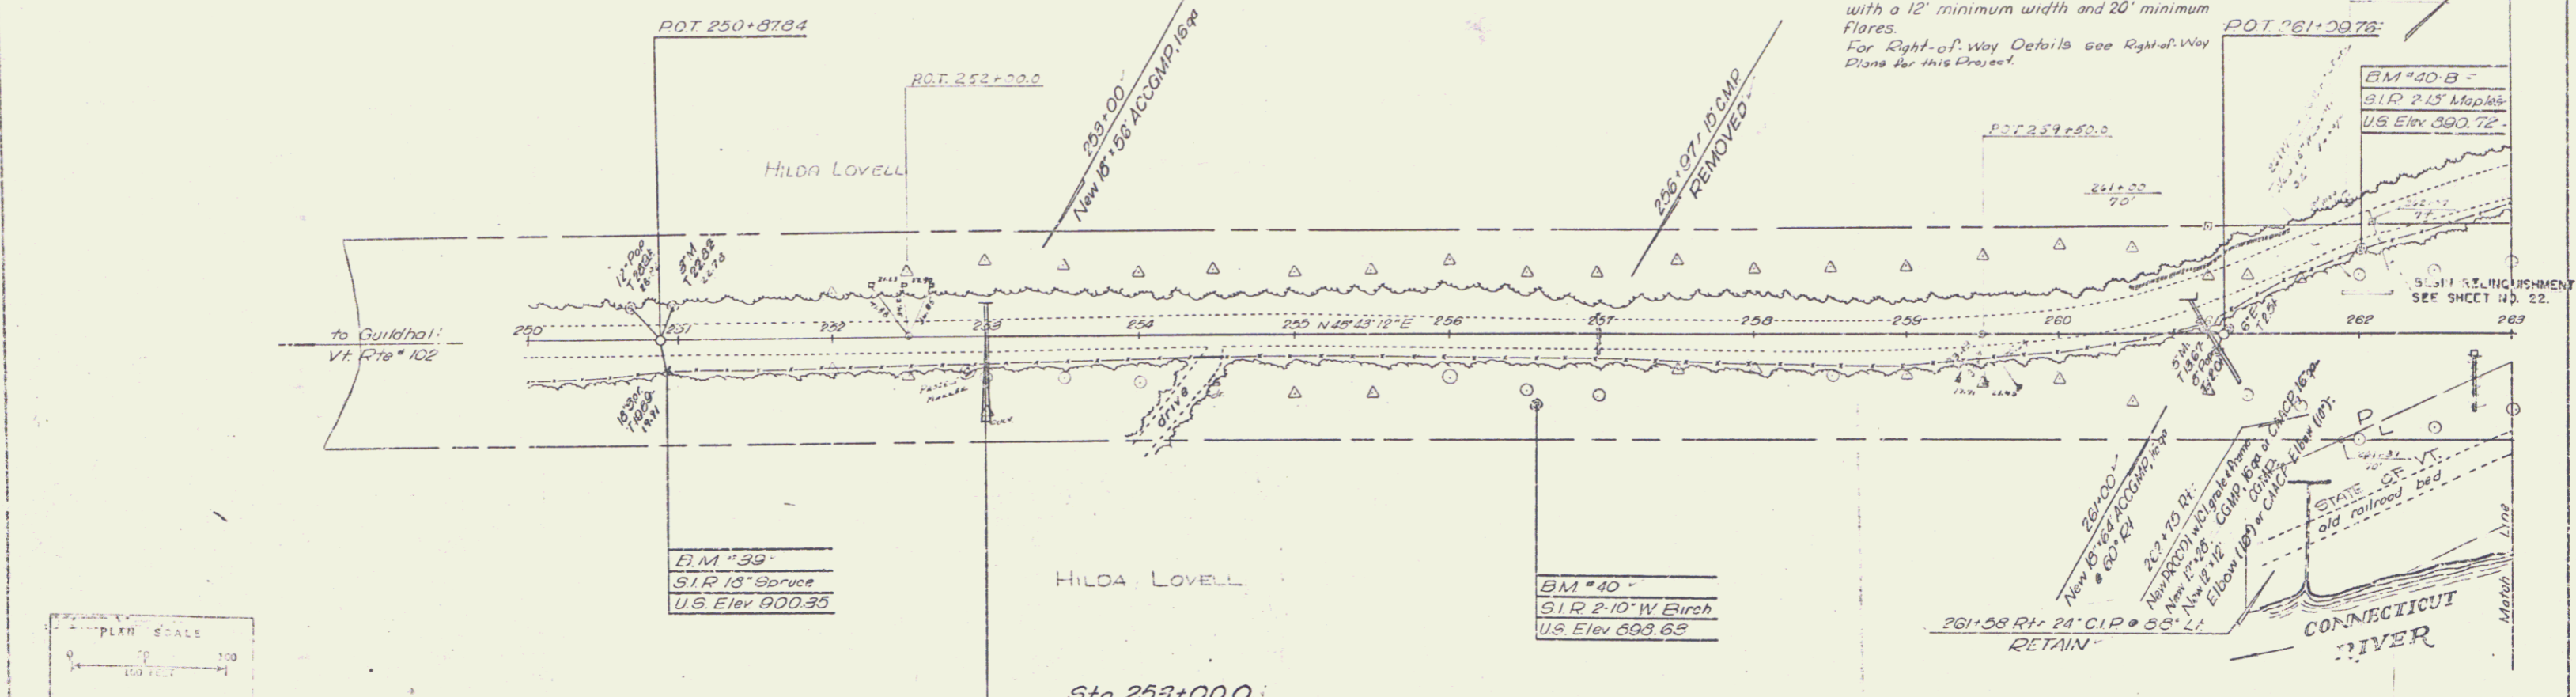

PLAN  
 DATE: 12/28/10  
 DRAWN BY: J. Clark  
 CHECKED BY: L. E. Brown

PROFILE  
 DATE: 12/28/10  
 DRAWN BY: J. Clark  
 CHECKED BY: L. E. Brown

MAILSTONE  
 Spot Elev 897.11  
 Sta 262