

DRILLING AND BLASTING
OF SOLID ROCK SUBGRADE
311+00 - 311+50
320+75 - 322+75
at 323+10

DEMOLITION AND DISPOSAL
OF BUILDING
LT RT


TWO CABLE GUARD RAIL
LT RT
316+75-317+75
312+30-313+54
316+00-321+20
323+25-323+51
324+75-327+00
322+75-323+50

CONSTRUCT DRIVE
LT RT
319+00 321+50
312+30 Park Ave

TREATED TIMBER CURB
LT RT
316+00-320+50
324+75-327+00
322+75-323+50

PAVED SHOULDERS
LT RT
316+00-320+50
324+75-327+00
322+75-323+50

320+50-321+00 RT-10
324+75-324+50 RT-2
323+50 RT-1

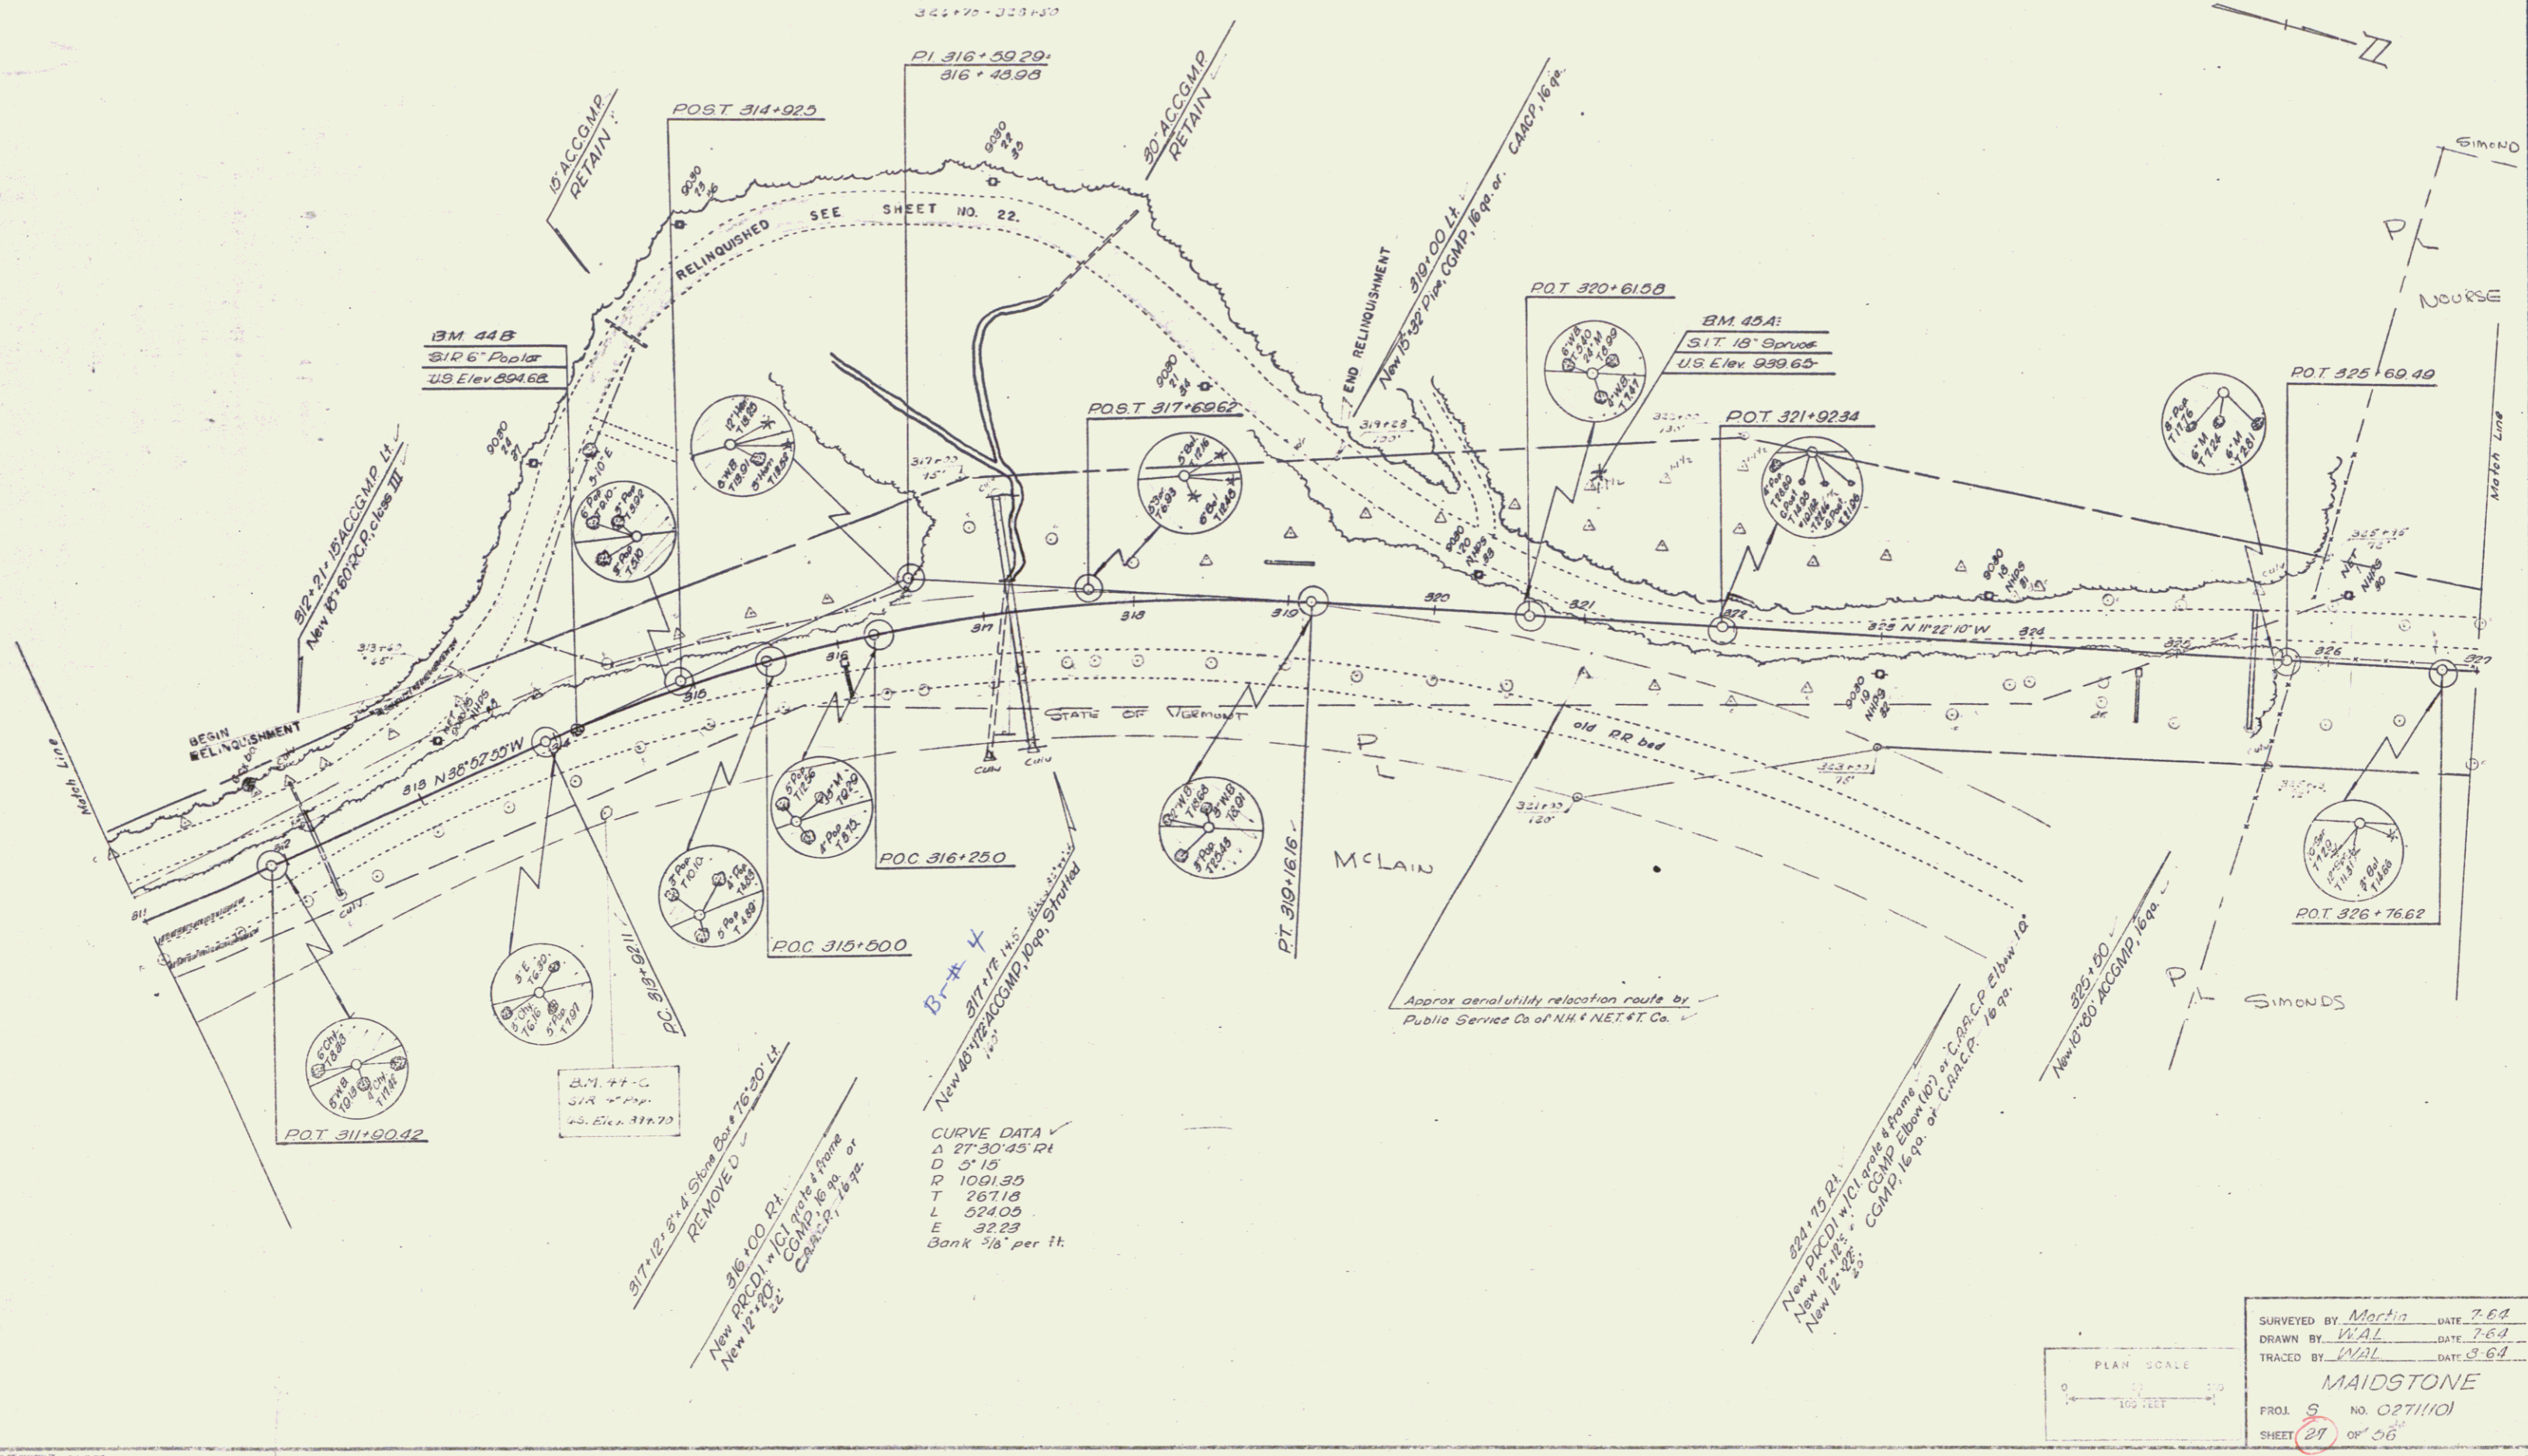

SURVEYED BY: *Mortia* DATE: 7-64
 DRAWN BY: *WAL* DATE: 7-64
 TRACED BY: *WAL* DATE: 8-64
MAIDSTONE
 PROJ. NO. 02711/01
 SHEET 21 OF 26