



TREATED TIMBER CURB 527+00-328+00
 PAVED SHOULDERS 327+00-328+99
 TWO CABLE GUARD RAIL Rt. 327+00-228+99
 CONSTRUCT DRIVE Lt. 330+50

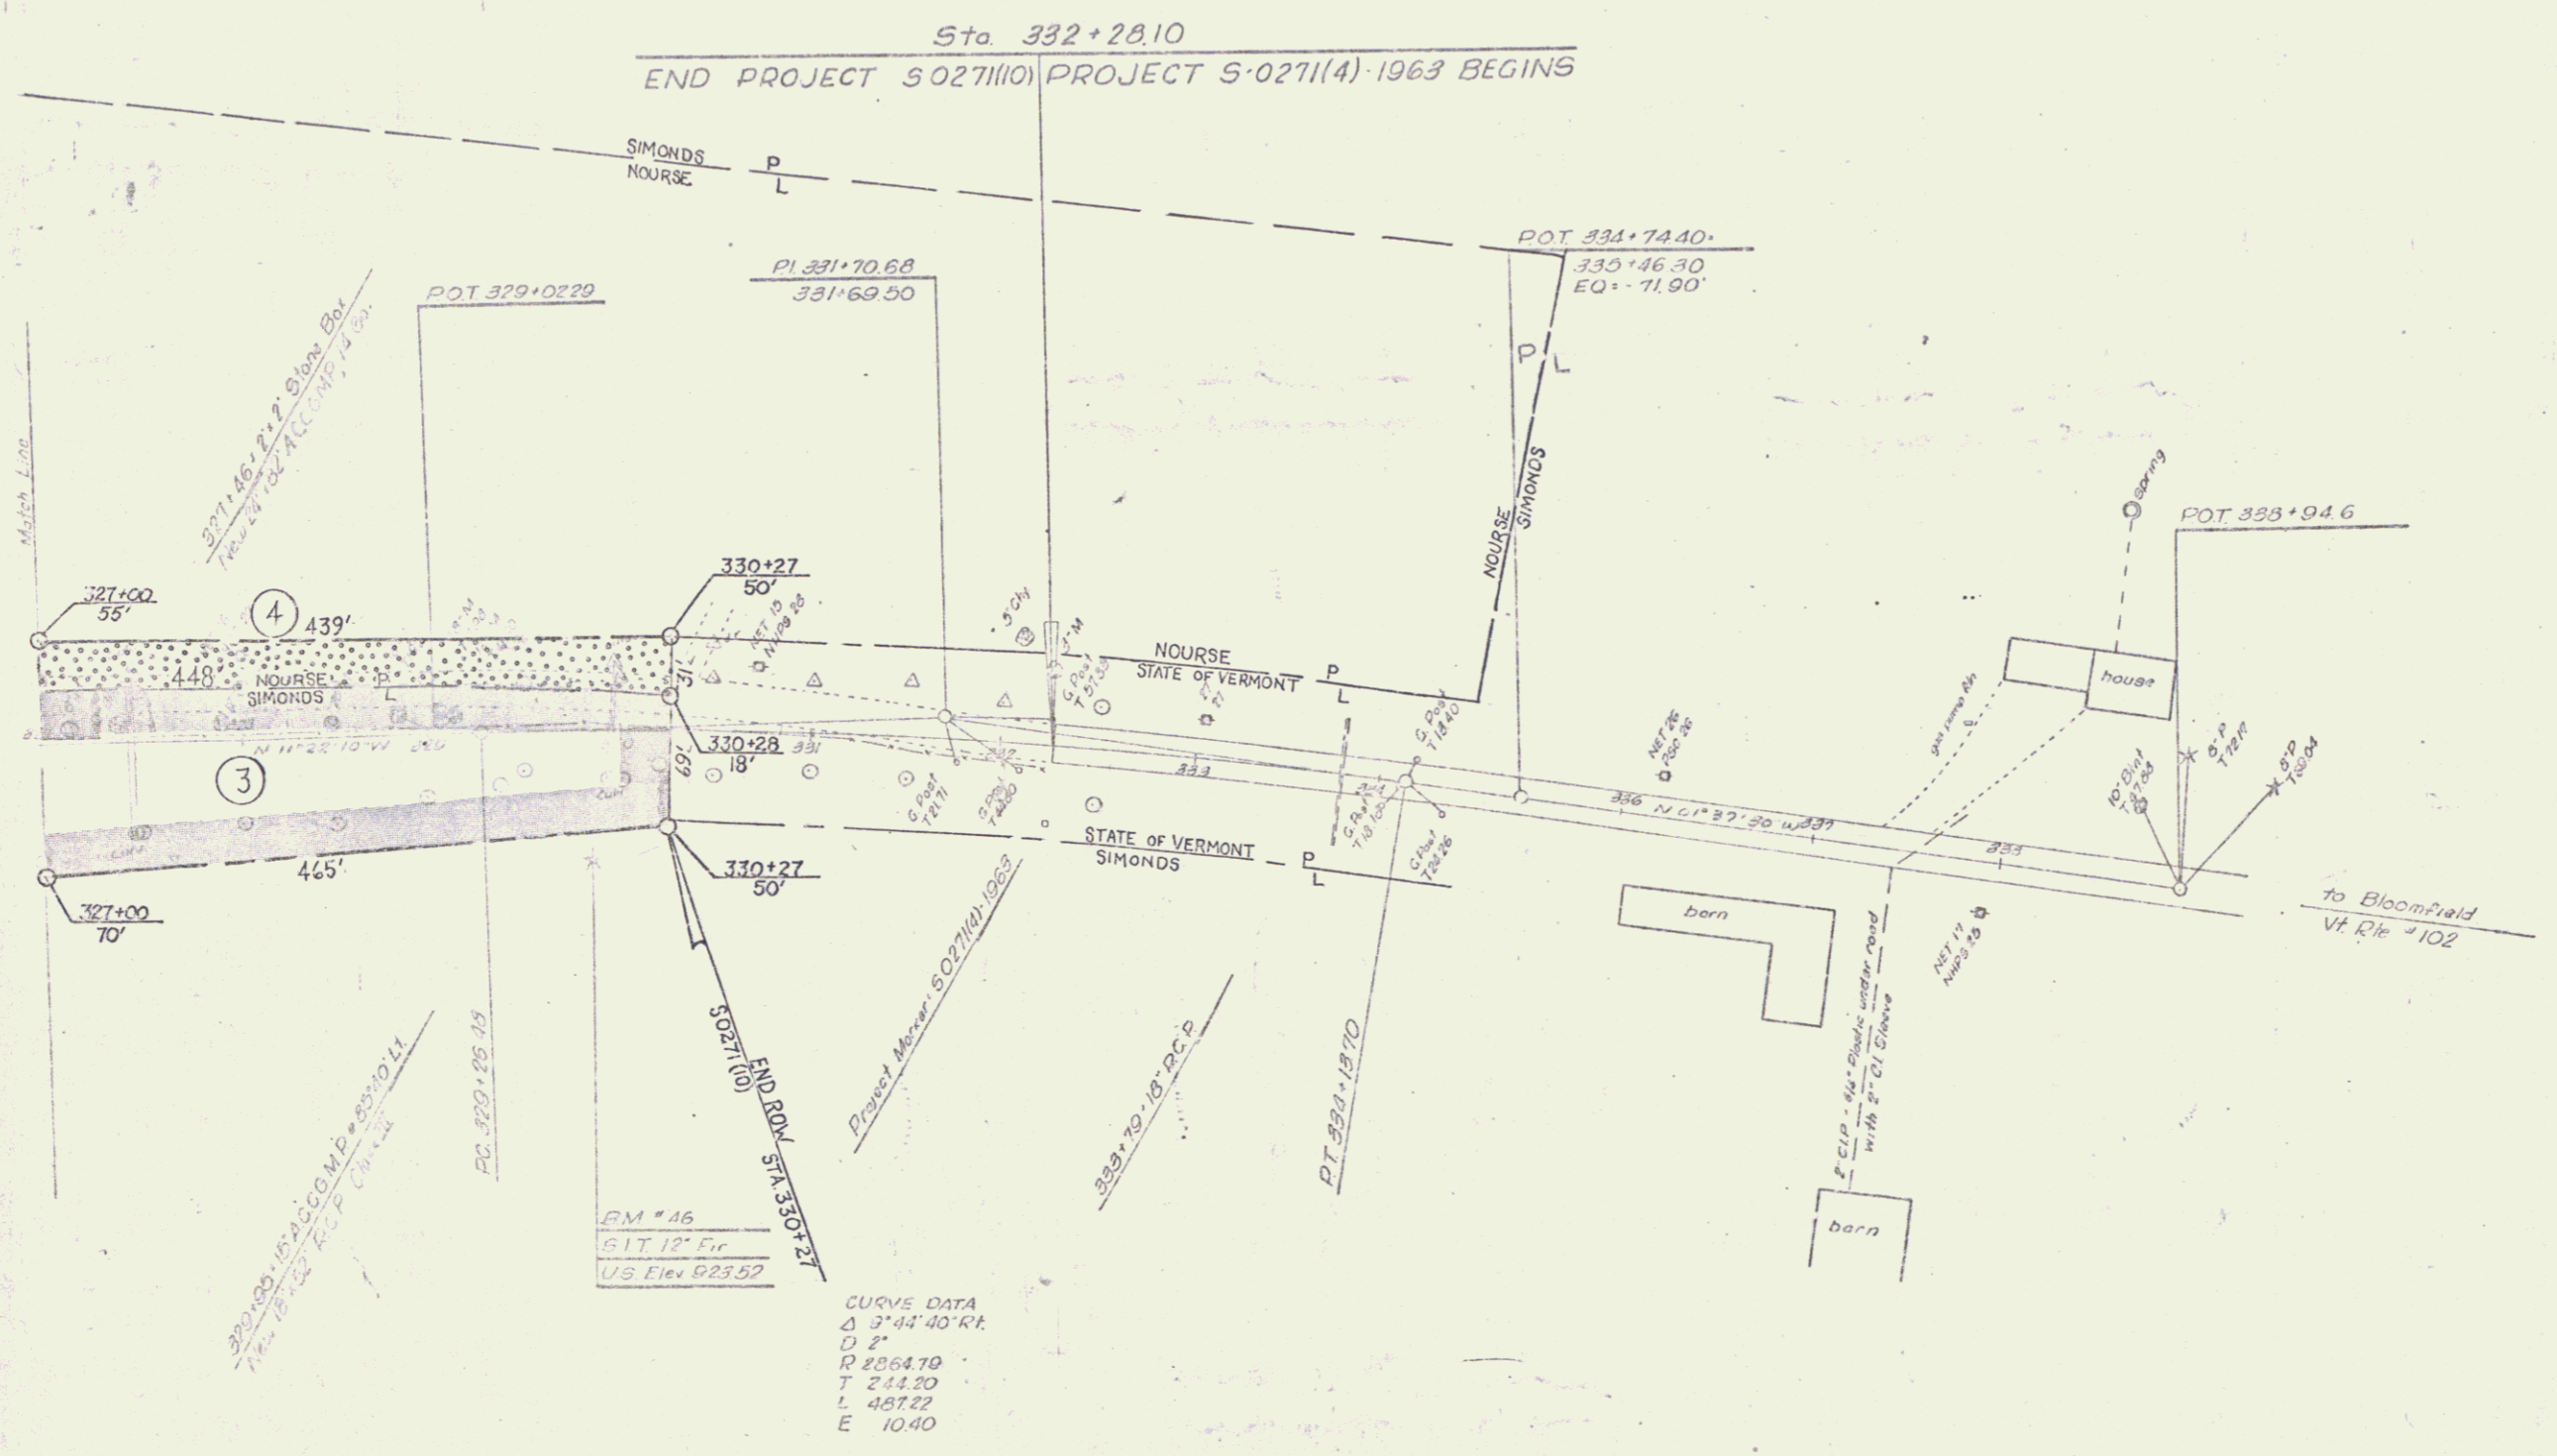

FM # 46
 51T 12' Fr
 US Hwy R2352

CURVE DATA
 Δ 2°44'40" Rt.
 D 2'
 R 2864.70
 T 244.20
 L 487.22
 E 10.40

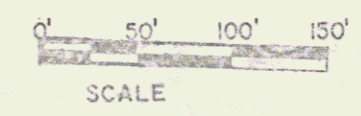

VERMONT DEPARTMENT OF HIGHWAYS
 RIGHT-OF-WAY PLANS
 PROJECT: MAIDSTONE
 NO. S0271(10)
 SHEET 13 OF 19