
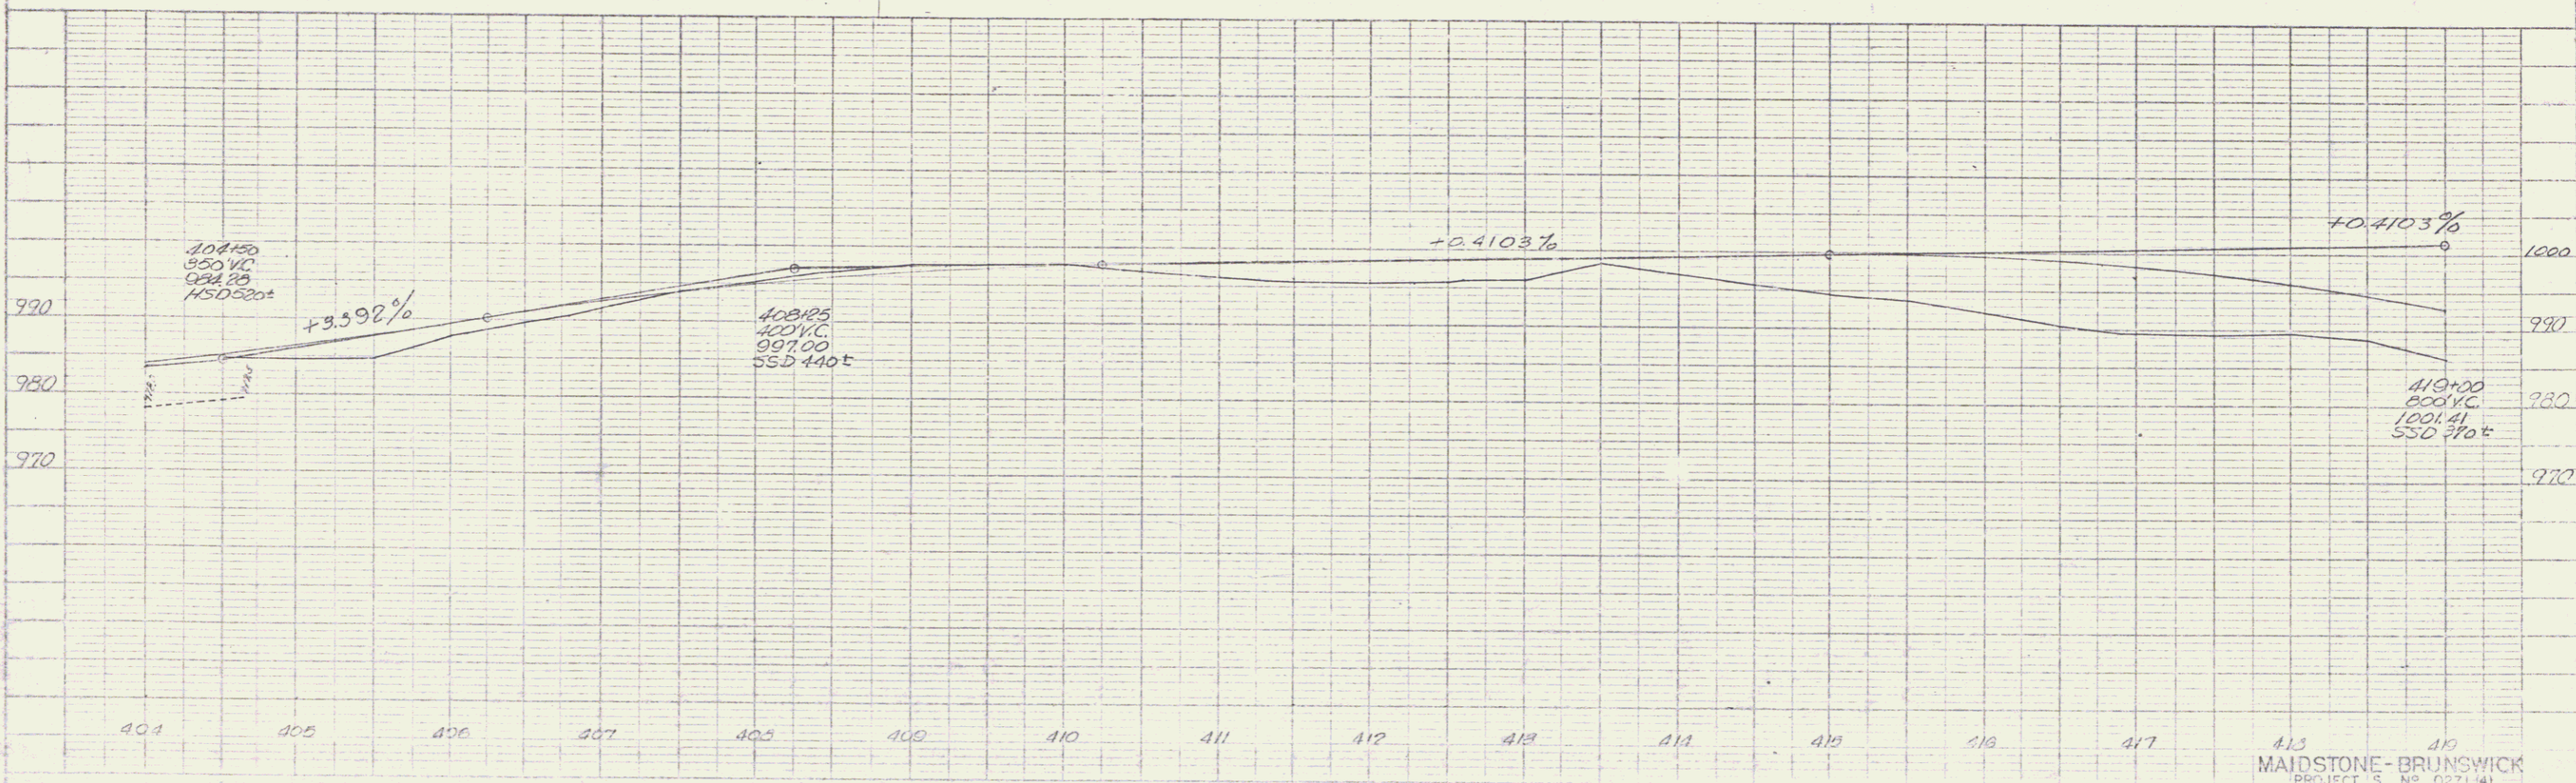


PLAN
 PROJECT: *Amundson*
 DRAWN BY: *Delano*
 DATE: *1/24/87*
 CHECKED BY: *Al Everett*
 NO. *1*

PROFILE
 PROJECT: *Amundson*
 DRAWN BY: *Delano*
 DATE: *1/24/87*
 CHECKED BY: *Al Everett*
 NO. *1*

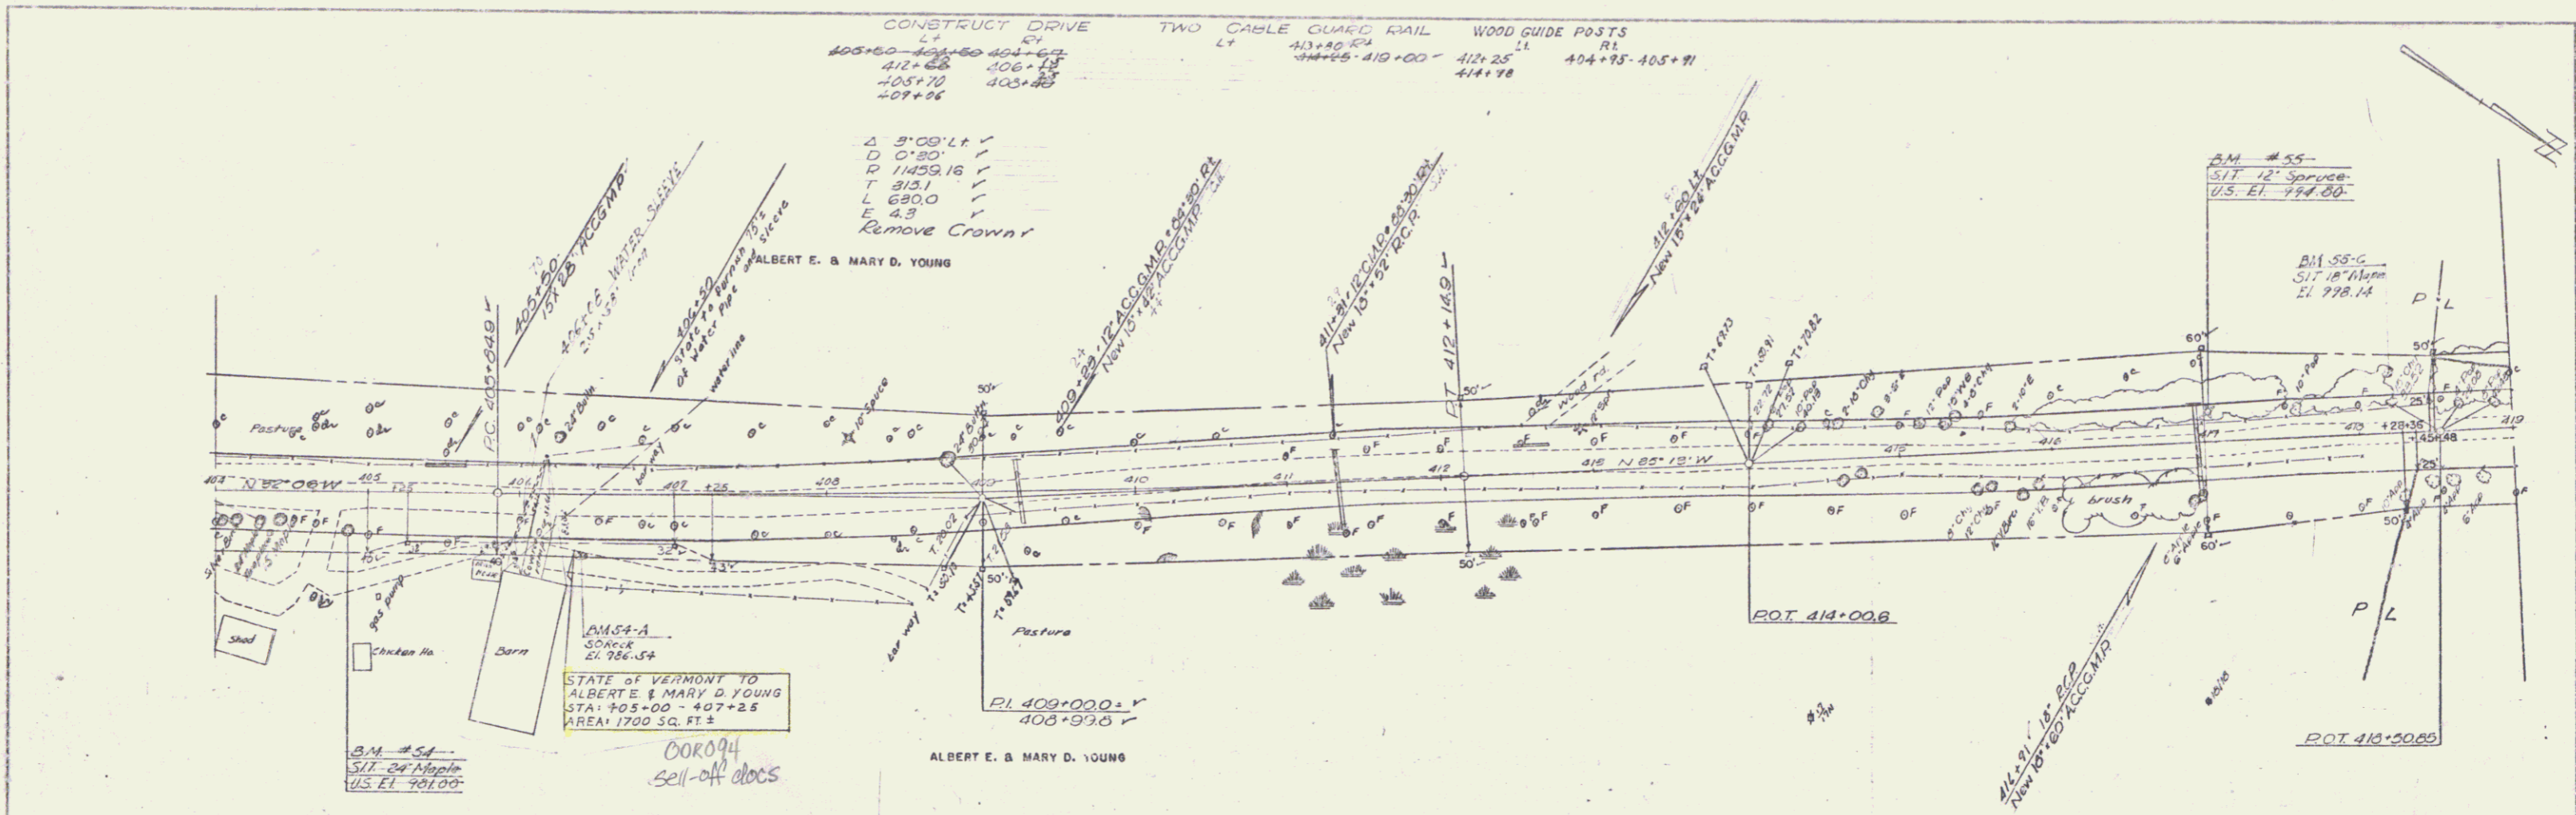

MAIDSTONE-BRUNSWICK
 PROJECT 5, NO. 0271(4)
 SHEET 24 OF 129