


PLAN
 DATE: 1/15/58
 DRAWN BY: J. W. WILSON
 CHECKED BY: J. W. WILSON
 PROJECT: BRUNSWICK
 SHEET: 27 OF 129



PROFILE
 DATE: 1/15/58
 DRAWN BY: J. W. WILSON
 CHECKED BY: J. W. WILSON
 PROJECT: BRUNSWICK
 SHEET: 27 OF 129

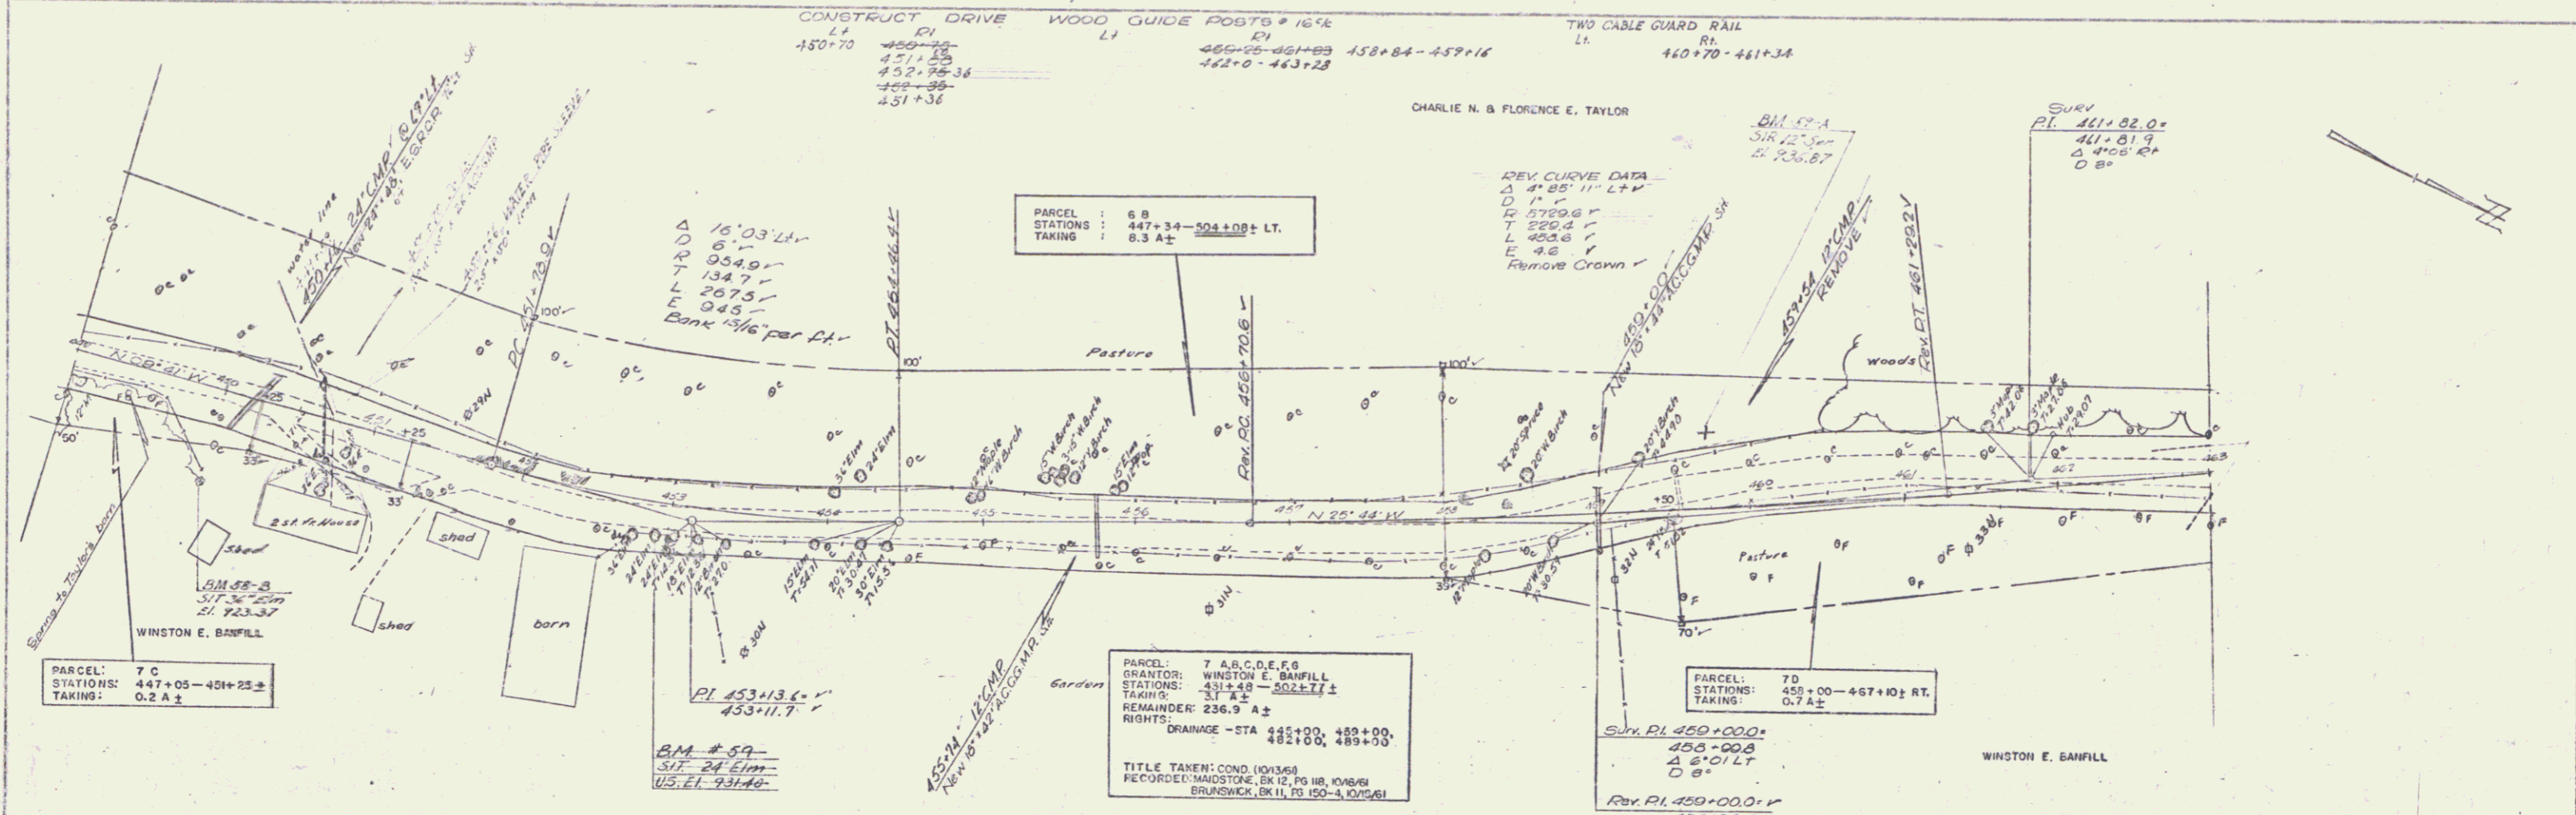