
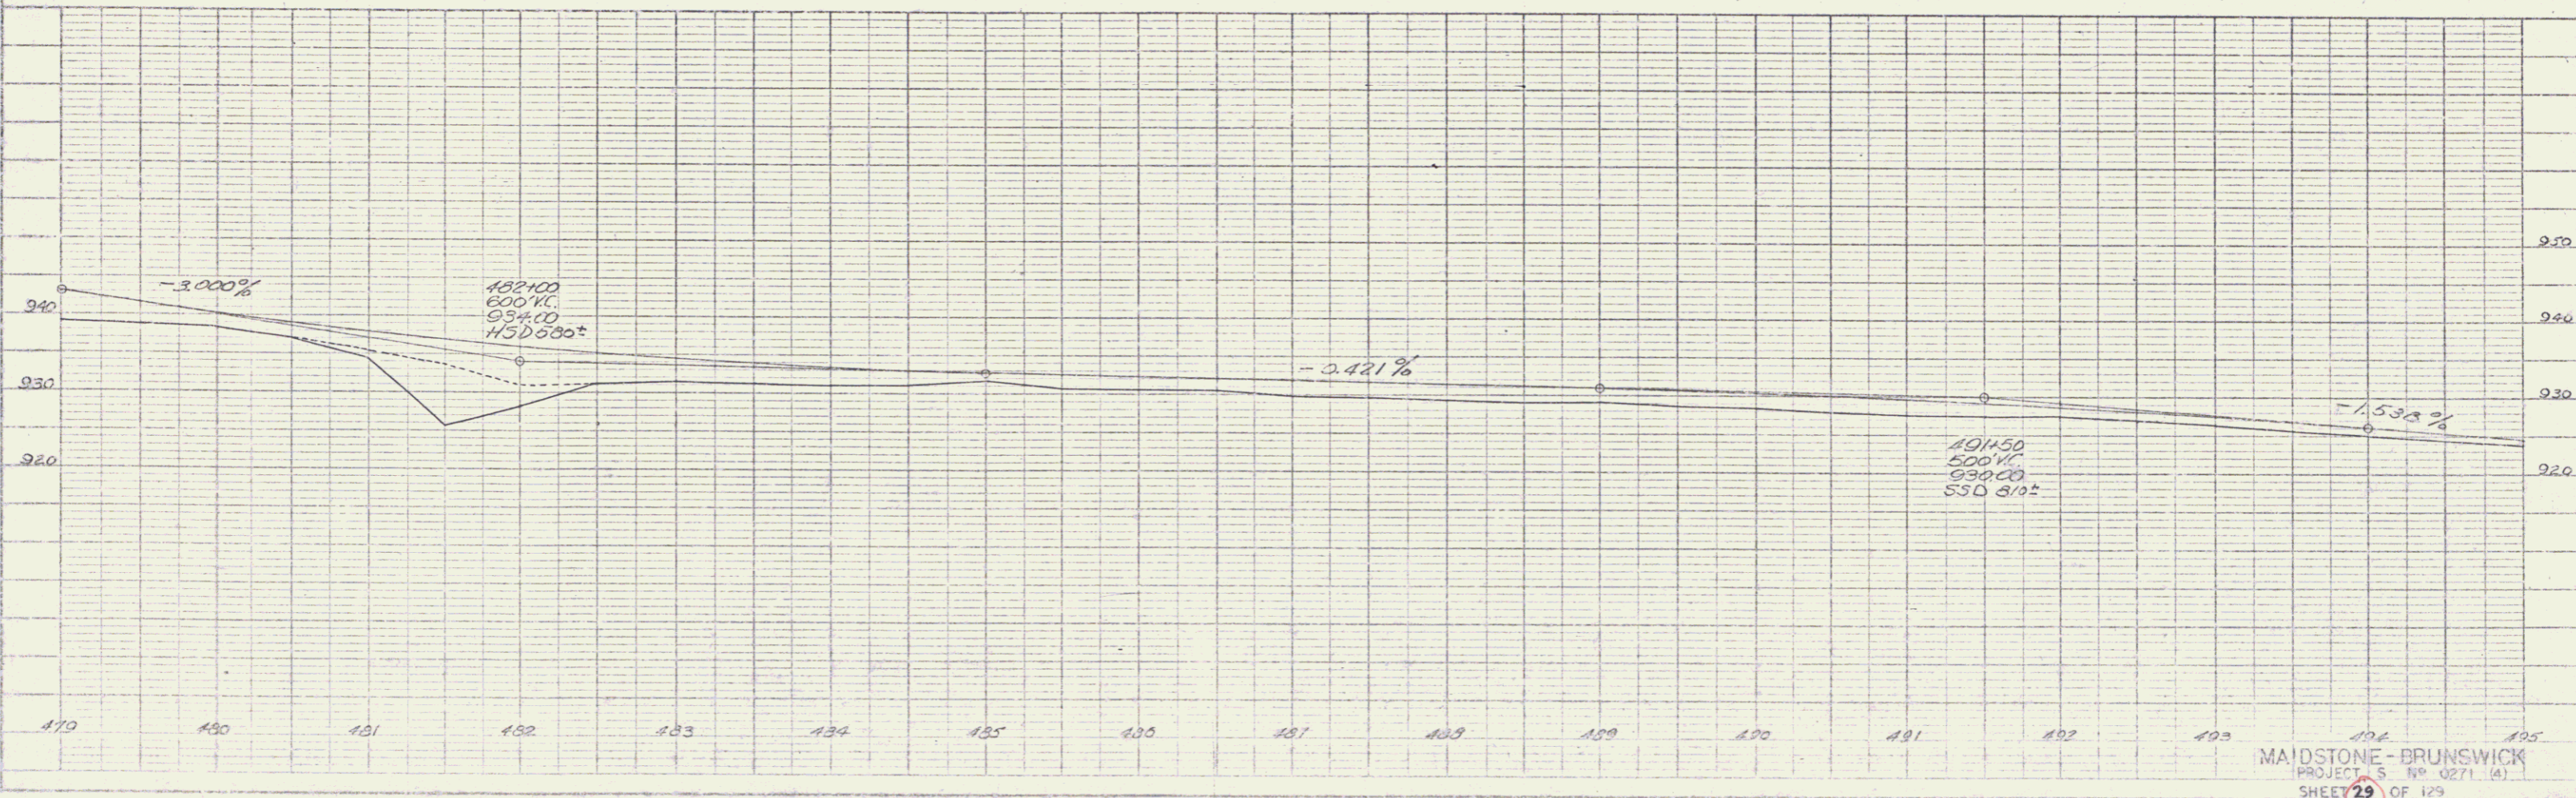


PLAN  
 DRAWN BY: [Signature]  
 CHECKED BY: [Signature]  
 DATE: 1/25/50

PROFILE  
 DRAWN BY: [Signature]  
 CHECKED BY: [Signature]  
 DATE: 1/25/50

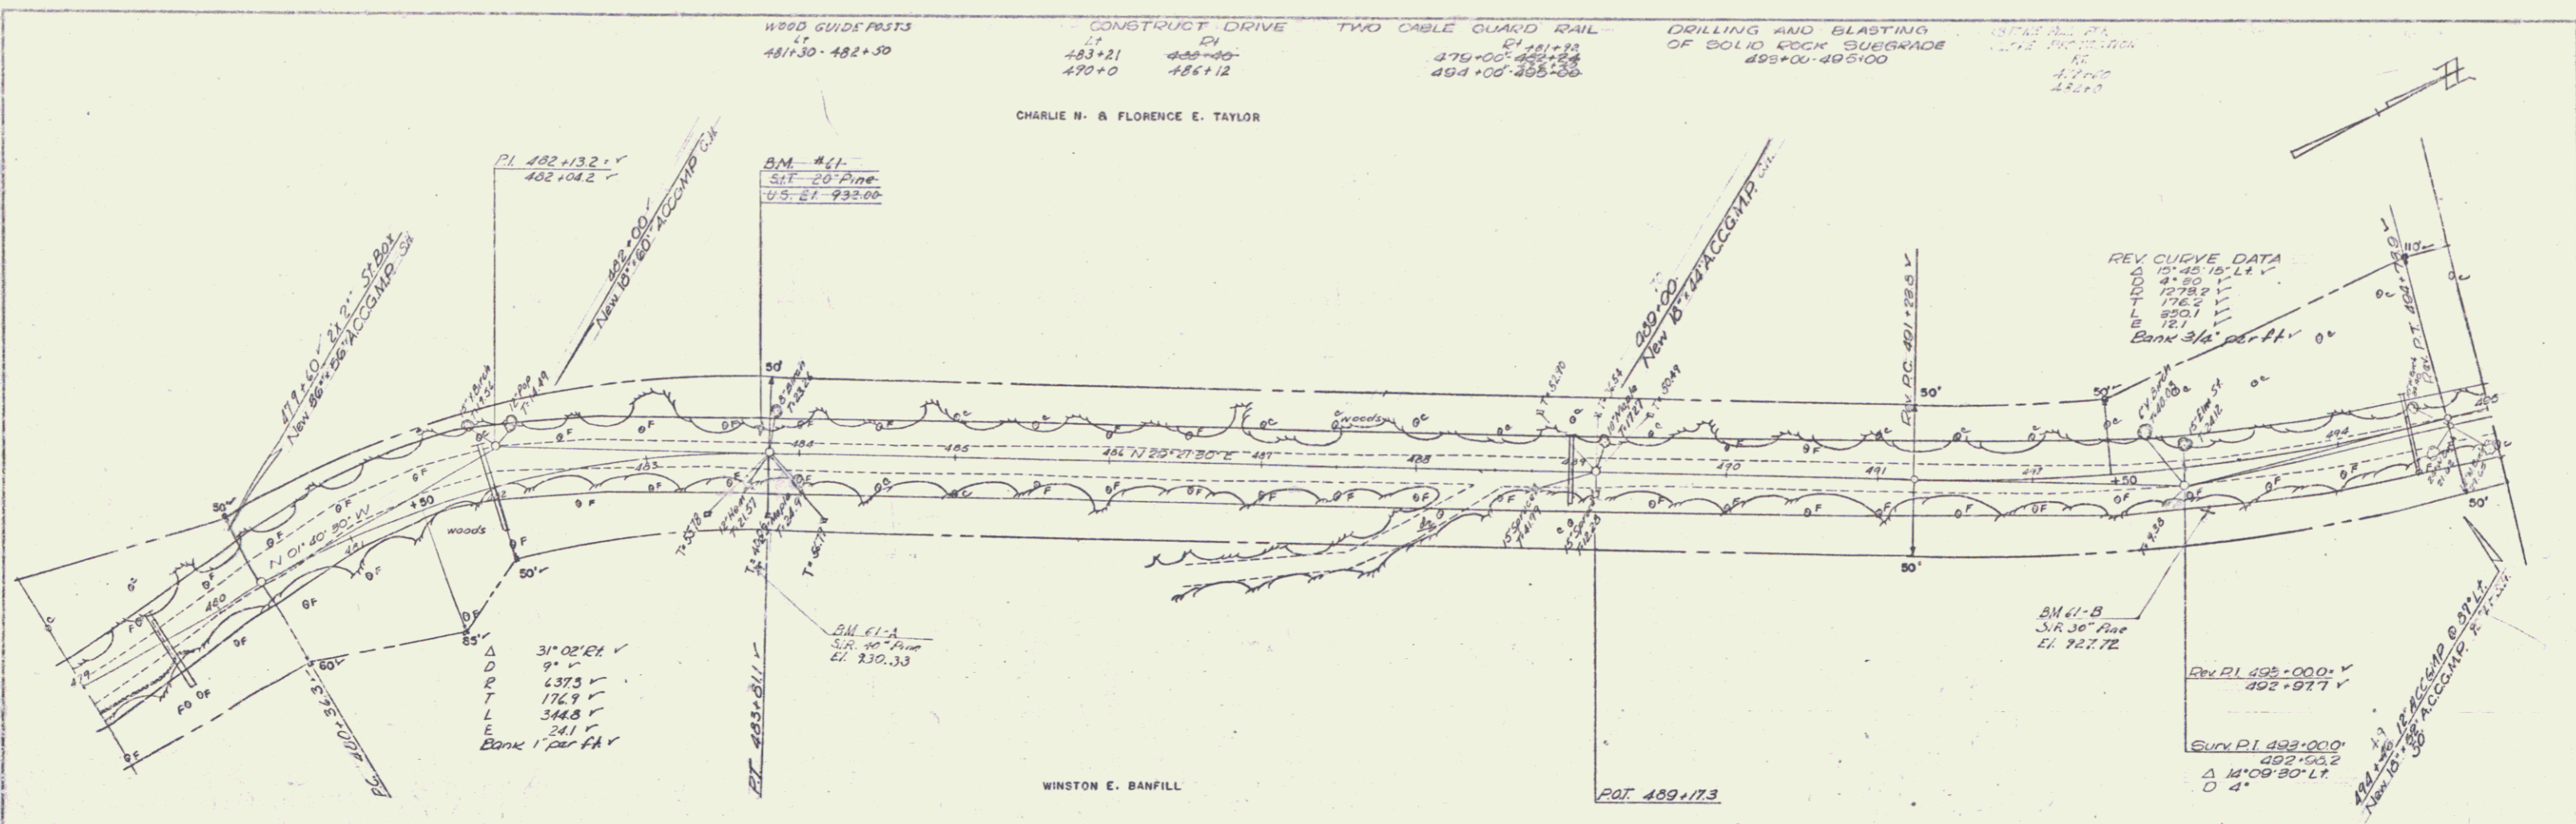

WOOD GUIDS POSTS  
 481+30 - 482+30

CONSTRUCT DRIVE  
 483+21 - 484+40  
 470+0 - 484+12

TWO CABLE GUARD RAIL  
 478+00 - 484+30  
 484+00 - 485+00

DRILLING AND BLASTING  
 OF SOLID ROCK SUEGRADE  
 488+00 - 495+00

CHARLIE N. & FLORENCE E. TAYLOR

WINSTON E. BANFILL

PAT 489+173

MAIDSTONE - BRUNSWICK  
 PROJECT S. NO. 0271 (A)  
 SHEET 29 OF 129