



PLAN	DATE	BY
REVISED		
NOTE BOOK		

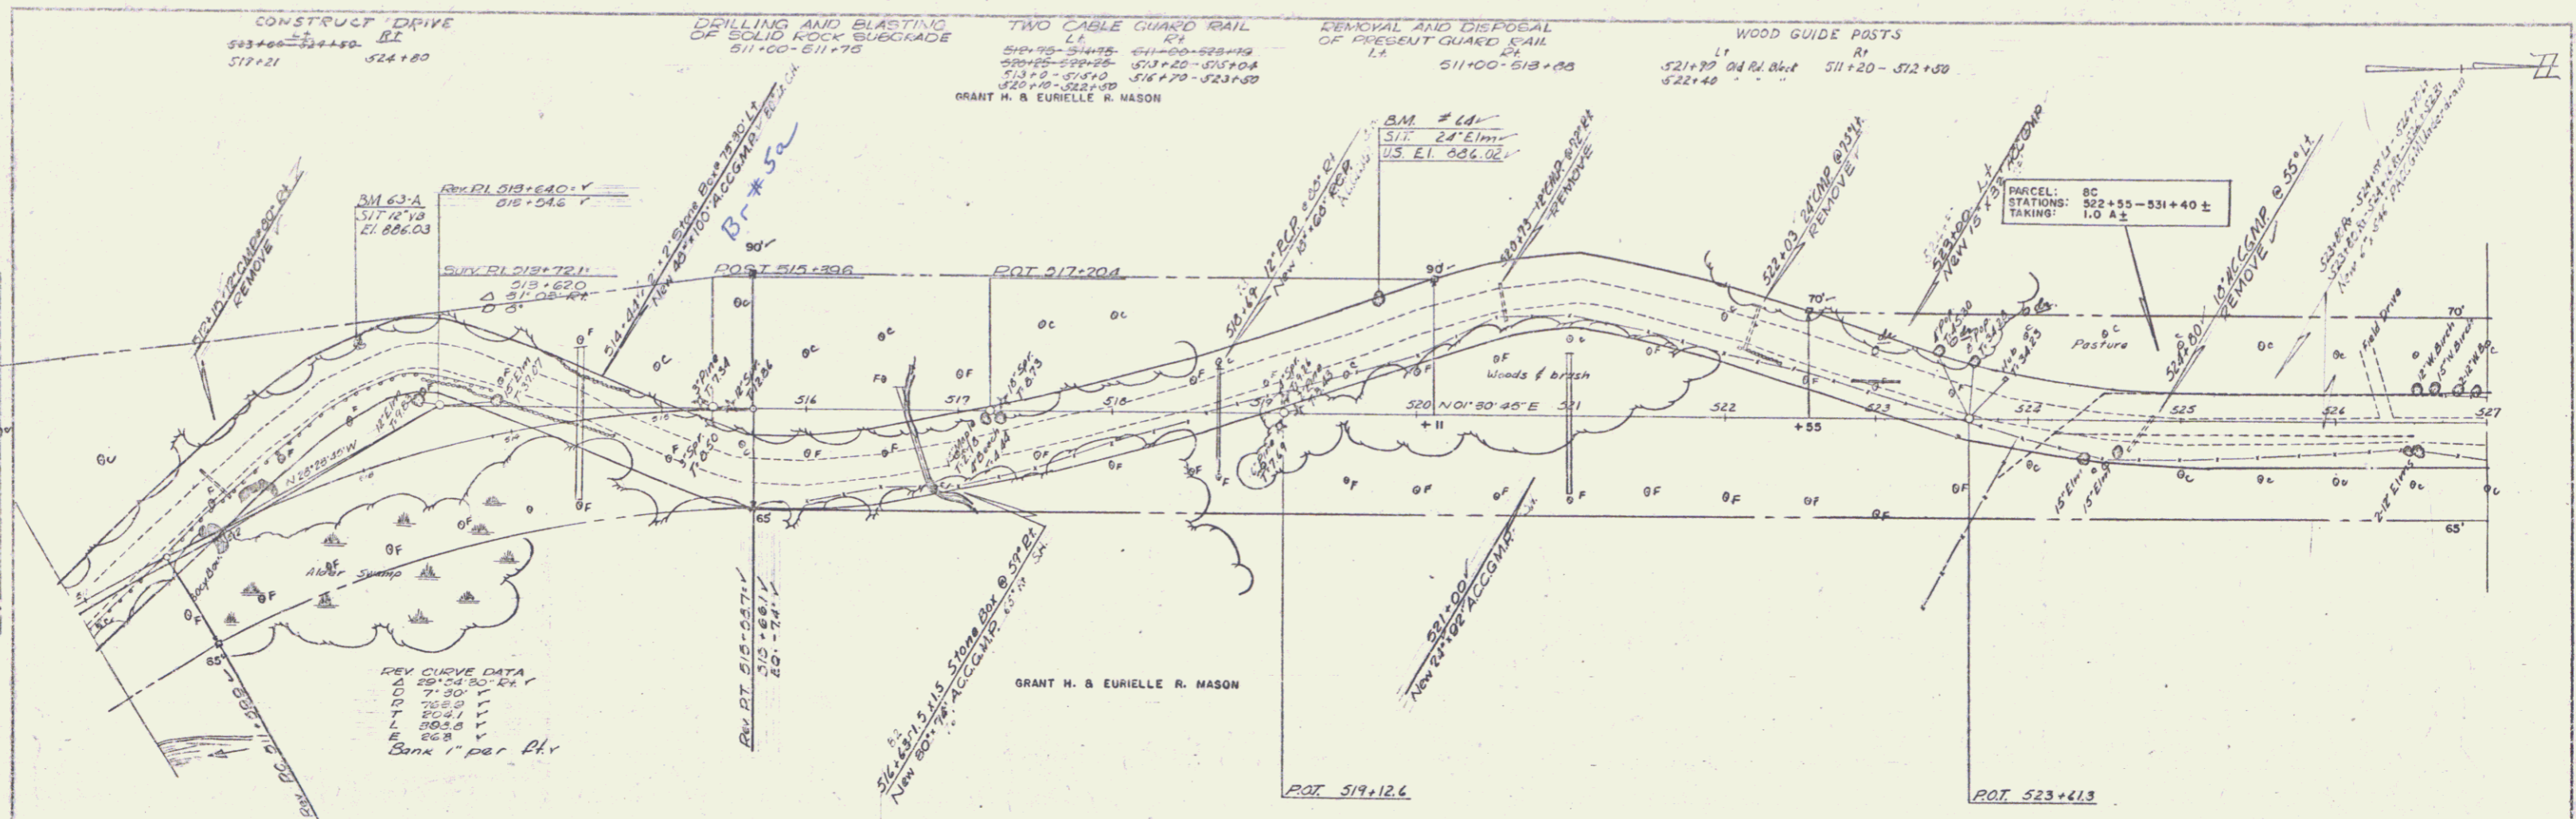

PROFILE	DATE	BY
REVISED		
NOTE BOOK		

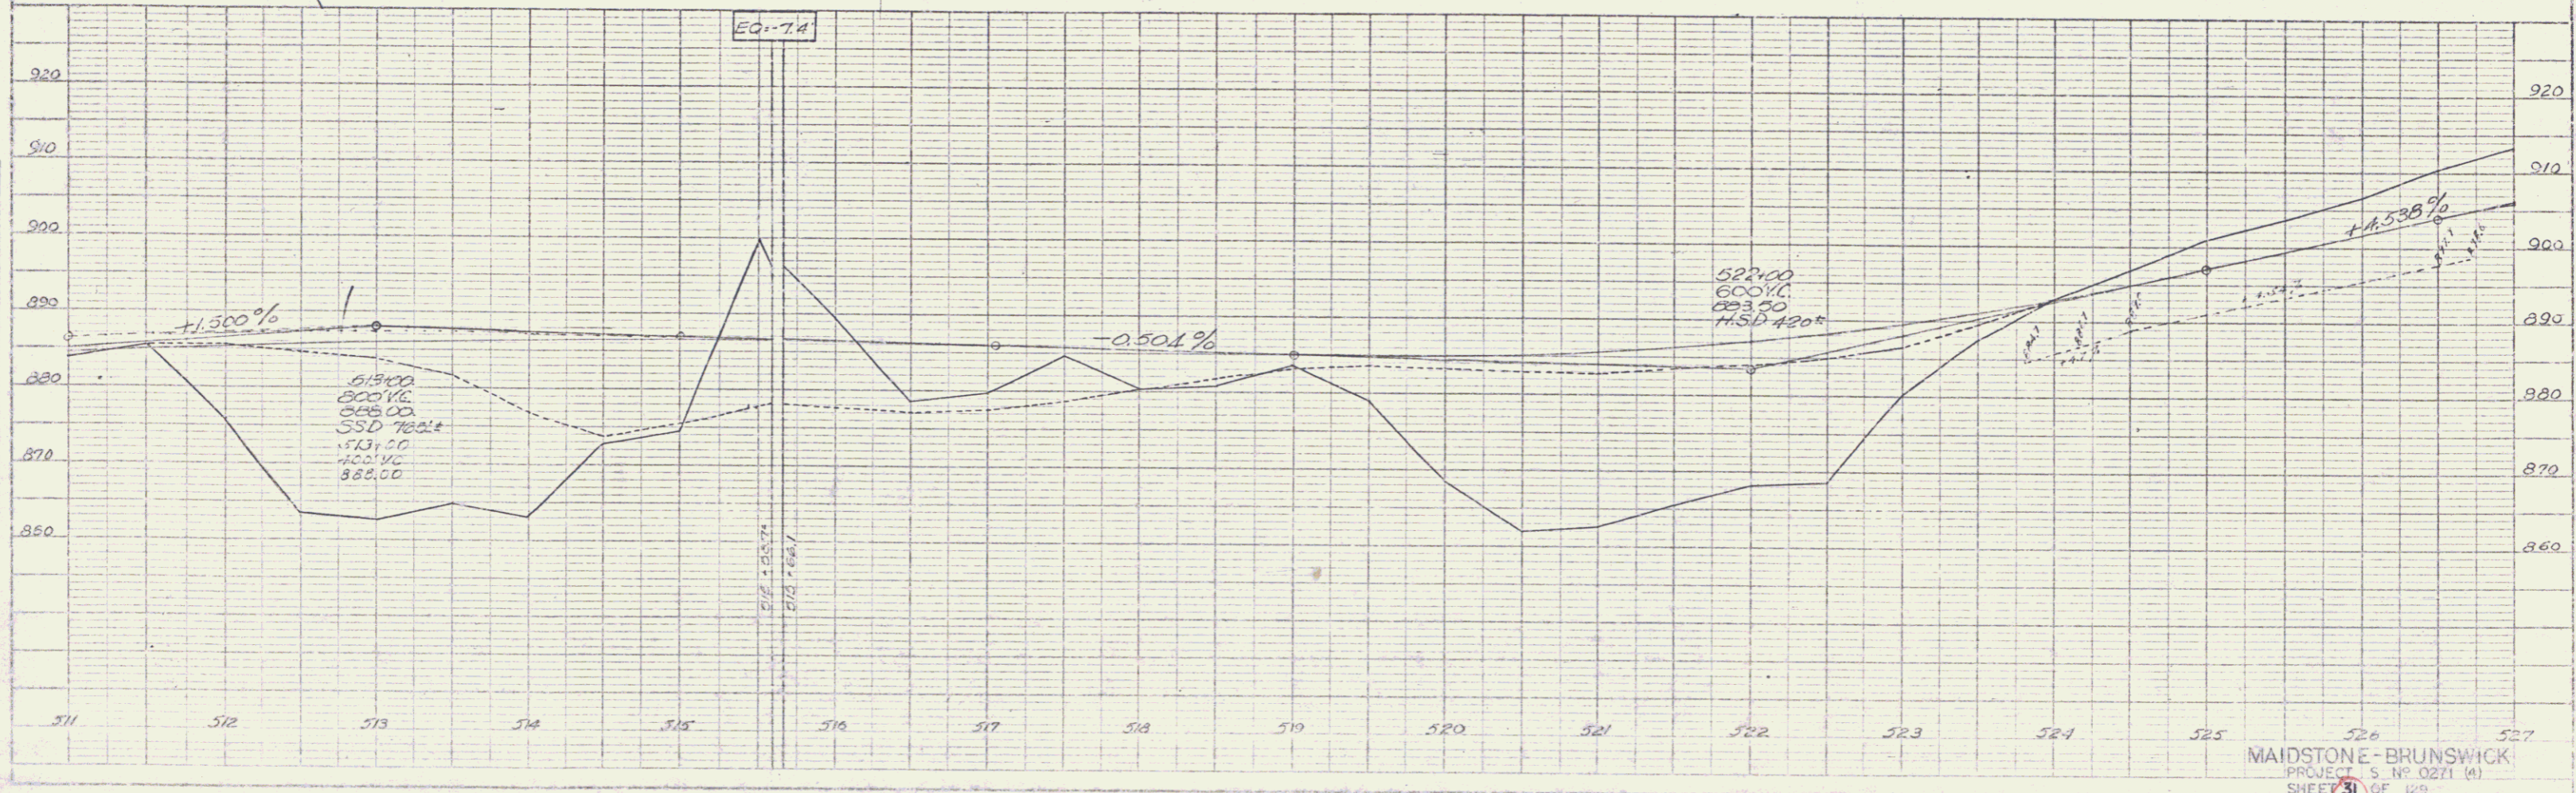

MAIDSTONE-BRUNSWICK
PROJECT 5, NO. 0271 (A)
SHEET 31 OF 129