


CONSTRUCT DRIVE
 L.P. 528+00
 528+25
 530+00
 532+20

TWO CABLE GUARD RAIL
 L.P. 531+75-533+75
 532+30-534+30
 531+40-532+28

WOOD GUIDE POSTS
 532+00 ON R.H.


GRANT H. & EURIELLE R. MASON

PLAN
 DATE
 DRAWN BY
 CHECKED BY
 SCALE
 SHEET NO.

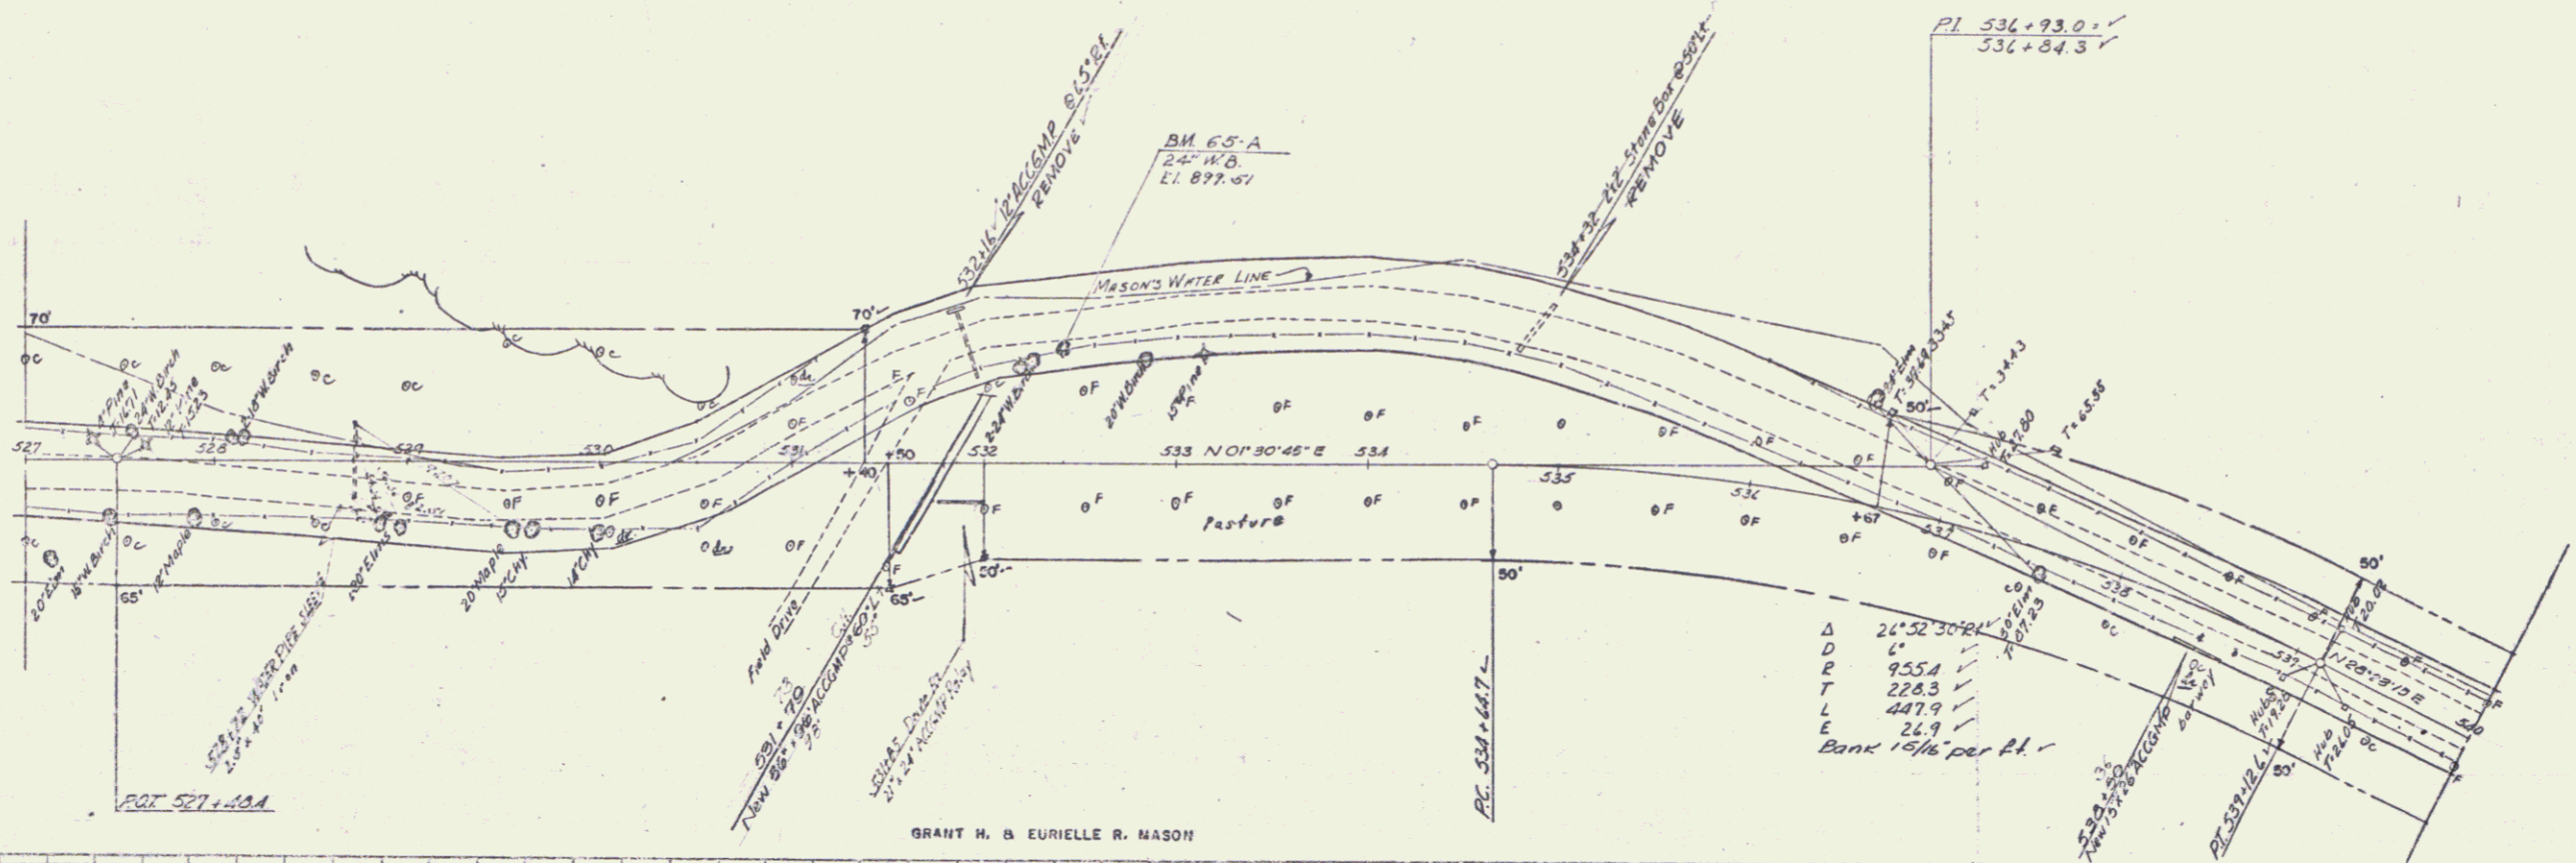

GRANT H. & EURIELLE R. MASON

PROFILE
 DATE
 DRAWN BY
 CHECKED BY
 SCALE
 SHEET NO.

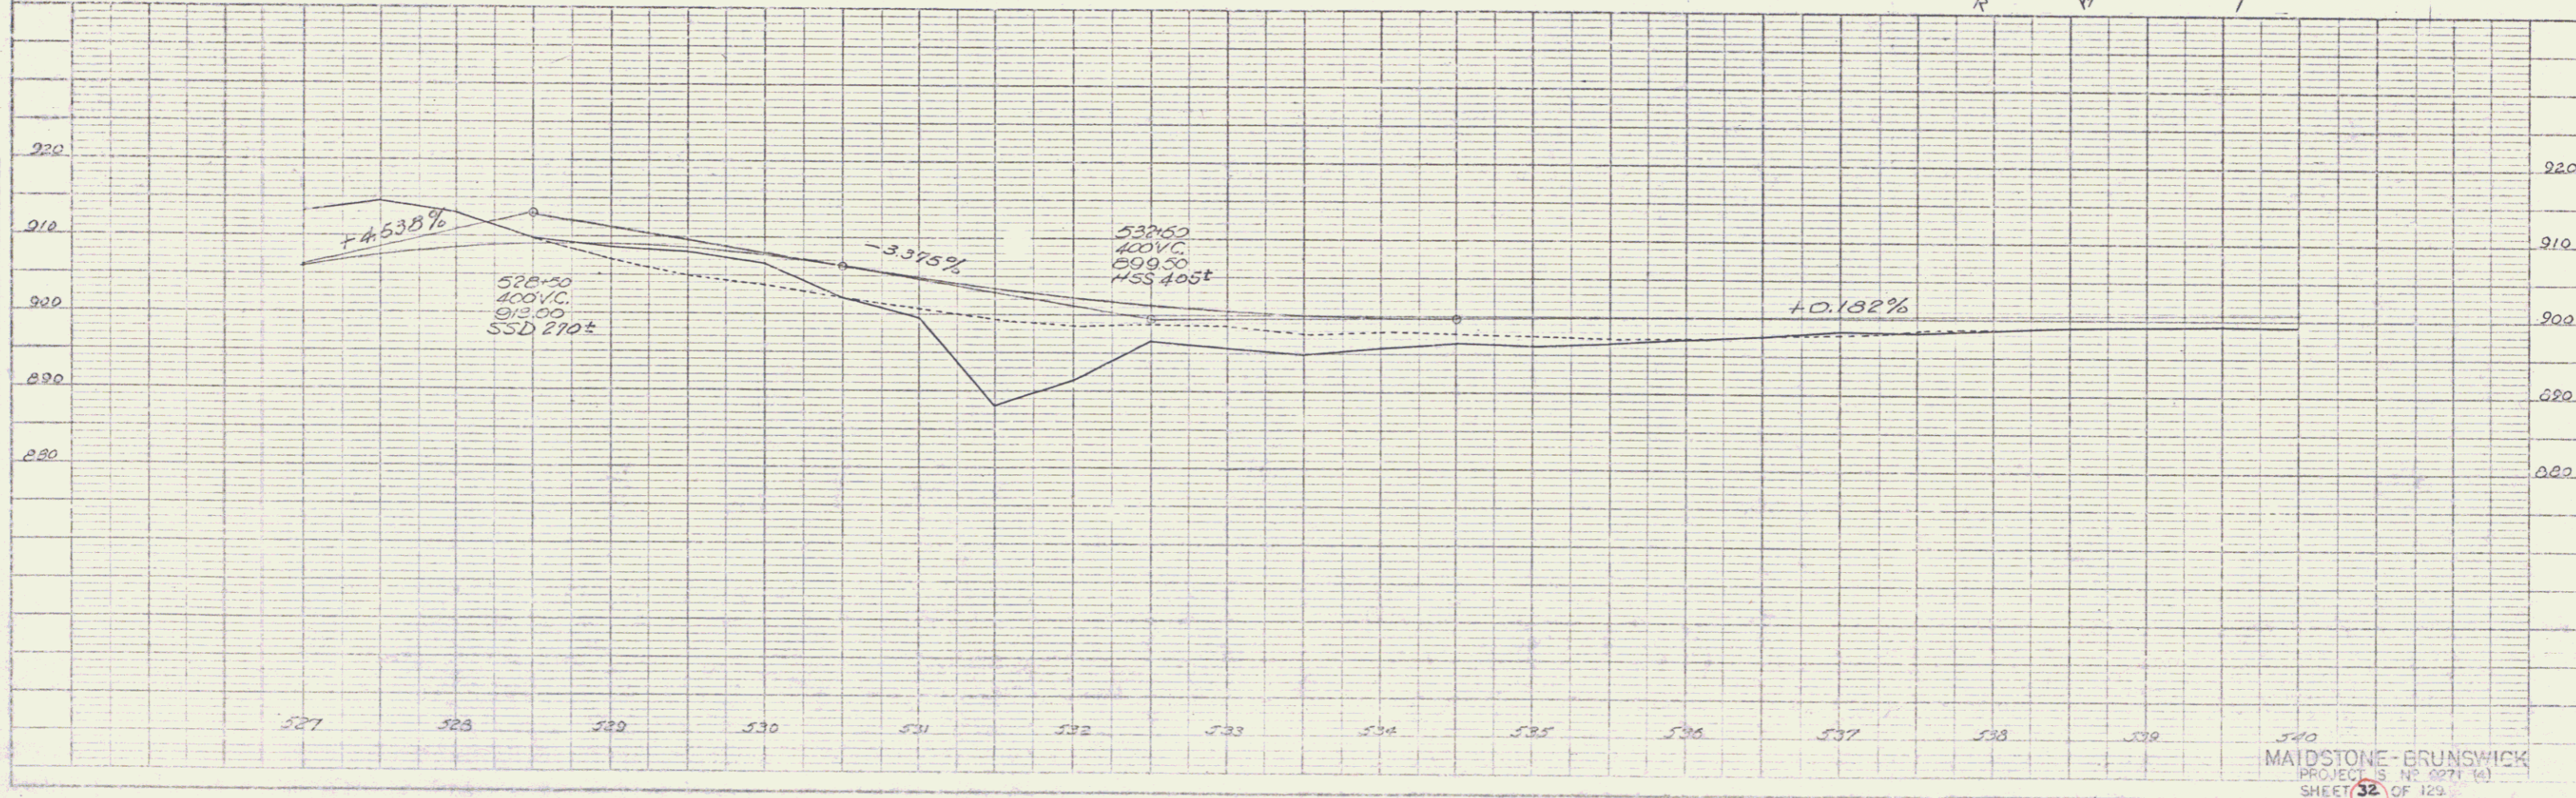

MAIDSTONE - BRUNSWICK
 PROJECT NO. 2271 (A)
 SHEET 32 OF 129