


| STATE | LEGAL SHEET | TOTAL SHEETS |
|-------|-------------|--------------|
| MD | 231M | 2 |

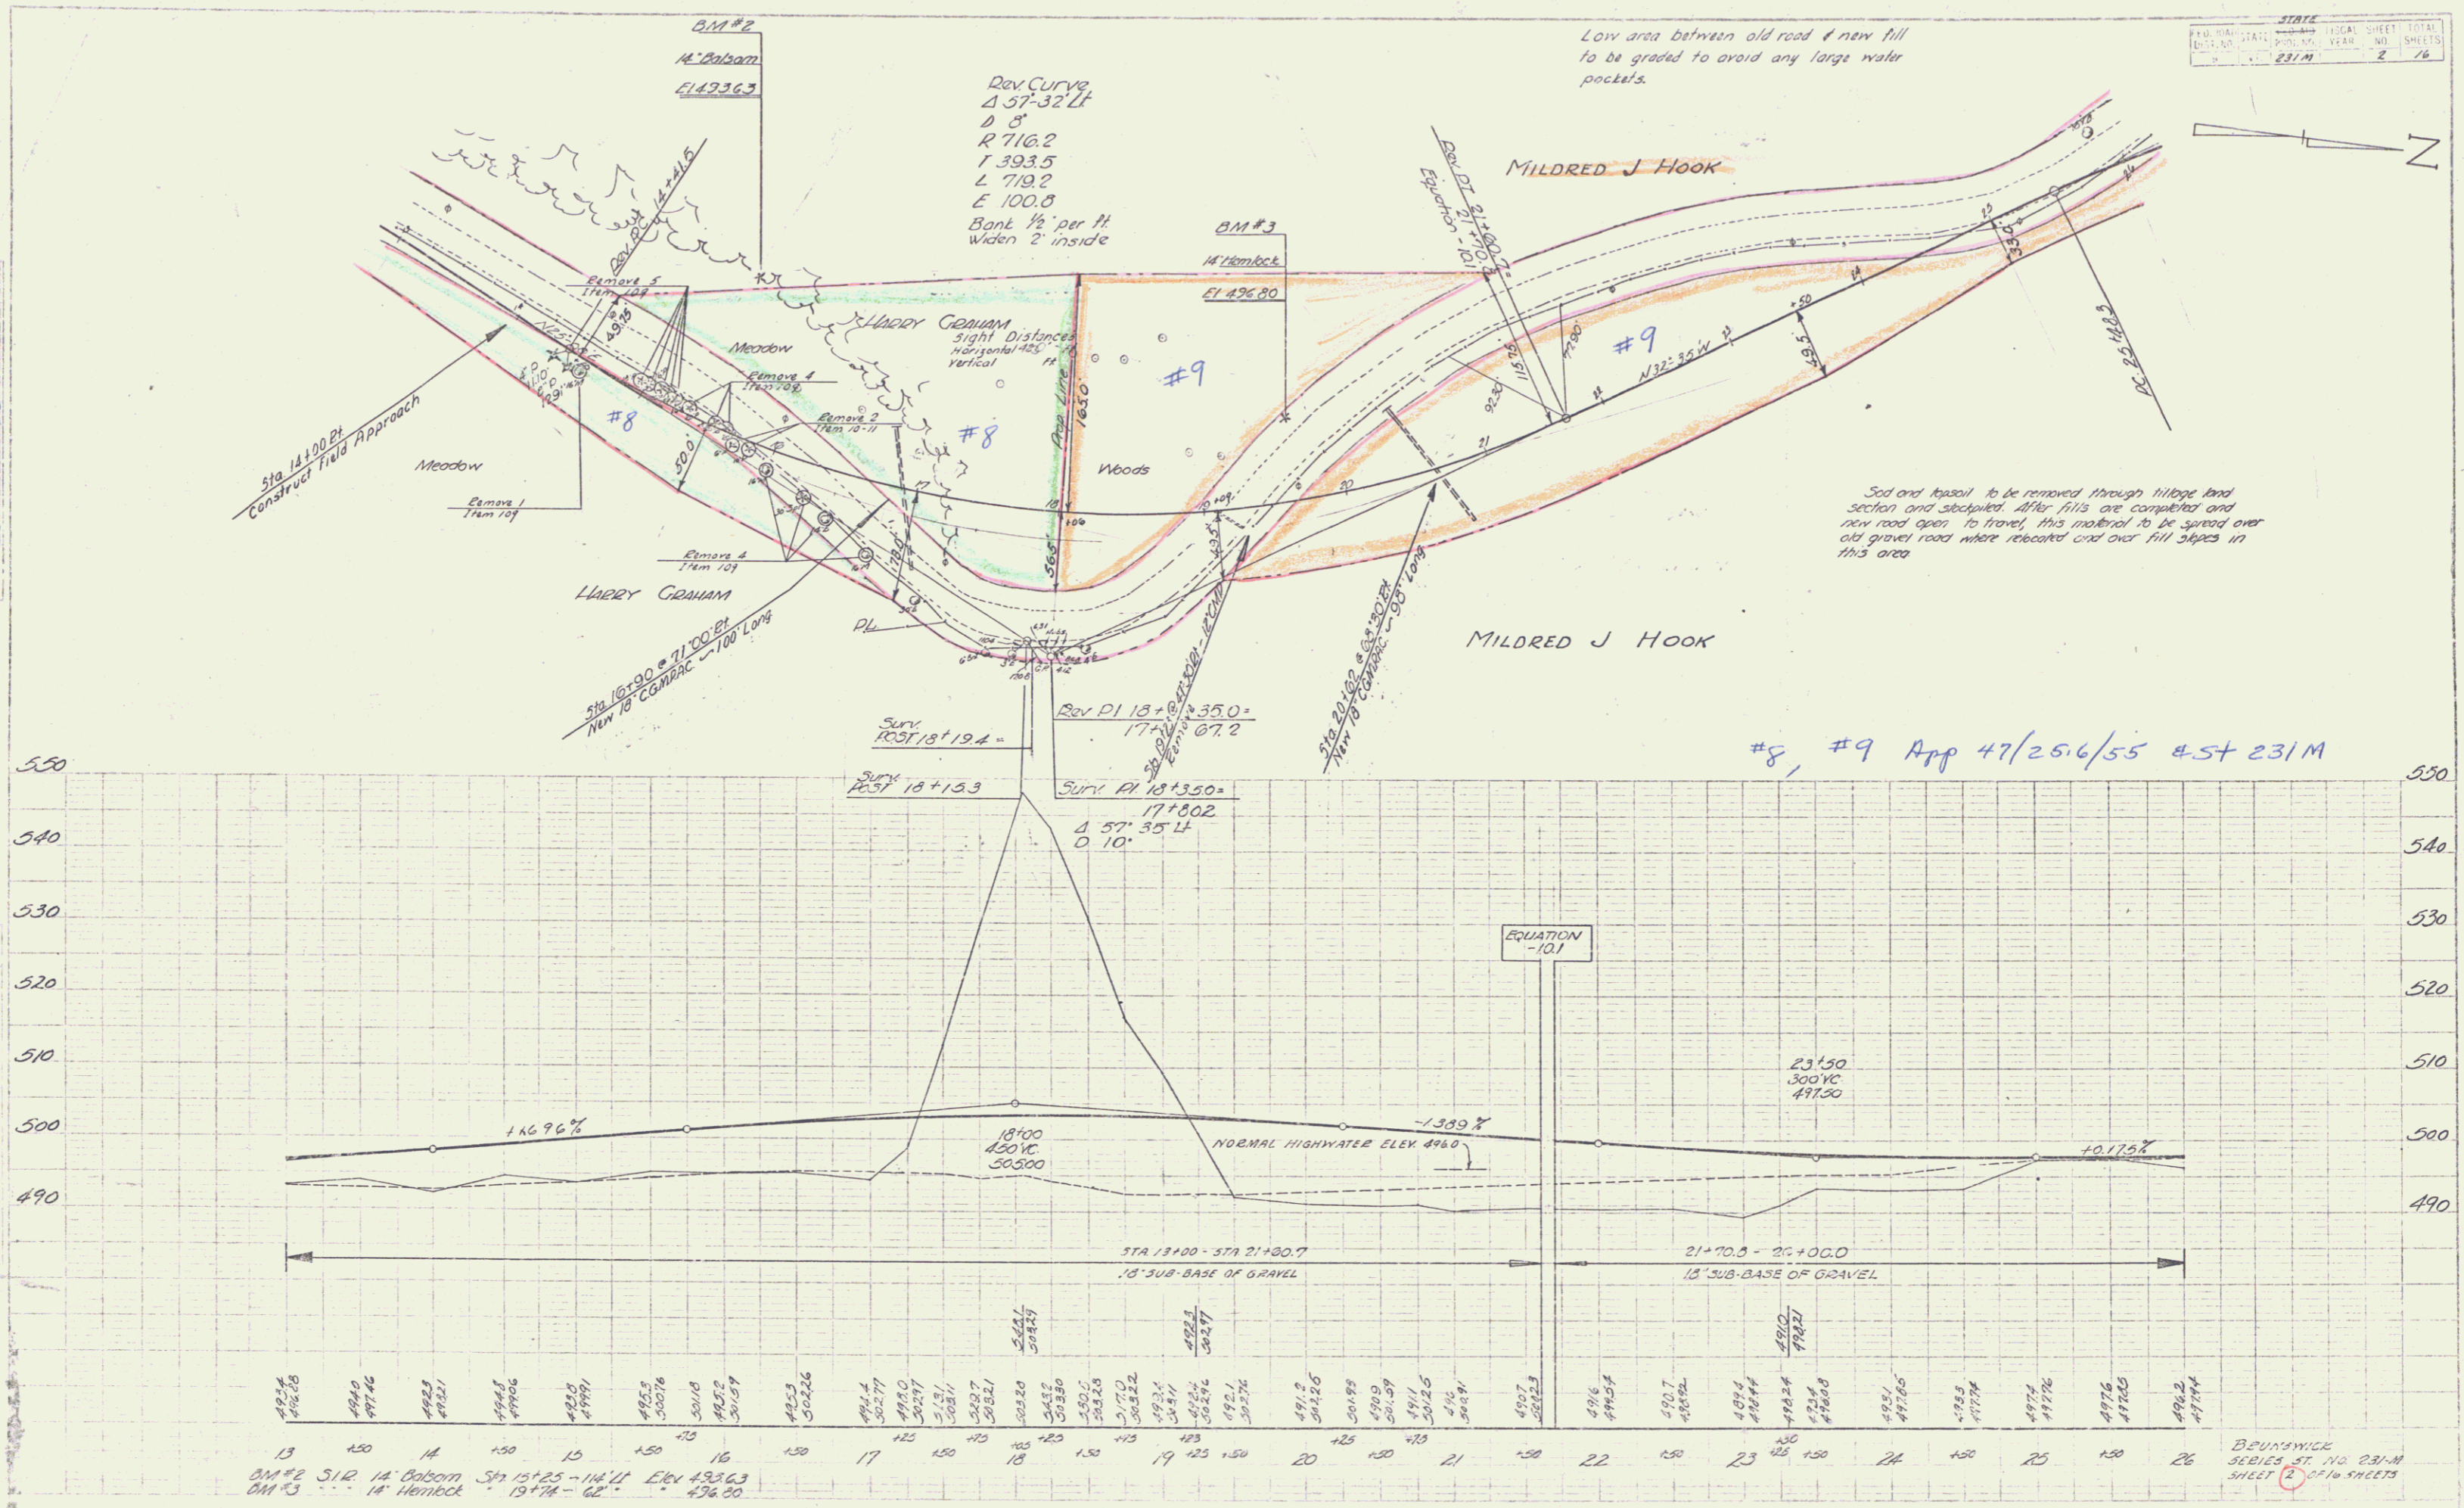

PLAN
Scale: 1" = 40'
Date: 10-40

PROFILE
Scale: 1" = 10'
Date: 10-40

Low area between old road & new fill to be graded to avoid any large water pockets.

Sod and topsoil to be removed through village land section and stockpiled. After fills are completed and new road open to travel, this material to be spread over old gravel road where relocated and over fill slopes in this area.

#8, #9 App 47/25.6/55 4.5+ 231M

BM #2 SIR 14 Balsam Sta 10+25 - 14+11 Elev 493.63
BM #3 14 Hemlock Sta 19+74 - 62 Elev 476.80

BEVANSWICK SERIES ST. NO. 231-M SHEET 2 OF 16 SHEETS