


STATE			
FEDERAL STATE	FISCAL YEAR	SHEET NO.	TOTAL SHEETS
9	VI	231M	3 16

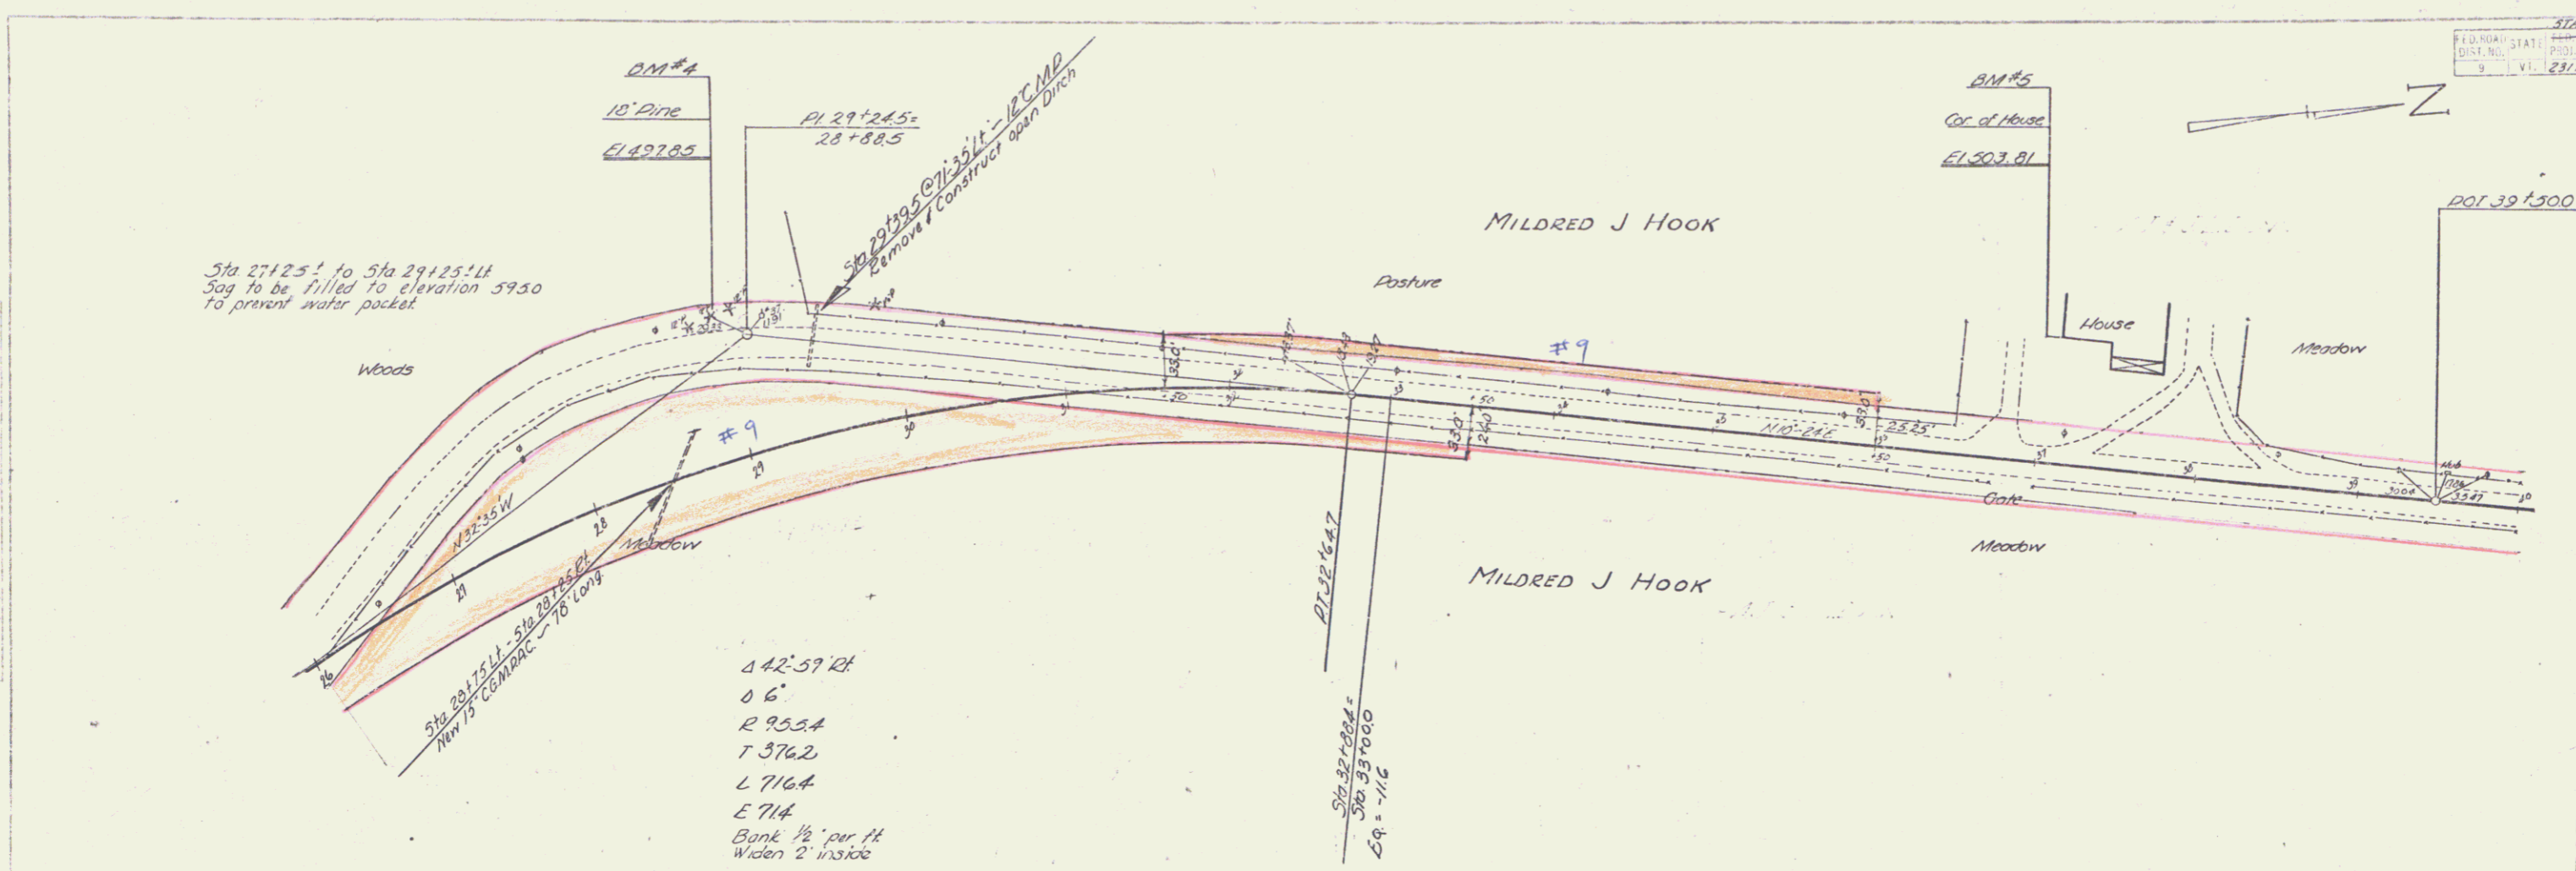

10 46
10 46
10 46
L LOUIN

10 46
10 46
10 46
L LOUIN