
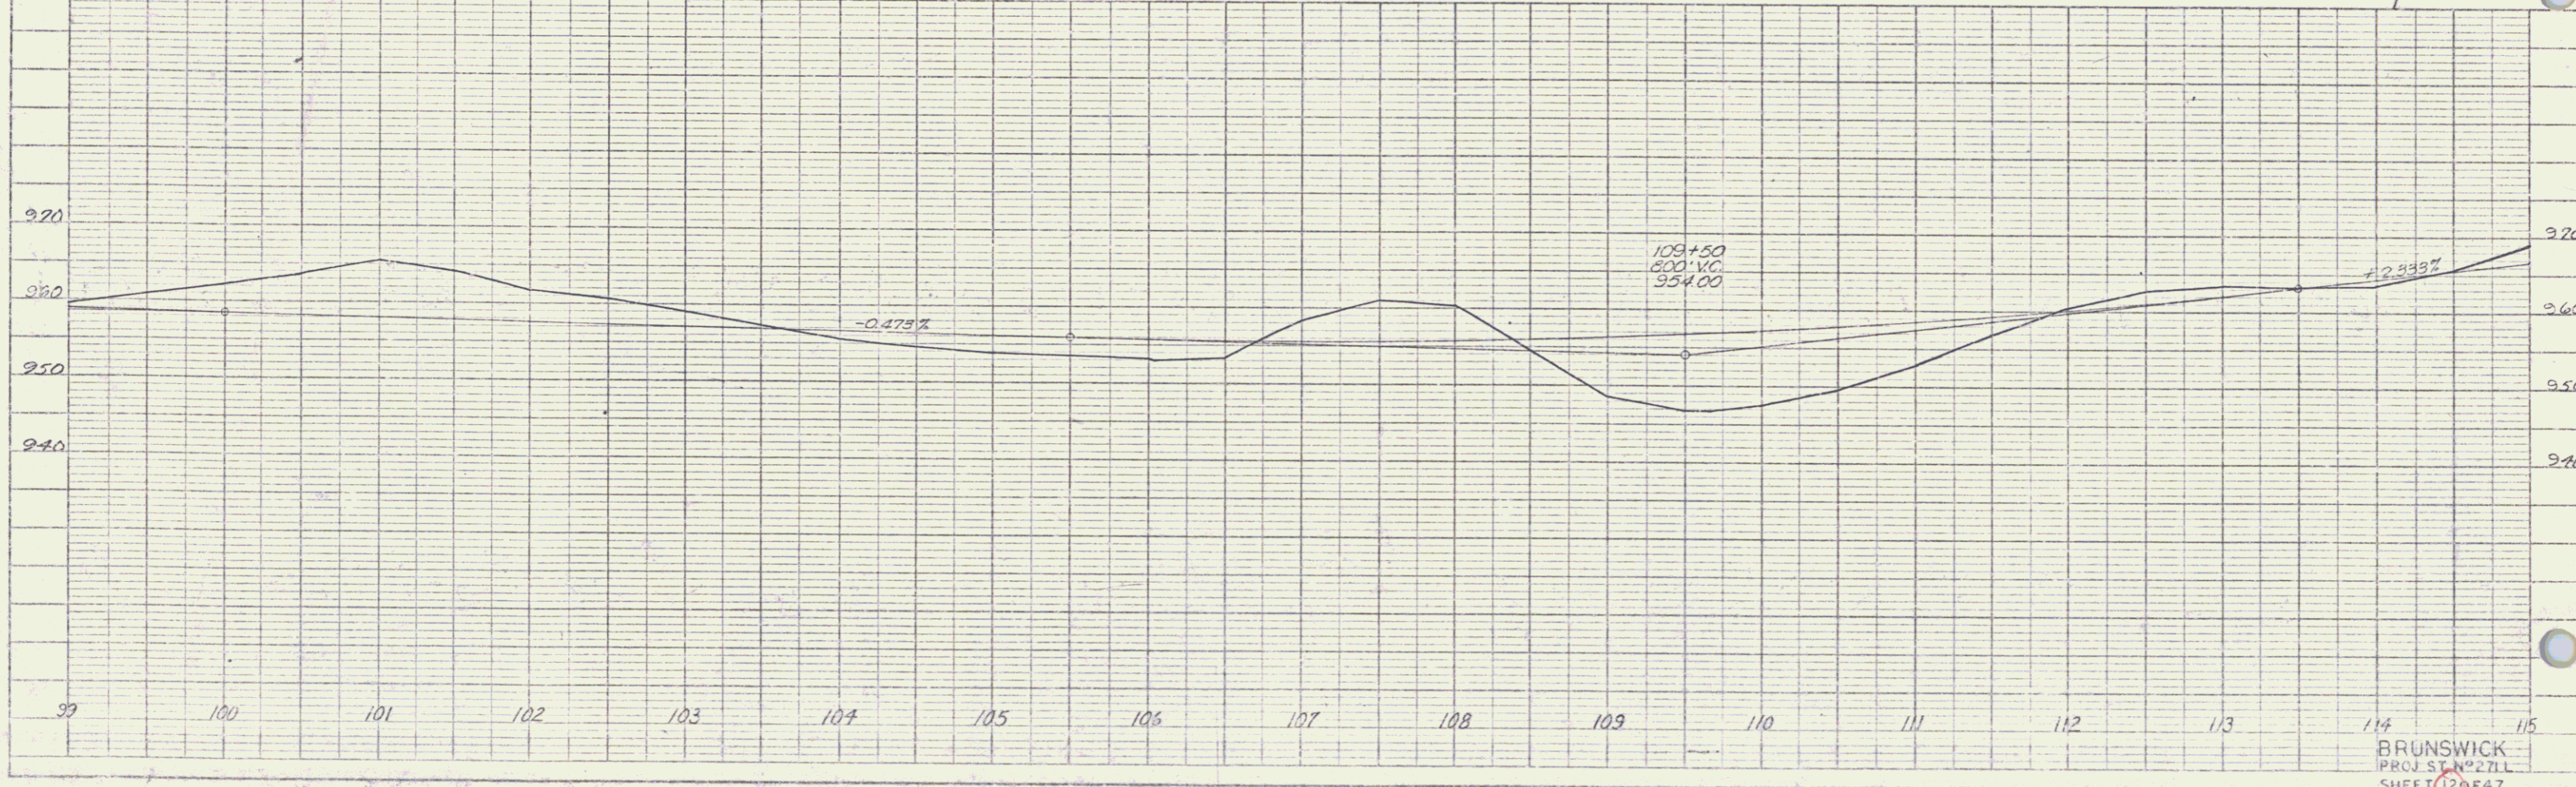


TWO CABLE GAUARD RAIL  
 LT  
 79+25-108+77 109+25-110+29  
 108+75-110+27

CONSTRUCT DRIVE  
 LT  
 111+00

DATE	BY	REVISION
1/27/20	PL/AVD	REVISED
1/27/20	PL/AVD	REVISED
1/27/20	PL/AVD	REVISED
1/27/20	PL/AVD	REVISED

DATE	BY	REVISION
1/27/20	PL/AVD	REVISED
1/27/20	PL/AVD	REVISED
1/27/20	PL/AVD	REVISED
1/27/20	PL/AVD	REVISED

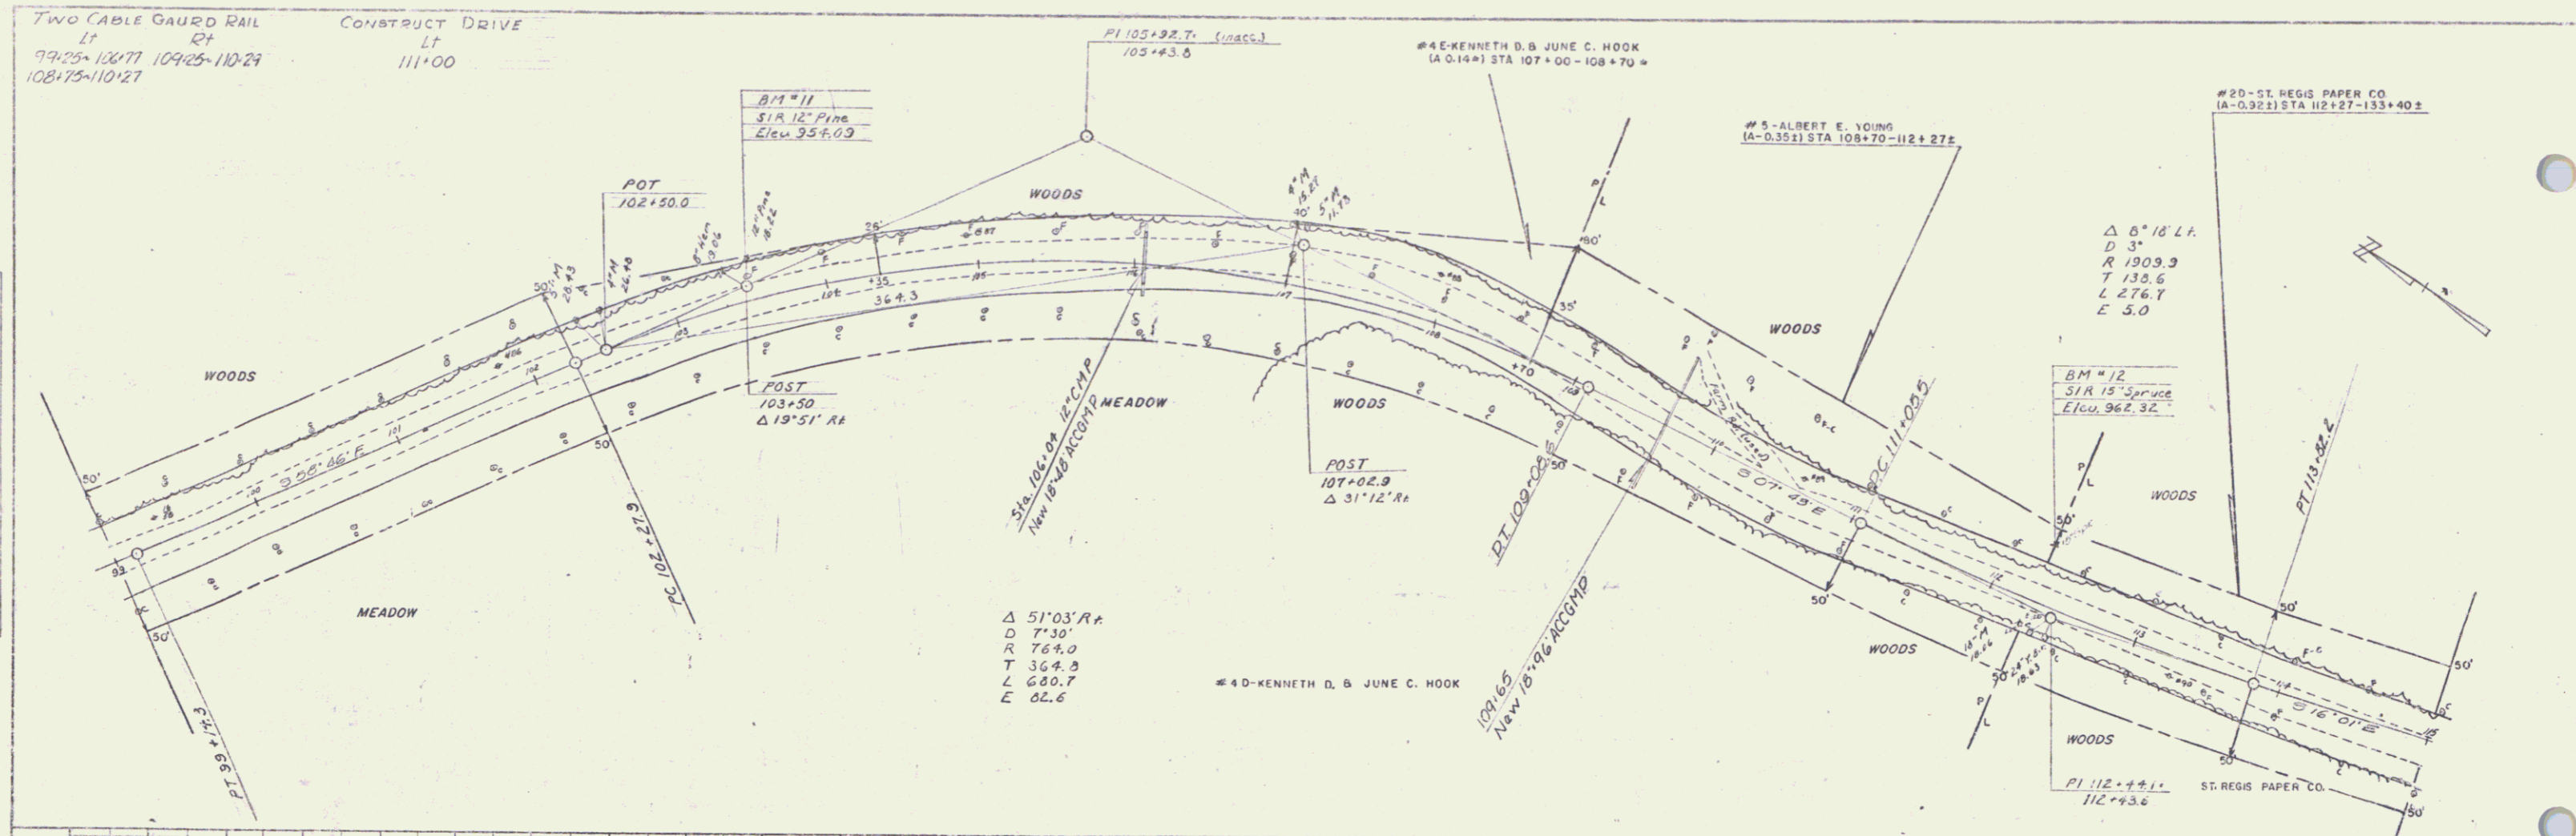

BRUNSWICK  
 PROJ. ST. 271L  
 SHEET 120E47

7