


RESIDENT ENGINEER - FRANK B. GAMSBY
 INSPECTORS - J. MARTIN, R. MICHAEL
 RECORD PLANS - D. BARTLETT & A. SPIDLE

STARTED-AUGUST 17, 1960
 COMPLETED-JUNE 14, 1961
 ACCEPTED-JUNE 14, 1961

66+00.0 68+00.0
 END PROJECT BEGIN PROJECT
 ST 161 (N) S-0271 (3)

MP 1.44%

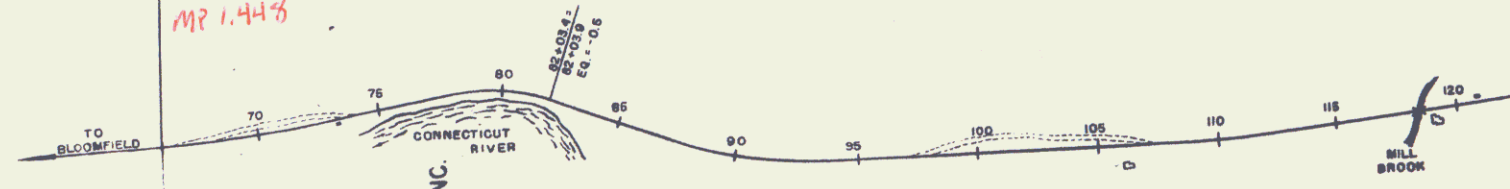

CONCRETE PAVEMENT

MADE BY SAND & GRAVEL CO. INC.
 ST. JOHNSBURY, VT.
 YEAR 1960-61
 POINT approximately 1.3 miles north of the junction of Rte 104 and extending northeasterly.

SAND & GRAVEL CO. INC.
 ST. JOHNSBURY, VT.
 D. BARTLETT & A. SPIDLE
 COMPLETED - JUNE 14, 1961

GROUND ELEVATION	DATUM	LINE
GRADE ELEVATION	DATUM	LINE
CURVE DATA		
DEFLECTION OF ANGLE	A	
DEGREE OF CURVE	D	

TITLE

SCALES

1" = 400'