
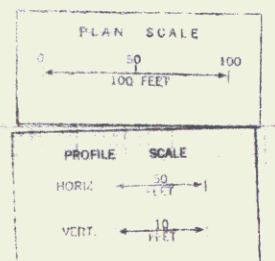
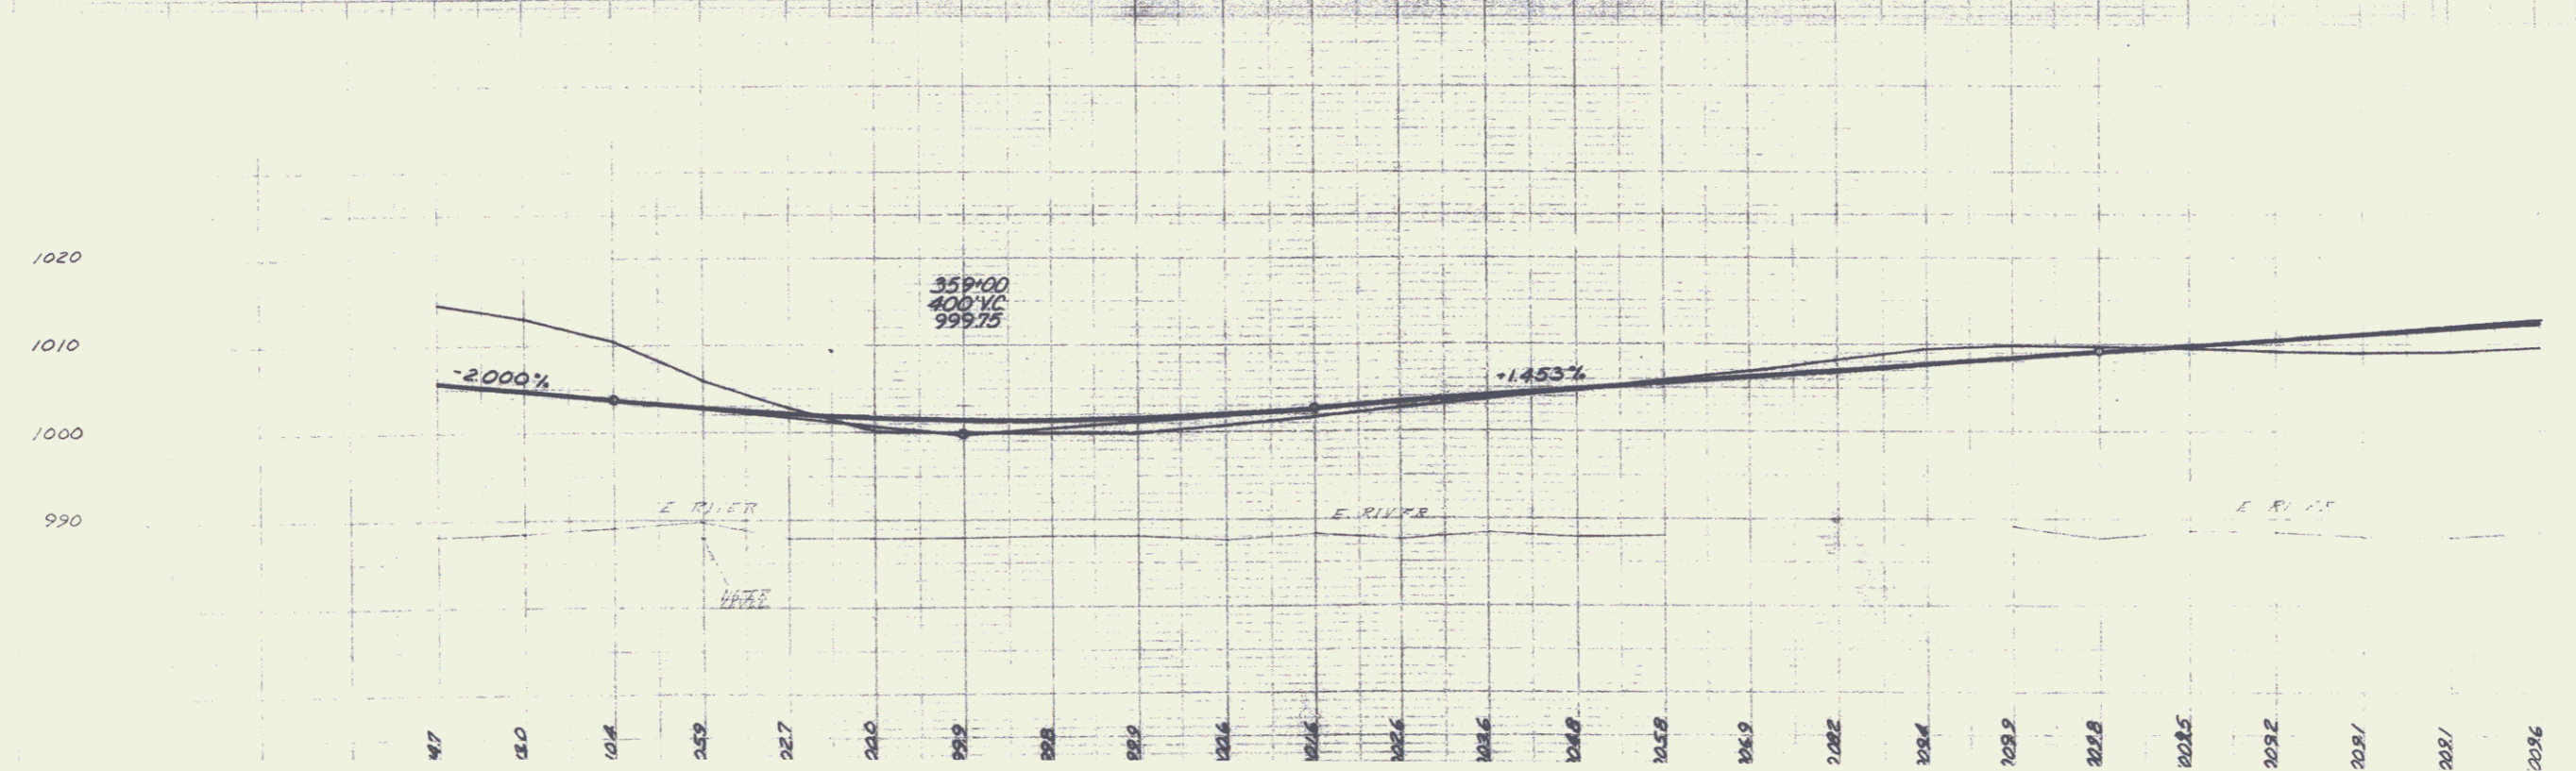


7-45
2-43
3-43
Willson
Woodbury
Sain
Prepared by

7-45
5-43
Gordon
Woodbury

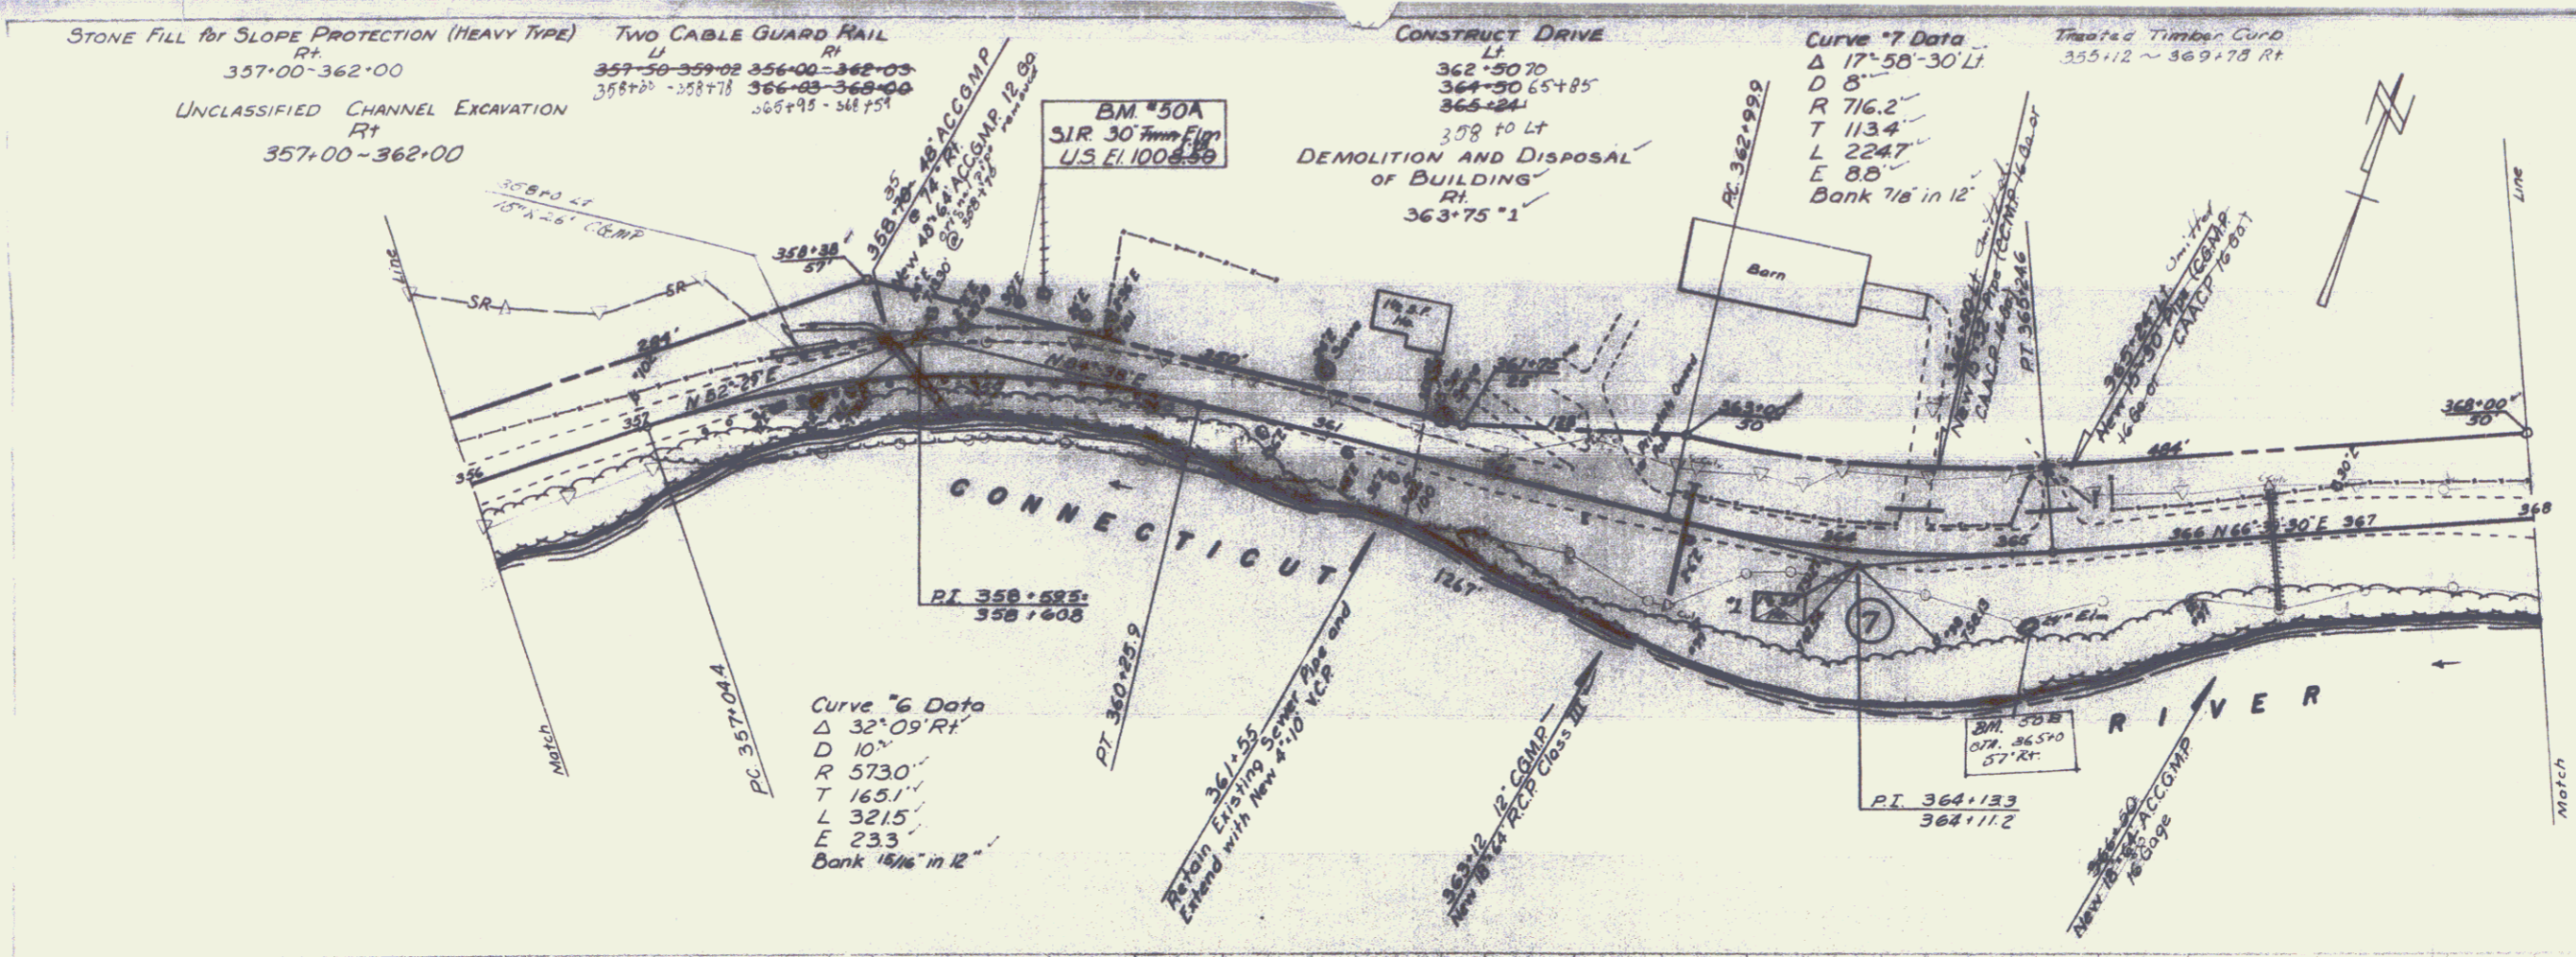

SHEET 6
6