

Lemington 48

INDEX OF SHEETS

SHEET NO.	TITLE PAGE
1	TYPICAL CROSS-SECTION OF IMPROVEMENT (Double Tack Coat of Refined Tar With Pea Stone Seal, Item 29A)
2	BANKING AND WIDENING TABLES
3-5	PLAN AND PROFILE
7	STANDARD STRUCTURE BRIDGE SLAB 30"
8	" " " " SS B2
9	" " " " SB 5C1
10	" " " " SB 2 Detail S 206
11	" " " " SB 20
12	" " " " ROAD S 28 Pipe Culverts
13	" " " " S 30 Guard Rail
14	" " " " S 30A Markers
15	" " " " S 40 Barricades, Signs & Lights
16-22	CROSS SECTIONS

STANDARD STRUCTURE SHEETS APPROVED BY THE CHIEF ENGINEER
 VT. STATE DEPARTMENT OF HIGHWAYS
 S 28 APRIL 25, 1941
 S 30 NOV. 10, 1941
 S 30A APRIL 19, 1941
 S 40 DEC. 18, 1945

**STATE OF VERMONT
 STATE HIGHWAY DEPARTMENT**

**PLAN AND PROFILE OF PROPOSED
 STATE HIGHWAY**

SECONDARY PROJECT

**TOWN OF LEMINGTON
 VERMONT ROUTE 102**



GUILDHALL - CANAAN ROAD

BEGINNING AT A POINT APPROXIMATELY 535 FEET
 SOUTHERLY FROM THE MILL BROOK BRIDGE AND EXTEND-
 ING NORTHERLY 300 FEET.

LENGTH OF PROJECT 300.0 FEET = 0.170 MILE

FED. ROAD DIST. NO.	STATE	FISCAL YEAR	SHEET NO.	TOTAL SHEETS
9	VT.	5161(2)	1	22

POST WAR F A SEC

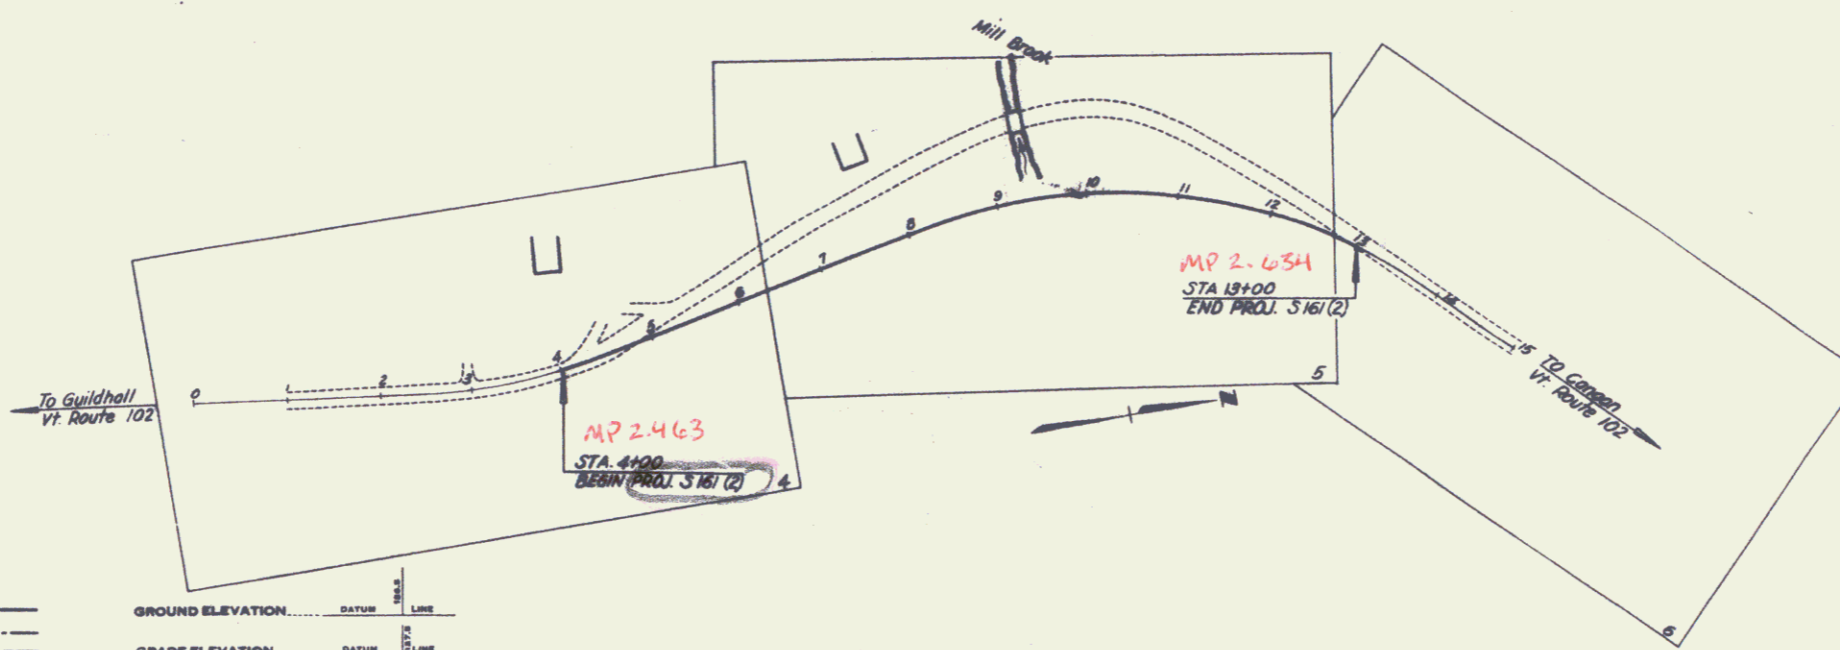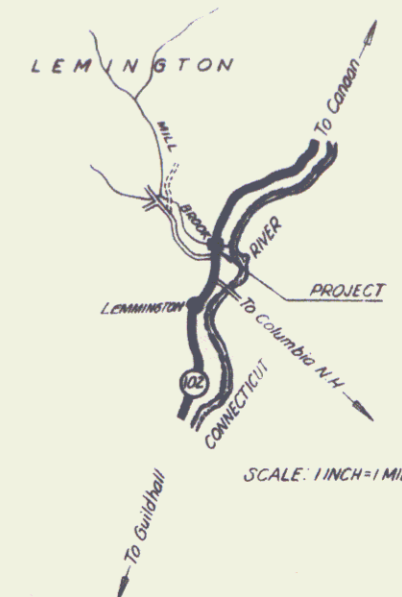

GROUND ELEVATION... DATUM... LINE
 GRADE ELEVATION... DATUM... LINE

CURVE DATA
 DEFLECTION ANGLE... Δ
 DEGREE OF CURVE... D
 RADIUS OF CURVE... R

SCALES
 TITLE 1" = 100'
 TYPICAL 1" = 2"
 PLAN 1" = 50'

Project 5161(2)
 Pin # 00R102

APPROVED: 21 May 48

COMMISSIONER OF HIGHWAYS
 SUBMITTED BY ORDER OF THE STATE HIGHWAY BOARD

RECOMMENDED FOR APPROVAL
 SHEET 1

THESE PLANS ARE SUBJECT TO SUCH REVISIONS AS MAY BE
 REQUIRED BY THE PUBLIC ROADS ADMINISTRATION OR THE COM-
 MISSIONER OF HIGHWAYS.
 CONSTRUCTION IS TO BE CARRIED ON IN ACCORDANCE WITH
 THE PLANS AND THE STANDARD ROAD AND BRIDGE SPECIFICATIONS
 OF 1938, AS APPROVED DECEMBER 29TH, 1938 BY THE PUBLIC