

WOOD GUARD RAIL REQUIRED


CULV. STA.	LT.	RT.
3+22	24 ft.	24 ft.
8+69	-	24 ft.
7+50	-	24 ft.

CABLE GUARD RAIL REQUIRED

STATIONS	L-R	LEN. CHVT.	PIV. LEN.
8+02-7+62	LT	40	200 ft.
8+20-9+00	LT	80	120 "
12+50-13+00	LT	50	70 "

REINFORCED CONCRETE PIPE REQUIRED


STATION	DIAM.	LEN.	CURBLY RIBBLE
3+22	18"	52 ft.	3.5 c.y.
8+69	24"	44 ft.	4.5 "
7+50	15"	36 ft.	2.7 "

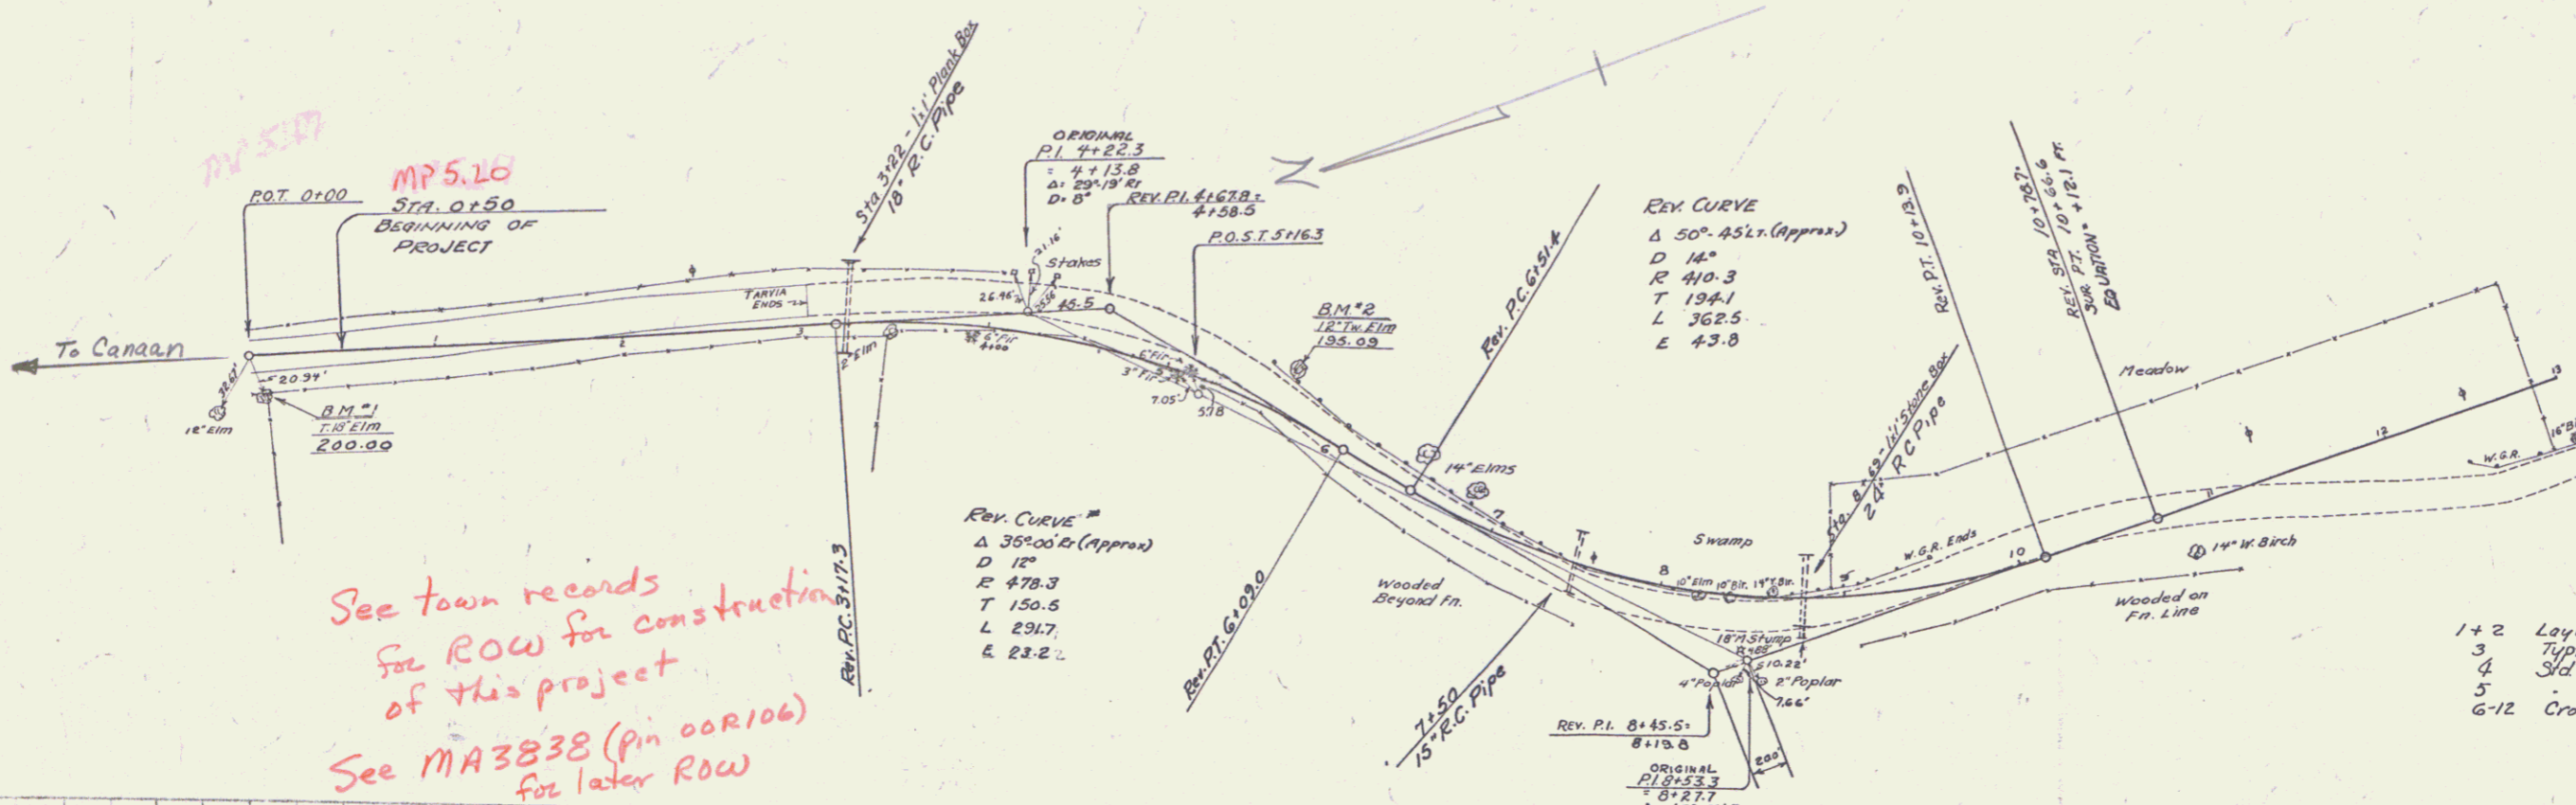

See town records for ROW for construction of this project
See MA 3838 (pin 00R106) for later ROW

INDEX OF SHEETS

1+2	Layouts + Profile
3	Typical Section (21" Gravel)
4	Std Structure Sheet 3-20
5	Pipe Culvert
6-12	Cross Sections
3-22	Guard Rail

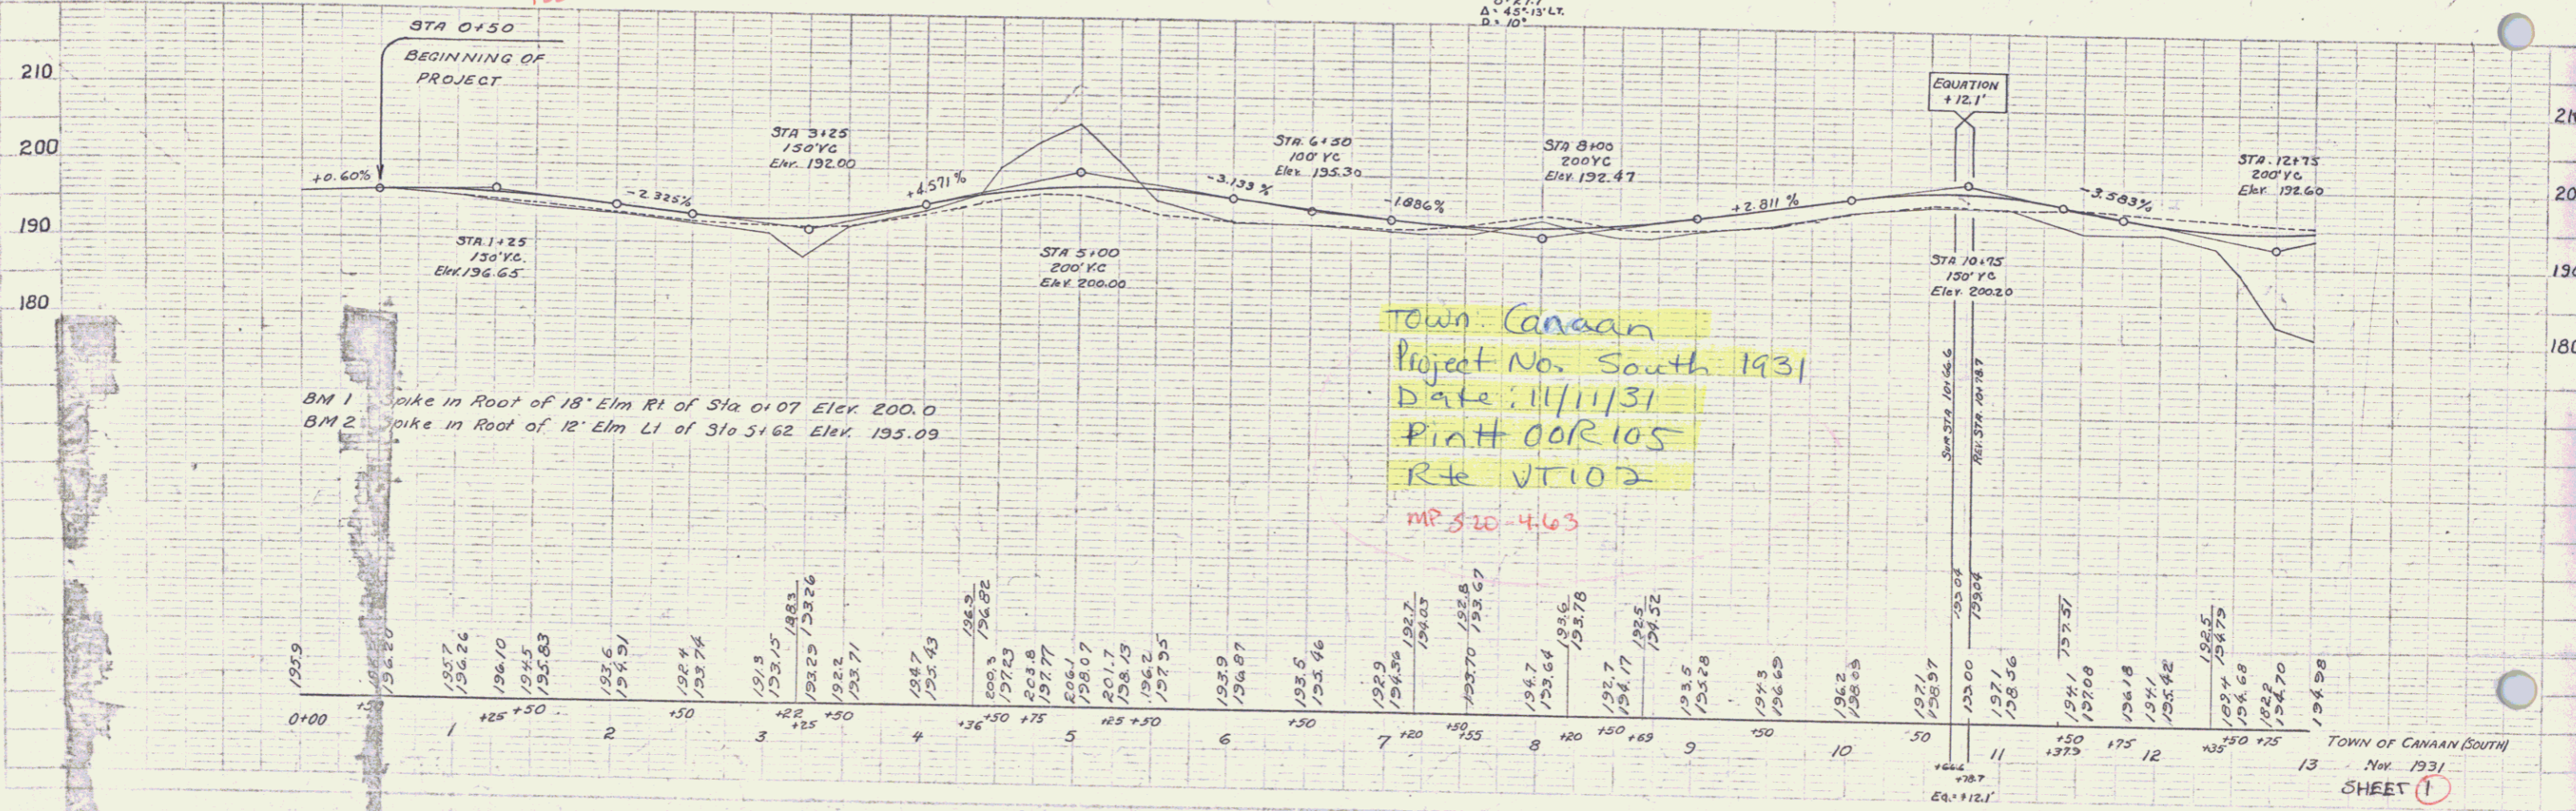

Town Canaan
Project No. South 1931
Date: 11/11/31
Pin # 00R105
Rte VT 102
MP 5.20-4.63

DIST # 9 PLANS

SHEET 1

