

MARtha L. VANDERWOLK TO St. OF VT BY WD ON 11/21/77
IN BK 27/446




PARCEL IA 0.26 A±
BEG. STA. 'TRAV. LINE' 2+80 LT. — END STA. 'TRAV. LINE' 8+20 LT.

PARCEL IB 0.07 A±
BEG. STA. 'TRAV. LINE' 9+00 LT. — END STA. 'TRAV. LINE' 8+20 LT.

MP 0478

ECCOMUNITY, INC. OPTION TO St. OF VT ON 10/7/77
IN BK 27/503-04

PARCEL 2 0.14 A±
BEG. STA. 'TRAV. LINE' 10+63 LT. — END STA. 'TRAV. LINE' 12+77 LT.

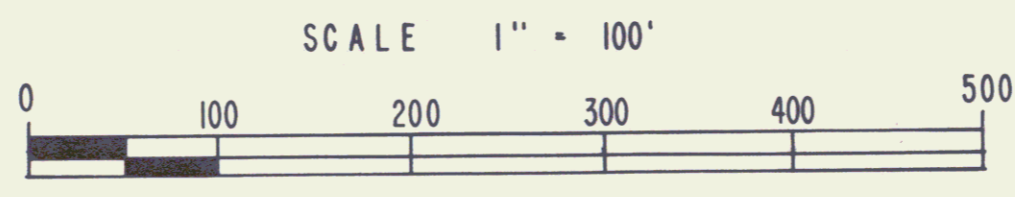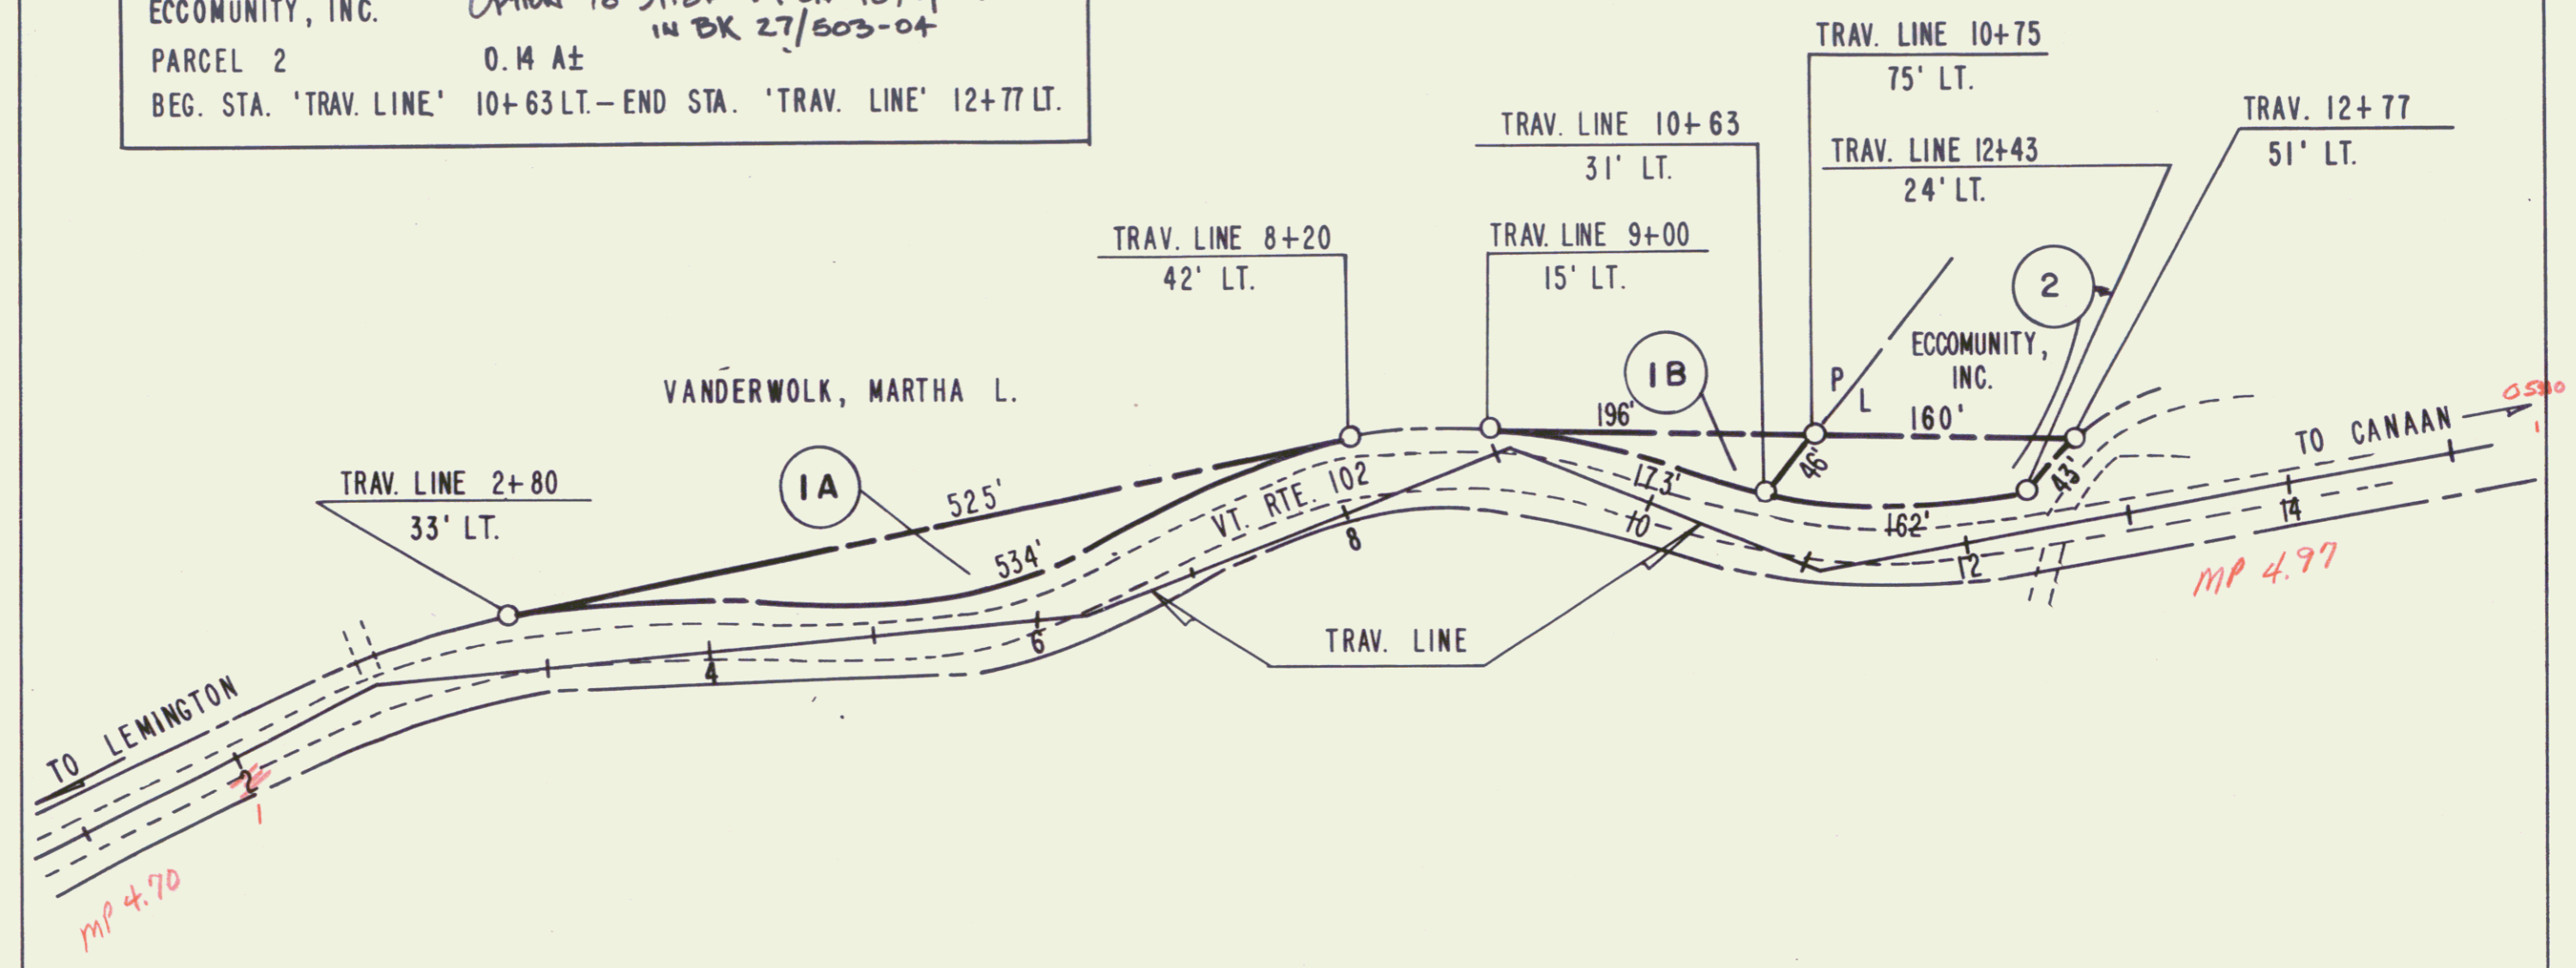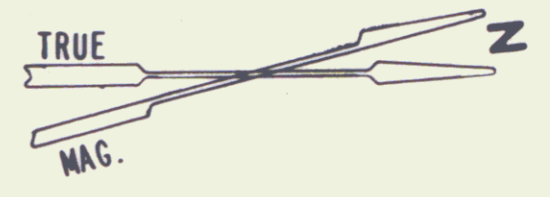

STATE OF VERMONT DEPT. OF HIGHWAYS	
SHEET 1A	
TOWN OF CANAAN	
PROJECT CANAAN	Project 2
APPROX. SCALE 1" = 100'	DATE 11-7-77
DRAWN BY KDP	