


TWO CABLE GUARD RAIL  
 U. RI  
 12+64-13+14 11+44-13+14  
 13+55-14+00 13+55-14+00

Curve Data  
 Δ 11° 46' 18"  
 D 31° 30'  
 P 1637.29  
 T 168.7  
 L 336.2  
 E 8.7

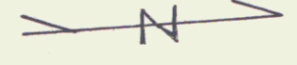

STA 12+00.0  
 BEGIN PROJECT  
 S161(3)

ADRIEN MAURAU  
 Woods

STATE OF VERMONT  
 FISH & GAME DEPT.

Abut #1 Sta 13+14.4  
 Pinned End  
 STOP ROADWAY  
 BEGIN BRIDGE

Sta 13+55-Abutment #2 V  
 Fin Of Elev 436.17 End End  
 END BRIDGE  
 RESUME ROADWAY

STATE OF VERMONT  
 FISH & GAME DEPT.

31A 14+00.0  
 END PROJECT  
 S161(3)

ADRIEN MAURAU

KEYER BROOK

STATE OF VERMONT FISH & GAME DEPT.  
 Meadow

G. MARQUIS

G. MARQUIS  
 Meadow

FISH HATCHERY BRIDGE  
 CANAAN - S161(3)

Sheet 8 of 22