

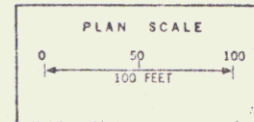
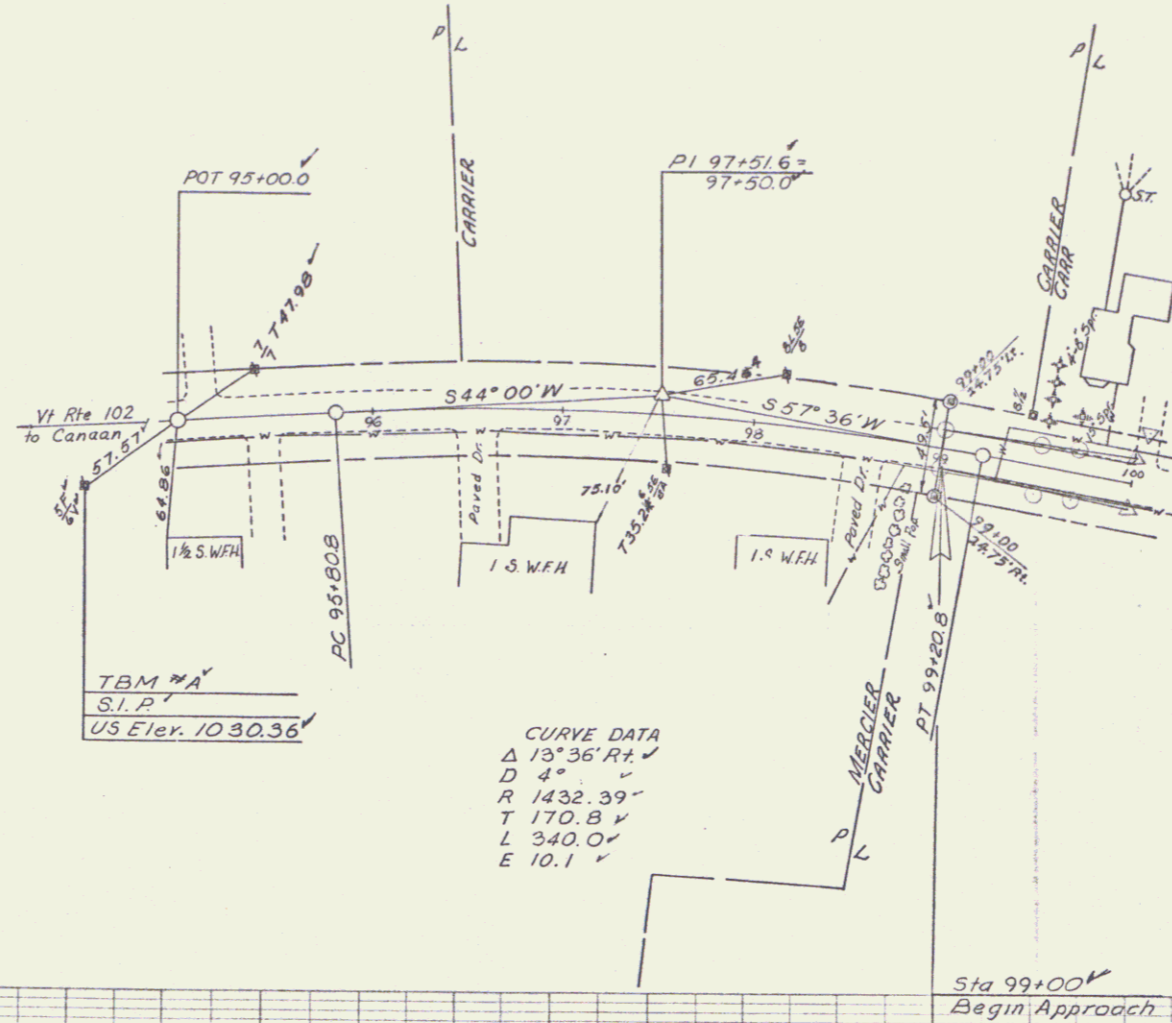


PLAN
 DATE: 02/11/12
 DRAWN BY: S.M.H. / J.W.M.
 CHECKED BY: S.M.H. / J.W.M.
 IN THE FIELD: S.M.H. / J.W.M.
 NO. 103

PROFILE
 DATE: 02/11/12
 DRAWN BY: S.M.H. / J.W.M.
 CHECKED BY: S.M.H. / J.W.M.
 IN THE FIELD: S.M.H. / J.W.M.
 NO. 103

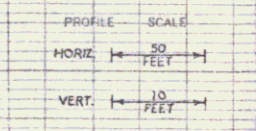

NOTE:
 Drives are to be constructed with a minimum width of 12 feet and a flare radius of at least 20 feet.
 All existing pavement within 2 feet of the subgrade shall be thoroughly scarified and broken up, payment to be included under the bid price of Common Excavation, Item 103-A1

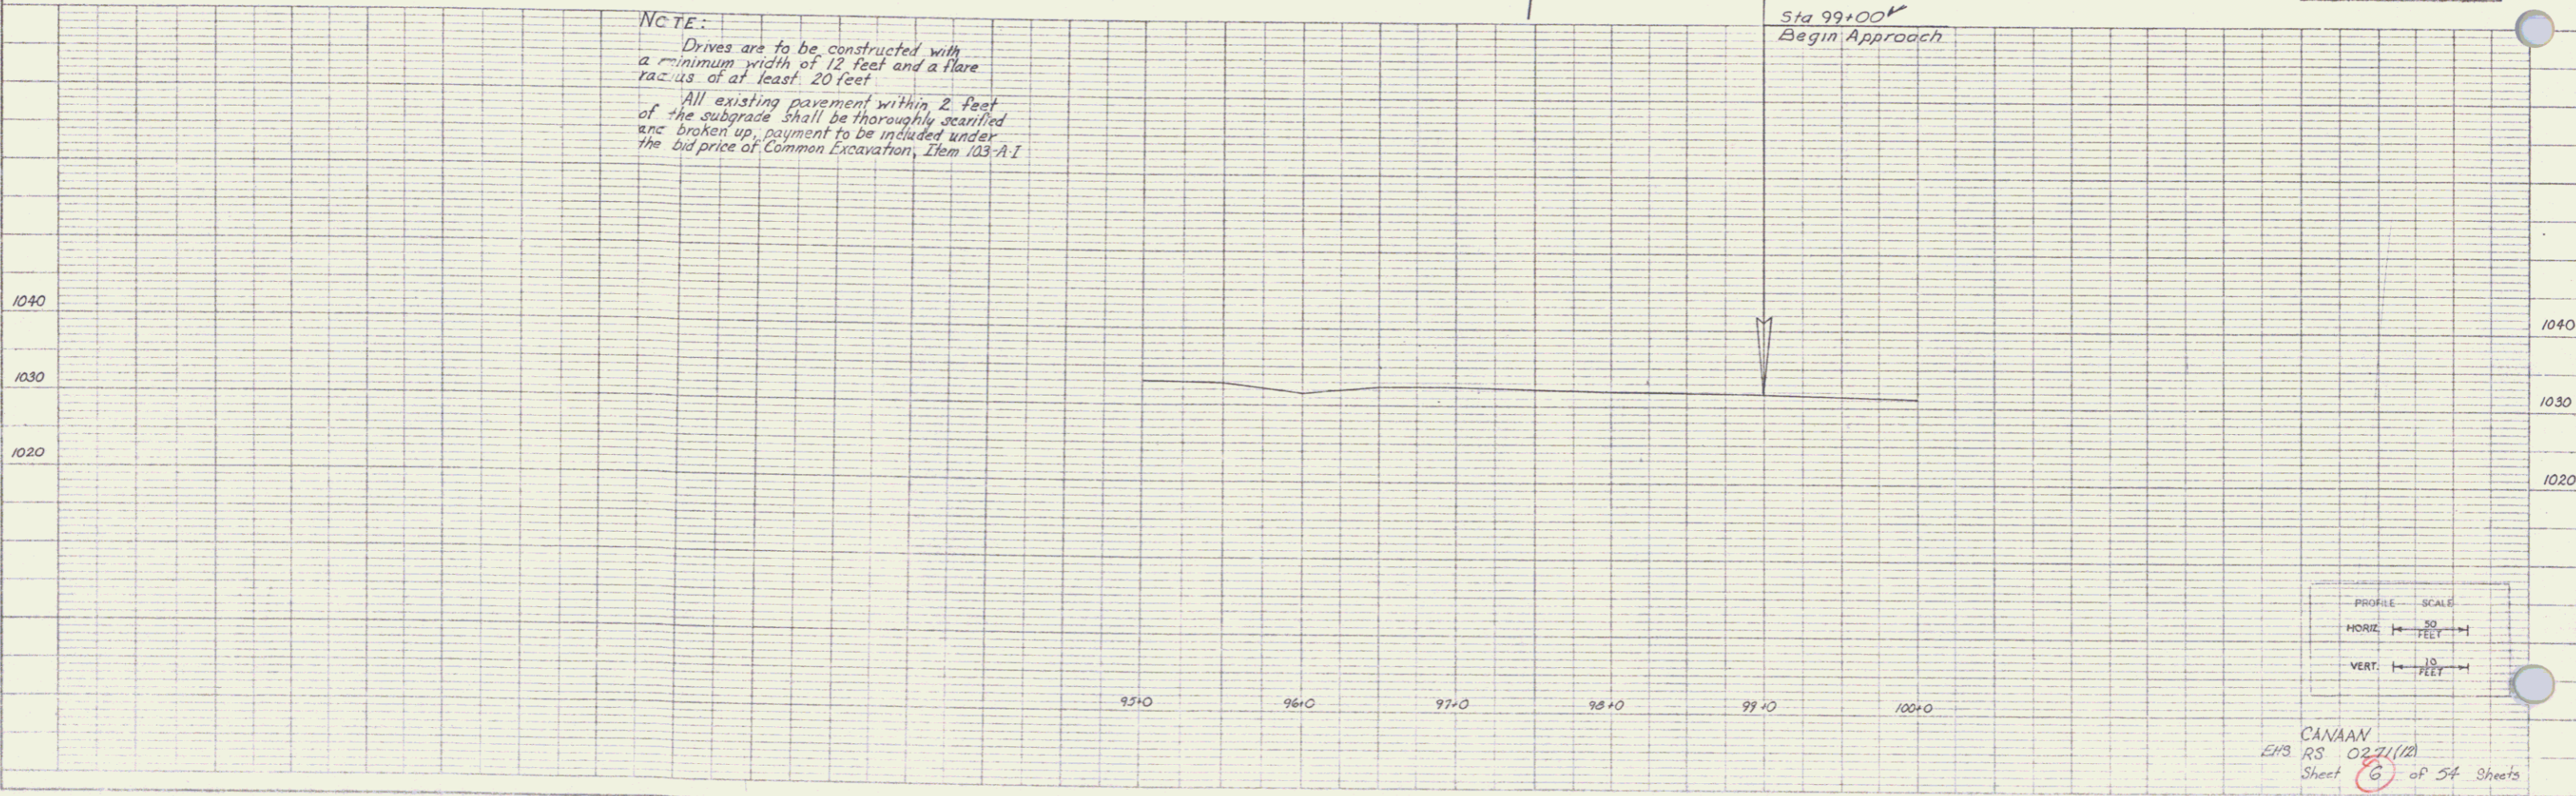

CANAAN
 EHS RS 02/11/12
 Sheet 6 of 54 Sheets