

PLAN
 SCALE 1" = 40'
 DATE 5/19/53
 DRAWN BY L. L. LORAN
 CHECKED BY L. L. LORAN


PROFILE
 SCALE 1" = 10'
 DATE 5/19/53
 DRAWN BY L. L. LORAN
 CHECKED BY L. L. LORAN

Δ 0° 30' Lt approx
 D 0° 10'
 L 343.775
 T 150.0
 L 300.0
 E 0.3


Three Cable Guard Rail

Stations	LT	RT
153114-153182		208
153182-160143		217
161146-161194	48	48

Δ 9° 35' Lt
 D 2° 30'
 L 2292.0
 T 192.1
 L 333.3
 E 8.1
 Bank 1/2 Ft. Ft.

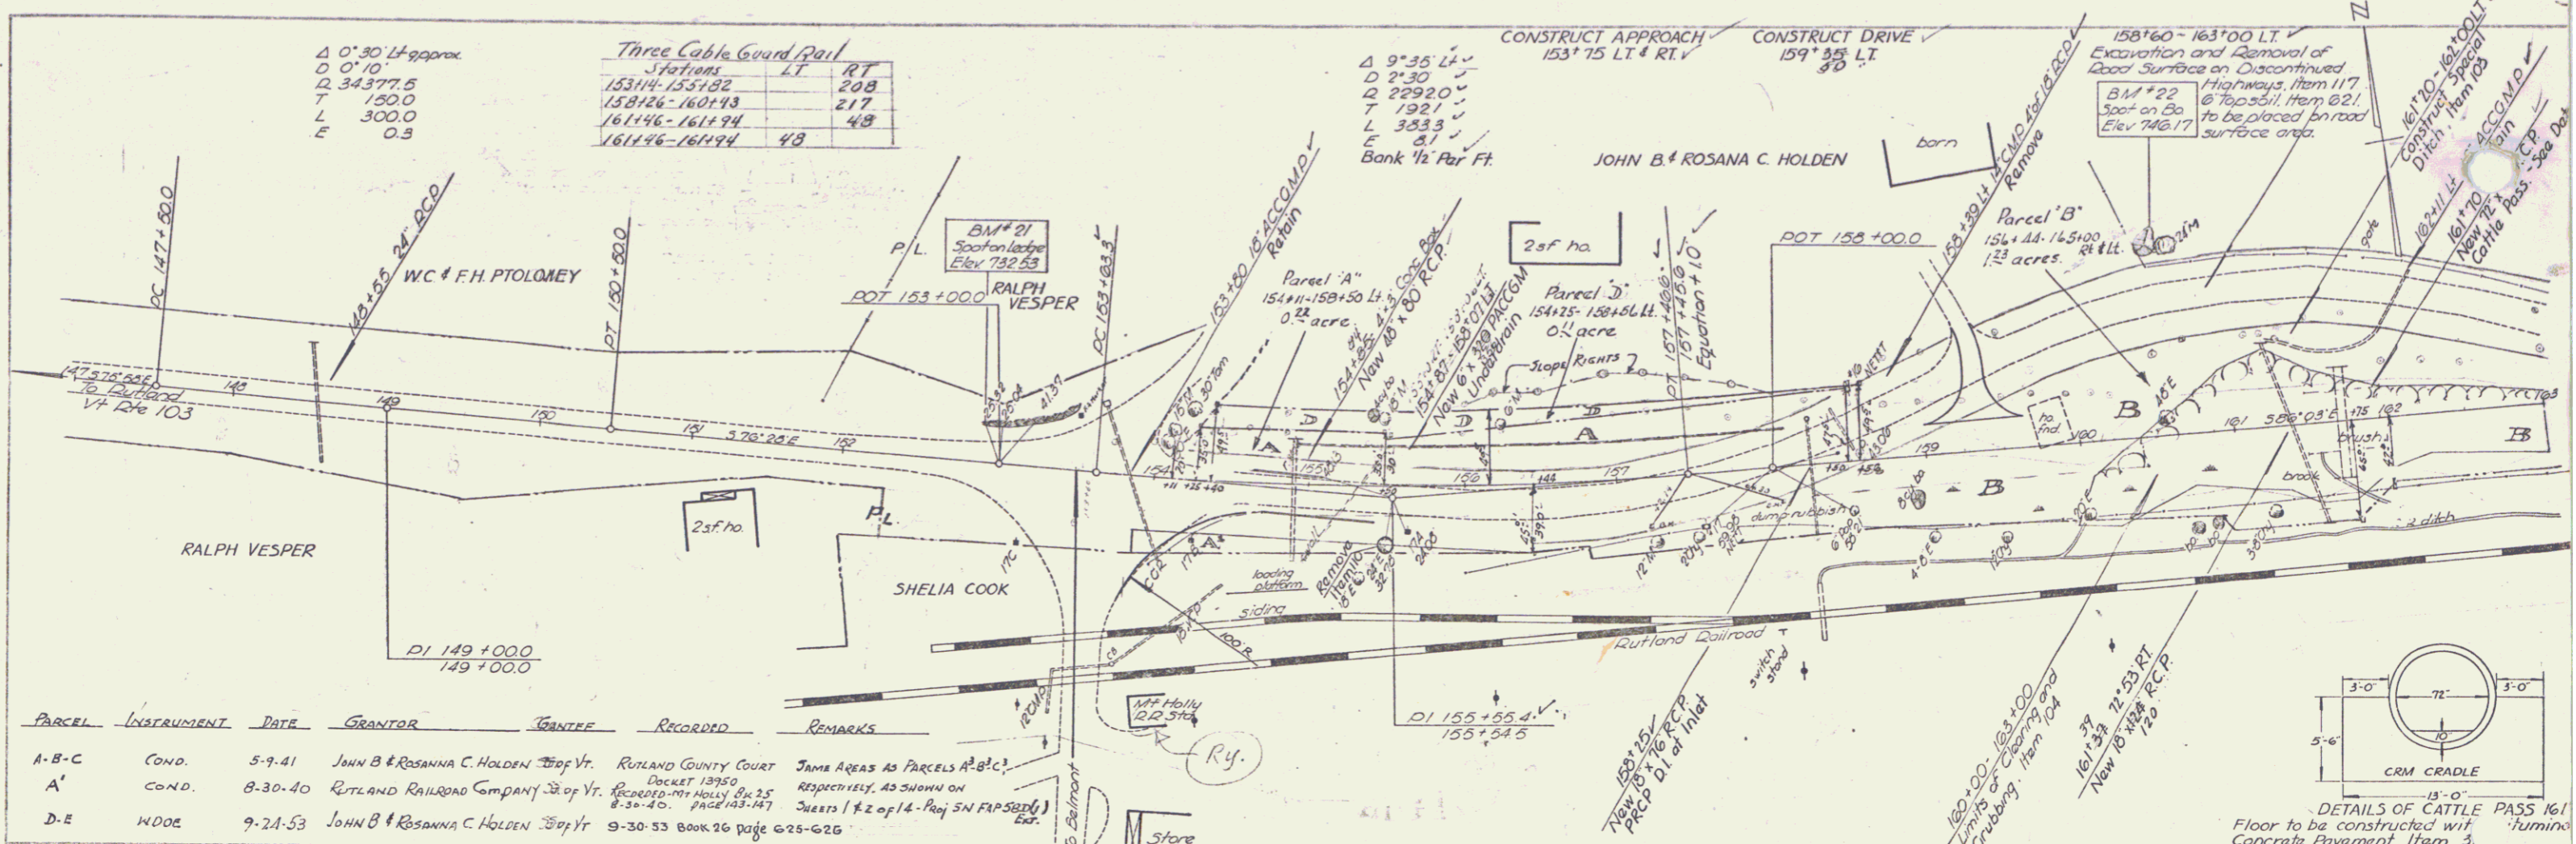

PARCEL	INSTRUMENT	DATE	GRANTOR	GRANTEE	RECORDED	REMARKS
A-B-C	COND.	5-9-41	JOHN B & ROSANNA C. HOLDEN	3rd of Vt.	RUTLAND COUNTY COURT	JAMES AREAS AS PARCELS A-B-C
A'	COND.	8-30-40	RUTLAND RAILROAD COMPANY	3rd of Vt.	DECKET 1950	RESPECTIVELY, AS SHOWN ON
D-E	WDOE	9-21-53	JOHN B & ROSANNA C. HOLDEN	3rd of Vt.	9-30-53 BOOK 26 PAGE 625-626	SUBD (1 & 2 of 14-Parj 5th FAP 58(1) Est.

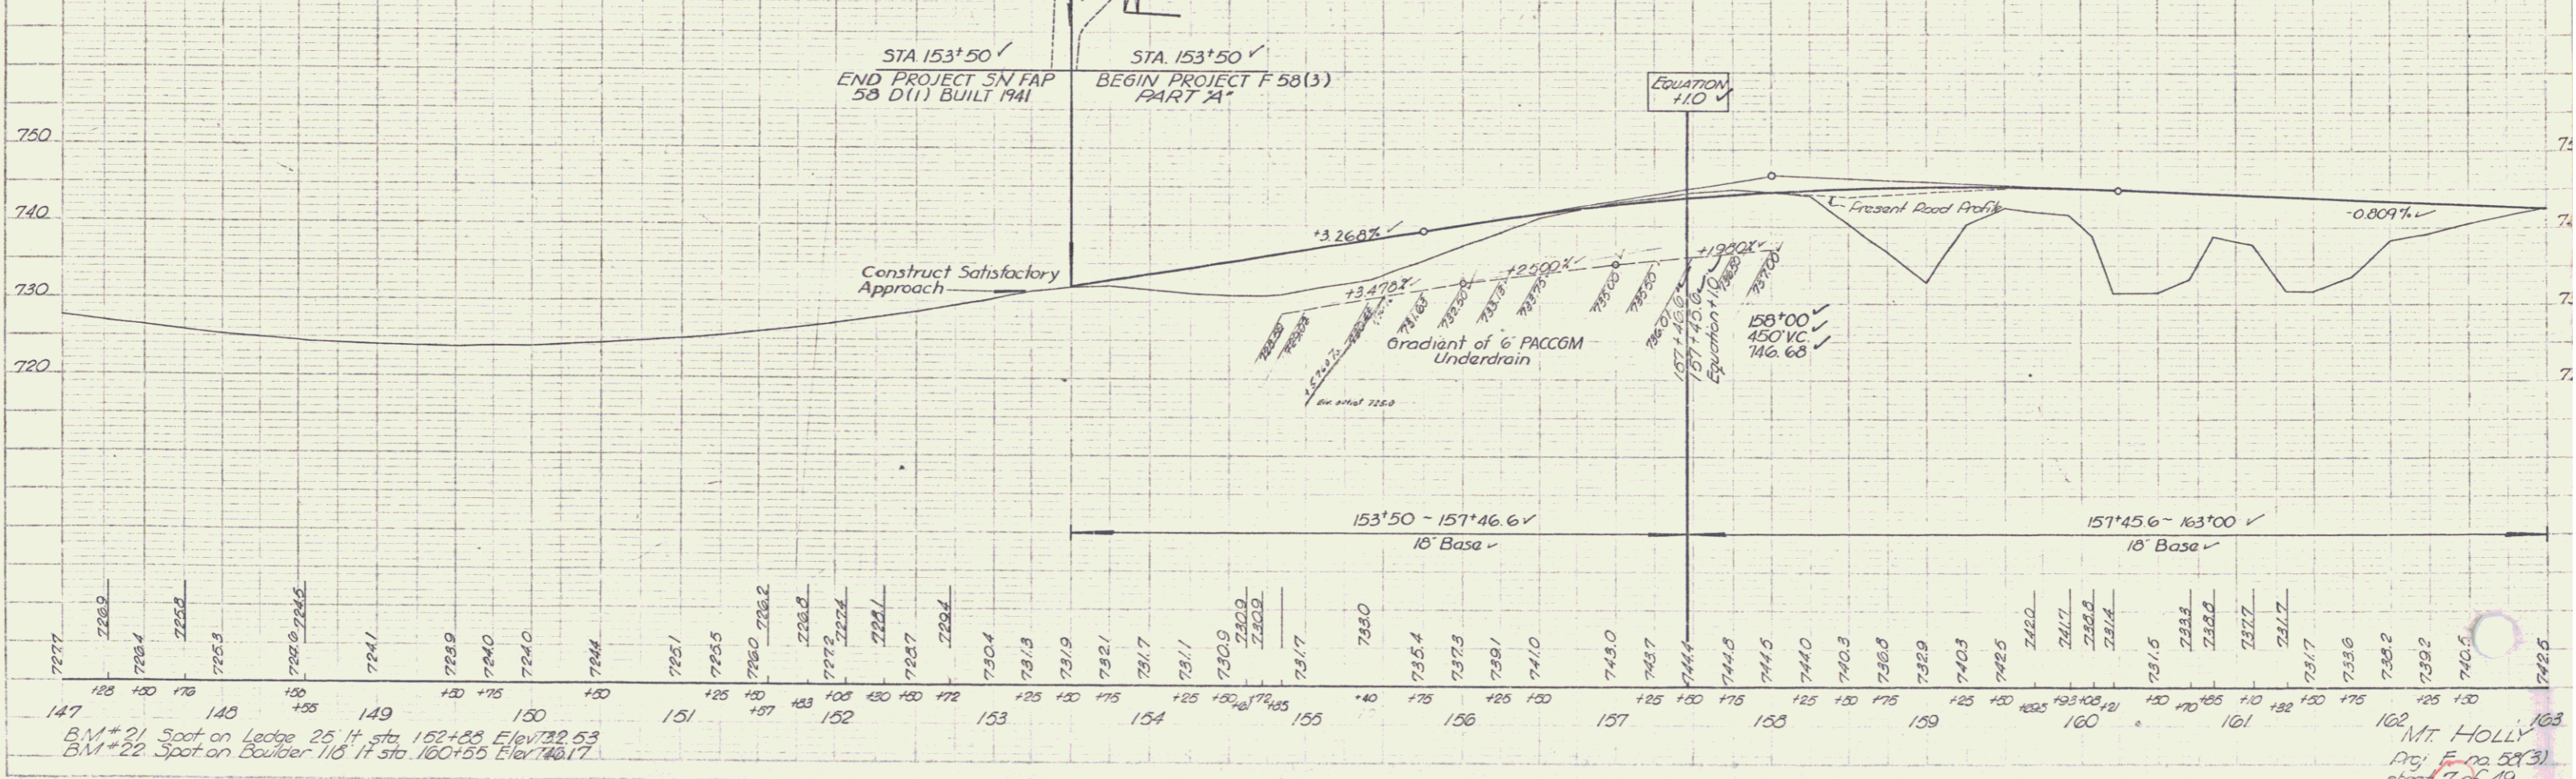

B.M. # 21 Spot on Ledge 25 ft sta 152+55 Elev 732.53
 B.M. # 22 Spot on Boulder 115 ft sta 160+55 Elev 746.17

