

Three Cable Guard Rail, Wood Posts	LT	RT
Station	125LE	98LT
37+25-38+50		
37+50-38+48		


CONSTRUCT APPROACHES
 36+00 LA 36+50 LT
 38+00 LA 37+0 LT
 39+00 RA 40+0 RT

CONSTRUCT DRIVES
 41+00 LA
 41+65 LA

Non-Govt. Participation
 sta 41+30+ install sleeve for
 water pipe across roadway Item 103 non-govt.
 Sleeve to be furnished by property owner.

DATE	1/23
BY	ALA
PROJECT	MT HOLLY
NO. OF SHEETS	28
SHEET NO.	28

DATE	1/23
BY	ALA
PROJECT	MT HOLLY
NO. OF SHEETS	28
SHEET NO.	28

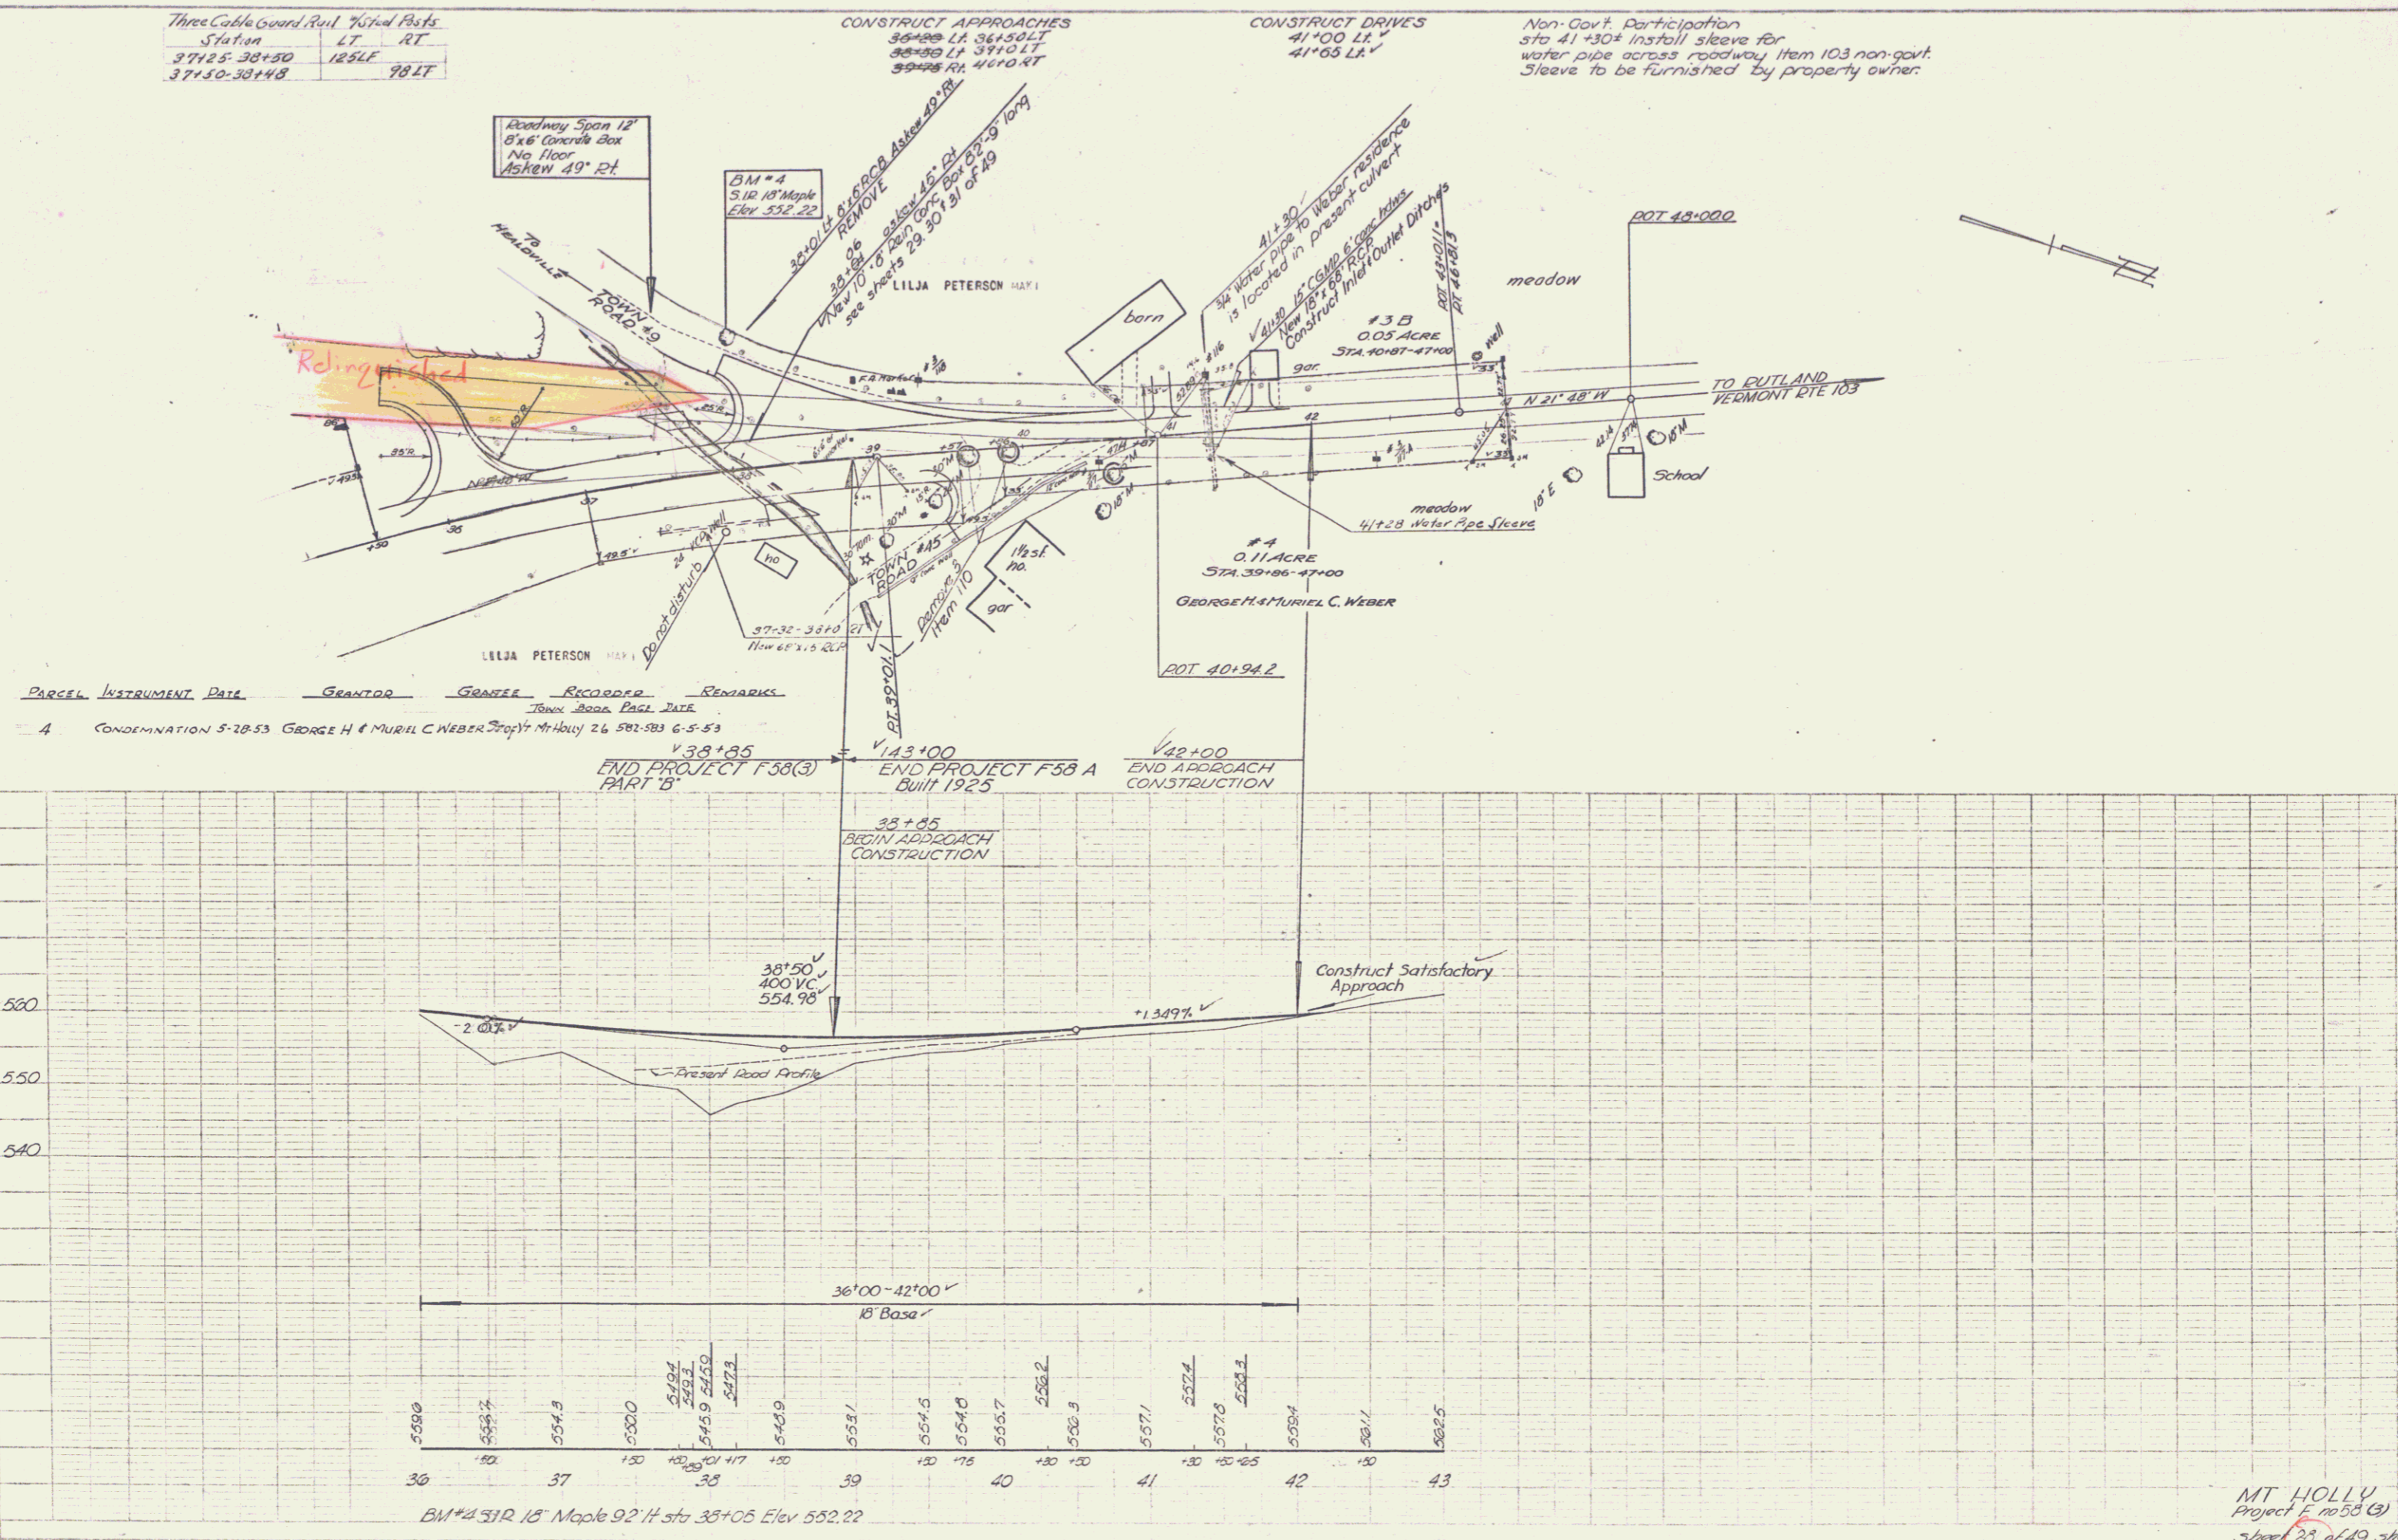

MT HOLLY
 Project F-58(3)
 Sheet 28 of 29 sheets