

INDEX OF SHEETS

- E PAGE
- CAL CROSS-SECTION OF IMPROVEMENT BITUMINOUS CONCRETE PAVEMENT, (TENSILE-B MODEL)
- BANKING AND WIDENING B-1
- QUANTITY SHEET (ITEMS) 5
- ITEM & DRAINAGE SHEET 6
- 7-10 EARTHWORK SHEETS
- 11 ROADWAY STANDARD G-4 (MARKERS & POSTS)
- 12 ROADWAY STANDARD D-2 (UNDERDRAIN)
- 13 ROADWAY STANDARD B-5 (SLOPE GRADING)
- 14 ROADWAY STANDARD A-61 (DRILLING AND BLASTING)
- 15 ROADWAY STANDARD D-4 (UNDERDRAIN FLUSHING/ISSIN)
- 16 ROADWAY STANDARD G-3 (THREE CABLE GUARD RAIL/STEEL POSTS)
- 17 ROADWAY STANDARD E-1 (BARRICADES, SIGNS AND LIGHTS)
- 18 ROADWAY STANDARD D-8 (PRECAST R.C.P. DI W/COVER
- 19 ROADWAY STANDARD B-6 (MUCK EXCAVATION)
- 20 ROADWAY STANDARD D-3 (GUTTERS)
- 20-A LANDSCAPING SHEET
- 21-32 PLAN AND PROFILE SHEETS
- 33 BRIDGE EXTENSION DETAILS
- 34 REINFORCING STEEL SCHEDULE
- 35 STANDARD STRUCTURE SHEET SB-21-56 (DETAILS FOR REINF. CONC. BOX)
- 36-106 CROSS-SECTIONS
- 107-108 CULVERT SECTIONS
- 109 APPROACH ROAD SECTIONS
- 110 CHANNEL SECTIONS

PROJECT NAME	NUMBER	TYPE	PAVEMENT	AREA
MT. HOLLY	F 025-1(III)	BIT. CONC.	PAVEMT.	58,558 SY.

SUBBASE OF SAND - MORTARITE PIT - MT. HOLLY, VERMONT.
 SUBBASE OF GRAVEL, GRAVEL BACKFILL & SHOULDERS - BURTON PIT - MT. HOLLY, VERMONT.
 SUBBASE OF CRUSHED ROCK, STONE BASE COURSE & PEAKING - W. MARBLE CO. - FLORENCE, VT.
 REFINED TAR - OLD COLONY TAR CO. - WORCESTER, MASS.
 ASPHALT CUTBACK ASPH. - TEXAS CO. - PROVIDENCE, R.I. - & MOBIL OIL CO. - E. PROVIDENCE, R.I.
 BITUMINOUS CONCRETE PAVEMENT - VERMONT PAVING CO. - ESCARELTON, VERMONT.
 CONC. CLAS. 15 AGGREGATES FOR CONC. & STONE CRITS - J. E. WARRAN & SONS - W. RUTLAND, VT.
 PORTLAND CEMENT - GLENS FALLS PORTLAND CEMENT CO. - GLENS FALLS, NEW YORK.
 REINFORCING STEEL - VERMONT STRUCTURAL STEEL CO. - BURLINGTON, VERMONT.
 THREE CABLE & PLANK GUARD RAIL, STEEL MARKER POSTS & BOUNDARY MARKERS -
 S. T. GRISWOLD CO. INC. - LESEX JUNCTION, VERMONT.
 REINF. CONC. PIPE & PRECAST REINF. CONC. PIPE DI. W/COVER - V. T. JOHNSON & CO. - WINDSOR, VT.
 ASPH. CTD. CORR. GALV. MET. PIPE - NEW ENGLAND METAL CULV. CO. - WHITE RIVER JCT., VT.
 CAST IRON PIPE UNDERDRAIN B-SINS W/C/COVERS - LEBERWITZ DRY - BROCKTON, MASS.
 TREES, SHRUBS & VINES - GEORGE MITCHELL - SO. BARRE, VERMONT.
 CONTRACTOR - S. V. ROSSI, JOHN, CO. INC. - TORRINGTON, CONN.
 RESIDENT ENGINEER - H. F. ELLDER.
 INSPECTOR - JOHN G. PHILBRICK.
 RECORD PLANS - A. G. SPIDLE.

CONTRACT DATED - JUNE 23, 1959.
 CONTRACT STARTED - JULY 13, 1959.
 CONTRACT COMPLETED - SEPTEMBER 30, 1960.
 CONTRACT ACCEPTED - SEPTEMBER 30, 1960.

STATE OF VERMONT
 DEPARTMENT OF HIGHWAYS
PROPOSED IMPROVEMENT
 FEDERAL AID
 PRIMARY PROJECT
TOWN OF MOUNT HOLLY
 COUNTY OF RUTLAND
VERMONT ROUTE 103
 RUTLAND-LUDLOW ROAD


BEGINNING AT A POINT APPROXIMATELY 4.92 MILES
 WESTERLY OF THE MT. HOLLY-LUDLOW TOWN LINE AND EXTENDING
 EASTERLY 17,123.2 FEET.

LENGTH OF PROJECT 17,123.2 FEET = 3.243 MILES

DESIGN SPEED	50 M.P.H.
1959 ADT	1975
1980 ADT	3150
D.V.	440
DIRECTIONAL	60%
TRUCK	9%



NOTE: ANY SUPPLIED INFORMATION CONCERNING FINAL QUANTITIES, AMOUNTS OR OTHER DETAILS RELATIVE TO THIS PROJECT MAY BE FOUND EITHER IN THE FIELD BOOKS OR THE ESTIMATE FILE.

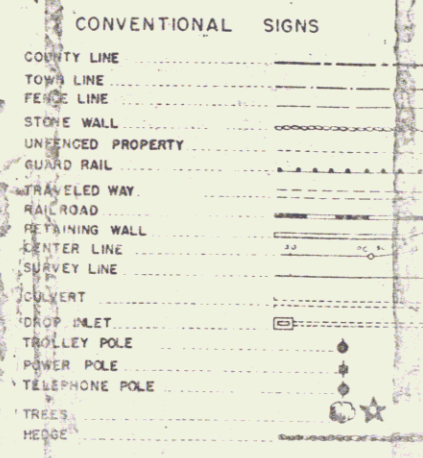

SCALES

TITLE	1" = 1000'
TYPICAL	1" = 250'
PLAN	1" = 50'
PROFILE HORIZONTAL	1" = 50'
PROFILE VERTICAL	1" = 10'
CROSS-SECTIONS	1" = 5'

APPROVED	DATE	APPROVED	DATE	APPROVED	DATE	APPROVED	DATE	APPROVED	DATE
SECONDARY ENGINEER		CONSTRUCTION ENGINEER	4-24-59	BRIDGE ENGINEER	4-24-59	DISTRICT ENGINEER	4-22-59	HIGHWAY ENGINEER	April 24, 1959

DEPARTMENT OF COMMERCE
 BUREAU OF PUBLIC ROADS
 Pin # 00R113

APPROVED

DIVISION ENGINEER DATE

PROJECT F NO 025-1 (II)

SHEET 1 OF 110 SHEETS