
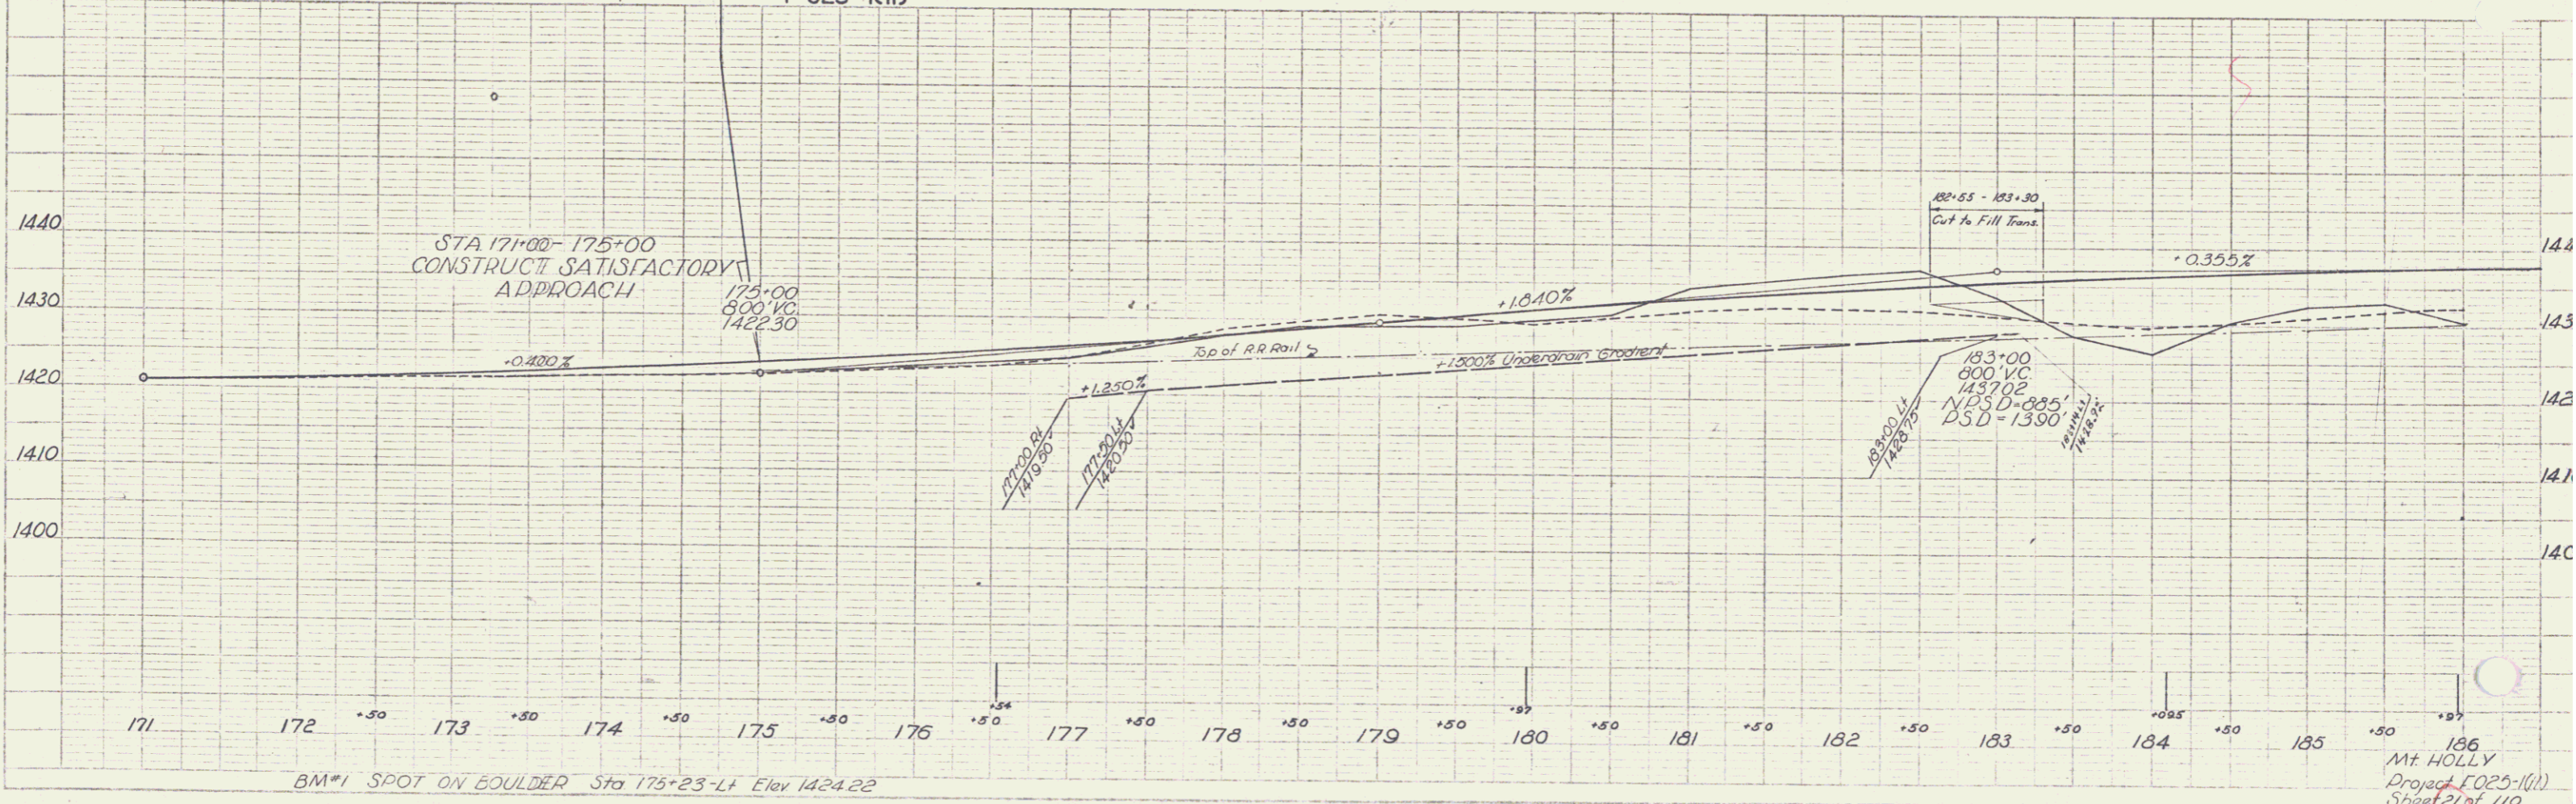


PLAN
 DRAWN BY
 H.Y. H.L. - N.R.
 DATE BOOK & SHEET NUMBER
 DATE OF SHEET
 DATE OF SHEET

PROFILE
 DRAWN BY
 H.Y. H.L. - N.R.
 DATE BOOK & SHEET NUMBER
 DATE OF SHEET
 DATE OF SHEET

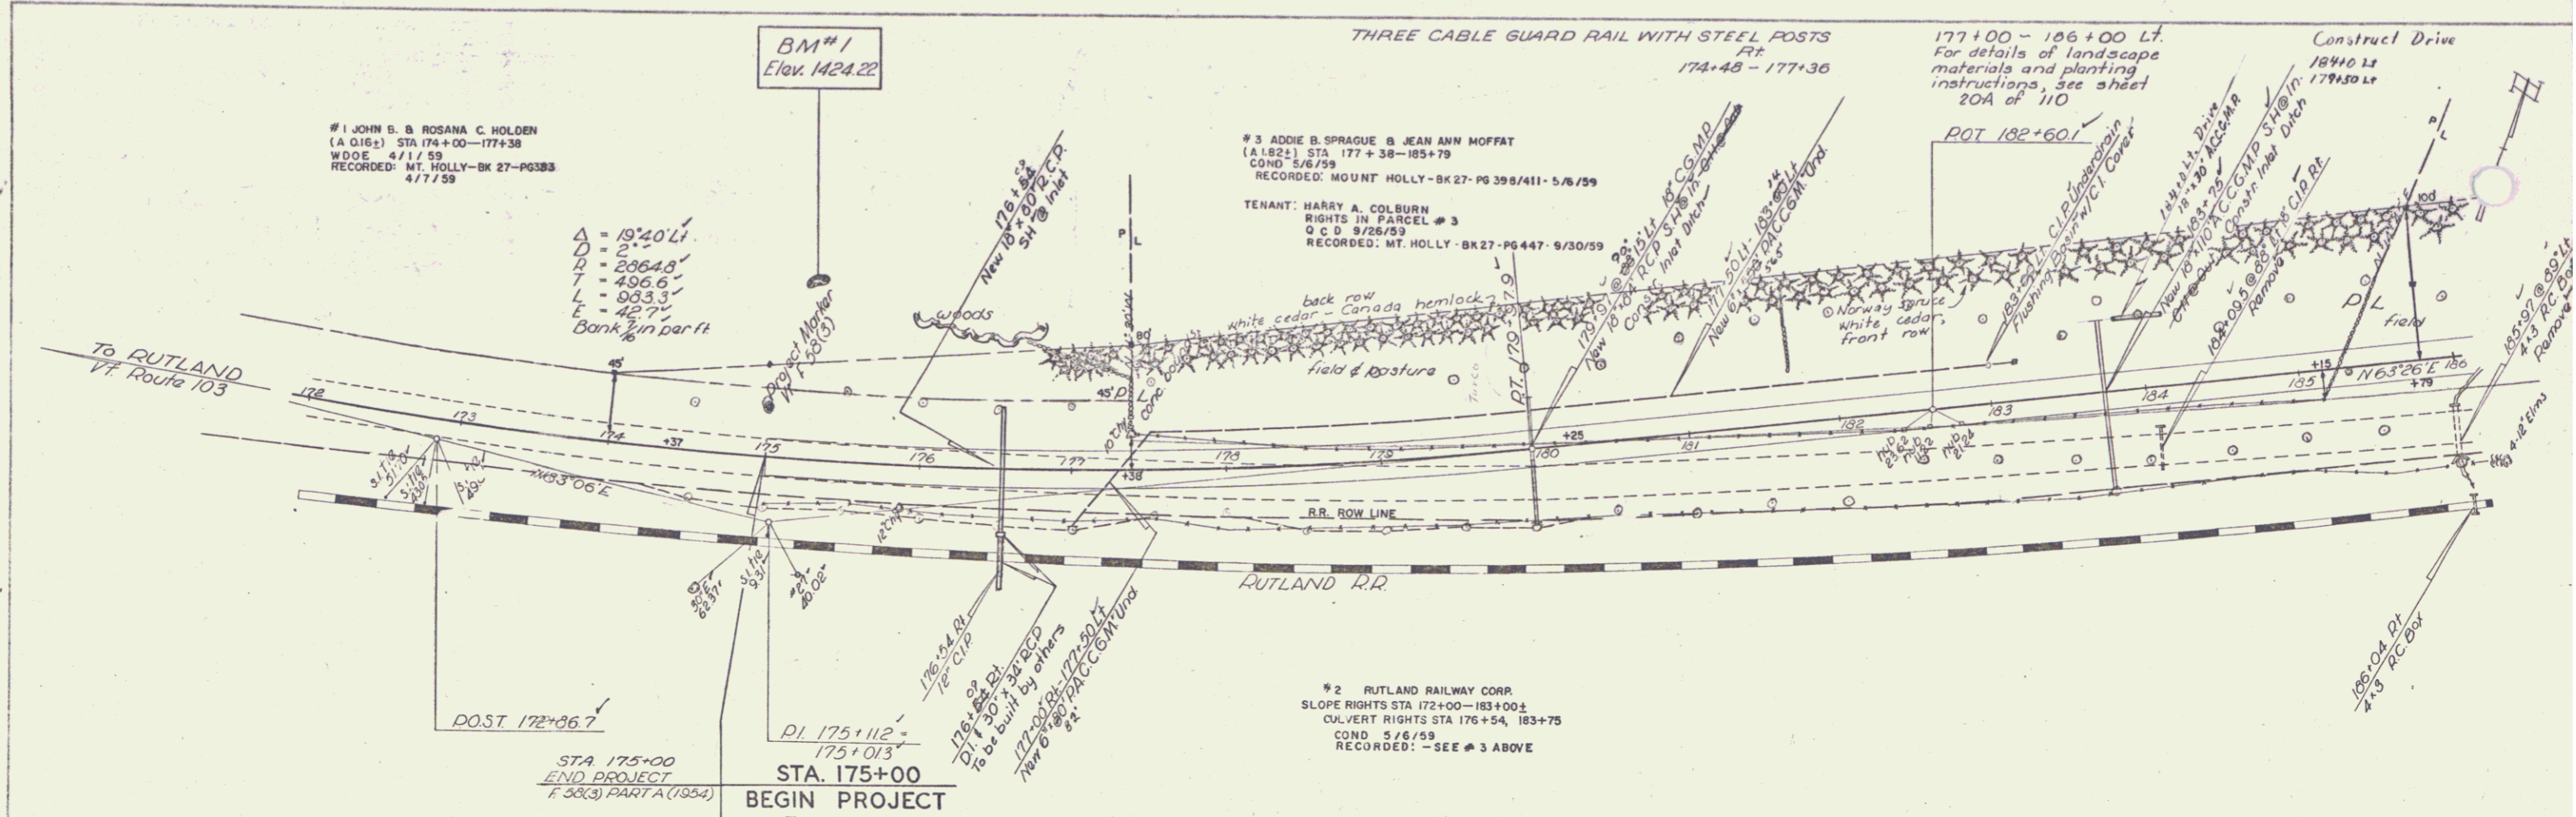

Mt HOLLY
 Project F025-1(11)
 Sheet 2 of 110