
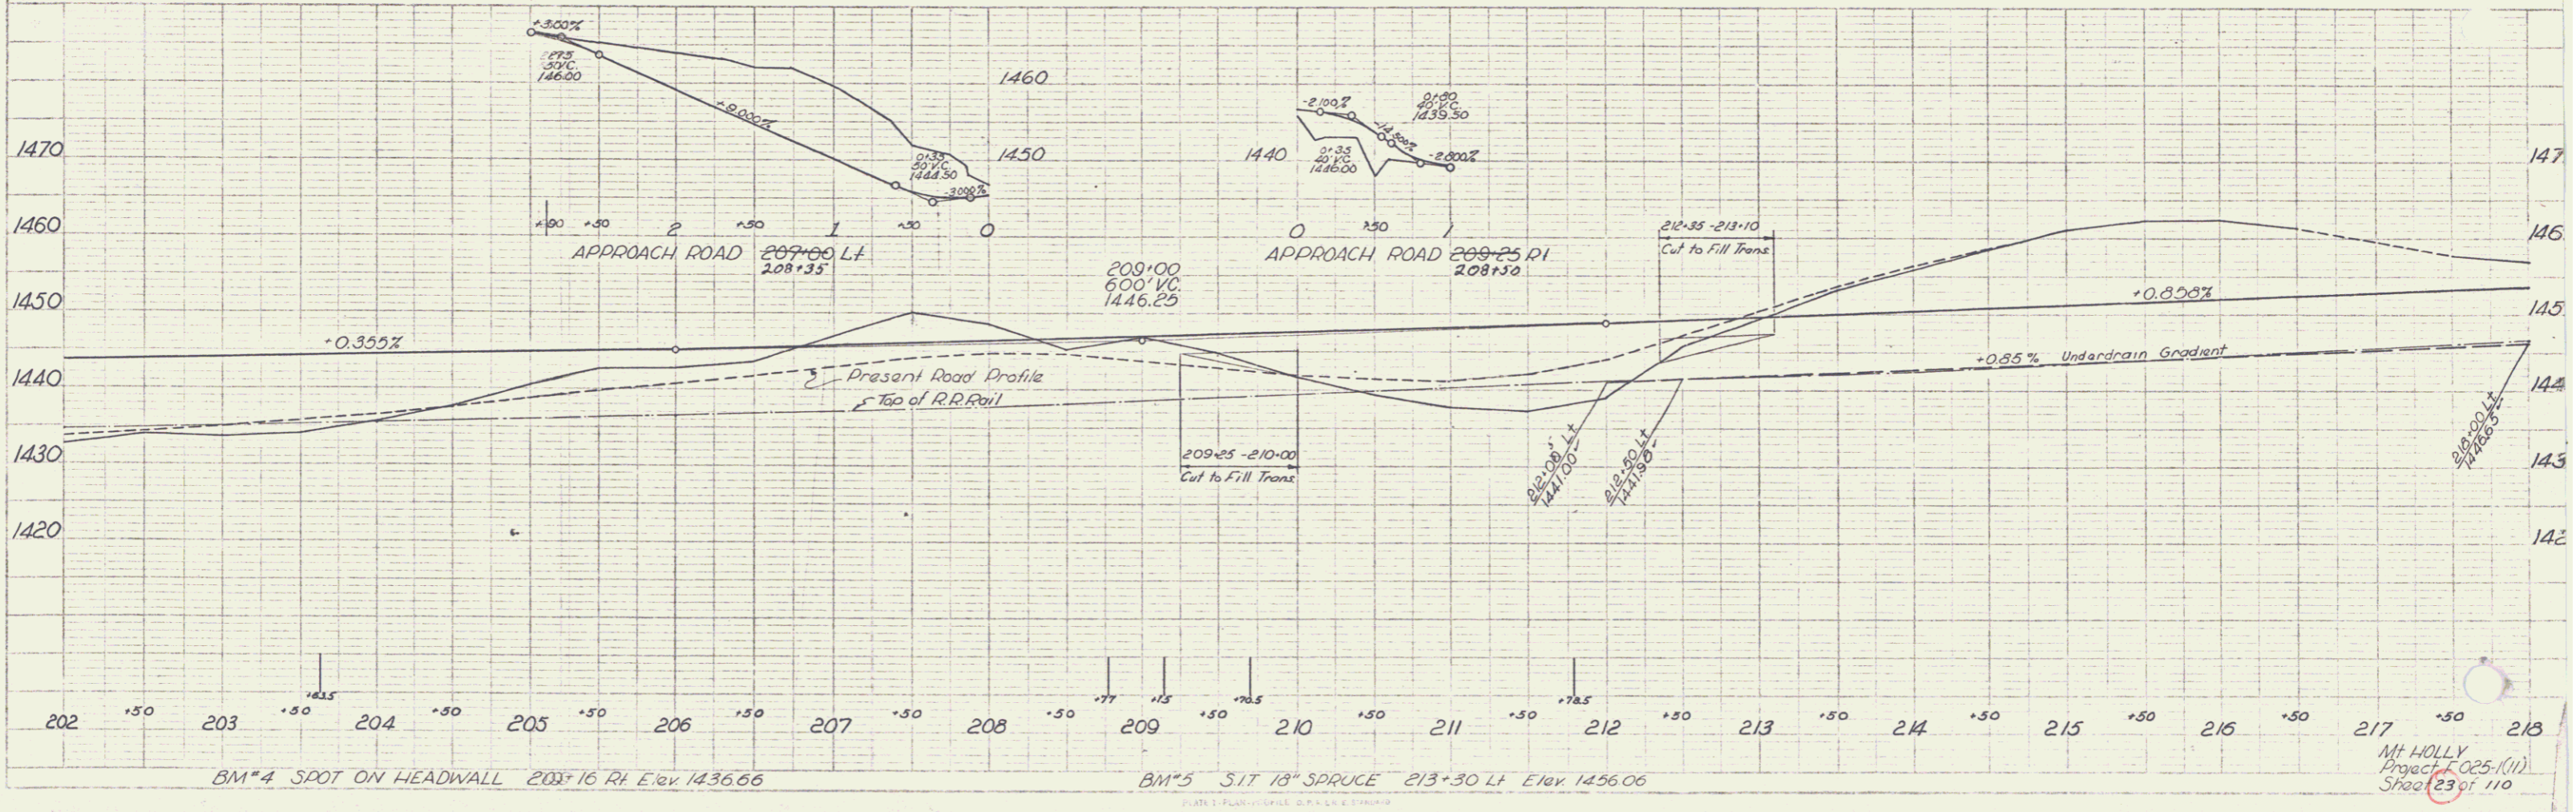


PLAN
 H.V. H.V. - W.R.
 2-58
 5-58

PROFILE
 H.V. H.V. - W.R.
 2-58
 5-58

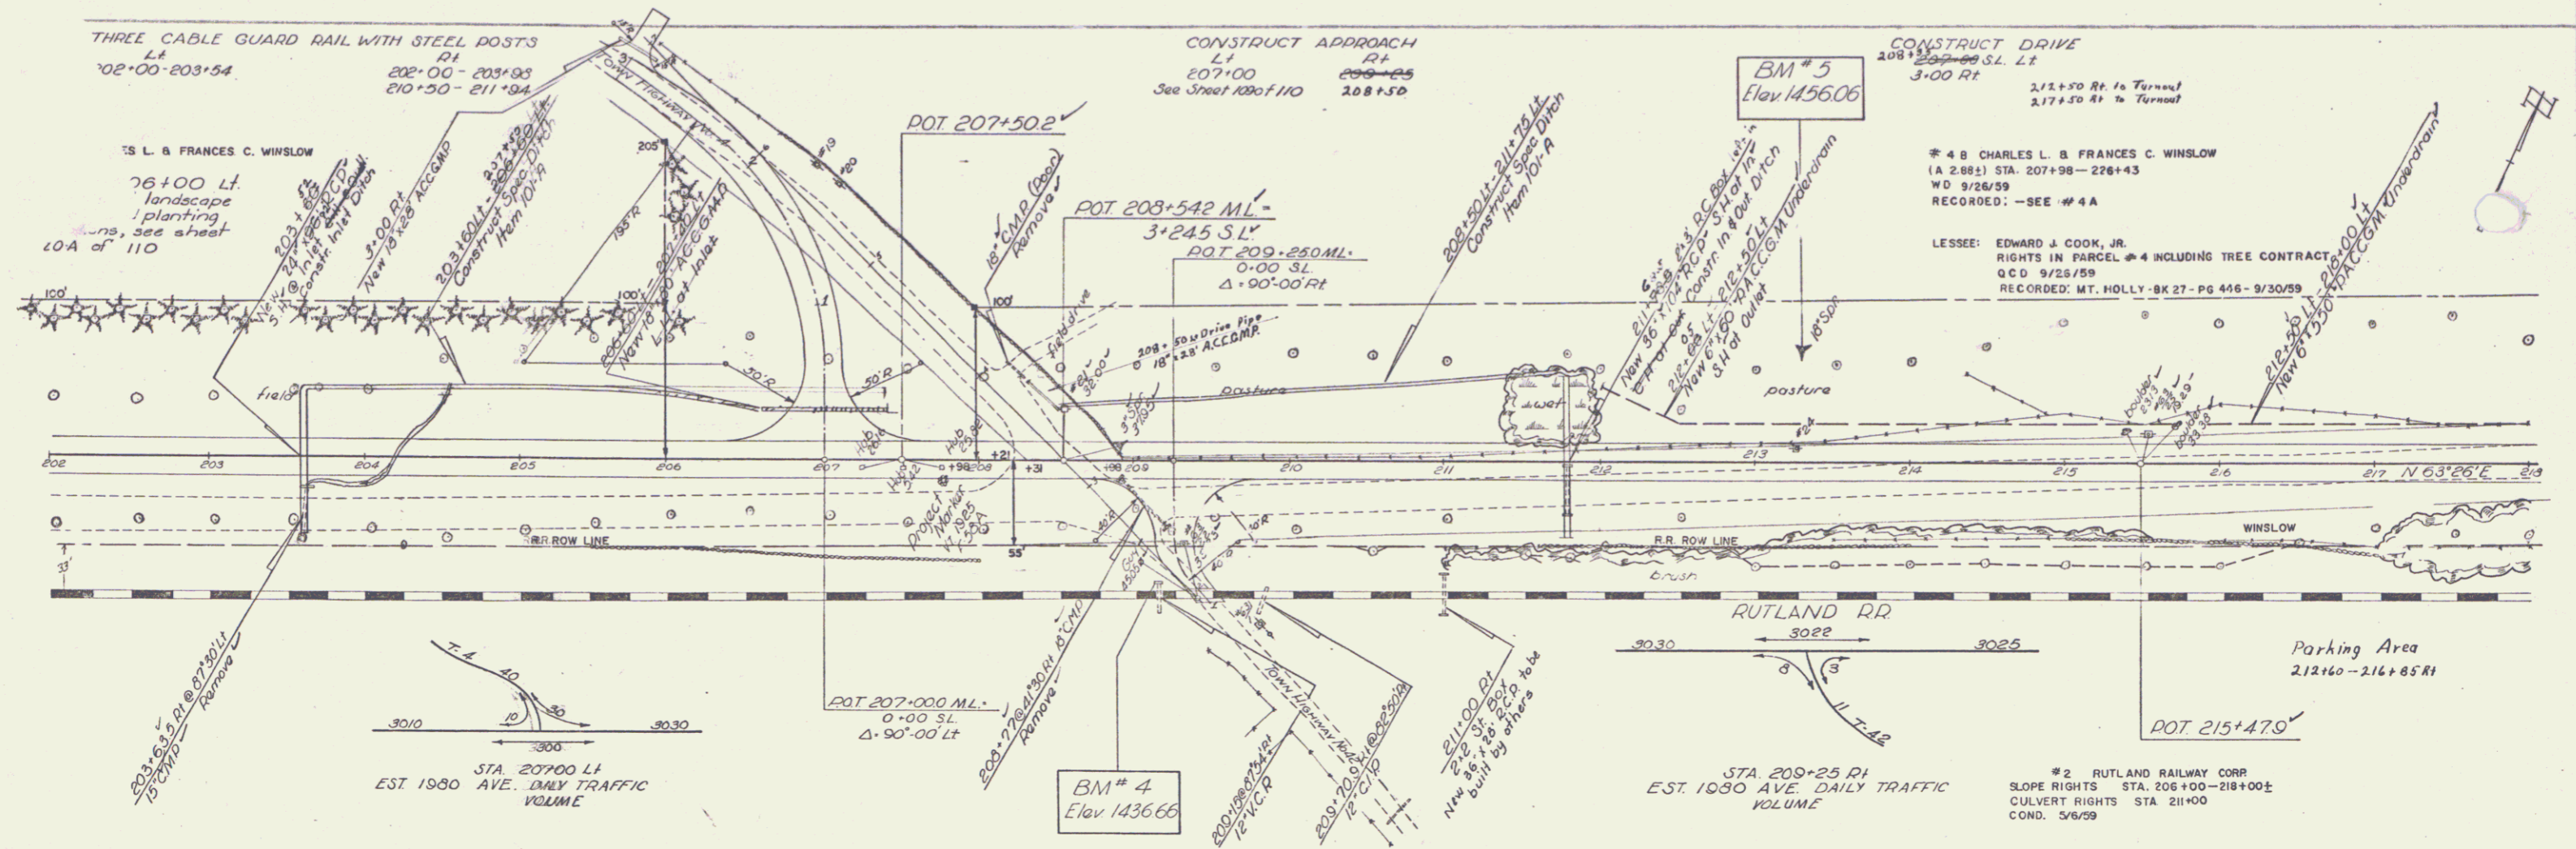

Mt HOLLY
 Project 7-025-1(11)
 Sheet 23 of 110