



Station	Elevation	Curve
83+00	606.89	350' V.C.
83+25	606.89	350' V.C.
83+50	612.59	325' V.C.
84+00	612.59	325' V.C.
84+25	612.59	325' V.C.
84+50	612.59	325' V.C.
85+00	612.59	325' V.C.
85+25	612.59	325' V.C.
85+50	612.59	325' V.C.
86+00	612.59	325' V.C.
86+25	612.59	325' V.C.
86+50	612.59	325' V.C.
87+00	612.59	325' V.C.
87+25	612.59	325' V.C.
87+50	612.59	325' V.C.
88+00	612.59	325' V.C.
88+25	612.59	325' V.C.
88+50	612.59	325' V.C.
89+00	612.59	325' V.C.
89+25	612.59	325' V.C.
89+50	612.59	325' V.C.
90+00	612.59	325' V.C.
90+25	612.59	325' V.C.
90+50	612.59	325' V.C.
91+00	612.59	325' V.C.
91+25	612.59	325' V.C.
91+50	612.59	325' V.C.
92+00	637.87	300' V.C.
92+25	637.87	300' V.C.
92+50	637.87	300' V.C.
93+00	637.87	300' V.C.
93+25	637.87	300' V.C.
93+50	637.87	300' V.C.
94+00	637.87	300' V.C.
94+25	637.87	300' V.C.
94+50	637.87	300' V.C.
95+00	637.87	300' V.C.
95+25	637.87	300' V.C.
95+50	637.87	300' V.C.
96+00	637.87	300' V.C.
96+25	637.87	300' V.C.
96+50	637.87	300' V.C.
97+00	637.87	300' V.C.
97+25	637.87	300' V.C.
97+50	637.87	300' V.C.
98+00	637.87	300' V.C.
98+25	637.87	300' V.C.
98+50	637.87	300' V.C.
99+00	637.87	300' V.C.
99+25	637.87	300' V.C.
99+50	637.87	300' V.C.
100+00	637.87	300' V.C.

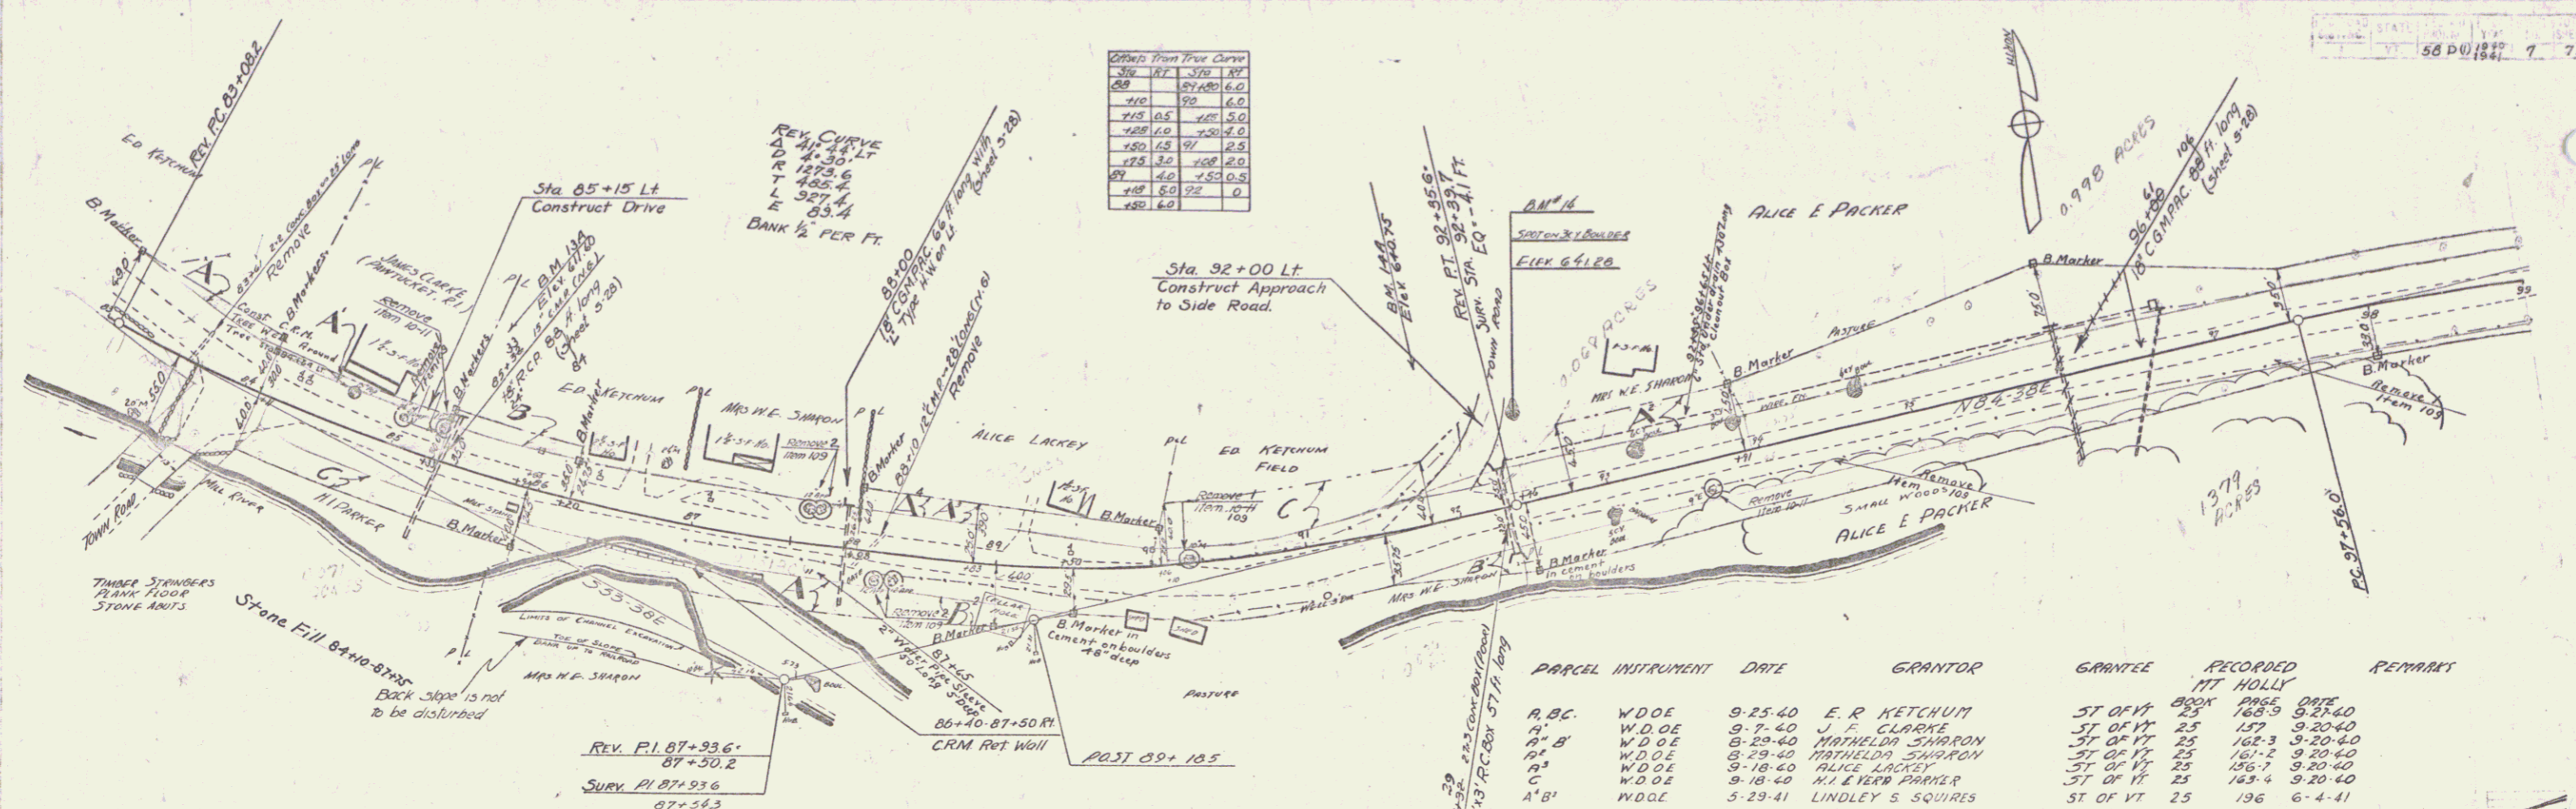

PARCEL INSTRUMENT	DATE	GRANTOR	GRANTEE	RECORDED	REMARKS
A.B.C.	9-25-40	E. R. KETCHUM	ST OF VT	188-9	9-25-40
A'-B'	9-7-40	J. F. CLARKE	ST OF VT	157	9-20-40
A''-B''	8-20-40	MATHELDIA SHARRON	ST OF VT	162-3	9-20-40
A'''	8-29-40	MATHELDIA SHARRON	ST OF VT	161-2	9-20-40
C	9-18-40	ALICE LACKEY	ST OF VT	156-7	9-20-40
A''-B''	9-18-40	M. E. VERB PARMER	ST OF VT	163-4	9-20-40
A''-B''	5-29-41	LINDLEY S. SQUIRES	ST OF VT	196	6-4-41

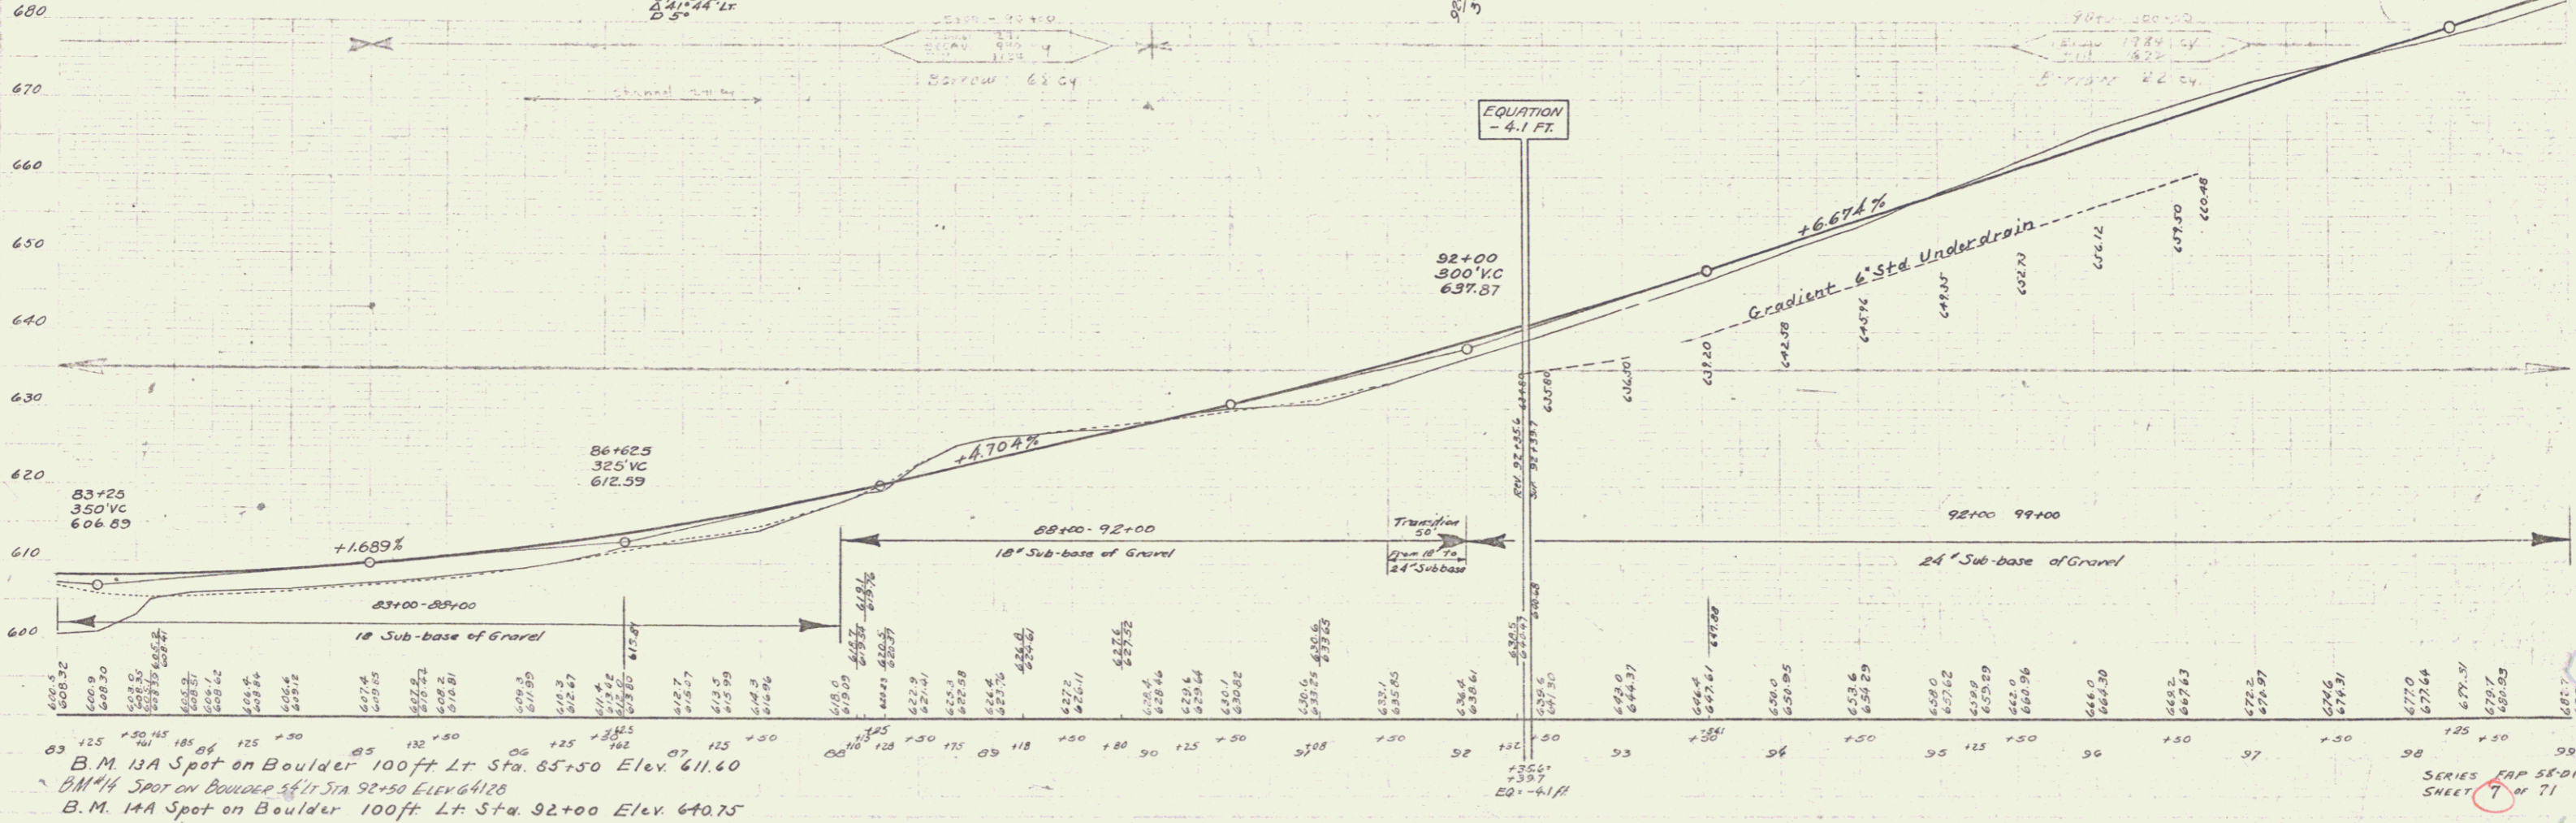

B.M. 13A Spot on Boulder 100ft Lt. Sta. 85+50 Elev. 611.60  
 B.M. 14 Spot on Boulder 100ft Lt. Sta. 92+50 Elev. 641.20  
 B.M. 14A Spot on Boulder 100ft Lt. Sta. 92+00 Elev. 640.75