



PARCEL INSTRUMENT DATE GRANTOR GRANTEE RECORDED REMARKS  
 A.B. G.W.D.G.E. 9-25-40 W.S. SHATTUCK GUR ALICE PACKER STAFF 25 1678 52140 1 CULV

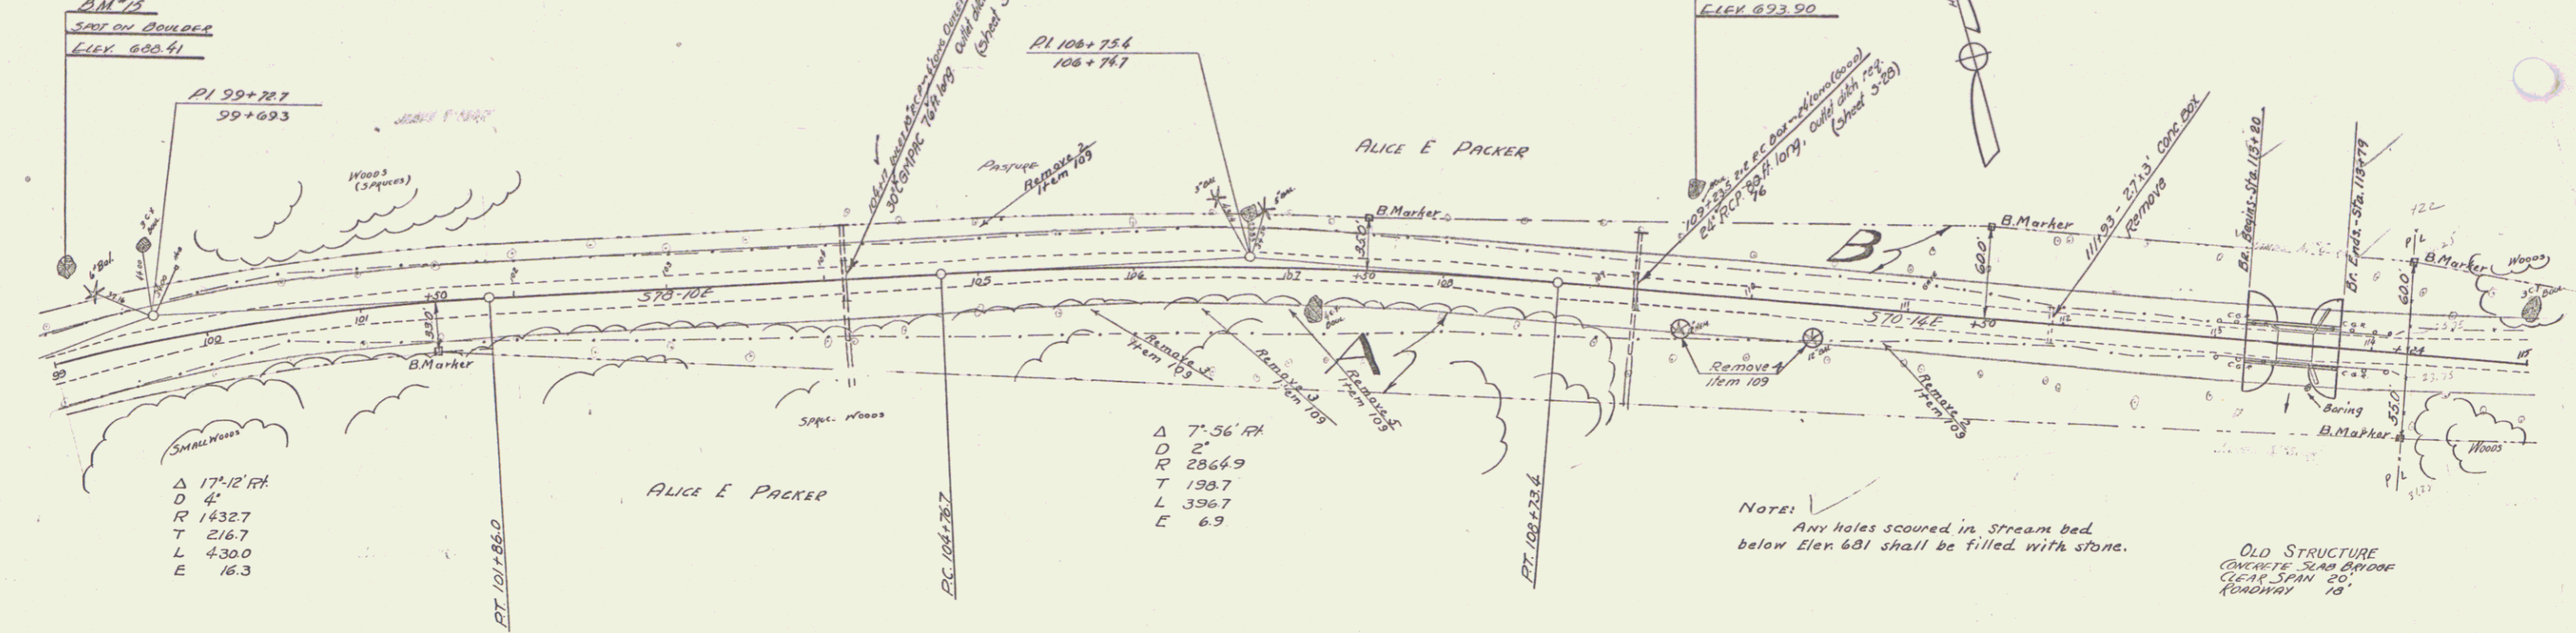

BRIDGE DATA		
Type	PRESENT	PROPOSED
Clear Span	20'-0"	55'-0"
Roadway Length	18'-0"	24'-0"
Clear Height	21'-0"	39'-0"
Waterway	100'	346'

SUMMARY OF BRIDGE QUANTITIES		
Item	Quantity	Final (7/13/33)
15 Channel Excavation	100 c.Y.	366
16 Structure Excavation	130 c.Y.	1263
10B Temporary Traffic Maintenance of Traffic	1 L.S.	1
41A Concrete Class II	85 c.Y.	868
42 Reinforcing Steel	15,678 lbs.	15790
43B Steel Superstructure (44105')	1 L.S.	1
57 Removal Present Superstr.	1 L.S.	1
68-B Rip Rap (Heavy Type) Modified	214 c.Y.	233
69 Stone Fill	20 c.Y.	~
80A Cable Guard Rail	119 L.F.	118

INDEX OF BRIDGE SHEETS	
1	Plan & Profile
2	Abutment Details
3	S18-24-59 Span
4	S350 - Cable Guard Rail
5	S511 - Entricades & Lights etc.
6	S220 - Detail A, L & Gen. Notes
7-A	Cross Sections

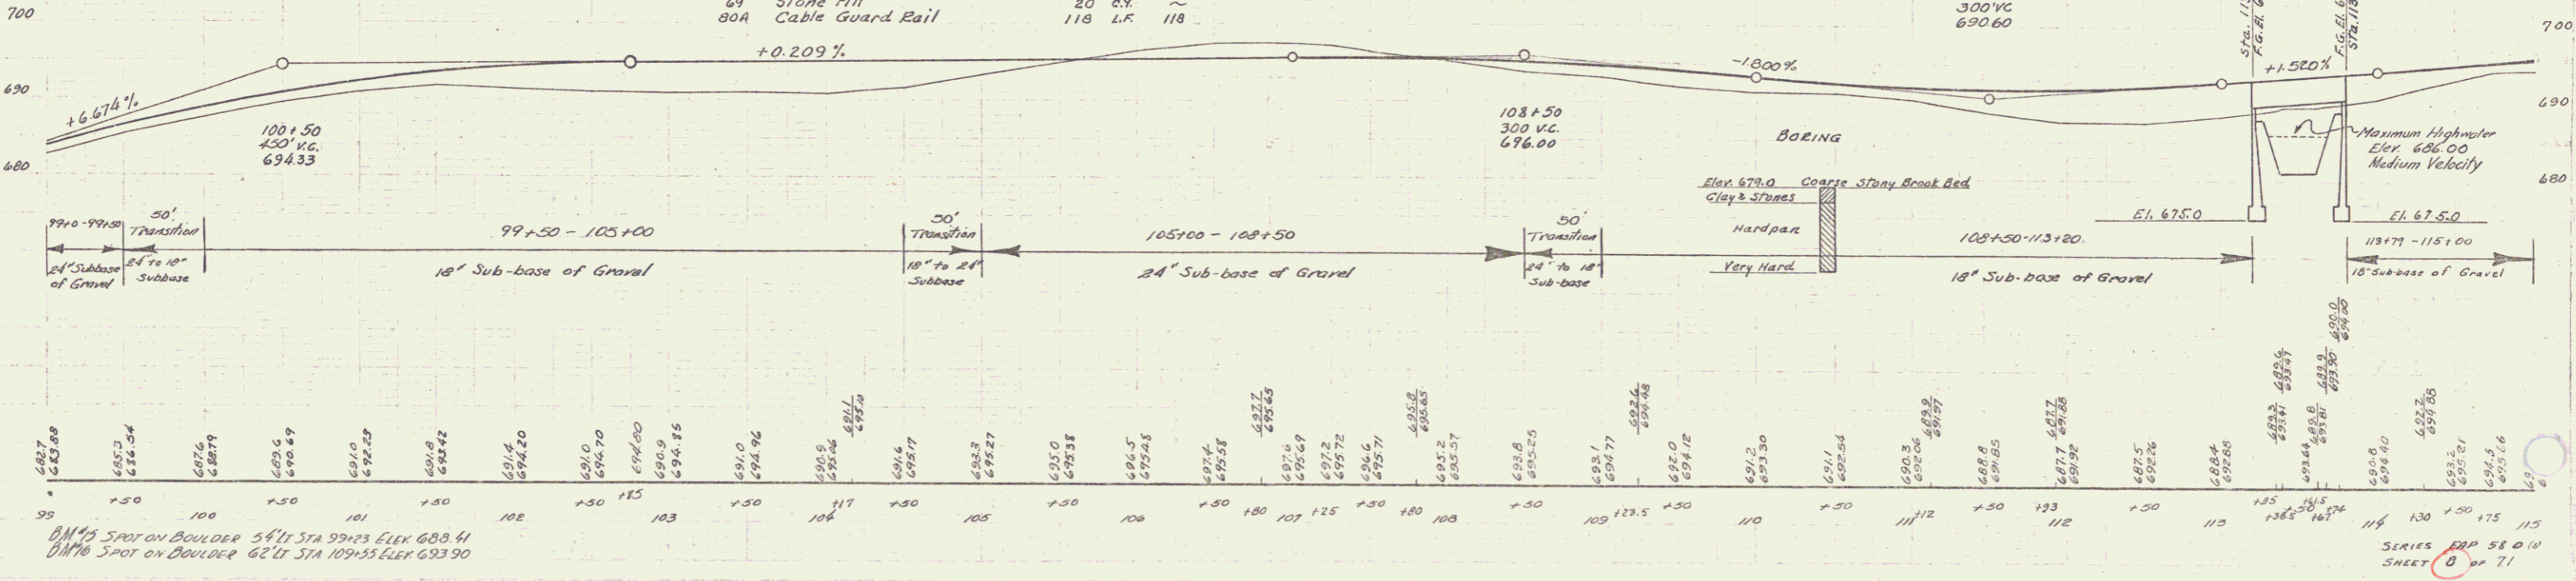

B.M. 16 SPOT ON BOULDER STA 99+72.7 ELEV 680.41  
 B.M. 16 SPOT ON BOULDER STA 109+55 ELEV 693.90

SERIES EXP 58 0 IN SHEET 7 OF 71