
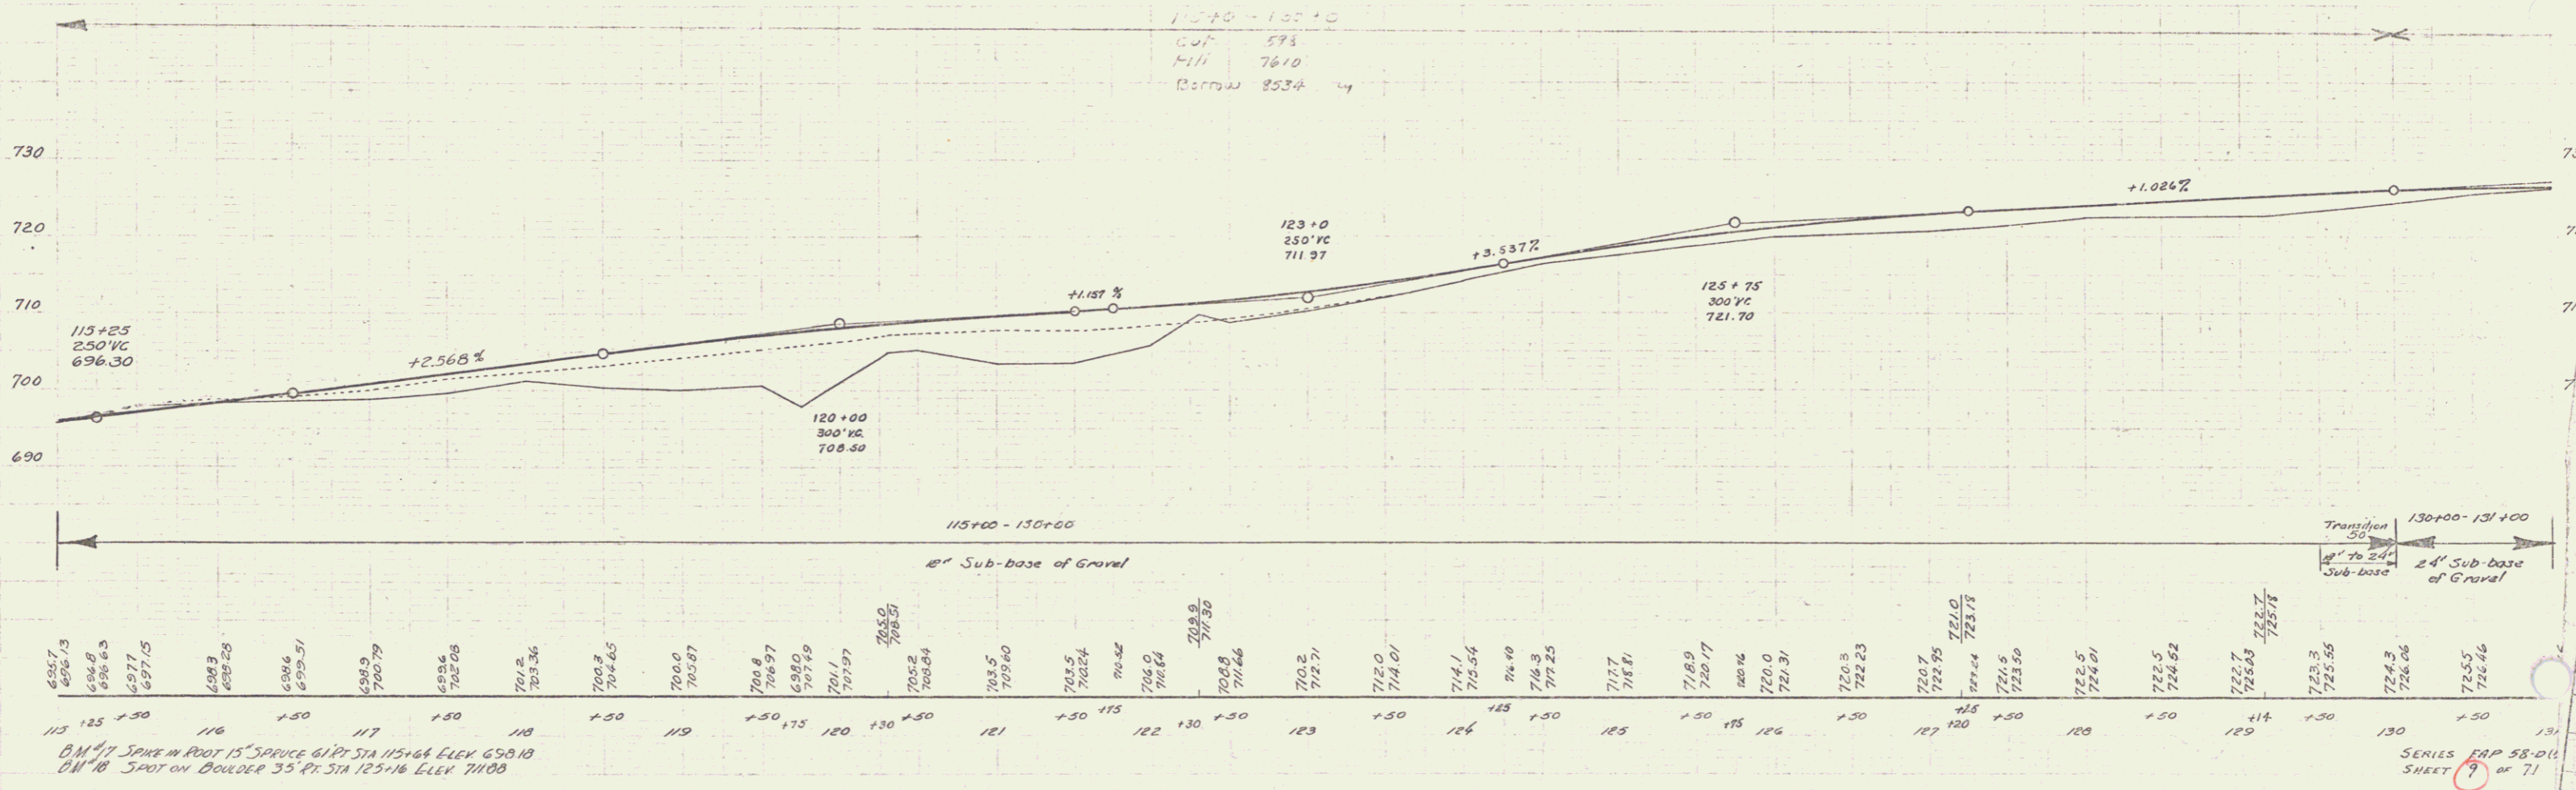


PARCEL INSTRUMENT DATE GRANTOR GRANTEE RECORDED  
 A, B W.D.O.E. 9-18-40 YRINO FILMI LEPPANEN MT HOLLY  
 A W.D.O.E. 9-18-40 HONORA COOK ST OF Y. BOOK PAGE DATE  
 ST OF Y. 25 153 9-20-40  
 ST OF Y. 25 160 9-20-40 I.C.U.K.

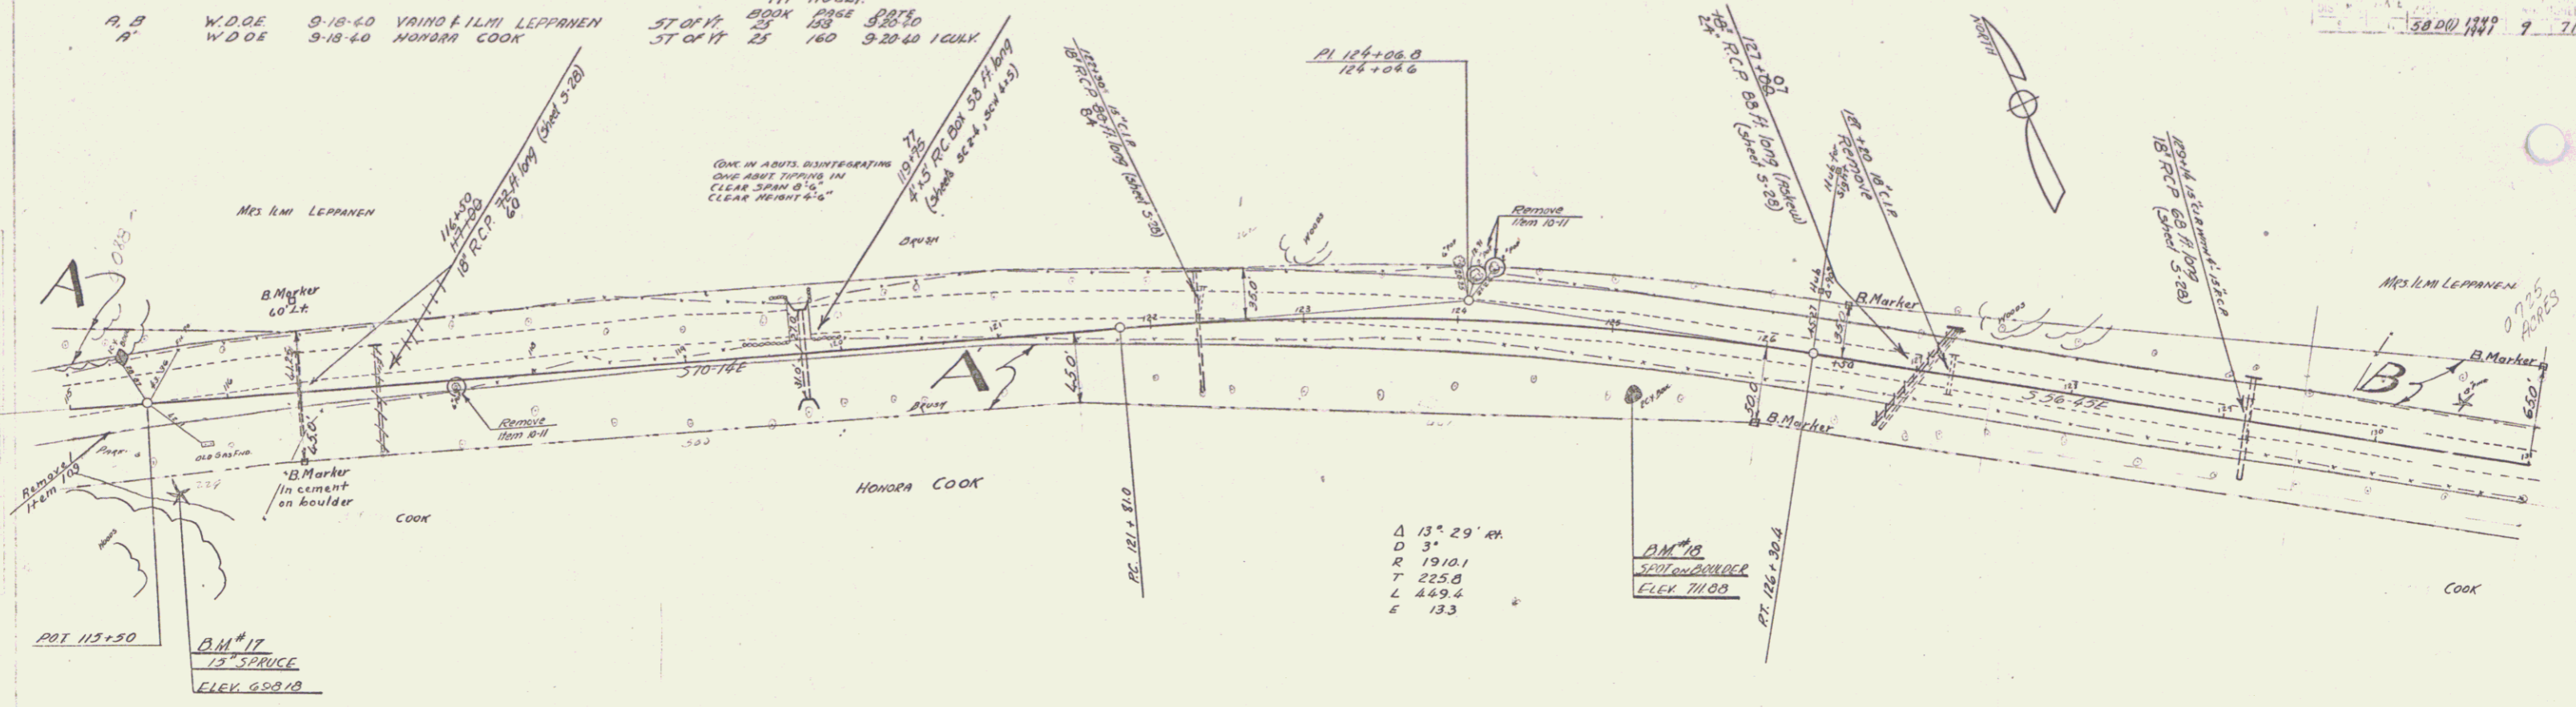

B.M. #17 SPIKE IN PROT. 15' SPRUCE 61 FT. STA 115+64 ELEV. 698.18  
 B.M. #18 SPOT ON BOULDER 33 FT. STA 125+16 ELEV. 711.08

SERIES EAP 58-D11  
 SHEET 9 of 71